



BASEMENT FRAMING PLAN - SOUTH
SCALE 1/8" = 1'-0"

2-0-1-2311

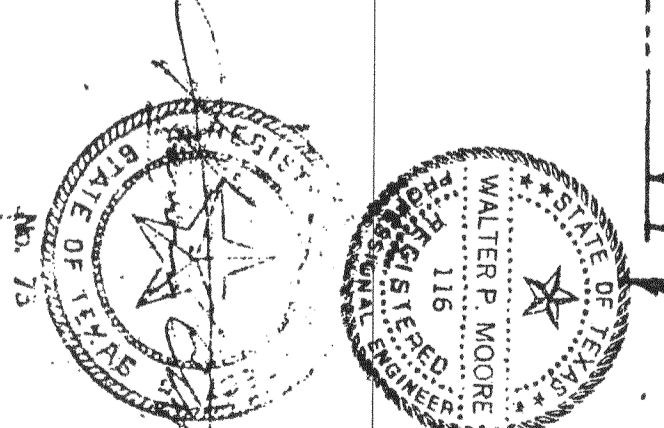

240 BED G.M.&S. BUILDING VETERANS ADMINISTRATION TEMPLE, TEXAS	
Drawn: KEZ Checked: HARVIN C. MOORE Date: 5-1-84	Prof. No.: 118 State: TEXAS Expires: 12-31-84
Design: WIRTZ, CALHOUN, TINDATE & JACKSON 2023 LEXINGTON STREET HOUSTON, TEXAS	Drawing Number: 105-516 Date: 5-1-84

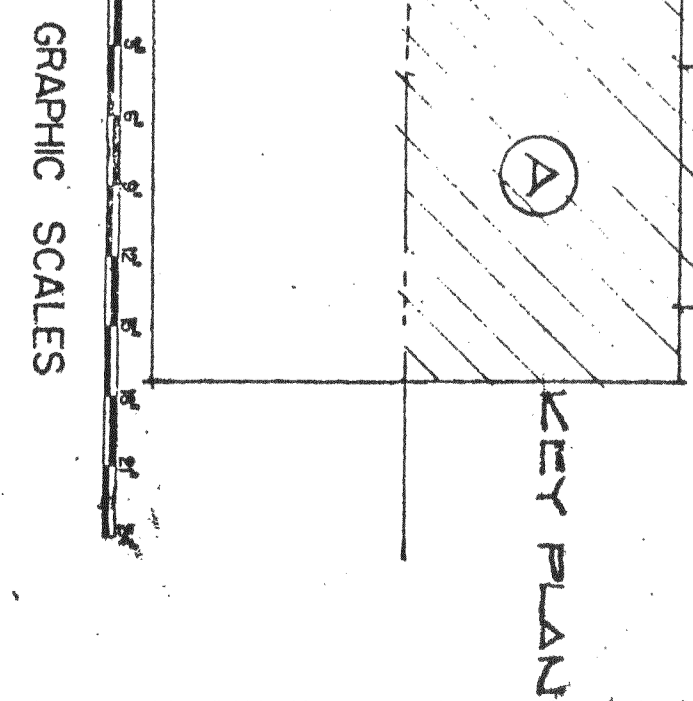

- REFERENCE NOTES:**
1. SEE SHEETS 5-1 AND 5-2 FOR BEAM SCHEDULES, TOP SLAB SCHEDULE.
 2. SEE SHEET 5-10 THRU 5-12 FOR COLUMN SCHEDULE.
 3. SEE SHEET 5-12 FOR GENERAL NOTES.
 4. SEE SHEET 5-17 FOR GENERAL FRAMING PLAN, NORTH FOR SECTIONS B1-B1 THRU B11-B11 FOR SECTIONS B1-B12.
 5. SEE SHEET 5-19 FOR SECTIONS B1-B12.
 6. SEE SHEET 5-20 FOR SECTIONS 1-1 THRU 1-11.
 7. SEE ARCHIT'S DETAILS (A) AND (S) FOR HANGERS, CONCRETE AND (S) FOR HANGERS.
 8. SEE SHEET 5-15 FOR LINTELS AND BEAM AND SLAB REMARKING PUNCHING DIM. GRAMS.
 9. SEE SHEET 5-23 FOR LINTELS AND BEAM AND SLAB REMARKING PUNCHING DIM. GRAMS.
 10. SEE SHEET 5-15 FOR LINTELS AND BEAM AND SLAB REMARKING PUNCHING DIM. GRAMS.
 11. SEE SHEET 5-15 FOR LINTELS AND BEAM AND SLAB REMARKING PUNCHING DIM. GRAMS.
 12. SEE SHEET 5-23 FOR LINTELS AND BEAM AND SLAB REMARKING PUNCHING DIM. GRAMS.

