

**ADDENDUM NO. 3**

IRONDALE FIRE STATION No. 3

---

THIS ADDENDUM IS DIRECTED TO ALL PRIME BIDDERS, AND ALL OTHERS TO WHOM DRAWINGS AND SPECIFICATIONS HAVE BEEN ISSUED.

THIS ADDENDUM FORMS A PART OF THE CONTRACT DOCUMENTS. THE FOLLOWING CONDITIONS TAKE PRECEDENCE OVER ANY CONFLICTING CONDITIONS IN THE DRAWINGS AND SPECIFICATIONS. THE DRAWINGS AND SPECIFICATIONS ARE HEREBY AMENDED IN THE FOLLOWING PARTICULARS.

---

**GENERAL:**

1. Per Birmingham E911, the new site address is 2920 Alton Rd.

**DRAWINGS**

1. C1.0 Site Layout Plan:
  - a. Modified sidewalk and retaining wall near east side of building
  - b. Added 6" curb and turndown edge dumpster enclosure
2. C2.0 Site Grading Plan:
  - a. Updated retaining wall grades near east side of building
  - b. Updated spot elevations near dumpster enclosure
  - c. Added note regarding settlement monitoring
3. C2.1 Site Drainage Plan: Added dumpster floor drain and 4" sanitary line to septic tank
4. C3.0 Site Utility Plan:
  - a. Added Flexstorm Insert to grate inlet connected to underground detention system
  - b. Added Notes 2-4 with City of Birmingham Stormwater Dept. requirements
5. C4.1 Erosion Control Plan – Intermediate:
  - a. Removed row of silt fence on the uphill side of the onsite sewer treatment area. This should also be removed from the initial phase (sheet C4.0).
  - b. Added topsoil, temporary seeding, and mulching to the onsite sewer treatment area

- c. Changed from single to double row of silt fence around the perimeter of the site
  - d. Added special note 3 regarding turbidity monitoring requirements
6. C4.2 Erosion Control Plan – Final:
- a. Changed temporary seeding callouts to permanent seeding and removed surface roughening from final phase.
  - b. Added special note 3 regarding turbidity monitoring requirements
7. C5.2 Details:
- a. Changed sump depth requirements for underground detention inlets to 48"
  - b. Note: Lane Enterprises StormKeeper Stormwater Chambers is an approved solution
8. C5.4 Details:
- a. Added mulching, temporary, and permanent seeding detail
  - b. Added diversion berm detail
  - c. Added Headwall detail for structure #A1
9. S1.0 General Notes: ISE Logik CWPA 800 is an approved equal for crystalline waterproofing
10. A2.01 Overall Floor Plan: Added 70 linear feet of guardrail to east retaining wall
11. A2.30 - Dumpster Enclosure Plan & Details: Added metal canopy over the dumpster
12. A2.21 Enlarged Plan Block B (Dorm): Change wall type of wall between Watch 105 and Office 107 to S6AA (6" thick stud with drywall).
13. A4.10 Finish Notes & Schedule:
- a. Change the floor finish in Room 141 Aux Room to CPT-2
  - b. Change the floor finish in Room 140 Apparatus Bays 140 to Polished Concrete. See new specification section 03 35 43 Concrete Polishing & Dyeing
14. A5.03 Stair Details: Added section detail of guardrail at east retaining wall
15. A6.01 Exterior Elevations: Added elevation of guardrail at east retaining wall
16. A12.01 Reflected Ceiling Plans: Berridge L Panel is an approved substitution for the Vesta HD3 Panel
17. FS1.01 Food Equipment Schedule:
- a. Food Equipment Schedule: Change Item 120 Millwork Base Counter quantity to two (2)
  - b. Food Equipment Schedule: Remove Item 126 Millwork Base Counter
18. M0.2 Mechanical Schedules: Added ECH-4 Ceiling Heater

19. M0.5 Mechanical Controls & Details: Added flue / intake cap detail
20. M1.1 Mechanical Floor Plan: Added flue and intake pipes
21. M1.2 Mechanical Roof Plan: Added concentric flue for hot water heaters
22. P0.1 Plumbing Schedules and Notes: Edited P-4, P-5, P-7. Changed WH-1, WH-2, WH-3 to gas
23. P0.2 Plumbing Details: Added water heater specification
24. P2.1 Pressure Piping – Floor Plan: changes related to switching to gas hot water heaters
25. P3.1 Plumbing – Enlarged Plans: Edited layout in Pressure Mech Room Plan
26. E002 Lighting Fixture Schedule and Details: Changed fixture tag 'UC' to UC2'.
27. E201 Level 1 Plan Lighting:
  - a. Moved Panel 'P1' into Janitor Closet #110.
  - b. Added location for LCP Panel.
28. E202 Level 1 Plan Power:
  - a. Moved Panel 'P1' into Janitor Closet #110.
  - b. Added location for LCP Panel.
29. E203 Level 1 Plan Auxiliary:
  - a. Added fire alarm panel location in Watch Room. Panel shall be recessed in wall.
  - b. Added power for FACP.
  - c. Added smoke detector in front of FACP.
  - d. Moved Panel 'P1' into Janitor Closet #110
  - e. Added location for LCP Panel.
30. E301 Electrical Riser Diagram & Panel Schedules: Added / Modified circuit breaker arrangements in Panel Schedules as shown.
31. E004 Electrical Details: Revised and issued in Addendum no. 2 but the changes were not noted. See below:
  - a. Added Lighting Control Wiring Diagram #3.
  - b. Updated panel names and notes at Lighting Control Wiring Diagram #1, #2, and #4.
  - c. Added approved Lighting Control Panel Manufacturers to LCP Detail.

## **SPECIFICATIONS**

1. 00 01 10 – Table of Contents: Updated to add 10 75 00 Flagpoles, deleted 06 40 00 Architectural Woodwork, added 12 32 16 Manufactured Plastic-Laminate-Clad Casework, added 03 35 43 Concrete Polishing & Dyeing

2. 01 21 00 – Allowances:
  - a. Corrected units of measure for Allowance nos. 10 and 11 and removed erroneous language regarding excavation.
  - b. Added Allowance no. 14 for French drain installation
  - c. Added Allowance no. 15 for BWWB fees
3. 01 22 00 Unit Prices: Added Item no. 12 for French drain installation
4. 03 35 43 Concrete Polishing & Dyeing: Added specification for polishing concrete in the Apparatus Bay 140
5. 04 21 13.13 – Brick Veneer Masonry: change mortar basis of design to Freedom “Champagne Buff”. Contact Corey McDonald at Southern Clay Brick for pricing (205) 910-6813.
6. 06 40 00 – Architectural Woodwork: deleted specification. See 12 32 16.
7. 08 11 16 – Interior Aluminum Doors and Frames: Under 2.1, Tubelite is an approved manufacturer
8. 08 35 13 – Four Fold Doors: JUS Doors, Model 93 is NOT an approved equal / manufacturer
9. 08 43 13 – Aluminum Framed Storefronts: Under 2.1, Tubelite is an approved manufacturer
10. 10 75 00 – Flagpole: See the attached specification
11. 12 32 16 - Manufactured Plastic-Laminate-Clad Casework: added specification.
12. 23 57 68 – Radiant Heating: Combustion Research Corporation, Omega II DI is NOT an approved equal

### **REQUESTS FOR INFORMATION (RFIs)**

1. *A4.30 Storefront / Window Types & Details:*
  - a. *Elevation B1 has sunshades but doesn't specify what kind. Please confirm this should be an outrigger type sunshade.*  
Answer: Sunshades should be outrigger type
  - b. *Sunshades are not offered for front set storefront. Please confirm that elevation B1 is to be center set storefront to allow for sunshades.*  
Answer: Elevation B1 should be center set storefront
  - c. *Please advise if ALL storefront elevations should be center set in lieu of front set or only change B1 to front set.*



Answer: Only window type B1 should be center set

1. Plans call for drywall at bottom of trusses. The trusses are 4'-0' on center , the drywall will not span 4'-0'.

Answer: Install Armstrong Framewall (basis of design) suspended ceiling system.  
Approved equals: USG, CertainTeed, Rockfon

2. Plan calls out Japanese Maple @ 10' HT. Plant schedule call them out a 9'.

Answer: 10' height

3. Plans calls out Sioux Crape Myrtle as multi trunk. Plant schedule calls them out as standard.

Answer: All Crape Myrtles are Standard (Single Trunk)

4. Plans calls out Natchez Crape Myrtle as standard. Schedule calls them out as multi trunk.

Answer: All Crape Myrtles are Standard (Single Trunk)

5. Plans calls out 66 Dwarf Yaupon. Schedule calls for 95.

Answer: Change plant schedule to 66 Dwarf Yaupon Hollies

6. Please confirm interior storefront type VP1 on A4.30 is not a sliding window. If it is a sliding window please provide active and fixed designations.

Answer: Type VP1 is not a sliding window. See 4/A4.30.

7. Can you verify the Owner furnished in the food service please? The FS schedule on the drawings and specs contradict each other on who is supplying the items? Items in question: 122, 123, 127, 128

Answer: The food equipment schedule on FS1.01 is correct. See items below:

- a. 122 Range: Contractor provided, contractor installed
  - b. 123 Exhaust Hood: Contractor provided, contractor installed
  - c. 127: Should read "Reach-in Refrigerator." See information listed for 128 in the specifications and 127 on the drawing schedule. Contractor provided, contractor installed
  - d. 128: Item 128 in the specifications should be item 127
8. Please verify paint type to be used in restrooms.

Answer: See specification section 09 90 00 – Paints and Coatings:

PRIMER: (This primer only, spray-applied) ProMar 200 Zero VOC Interior Latex Primer, B28W02600 or High Build Interior Latex Primer, B28W08601

FINISH: (2 coats) Pro Industrial Water based Catalyzed Epoxy, Gloss, B73-300 Series / B73V00300 Hardener (Eg-Shel finish, B73-360 Series

9. *Please confirm exact location of LCP*

Answer: The LCP shall be located in Janitor Closet 110.

10. *In sheet E004, Lighting Control Panel Wiring Diagram #1 indicates that CAT5e cable should be routed through 3/4" conduit. Please confirm if all cable routing will be 3/4" conduit. This is because the price may increase due to this, and typically, 3/4" conduit is only used to reach the accessible ceiling.*

Answer: Conduit with low voltage wiring may be stubbed up to above the accessible ceiling and terminated with a smooth bushing. Low Voltage cable may be installed "free air" above the accessible ceiling as required. In areas with an exposed ceiling, conduit shall be run to the nearest accessible ceiling before being terminated.

11. *In sheet E201 - Lighting Plan shows that MECH / ELE Room is controlled by LCP but also is controlled by a single pole switch, please confirm which control is the correct.*

Answer: This room shall be controlled with an on-off switch only. Do not run lights in this room through the LCP.

12. *For circuit 17 panel P1 - Flag Pole lights on the Panel Schedule specifies that wire size should be #12, but in Sheet E101 - Site Plan Electrical in general notes it specifies that all site lights should be #8-1"C, please confirm the correct wire size.*

Answer: Wire size shall be #12 per panel schedule.

13. *There is not FACP on plans, please confirm the exact location.*

Answer: FACP shall be recessed and installed in the Watch Room in room separating it from the adjacent office. Wall depth shall be increased to a 6" wall. Provide 2#12, 1#12G-3/4"C. to 20/1 Lock-On Breaker at Panel 'PEQ'..

14. *In plan sheet E101 note 2, please confirm if lightning protection for the Fire Alarm circuit will be necessary.*

Answer: Yes. Lightning protection is required on fire alarm wiring as called for.

15. *Note 5 in plan sheet E101 indicates that we must install an empty conduit from the fire vault to panel RP2, but panel RP2 is not in the drawings, can you please clarify this note?*

Answer: Conduit shall be terminated at Panel P1.

16. Can you clarify if the clearing contract outside of this contract, includes stump removal?

Answer: The General Contractor is responsible for removing the remaining stumps

17. Specification section 012100 - Allowances, Page six.

Item J. Allowance 10 - Sod, paragraph a. is calling for undercut & Backfill

Item k - Allowance 11 Mud Sills. Paragraph is referring to Allowance 10 for Square Yd of Sod in Place.

Answer: See revised 01 21 00 – Allowances for correction of units.

18. We have been asked by a steel fabricator and erector if the AISC certification is a requirement for this project.

Answer: See Addendum no. 2. Yes, this is STRUCTURALLY ACCEPTABLE, provided, the contractor pays for the owner's testing agent to shop inspect welds.

19. Please refer to the Plan Sheet Notes on Sheet A2.2. Who is to provide and install the following items:

- a. Item #2 – Wall Rack equal to “Geargrid Corp – 5' Wash Center
- b. Item #3 – Wall Rack equal to Geargrid Corp – 5' Broom Center
- c. Item #6 – Mobile PPE Racks equal to Geargrid “Mobile 3-pack, 20”w x 20”d x 83.25”h”

Answer: The Plan Sheet Notes refer to both A2.20 and A2.21. These items are to be purchased and installed by the GC. GearGrid is the basis of design.

20. The upper tower section shown on Sheet A6.01 appears to be EIFS around the Type “J” windows. But it does not show up on the Section cut 3/A7.01 and there are no specs. Also, it is calling for scratch coat on metal lath behind the stone veneer which I would also expect to find in the EIFS spec.

Answer: The siding around the ‘J’ windows is prefinished break metal. See Detail 11/A4.30 and 6/A4.30. The scratch coat and metal lath is the standard detail for manufactured stone with metal studs.

21. Are the roof panels intended to be 16” wide or 11-1/2” wide?

Answer: Standing seam roof panels shall be 16” wide. See 07 61 13 – Standing Seam Metal Roofing specification.

22. Sheet C1.0 shows two (2) retaining walls at the building with notes referring to the Architectural Plans for information on the guardrail at the top of the wall. These

*retaining walls are not shown in the Architectural Plans. Please provide information on the type guardrail needed at the tops of these walls.*

Answer: See revised A2.01, A5.03, and A6.01

23. *Detail 15 on Sheet L5 shows a 20' Flagpole at the Plaza Plan. There are no specs for this Flagpole. Please provide specifications.*

Answer: See attached specification

24. *Is this Birmingham Water works, or Irondale water?*

Answer: Birmingham Water Works

25. *Stormwater: The Vertical Headwall does not appear to be correctly drawn. The sides should be more winged out so the slope can wrap around it. Please advise.*

Answer: See detail on the revised sheet C5.4

26. *The civil drawing C3.0 calls out for the underground fire main piping to be C-900 plastic piping but the specification section (331416) Part #3, 3.2 letter J calls for the piping to be ductile piping. Please, advise on which pipe to be installed for this project.*

Answer: Ductile iron pipe will be required from the tap to the backflow preventer and C-900 pipe can be for fire service piping beyond the backflow preventer

27. *Will there be any grade plate requirements where the fill is being placed?*

Answer: Settlement monitoring plates and monitoring by a licensed surveyor are the responsibility of the contractor.

28. *Is the site going to be unclassified, or will there be any allowances for rock, both mass and trench?*

Answer: The site will be unclassified to the "cut line" as defined by the specs, and unit price allowances for rock as provided in Allowance Numbers 7 and 8 listed in the specifications.

29. *Is the material from the cut areas onsite considered suitable to use in fill areas?*

Answer: Refer to the geotechnical report.

30. *Can crushed concrete with no debris be used to bed and backfill storm drains, excluding the underground detention system.*

Answer: No. Quarry aggregate is required.

31. *The geotech reports mentions the possibility of needing to install french drains, or subsurface drainage. Is there any detail to price this in the bid, or would it be handled through an allowance?*

Answer: An allowance for French drains will be included via addendum.

32. *Can we get clarification for backfilling the underground detention system: what elevation does the backfill need to be 57 stone before changing to engineered fill, and does this change in the concrete paving areas?*

Answer: No. 57 stone is required to 12" minimum above the chambers per the detail. Engineered fill compacted per the specifications is allowed above this elevation for all areas.

33. *Who is responsible for purchasing the meters?*

Answer: The contractor is responsible for purchasing the water meters from Birmingham Water Works.

34. *Sheet S2.1, Foundation Plan, Note 19 states to see general notes for information concerning Shear Wall Hold Downs. I could not find this information on General Notes.*

Answer: Please refer to "SHEAR WALL PANEL CONSTRUCTION" on S1.2.

35. *Sheet A4.21 details 11 & 12. These details show a bent plate at head and jamb. Please provide information on these bent plates.*

Answer: Please refer to Section 4 on S4.2. Provide Rolled Galv. L8x6x1/2 LLV for masonry veneer angle. Weld stop bars as noted in section. Provide curved steel plate (18"x3/8"xCONT) under Concrete/Masonry and Brick. Shop weld L8x6x1/2 to plate. Attach L8x6x1/2 to wall as shown in 4/S4.2. Anchor decorative 3/8" plate to head and jamb with two rows 3/8"x4" machine screws in countersunk hole in steel plate @18". Head of screws to be flush with outside face of plate.

36. *Sheet S4.1 detail 2. This detail show a 3/4" Headed Stud x 24". One of my structural steel fabricators stated the longest 3/4" headed stud was 16". Please advise.*

Answer: It will be structurally acceptable to extend headed studs by welding another headed stud to end of first stud.

37. *Sheet S4.2, detail 3. This detail shows a 1/2" square bar welded to Galvanized angle. What is length of 1/2" square bars. This also occurs at detail 4.*

Answer: Bar shall be 5" long for the 6" angle. Install bar perpendicular to wall. The bar will aid the brick veneer from "sliding" down the angle.

38. *Sheet S2.1, Foundation Notes*

1. *Finish Floor Elevation is 0'-0", UNO.*

2. *Item 2, Top of Footing elevation should be -2'-0" UNO in lieu of 0'-0" as shown*

Answer: Several of the footings are poured monolithic with the slab thus a top of footing elevation of 0'-0". Several footings are dropped per the sections below

the finish floor thus "unless noted". All Footings under Masonry Walls are -2'-0" BFF (min). Coordinate with sections and plans for footing elevations.

39. *In regards to thickened slab detail, is Dayroom 122 the only place it occurs?*

Answer: Thickened Slab detail on S1.3 shall be used between the corridor (C1-3) and rooms (146,147) as shown in plan.

40. *Sealed Concrete Spec Section is missing from the spec book. Please advise.*

Answer: There is no sealed concrete specification. Sikagard 300 HD WD is called out on A4.10 as the basis of design. See 03 35 43 Concrete Polishing & Dyeing for Apparatus Bay flooring.

41. *The Birmingham Water Works Board (BWVB) is unable to provide an estimate of the cost to attach the 6" and 2" water lines because the application for the required water main extension has not been submitted.*

Answer: See the revised 01 21 00 Allowances specification.

42. Does this project have a monument sign?

Answer: No, the project does NOT have a monument sign.

43. Signage: We have been unable to locate a spec for this sign shown on 4/A6.01. Also, is it illuminated?

Answer: There is no specification for the building signs. Yes, the signs are illuminated, see E201 & E202.

44. *Food Equipment: Please confirm all equipment shown on the food equipment schedule on FS1.01 will be purchased by the owner and does not need to be purchased by GC.*

Answer: The only food equipment purchased by the owner is listed on the Food Equipment Schedule on FS1.01 as "by owner." All other equipment to be purchased and installed by the GC.

45. Millwork: We have been unable to locate interior elevations for the Millwork in Day Room 122.

Answer: There is no millwork in the Day Room 122.

46. *Can Crushed Concrete and Asphalt be used as structural fill material?*

Answer: Asphalt material cannot be utilized as structural fill. Crushed concrete may be utilized as structural fill but must meet the requirements as outlined in the geotechnical report and specifications for compaction, maximum particle size, placement depth, etc.

47. *Item 127 / 128: Is Item 127 the residential refrigerator/freezer(s) as indicated on the drawing or are they Item 128 per the specs? Additionally, which model number is correct (WRS588FIH2 or WRS588FIHZ)?*

48. Answer: 127 Should read "Reach-in Refrigerator." See information listed for 128 in the specifications and 127 on the drawing schedule. Contractor provided, contractor installed. WRS588FIHZ is correct.

49. *Item 101: This dumpster is not tagged on the floor plan. Should we still account for it?*

Answer: No, the trash dumpster is provided by the owner

50. *Item 120: Are there two (2) base counters or one (1)? The floor plan shows two (2).*

Answer: There are five (5) base counters. See A11.03. Item 120 quantity should be two (2). Item 126 is not used.

51. *Items 122, 123, and 128: Are these by Owner as stated in the specs or by KEC as indicated on the equipment schedule?*

Answer: The only food equipment purchased by the owner is listed on the Food Equipment Schedule on FS1.01 as "by owner." All other equipment to be purchased and installed by the GC.

52. *Item 104, trash receptacle by owner: Are there three (3) or one (1)? The drawing shows one (1) while the specs mention one (1) and three (3).*

Answer: There is one (1) and it will be provided by the owner.

53. *Item 115: Model number differs between the written specs and the equipment schedule. Which is correct?*

Answer: Pre-rinse faucet B-0113-ADF12-B is correct.

54. *Item 118: Model number differs between the written specs and the equipment schedule. Which is correct?*

Answer: Ice Maker MAS033SA1/B-530S is correct.

**END OF ADDENDUM NO. 3**



**TABLE OF CONTENTS FOR PROJECT MANUAL****VOLUME 1 OF 2****DIVISION 00 PROCUREMENT AND CONTRACTING REQUIREMENTS**

00 01 05	PROJECT DIRECTORY
00 01 07	ARCHITECT/ ENGINEERS SEALS PAGE
00 01 10	TABLE OF CONTENTS
00 11 13	ADVERTISEMENT TO BID
00 21 13	INSTRUCTIONS TO BIDDERS
00 42 13	PROPOSAL FORM
00 42 13a	PROPOSAL FORM ATTACHMENT (SALES TAX)
00 42 13b	ATTACHMENT A TO PROPOSAL FORM (UNIT PRICES)
00 43 12	FORM OF ADVERTISEMENT FOR COMPLETION
00 43 13	SALES TAX EXEMPTION APPLICATION FORMS
00 43 14	STORED MATERIALS LOG
00 43 80	PARTIAL RELEASE OF LIEN
00 60 00	PROJECT FORMS
00 65 19	WAIVER OF LIEN
00 72 13	GENERAL CONDITIONS
00 73 00	SUPPLEMENTAL GENERAL CONDITIONS
00 73 16	CONTRACTOR'S AND SUBCONTRACTOR'S INSURANCE
00 74 20	AL VENDOR DISCLOSURE STATEMENT
00 80 01	EVERIFY SAMPLE

**DIVISION 1 – GENERAL REQUIREMENTS**

01 11 00	SUMMARY OF WORK
01 21 00	ALLOWANCES
01 22 00	UNIT PRICES
01 26 00	CONTRACT MODIFICATION PROCEDURES
01 26 20	WEATHER DELAYS
01 31 00	PROJECT MANAGEMENT AND COORDINATION
01 32 00	CONSTRUCTION PROGRESS DOCUMENTATION
01 33 00	SUBMITTAL PROCEDURES
01 40 00	QUALITY REQUIREMENTS
01 41 00	STRUCTURAL TEST AND SPECIAL INSPECTIONS



<b>01 41 00S</b>	SPECIAL INSPECTIONS SCHEDULE
<b>01 42 00</b>	REFERENCES
<b>01 42 19</b>	REFERENCE STANDARDS
<b>01 50 00</b>	TEMPORARY FACILITIES AND CONTROLS
<b>01 60 00</b>	PRODUCT REQUIREMENTS
<b>01 70 00</b>	EXECUTION AND CLOSEOUT REQUIREMENTS
<b>01 73 29</b>	CUTTING AND PATCHING
<b>01 77 00</b>	CLOSEOUT PROCEDURES
<b>01 78 23</b>	OPERATION AND MAINTENANCE DATA
<b>01 78 39</b>	PROJECT RECORD DOCUMENTS
<b>01 79 00</b>	DEMONSTRATION AND TRAINING

**DIVISION 02 – EXISTING CONDITIONS**

<b>02 32 00</b>	GEOTECHNICAL INVESTIGATION
-----------------	----------------------------

**DIVISION 03 – CONCRETE**

<b>03 30 00</b>	CAST-IN-PLACE CONCRETE
<b>03 35 43</b>	CONCRETE POLISHING & DYEING
<b>03 34 52</b>	INSULATED GLASS FIBER REINFORCED CONCRETE (IGFRC)
<b>03 45 00</b>	ARCHITECTURAL PRECAST CONCRETE

**DIVISION 04 – MASONRY**

<b>04 21 13.13</b>	BRICK VENEER MASONRY
<b>04 72 00</b>	CAST STONE MASONRY
<b>04 73 00</b>	MANUFACTURED STONE

**DIVISION 05 – METALS**

<b>05 12 00</b>	STRUCTURAL STEEL
<b>05 22 00</b>	STEEL JOIST
<b>05 31 00</b>	STEEL DECK
<b>05 40 00</b>	COLD FORMED METAL FRAMING
<b>05 50 00</b>	METAL FABRICATIONS

**DIVISION 06 – WOOD AND PLASTIC**

06 10 00	ROUGH CARPENTRY
06 20 00	FINISH CARPENTRY

**DIVISION 07 – THERMAL MOISTURE PROTECTION**

07 21 00	THERMAL INSULATION
07 21 13	BOARD INSULATION
07 27 27	SELF-ADHERED SHEET AIR BARRIER
07 42 93	ALUMINUM SOFFIT AND FASCIA SYSTEM
07 56 00	COLD LIQUID-APPLIED FLASHINGS
07 61 13	STANDING SEAM METAL ROOFING
07 62 00	SHEET METAL FLASHING AND TRIM
07 71 00	ROOF SPECIALTIES
07 80 00	FIRE AND SMOKE PROTECTION
07 90 00	JOINT PROTECTION

**DIVISION 08 – DOORS AND WINDOWS**

08 11 13	HOLLOW METAL DOORS AND FRAMES
08 11 16	INTERIOR ALUMINUM DOORS AND FRAMES
08 14 23	CLAD WOOD DOORS
08 31 13	ACCESS DOORS AND FRAMES
08 35 13	FOUR-FOLD DOORS
08 43 13	ALUMINUM-FRAMED STOREFRONTS
08 71 00	DOOR HARDWARE
08 80 00	GLAZING
08 90 00	LOUVERS AND VENTS

**DIVISION 09 – FINISHES**

09 21 16	GYPSUM BOARD ASSEMBLIES
09 30 13	CERAMIC TILING
09 51 00	ACOUSTICAL CEILINGS
09 65 13	RESILIENT BASE
09 65 19	RESILIENT TILE FLOORING
09 65 36	STATIC CONTROL RESILIENT FLOORING
09 68 13	TILE CARPETING
09 77 20	DECORATIVE FIBERGLASS REINFORCED PANELS
09 90 00	PAINTS AND COATINGS

**DIVISION 10 – SPECIALTIES**

<b>10 14 00</b>	SIGNAGE
<b>10 26 00</b>	WALL AND CORNER GUARDS
<b>10 28 00</b>	TOILET BATH AND LAUNDRY ACCESSORIES
<b>10 44 16</b>	FIRE EXTINGUISHERS, CABINETS, AND ACCESSORIES
<b>10 73 16</b>	CANOPIES
<b>10 75 00</b>	FLAGPOLES

**DIVISION 11 – EQUIPMENT**

<b>11 40 00</b>	FOOD SERVICE EQUIPMENT
-----------------	------------------------

**DIVISION 12 – FURNISHINGS**

<b>12 24 13</b>	ROLLER WINDOW SHADES
<b>12 32 16</b>	MANUFACTURED PLASTIC-LAMINATE-CLAD CASEWORK
<b>12 36 61.16</b>	SOLID SURFACING COUNTERTOPS
<b>12 36 61.19</b>	QUARTZ SURFACING COUNTERTOPS

**VOLUME 2 OF 2**

**DIVISION 21 – FIRE SUPPRESSION**

<b>21 11 16</b>	IRONDALE FIRE HYDRANT SPECIFICATIONS
-----------------	--------------------------------------

**DIVISION 22 – PLUMBING**

<b>22 04 05</b>	PLUMBING IDENTIFICATION
<b>22 04 10</b>	GENERAL PROVISIONS - PLUMBING
<b>22 04 20</b>	TESTING, CLEANING AND ADJUSTING (TCA)
<b>22 04 50</b>	MATERIALS AND METHODS - PLUMBING
<b>22 04 51</b>	GENERAL FIRE PROTECTION REQUIREMENTS
<b>22 04 53</b>	BASIC FIRE PROTECTION MATERIAL AND METHODS
<b>22 04 55</b>	FIRE PROTECTION SYSTEM
<b>22 04 80</b>	INSULATION - PLUMBING
<b>22 04 90</b>	FIXTURES AND EQUIPMENT – PLUMBING

**DIVISION 23 - HEATING VENTILATING AND AIR CONDITIONING**

<b>23 05 00</b>	GENERAL PROVISIONS - HVAC
-----------------	---------------------------

<b>23 05 13</b>	MATERIALS AND METHODS - HVAC
<b>23 05 52</b>	PIPING SPECIALTIES - HVAC
<b>23 05 93</b>	TESTING, ADJUSTING, AND BALANCING (TAB)
<b>23 51 80</b>	INSULATION - HVAC
<b>23 52 10</b>	AIR PURIFICATION SYSTEMS
<b>23 57 60</b>	HEAT PUMP UNITS
<b>23 57 61</b>	CONDENSING UNITS
<b>23 57 63</b>	ENERGY RECOVERY UNITS
<b>23 57 66</b>	VARIABLE REFRIGERANT FLOW SYSTEM
<b>23 57 68</b>	UNITARY HEATING AND COOLING
<b>23 58 20</b>	FANS
<b>23 58 40</b>	DUCTWORK
<b>23 58 50</b>	SPECIAL DUCTWORK SYSTEM
<b>23 58 60</b>	DUCT ACCESSORIES
<b>23 58 70</b>	OUTLETS
<b>23 58 80</b>	FILTERS
<b>23 90 00</b>	CONTROLS

**DIVISION 26 – ELECTRICAL**

<b>26 05 10</b>	ELECTRICAL GENERAL
<b>26 00 30</b>	COORDINATION
<b>26 05 15</b>	CONDUCTORS
<b>26 05 21</b>	GROUNDING
<b>26 05 30</b>	FIRESTOPPING
<b>26 05 31</b>	RACEWAYS
<b>26 05 32</b>	OUTLET BOXES AND JUNCTION BOXES
<b>26 05 73</b>	SHORT CIRCUIT AND PROTECTIVE DEVICE COORDINATION STUDY
<b>26 24 16</b>	PANELBOARDS
<b>26 27 26</b>	WIRING DEVICES
<b>26 28 13</b>	FUSES
<b>26 28 16</b>	ENCLOSED SWITCHES AND CIRCUIT BREAKERS
<b>26 32 10</b>	EMERGENCY POWER GENERATOR
<b>26 50 00</b>	LIGHTING

**DIVISION 27 – COMMUNICATIONS**

<b>27 05 00</b>	COMMON WORK RESULTS FOR COMMUNICATIONS
<b>27 05 53</b>	IDENTIFICATION FOR COMMUNICATIONS SYSTEMS
<b>27 15 00</b>	COMMUNICATIONS HORIZONTAL CABLING

**DIVISION 28 - ELECTRONIC SAFETY AND SECURITY**

<b>28 31 11</b>	DIGITAL ADDRESSABLE FIRE ALARM SYSTEM
<b>28 55 00</b>	RF SURVEY FOR IN-BUILDING TWO-WAY EMERGENCY RESPONDER COMMUNICATION ENHANCEMENT SYSTEM

**DIVISION 31 - SITE**

<b>31 10 10</b>	SITE CLEARING
<b>31 20 00</b>	EARTH MOVING

**DIVISION 32 - LANDSCAPE**

<b>32 13 13</b>	CONCRETE PAVING
<b>32 80 00</b>	LANDSCAPE WORK
<b>32 84 00</b>	LANDSCAPE IRRIGATION
<b>32 94 00</b>	MAINTENANCE

**DIVISION 33 - UTILITIES**

<b>33 14 16</b>	SITE WATER UTILITY DISTRIBUTION PIPING
<b>33 31 00</b>	SANITARY SEWERAGE PIPING
<b>33 42 00</b>	STORMWATER CONVEYANCE
<b>33 71 73</b>	ELECTRICAL UTILITY SERVICE

**END OF TABLE OF CONTENTS FOR PROJECT MANUAL**

**SECTION 01 21 00**

**ALLOWANCES**

**PART 1 – GENERAL**

1.1 RELATED DOCUMENTS:

- A. Drawings and general provisions of Contract, including General and Division-1 Specification sections, apply to work of this section.
  - 1. Coordinate allowance work with related work to ensure that it is completely integrated and interfaced with related work.

1.2 DESCRIPTION OF REQUIREMENTS:

- A. Definitions and Explanations: Certain requirements of the work related to each allowance are shown and specified in contract documents. The allowance has been established in lieu of additional requirements for that work, and further requirements thereof (if any) will be issued by change order.
- B. Types of allowances scheduled herein for the work included the following:
  - 1. Lump sum allowances.
- C. Selection and Purchase:
  - 1. At earliest feasible date after award of Contract, advise Architect/Engineer of scheduled date when final selection and purchase of each product or system described by each allowance must be accomplished in order to avoid delays in performance of the work.
  - 2. As requested by the Architect/Engineer, obtain and submit proposals for the work of each allowance for use in making final selections; include recommendations for selection which are relevant to the proper performance of the work.
  - 3. Purchase products and systems as specified, and as selected (in writing) by the Architect/Engineer.
  - 4. Submit proposals and recommendations, for purchase of products or systems of allowances, in form specified for change orders.
- D. Change Order Data: Include in each change order proposal both the quantities of products being purchased and unit costs, along with total

amount of purchases to be made. Where requested, furnish survey-of-requirements data to substantiate quantities. Indicate applicable taxes, delivery charges, amounts of applicable trade discounts, and other relevant details as requested by the Architect.

1. Each change order amount for allowances shall be based on the unit price difference between the actual purchase amount and the allowance, multiplied by the final measure or count of work-in-place, with reasonable allowances, where applicable, for cutting losses, tolerances, mixing wastes, normal product imperfections and similar margins.
2. Include 10% overhead and profit separately, in the Contractor's Base Bid, and not as part of Allowances.
3. When requested, prepare explanations and documentation to substantiate the quantities, costs, and margins as claimed.

E. Change Order Mark-Up:

1. Except as otherwise indicated, comply with provisions of General Conditions. For each allowance, Contractor's claims for increased costs (for either purchase amount or Contractor's handling, labor, installation, overhead, and profit), because of a change in scope or nature of the allowance work as described in contract documents, must be submitted within 60 days of initial change order authorizing work to proceed on that allowance; otherwise, such claims will be rejected.
2. Where it is not economically feasible to return unused material to the manufacturer/supplier for credit, prepare unused material for the Owner's storage, and deliver to the Owner's storage space as directed. Otherwise, disposal of excess material is the Contractor's responsibility.

F. Time and Allowance Amounts:

1. Nothing in the Bid or Contract Documents shall be so constructed or interpreted as to provide a Contract time extension, due to use or non-use of any Allowance amount.
2. Nothing in the Bid or Contract Documents shall be so constructed or interpreted as to allow unused Allowances or any portion thereof, nor any overhead and profit therefore to be retained by or paid to the Contractor.
  - a. Amount of unused allowances be returned shall include unused amount plus 10% overhead and profit.

**PART 2 – PRODUCTS**

Not Applicable

**PART 3 – EXECUTION**

## 3.1 SCHEDULE OF ALLOWANCES:

A. **Allowance No. 1 – Contingency Allowance:**

1. Allow a lump sum of **\$350,000.00** for additional work, as directed by the Architect and Owner, including purchase, any applicable taxes and fees, and all related costs.
2. Include overhead and profit of at least 10% in Base Bid, and not as part of Allowance.

B. **Allowances No. 2 – Excavate and haul off unsuitable materials from below the cut line:**

1. The following items will be included as an allowance based on units and quantities along with the unit prices provided per the specifications. The contractor will only be able to utilize these allowances when the required excavation exceeds what is required by the Specifications and as directed by the Owner's Geotechnical Engineer. This allowance is not to be used to correct subgrade damage caused by construction traffic or contractor neglect.

The contractor will only use this allowance when properly authorized prior to performing the additional work paid for from the allowance.

- a. Unit Price Item No. 1 – Undercut and Backfill of Unsuitable Material.

**200** cy x \$ \_\_\_\_\_ per cy = \_\_\_\_\_.

C. **Allowances No. 3 – Replace with crushed stone (ALDOT 825B or #57)**

1. The following items will be included as an allowance based on units and quantities along with the unit prices provided per the specifications.

The contractor will only use this allowance when properly authorized prior to performing the additional work paid for from the allowance.

- a. Unit Price Item No. 2 – Replacement with crushed stone:



200 tons x \$ \_\_\_\_\_ per ton = \_\_\_\_\_.

D. **Allowances No. 4** – Replace with suitable material from offsite source

1. The following items will be included as an allowance based on units and quantities along with the unit prices provided per the specifications.

The contractor will only use this allowance when properly authorized prior to performing the additional work paid for from the allowance.

- a. Unit Price Item No. 3 – Replacement with offsite suitable material:

200 cubic yards x \$ \_\_\_\_\_ per cy = \_\_\_\_\_.

E. **Allowances No. 5** – Surge Material (ALDOT #1 Stone)

1. The following items will be included as an allowance based on units and quantities along with the unit prices provided per the specifications.

The contractor will only use this allowance when properly authorized prior to performing the additional work paid for from the allowance.

- a. Unit Price Item No. 4 –Tons (TN) of crushed stone.

100 tons x \$ \_\_\_\_\_ per ton = \_\_\_\_\_.

F. **Allowances No. 6** – Stabilization Fabric

1. The following items will be included as an allowance based on units and quantities along with the unit prices provided per the specifications.

The contractor will only use this allowance when properly authorized prior to performing the additional work paid for from the allowance.

- a. Unit Price Item No. 5 – Stabilization Fabric:

300 square yards x \$ \_\_\_\_\_ per sy = \_\_\_\_\_.

G. **Allowances No. 7** – Topsoil

1. The following items will be included as an allowance based on units and quantities along with the unit prices provided per the specifications.

The contractor will only use this allowance when properly authorized prior to performing the additional work paid for from the allowance.

- a. Unit Price Item No. 6 – Provide additional topsoil.

50 cubic yards x \$ \_\_\_\_\_ per cy = \_\_\_\_\_.

H. **Allowances No. 8** – Rock, Masonry or Concrete Excavation in Trenches and Pits

1. The following items will be included as an allowance based on units and quantities along with the unit prices provided per the specifications. The contractor will only be able to utilize these allowances when the required excavation exceeds what is required by the Specifications and as directed by the Owner's Geotechnical Engineer. This allowance is not to be used to correct subgrade damage caused by construction traffic or contractor neglect.

The contractor will only use this allowance when properly authorized prior to performing the additional work paid for from the allowance.

- a. Unit Price Item No. 7 – Cubic Yard (CY) of rock, masonry, or concrete excavated.

50 cubic yards x \$ \_\_\_\_\_ per cy = \_\_\_\_\_.

I. **Allowances No. 9** – Rock, Masonry or Concrete Excavation in Open Excavation

1. The following items will be included as an allowance based on units and quantities along with the unit prices provided per the specifications. The contractor will only be able to utilize these allowances when the required excavation exceeds what is required by the Specifications and as directed by the Owner's Geotechnical Engineer. This allowance is not to be used to correct subgrade damage caused by construction traffic or contractor neglect.

The contractor will only use this allowance when properly authorized prior to performing the additional work paid for from the allowance.

- a. Unit Price Item No. 8 – Cubic Yard (CY) of rock, masonry, or concrete excavated.

50 cubic yards x \$ \_\_\_\_\_ per cy = \_\_\_\_\_.

J. **Allowances No. 10** – Sod

1. The following items will be included as an allowance based on units and quantities along with the unit prices provided per the specifications

The contractor will only use this allowance when properly authorized prior to performing the additional work paid for from the allowance.

a. Unit Price Item No. 9 – Square yard (SY) of sod, in place.

50 square yards x \$ \_\_\_\_\_ per sy = \_\_\_\_\_.

K. **Allowances No. 11 – Mud Footings**

1. The following items will be included as an allowance based on units and quantities along with the unit prices provided per the specifications.

The contractor will only use this allowance when properly authorized prior to performing the additional work paid for from the allowance.

a. Unit Price Item No. 10 – Cubic yard (CY) of concrete, in place.

50 cubic yards x \$ \_\_\_\_\_ per cy = \_\_\_\_\_.

L. **Allowances No. 12 – Sidewalk**

1. The following items will be included as an allowance based on units and quantities along with the unit prices provided per the specifications.

The contractor will only use this allowance when properly authorized prior to performing the additional work paid for from the allowance.

a. Unit Price Item No. 11 – Square Foot (SF) of sidewalk installed.

50 square yards x \$ \_\_\_\_\_ per sy = \_\_\_\_\_.

M. **Allowance No. 13 – Radio and Paging System Allowance:**

1. Allow a lump sum of **\$45,000.00** for the purchase and installation of the radio and paging system, as directed by the Architect and Owner, including any applicable taxes and fees, and all related costs.

2. Include overhead and profit of at least 10% in Base Bid, and not as part of Allowance.

N. **Allowance No. 14 – French Drain:**

1. The following items will be included as an allowance based on units and quantities along with the unit prices provided per the specifications.

The contractor will only use this allowance when properly authorized prior to performing the additional work paid for from the allowance.

a. Unit Price Item No. 12 – linear foot (lf) of French drain installed.

50 linear feet x \$ \_\_\_\_\_ per lf = \_\_\_\_\_.

O. **Allowance No. 15** – Aid to Construction for Birmingham Water Works

1. Include a lump sum allowance of \$75,000 for use to pay for Tap Fees, System Development Fees and materials required to be purchased direct from BWWB. Installation will remain the responsibility of the contractor as a part of the base bid amount.
2. Include overhead and profit of at least 10% in Base Bid, and not as part of Allowance.

**END OF SECTION 01 21 00**

THIS PAGE INTENTIONALLY BLANK

**SECTION 01 22 00**

**UNIT PRICES**

**PART 1 – GENERAL**

1.1 SUMMARY

**A.** This section specifies administrative and procedural requirement for unit prices.

1. A unit price is an amount proposed by Bidders, as a price per unit of measurement for materials and/or services that will be added to or deducted from the Contract Sum by Change Order in the event the estimated quantities of Work required by the Contract Documents are increased or decreased, in accordance the General Conditions and/or other provisions of the Bid and Contract Documents.
2. Unit prices shall include all necessary material, labor, fees, layout, supervision (field and home office), general expenses, insurance, bonds, overhead, profit and applicable taxes, for unit item of work in place.
3. Refer to other Division 1 Sections and individual Specification Sections for construction activities requiring the establishment of unit prices. Methods of approval, verification, measurement and payment for unit prices are specified in those sections.

**B.** Related work specified elsewhere includes: None

**C.** Schedule:

1. A "Unit Price Schedule" is included at the end of this Section. Specification Sections referenced in the Schedule contain requirements for materials and methods described under each unit price.
2. The Owner reserves the right to reject the Contractor's measurement of work-in-place that involves use of established unit prices, and to have this work measured by an independent surveyor acceptable to the Contractor at the Owner's expense.

**PART 2 – PRODUCTS**

2.1 Not Applicable.

**PART 3 – EXECUTION**

3.1 ITEMIZED UNIT PRICE SCHEDULE:

**A. Item No. 1 – Excavation and haul off of unsuitable materials**

1. Description: Remove unsuitable soils from below the "cut line" elevation and legally dispose of off-site, in accordance with Section 31 20 00 - "Earth Moving".
2. Unit of Measure: Cubic yard (CY) of earth excavated.

**B. Item No. 2 – Replacement with crushed stone**

1. Description: include all cost associated with the purchasing, transporting, installation and compacting of ALDOT #57 stone or dense-graded aggregate base material for soil stabilization and/or backfill, in accordance with Section 31 20 00 - "Earth Moving".
2. Unit of Measure: Tons (TN) of crushed stone.

**C. Item No. 3 – Replacement with offsite suitable material**

1. Description: include all cost associated with purchasing, importing, placing and compacting of material conforming to the project specifications from an offsite source in the event that adequate suitable material is not present on the project site, in accordance with Section 31 20 00 - "Earth Moving".
2. Unit of Measure: Cubic yard (CY) of earth compacted in place.

**D. Item No. 4 – Surge Material (ALDOT #1 Stone)**

1. Description: include all cost associated with purchasing, importing, placing and compacting ALDOT #1 stone for soil stabilization, in accordance with Section 31 20 00 - "Earth Moving".
2. Unit of Measure: Tons (TN) of crushed stone.

**E. Item No. 5 – Stabilization Fabric**

1. Description: include all cost associated with the purchase and installation of geogrid for soil stabilization. This material shall be Tensar BX1 100 (Tensar Biaxial type 1) or approved equal, in accordance with Section 31 20 00 - "Earth Moving".
2. Unit of Measure: Square Yards (SY) of fabric installed

**F. Item No. 6 – Topsoil**

1. Description: Provide additional topsoil from offsite locations, in accordance with Section 31 20 00 "Earth Moving", and applicable portions of other sections.
  - a. Unit of Measure: Cubic yard (CY) of topsoil, in place.

**G. Item No. 7 – Rock, Masonry, or Concrete Excavation in Trenches and Pits**

1. Description: Remove rock, masonry, and/or concrete encountered in trenches and pits, below elevations indicated, and legally dispose of offsite, in accordance with Section 31 20 00 "Earth Moving".
2. Unit of Measure: Cubic Yard (CY) of rock, masonry, or concrete excavated.

#### **H. Item No. 8 – Rock, Masonry, or Concrete Excavation in Open Excavation**

1. Description: Remove rock, masonry, and/or concrete encountered in open excavations, below elevations indicated, and legally dispose of off-site, in accordance with Section 31 20 00 - Earth Moving".
2. Unit of Measure: Cubic Yard (CY) of rock, masonry, or concrete excavated.

#### **I. Item No. 9 – Sod**

1. Description: Provide additional sod as directed, including fine grading, soil amendments, fertilizers, sod, maintenance, etc., as specified in Division 32.
2. Unit of Measure: Square yard (SY) of sod, in place.

#### **J. Item No. 10 – Concrete Mud Footings**

1. Description: Provide additional concrete mud footings, in addition to any mud footings indicated on the Drawings, as specified in Division 3, as directed, where required by the Project Geotechnical Consultant due to any existing unsuitable soils.
2. Unit of Measure: Cubic yard (CY) of concrete mud footings, in place.
3. Note: This unit price is not applicable to cost of mud footings that are required due to over-excavation, or due to not pouring footings the same date they are excavated, or other reasons indicated in Section 31 20 00 - "Earth Moving," or Section 03 30 00 - "Cast-in-Place Concrete".

#### **K. Item No. 11 – Concrete Sidewalk**

1. Description: Install concrete sidewalk not otherwise shown on drawings, in location directed by Architect.
2. Unit of Measure: Square Foot (SF) of sidewalk installed.

#### **L. Item No. 12 – French Drain**

1. Description: 12" minimum wide trench 3' deep, covered with a non-woven geotextile with a 4" diameter perforated pipe installed in the bottom and



backfilled with #57 crushed stone. The drain should slope to the nearest drainage ditch or stormwater culvert/catch basin.

2. Unit of Measure: Linear Foot (LF) of French drain installed.

**END OF SECTION 01 22 00**

**SECTION 03368  
CONCRETE POLISHING AND DYEING**

**PART 1 GENERAL**

**1.1 RELATED DOCUMENTS**

A. Drawings and general provisions of Contract, including General and Supplementary Conditions and Division 1 Specification Sections, apply to this Section.

**1.2 SUMMARY**

- A. This Section includes stained concrete finish for interior concrete floors denoted on Finish Schedule as PC (Polished Concrete).
- B. Furnish all labor, material, equipment and services necessary for the dry diamond grinding and polishing of concrete floors.
- C. Applying densifying impregnator/sealer and polishing to specified sheen level and aggregate exposure.
- D. Concrete must be cured a minimum of 28 days prior to polishing.

**1.3 REFERENCES**

- A. American Concrete Institute (ACI):
  - 1. ACI302.1R-89, Guide for Concrete Floor and Slab Construction.
- B. American Society for Testing and Materials:
  - 1. ASTM C779, Standard Test Method for Abrasion of Horizontal Concrete Surfaces.
  - 2. ASTM C805, Impact Strength.
  - 3. ASTM G23-81, Ultraviolet Light & Water Spray.
  - 4. ASTM 1028, Co-efficient of Friction.
  - 5. ASTM C 150, Type I, II Portland cement conformity, depending on soil conditions.
  - 6. ASTM C 33, Aggregate conformity.
- C. Other Tests:
  - 1. Reflectivity.

**1.4 SUBMITTALS**

- A. Submit the following in accordance with Submittal Procedures in Division 1 Sections.

- B. Product data for each grinding machine, including all types of grinding heads, dust extraction system, joint filler, concrete densifying impregnator, penetrating sealer, and any other chemicals used in the process.
- C. Applicators qualification data.
- D. Polished concrete samples: size 3x3 for each Polished Concrete finish required.
- E. Maintenance procedures for Polished Concrete using diamond impregnated cleaning pads.

**1.5 QUALITY ASSURANCE**

- A. Certified Contractors:
  - 1. Pre-qualified contractors meeting **ALL** requirements set forth within specifications.
  - 2. No substitutions will be allowed or approved.
- B. Pre Pour Installation Conference: Conduct conference at project site to comply with requirements in Division 1 Sections "Special Conditions" and "Administrative Requirements".
- C. Provide project names, addresses, contact names, phone numbers of at least (5) three projects of similar scope, projects greater than 50,000 sq ft, completed by the installer.
- D. Installer/applicator shall be certified by concrete grinding/polishing equipment, chemical manufacturer and caulking manufacturer.
- E. Installer/applicator shall provide adequate number of skilled workmen who are thoroughly trained and experienced in the necessary craft.
- F. Manufacturer's Certification: Provide a letter of certification from both the equipment and chemical manufacturer stating that the installer is a Certified Contractor and is familiar with proper procedures and installation requirements recommended by the manufacturer.
- G. Mock-ups:
  - 1. General Contractor to notify applicator 7 days prior to pour to schedule finish of mock-up.
  - 2. Reserve 100 square feet for each color and finish at location adjacent to floor that will receive polish, but will be covered with another flooring material. Mock-up floor shall be placed on the same day, preferably the same pour as the floors to receive polish.
  - 3. Install mock-ups to verify selections made under sample submittal and to demonstrate methods and workmanship proposed for the project. If mock-up not possible, submitted samples will be accepted as demonstrated methods & workmanship.

4. Aggregate selected must be tested to ensure it will accept polish.
  5. If stand alone mockup required, form should be clean and free from extraneous substance and be at least a 12' x 12' with a level plywood bottom on level ground with unobstructed access around all four sides.
  6. Control joints should be included in mock-up. Sawing performed by General Contractor can begin as soon as the surface is firm enough not to displace any of the aggregate.
  7. Edges should be included in mock-up.
  8. Approved mock-ups may become part of the completed work if undisturbed at time of substantial completion.
- H. Protection: General Contractor shall protect areas to receive polished concrete finish at all times during construction to prevent oils, dirt, metal, excessive water and other potentially damaging materials from affecting the finished concrete surface. Protection measures listed below shall begin immediately after the concrete slab is poured:
1. All hydraulic powered equipment shall be diapered to avoid staining of the concrete.
  2. All vehicle parking shall be prohibited on the finish slab area. If necessary to complete their scope of work, drop cloths shall be placed under vehicles at all times.
  3. No pipe cutting machine shall be used on the finish floor slab.
  4. Steel shall not be placed on the finish slab to avoid rusting.
  5. Acids and acidic detergents will not come in contact with slab.
  6. All painters will use drop cloths on the concrete. If paint gets on the concrete, it must be immediately removed.
  7. All trades will be informed that the slab must be protected at all times.
- I. Environmental Limitations
1. Comply with manufacturers written instructions for substrate temperature and moisture content, ambient temperature and humidity, ventilation and other conditions affecting chemical performance.
- L. Flatness and levelness:
- a. Finish Concrete shall have a minimum Floor Flatness rating of at least 40.
  - b. Finish Concrete shall have a minimum Floor Levelness rating of at least 30.
  - c. Finish Concrete shall be cured a minimum of 28 days or at which point equipment can be put on the slab and does not displace aggregate.

- M. Application of finish system shall take place a minimum of 21 days prior to fixture & trim installation and/or substantial completion.
- N. Finish Concrete area shall be closed to traffic during finish floor application and after application, for the time as recommended by manufacturer.
- O. Concrete Mix Design:
  - 1. Concrete Mixture shall be 3000 PSI or higher, non air entrained.
    - a. Any admixtures, plasticizers, slag, fly ash or anything taking the place of Portland based cement shall be kept to a minimum.
    - b. The cement shall be Portland Cement Type I, conforming to ASTM C 150.
    - c. Maintain concrete temperature below 85 degrees. Keep concrete as cool and moist for as long as possible. In essence, decrease rate of hydration and drying to minimize cracking.
    - d. Wet cures are most suitable, but if this cannot be achieved, use a penetrating, dissipating or wax based cure and seal. Do not use a densifier/hardener material due to the grinding of the floor after 6 days.
    - e. All mix designs must be approved by Architect. Send all approved mix designs to Applicator.
    - f. The Engineer/Architect shall determine the saw cut patterns, color and layout.
    - g. Color loads for integral color should never be smaller than 3 cubic yards.
    - h. Use on source for cement, aggregates and pozzolans throughout the job. Monitor and control incoming material consistency. Do not use calcium chloride-based admixtures. Non-chloride admixtures may be used.
    - i. Wash out all drums before loading. Keep slumps consistent with a maximum of 4. Minimize driver added water maintaining a .45 water content ratio.
    - j. Place concrete to achieve as true and smooth a top surface as possible. Mounds, or dips are not acceptable. GC shall control overall flatness and levelness, including on sloping areas to within tolerances permitted by specification – ASTM E1155.
    - k. Slab shall be protected from indentation and footprints during pour and curing.

## **PART 2 PRODUCTS**

### **2.1 POLISHING MATERIALS**

- A. Three-phase 480 Volt generator.
- B. 3 head or 4 head counter rotating, variable speed, electric floor grinding/polishing machines with at least 600 pounds down pressure. For example: HTC 950RX, HTC 800 HD, SASE PDG 8000, Husqvarna PG 820. No substitutions allowed.
- C. HTC/Pullman Dust extraction system, pre-separator, and squeegee attachments with minimum flow rating of 322 cubic feet per minute such as the HTC 75D, HTC 86D, T8600, T12600, Bull 500, Bull 1250 & T55 or C5500. No substitutions allowed.
- D. Grinding tools:
  - 1. Metal bonded diamonds 16, 25, 40, 80, 150 and/or 300 grits.
  - 2. Resin bonded diamonds 100, 200, 400 and 800 grits.
- E. Grinding Pads for Edges
  - 1. 30, 60, and 120 grits.
  - 2. 100, 200, 400, and 800 grits.
- F. Hand Grinder with dust extraction attachment and pads.
- G. Densifier: a Concrete Hardener chemically reactive, waterborne solution of inorganic silicate or silicate materials and proprietary components; odorless; colorless which hardens and densifies concrete surfaces to protect against abrasion, dusting, and absorption of liquids.
  - 1. Pentra-Sil (NL); Lithium Silicate; Convergent Technologies
  - 2. Consolideck LS; Lithium Silicate; Prosoco
  - 3. Ameripolish 3D HS; Lithium Silicate; Ameripolish, Inc.
  - 4. Scofield Formula One Lithium Densifier; L.M. Scofield Company
  - 5. Approved equal
- H. Control Joint and Saw Cut Filler, two part polyurea.
  - 1. Euclid Quickjoint 200
  - 2. Hi-Tech HT-PE85
  - 3. Metzger McQuire RS-88
  - 4. Approved equal
- I. Stain Guard: Protect from debris and contaminants.
  - 1. Ameripolish 3D SP Guard; Ameripolish, Inc.
  - 2. Consolideck LSGuard; PROSOCO
  - 3. Scofield Formula One Guard-W; L.M. Scofield Company
  - 4. Approved equal
- J. Diamond Impregnated Polishing Pads
  - 1. Twister Polishing Pad; HTC
  - 2. TRIFECTA Polishing Pad; SASE Company
  - 3. Approved equal

**2.2 STAINING MATERIAL:** Not used

**2.3 EPOXY COATING:**

- A. Basis of Design: CSS Emulsion- concentrated solvent sealer by Elite Crete Systems.
- B. Location: Apparatus Bay
- C. Manufacturers: Substitutions per Division 1 based on Architect approval.

**PART 3 EXECUTION**

**3.1 PREPARATION**

- A. Installer shall examine and approve concrete substrate for conditions affecting performance of finish. General Contractor shall correct conditions that are found to be out of compliance with the requirements of this section. Repairs are not acceptable unless specifically approved on a case-by-case basis by the Architect.
- B. Verify that base slab meet finish and surface profile requirements listed in Division 3, Section "Cast in Place Concrete".
- C. Provide floor clean of materials and debris.
- D. Protect adjacent surfaces as required to prevent damage by the concrete polishing procedure.
- E. Setup grinding machine, dust extraction system, tooling, and generator.
- F. Ensure floor cured to accept polishing application.

**3.2 POLISHED CONCRETE APPLICATION**

- A. Applicator shall examine the areas and conditions under which work of this section will be provided and the General Contractor shall correct conditions detrimental to the timely and proper completion of the work and the Applicator shall not proceed until unsatisfactory conditions are resolved.
- B. Fill construction joints and cracks with filler products as specified in accordance with manufacturers instructions colored to match (or contrast) with concrete color as specified by architect. All control joint and decorative saw cut filling must be preformed prior to grinding application.

- C. Grind the concrete floor to within 2 -3 inches of walls with 16, 25, 40 and 80 grit removing construction debris, floor slab imperfections and until there is a uniform scratch pattern and desired concrete aggregate exposure is achieved. Vacuum the floor thoroughly using a squeegee vacuum attachment. Utilize the least aggressive diamond tooling necessary to remove all debris and to achieve uniform scratch pattern.
- D. Grind the edges with 30, 60, and 120 grit grinding pads, prior to grinding the floor with each step on the larger diamond grinder, removing all of the scratches from the previous grit. Vacuum the floor thoroughly after each grind, using a squeegee vacuum attachment.
- E. Grind the floor to within 2 - 3 inches of walls with metal bonded diamond grits of 150 and/or 300, grinding 90 degrees from each previous grind and removing all the scratches from the previous grit. Vacuum the floor thoroughly after each grind, using a squeegee vacuum attachment.
- F. Polish the floor with resin bonded diamond grits of 100, 200, 400, first polishing the edges (if specified) with pads of the same grit and then the field of the floor, removing all scratches from the previous grit. After each polish, clean the floor thoroughly using a vacuum with a squeegee attachment. After the 400 grit polishing step thoroughly clean the floor with a mop or auto-scrubber to prepare for dye (if specified).
- G. (If Specified) Apply dye color per Manufacturer's recommendations. Apply 2 coats of dye to achieve desired coloration.
- H. Apply densifying impregnator undiluted as per manufacturer's specifications and guidelines. Cover the entire work area liberally and allow to sit for 10 minutes. Apply again to areas where the densifying impregnator has soaked in and allow to sit for an additional 30 minutes. Squeegee excess material off the floor.
- I. Polish the floor with resin bonded diamond grit of 800, first polishing the edges (If specified) with pads of the same grit and then the field of the floor, removing all scratches from the previous grit. After polishing, clean the floor thoroughly using clean water and an auto-scrubber or a mop and a wet vacuum.
- J. Apply CSS Emulsion with a microfiber applicator and burnish with a fine, 800 grit, or very fine, 1500 grit, diamond impregnated cleaning pad.
- K. Upon completion, the work shall be ready for final inspection and acceptance by the customer.

### **3.3 PROTECTION**

- A. Plywood slab protection in traffic corridors, entry ways, and dining room shall be provided by and maintained by General Contractor throughout construction until the polishing contractor takes ownership of the floor.

## **PART 4 SCHEDULES**



**4.1 SHEEN**

- A. Polished Concrete Level 2 (Medium Gloss Finish):
  - 1. At a distance of 30 to 50 feet, the floor will reveal moderate reflection.
    - a. Yield a 40-60 degree sheen, as measured by a Horiba IG-310

**4.2 EXPOSED AGGREGATE**

- A. Minimal exposure, Salt and Pepper

**4.3 EDGES**

- A. Polished
- B. Edge Tint

**4.4 STAIN COLOR:** None

**END OF SECTION 03368**

**SECTION 10 75 00**

**FLAGPOLES**

**PART 1-GENERAL**

1.1 RELATED DOCUMENTS:

- A. Drawings and general provisions of the Contract, including General and Supplementary Conditions and Division 1 Specification sections, apply to work of the section
- B. Related work specified elsewhere includes:
  - 1. Section 03 30 00 – Cast-in-Place Concrete

1.2 SUMMARY

- A. Extent and location of each type of flagpole is shown on the Drawings; (1) One required.
- B. Work under this Section includes ground set flagpole, bas, lightning protection and ground, fittings, accessories, concrete footing, and all other items necessary or required for a complete and properly functioning installation.

1.3 SUBMITTALS:

- A. Product Data: Submit manufacturer's technical data accessories, finishes and installation instructions for each type of flagpole required.

1.4 QUALITY ASSURANCE:

- A. Manufacturing Standards: Provide each flagpole as a complete unit, produced by a single manufacturer, including fittings, accessories, bases and anchorage devices.
- B. Design Criteria: Provide flagpoles and installations constructed to withstand a 90-mph wind velocity minimum when flying one flag of appropriate size. Use heavy pipe sizes if required for flagpole type and height shown.
- C. Pole Construction: Construct pole and ship to site in one piece if possible. If more than one piece is necessary, provide snug-fitting, precision joints with self-aligning, internal splicing sleeve arrangement for weather tight, hairline field joints.

**1.5 DELIVERY, STORAGE and HANDLING:**

- A. Spiral wrap flagpoles with heavy Kraft paper or other protective wrapping and prepare for shipments in hard fiber tube or other protective container.
- B. Deliver flagpoles and accessories completely identified for installation procedure. Handle and store flagpoles to prevent damage or soiling.

**PART 2-PRODUCTS****2.1 ACCEPTABLE MANUFACTURERS:**

- A. Manufacturer: Subject to compliance with requirements, provide products of one of the following:
  - 1. American Flagpole & Flag Co.
  - 2. American Flagpole; a Kearney-National Inc. company.
  - 3. Atlantic Fiberglass Products, Inc.
  - 4. Baartol Company.
  - 5. Concord Industries, Inc.
  - 6. Eder Flag Manufacturing Company, Inc.
  - 7. Ewing Flagpoles.
  - 8. Lingo Inc.; Acme Flagpole Company Division.
  - 9. Millerbernd Manufacturing Company.
  - 10. Morgan-Francis; Division of Original Tractor Cab Co., Inc.
  - 11. PLP Composite Technologies, Inc.
  - 12. Pole-Tech Company Inc.
  - 13. U.S. Flag & Flagpole Supply, LP.
  - 14. USS Manufacturing Inc.

**2.2 FLAGPOLE TYPE:**

- A. Aluminum Flagpoles: Fabricate aluminum flagpoles from seamless extruded tubing complying with ASTM B 241, alloy 6063-T6, having a minimum wall thickness indicated, tensile strength not less than 35,000 psi and a yield point of 30,000 psi. Heat-treat and age-harden flagpoles after fabrication.
  - 1. Provide tapered aluminum tube flagpole; for flying one flag.
  - 2. Exposed Height: Provide (1) one 20-foot flagpole.

3. Manufacturer- Basis of Design: American Flagpole. Provide complete with all standard and specified accessories.

- a. Catalog No. – ESS30B41-AA
- b. Exposed height: 20 ft.
- c. Butt Diameter: 4 in.
- d. Wall Thickness: 0.125 in.
- e. Set depth: 3 ft.
- f. Total length: 33 ft.
- g. Taper: 11'-0"
- h. Top diameter: 3 in.
- i. Wind Speed: 60 mph max. with flag; 90 mph without flag
- j. Flag Size: 3'x 5'
- k. Standard Finish: Anodized, clear

### 2.3 FLAGPOLE MOUNTING:

A. Provide manufacturer's standard base system for the type flagpole installation required.

1. Foundation Tube: For ground-set [verify] flagpoles, provide 16-gage minimum galvanized corrugated steel tube, or 12-gage minimum rolled steel tube, sized to suit flagpole and installation. Furnish complete with welded steel bottom base and support plate, lighting ground spike, and steel centering wedges, all welded construction. Provide loose hardwood wedges at top for plumbing pole after erection. Galvanized steel parts after assembly, including foundation tube.

- a. Provide manufacturer's standard spun aluminum collar, finished to match flagpole.

### 2.4 SHAFT FINISH:

A. Aluminum: Fine, directional, mechanical Satin polish (NAAMM-32), finished as follows:

1. Clear Anodic Finish: AAMA 611, AA-M12C22A41, Class I, 0.018 mm, or thicker.

## 2.5 FITTINGS:

- A. Finial Ball: Manufacturer's standard flush seam ball, size as indicated or, if not indicated, to match pole butt diameter.
  1. Finish to match flagpole.
- B. Truck: Ball-bearing non-fouling, revolving, double-track assembly of cast metal, finished to match pole shaft.
- C. Cleats: One 9" heavy duty cast aluminum cleat with stainless steel fasteners, finished to match pole shaft.
- D. Halyards: Provide one continuous halyard for each flagpole, as follows:
  1. Nylon, braided, with metal core; Size 3/8" (No. 12)
- E. Halyard Flag Snaps: Provide 2 swivel snaps per halyard; Chromium-plated bronze.

## **PART 3-EXECUTION**

### 3.1 INSTALLATION:

- A. Excavation: Excavate for foundation concrete to neat clean lines in undisturbed soil. Provide forms where required due to unstable soil conditions. Remove wood, loose soil, rubbish and other foreign matter from excavation, and moisten earth before placing concrete.
- B. Concrete: Refer to Section 03 30 00 – Cast-in-Place Concrete, for 3,000 psi concrete and related requirements.
  1. Place concrete immediately after mixing. Perform chuting to avoid segregation of mix. Compact concrete in place by use of vibrators to consolidate. Moist-cure exposed concrete for not less than 7 days, or use a non-staining curing compound in freezing weather.
  2. Finish trowel exposed concrete surfaces to smooth, dense surface. Provide positive slope for water runoff to base perimeter.

- C. Flagpole Installation: Install flagpoles as shown and in compliance with final shop drawings and manufacturer's written instructions and recommendations.
1. Provide positive lightning ground for each flagpole installation.
    - a. Paint portions of ground-set flagpole below grade with a heavy coat of bituminous paint, and allow to properly dry and cure, prior to setting in place and pouring concrete.

**END OF SECTION 10 75 00**

## SECTION 12 32 16

**MANUFACTURED PLASTIC-LAMINATE-CLAD CASEWORK****PART 1 - GENERAL**

## 1.1 RELATED DOCUMENTS

- A. Drawings and general provisions of Contract, including General and **Special Conditions** and Division 1 - Specification sections, apply to work of this section.

## 1.2 WORK INCLUDED

- A. The extent of manufactured casework systems as shown on drawings, schedules, and specified herein. Where specific materials, finishes, construction details, and hardware are specified herein, the casework contractor shall be held in strict accordance. All items shall be as provided, and publicly cataloged, by the manufacturers to assure physical and dimensional integrity of the system and ready access to additional systems components for a minimum of ten (10) years after completion of this contract. Product from companies not meeting this requirement will not be accepted. It is the intent of the owner and architect and construction manager to have this specification section furnished by one contractor. The work includes fabrication and installation of.
- B. Furnish and install all fixed, modular, flexible rail mounted, and mobile laminate clad casework, tops, accessories and components, fillers and related items shown on drawings and herein specified. All built-in and modular plastic laminate countertops, splashes as specified herein and detailed on architectural drawings.
- C. Provide QCP Registered Certificate upon request at time of bid, and as a part of Shop Drawings.
- D. Furnish and install all locks for cabinet doors and drawers as indicated on elevations of the architectural drawings.
- E. Furnish and install all keyboard trays as shown on the drawings.
- F. Furnish and install closet shelving and rods as indicated on Drawings and herein specified.

**1.3 RELATED WORK SPECIFIED ELSEWHERE**

- A. Sinks and service fixtures, service and waste lines and all connections, vents, electrical service fixtures, hoods and ducting within or adjacent to casework, or otherwise required in all areas. Furnished and installed under Mechanical and Electrical Divisions 23 and 26.
- B. Any & all type required and indicated Base molding: Furnished and installed under Finishes Division 9.
- C. Appliances, unless specifically noted on plans or in other Sections shall be included in this section.
- D. Furnishing, installing and connecting of service supply lines and conduits within equipment and casework and all final connections.
- E. Installing all utility service outlet accessory fittings and fixtures furnished by casework contractor, pulling of wire and connecting of electrical fixtures in service lines, provision of ground fault protection for circuits requiring such.
- F. Furnishing, installing and connecting all traps, tailpieces, backflow prevention devices and special plumbing fittings and piping of unusual nature to meet local codes even though not specifically called for in specifications or shown on drawings.
- G. Furnishing and installing of all framing, bucks, metal grounds or reinforcements in walls, floors, ceilings to adequately support and anchor casework and related equipment.
- H. Furnishing and installation of all rigid or flexible conduit, wire, pulling of wire, fittings, special electrical equipment, data and accessories including boxes, receptacles; flush plates required at the circulation desk .
- I. General Contractor or Owner shall furnish hoisting or elevator service, where available, at no charge to casework contractor.

**1.4 SYSTEM DESCRIPTION**

- A. All manufactured casework shall be pre-engineered, and cataloged in a nationally published catalog. Manufacturers submitting for approval must provide printed catalog information documenting this performance feature; no exceptions will be allowed.



**1.5 QUALITY ASSURANCE**

- A. All manufactured casework systems, countertops and related items herein specified shall be furnished by one contractor to insure single source responsibility, and integration with other building trades.
- B. All manufacturers herein listed, shall show evidence of a minimum of five (5) years experience in providing manufactured casework systems for similar types of projects.
- C. Manufacturer shall produce evidence of adequate facilities and personnel required to perform on this project. Financial stability of manufacturer shall be evidenced by readily providing a material performance bond if required.
- D. Refer to Division 1 Section "Special Conditions" for additional information and requirements related to minimum experience requirements.
- E. Manufactured casework systems must conform to design, quality of materials, workmanship and function and finishes and colors as shown on drawings and specified herein. Any manufacturers not meeting this AWI certification are prohibited from bidding, no exceptions.
- F. Provide independent laboratory testing documenting that the support rail and interfacing components when tested in strict accordance with the requirements of seismic construction codes, all components met or exceeded the requirements as set forth by the codes. All bidders must provide a copy of test to architect ten days prior to bid date.
- G. All proposed casework shall meet the following minimums loads / design strengths:
  - 1. Racking Test (must exceed 975 lbs.)
  - 2. Front Joint Load Test (must exceed 635lbs.)
  - 3. Uniform Load Shelf Test (must exceed 1140 lbs.)
  - 4. Isolated Shelf Clip Load Test (must exceed 225 lbs.)
  - 5. Static Load Test (must exceed 1800 lbs with no cabinet failure)
  - 6. Draw Side Joint Test (must exceed 425 lbs.)
  - 7. Draw Front Joint Test (must exceed 925lbs.)

- H. Provide independent laboratory testing documenting that the support rail and interfacing components when tested in strict accordance with the requirements of seismic construction codes, all components will meet or exceed the requirements as set forth by the codes.
- I. The owner requires the following minimal depths for the plastic laminate cabinets to allow certain items needing to be stored to fit completely inside the cabinets. These measurements shall be determined from the inside back of the cabinet, to the front side edge of the cabinet.
1. All 13" deep open cabinets & 14" deep door cabinets shall have an 11-1/2" inside clear dimension.
  2. All 15" deep open cabinets & 16" deep door cabinets shall have a 13-1/2" inside clear
  3. All 17" deep open cabinets & 18" deep door cabinets shall have a 15-1/2" inside clear dimension.
  4. All 23" deep open cabinets & 24" deep door cabinets shall have a 21-1/2" inside clear dimension.
  5. All 28" deep open cabinets & 29" deep door cabinets shall have a 26-1/2" inside clear dimension.
  6. All drawers depths shall be two inches are less from the back of the cabinet. All bidders must provide documentation to the architect stating their casework is in compliance with these requirements ten (10) days prior to the bid date.
- J. The Architect and Owner reserve the right to randomly select one 36" wide base cabinet and one 36" wide wall cabinet and one 36" wide tall cabinet from each manufacturer during installation and cut apart to determine if the product installed meets the written specification. The casework manufacturer shall include the price to replace these units in their bid. If the product fails to comply with specifications the casework manufacturer and/or supplier shall be responsible for all necessary corrections until compliant with requirements, at no additional cost to the Owner.

## 1.6 SUBMITTALS

### A. Product Data:

1. In addition to the general conditions as relates to prior approvals, submit complete manufacturer's data; elevations, details and sections;

manufacturer's installation and maintenance instructions; sample warranties and guarantees; and samples of cabinets and components are required upon Architect's request.

B. Samples:

1. Submit samples of casework manufacturer's standard decorative laminate colors, patterns, and textures for exposed and semi-exposed materials for architect's selection. Samples of other materials or hardware shall be made available if requested.
2. Architect may request representative full-size samples for evaluation prior to approval. Samples may be impounded by architect/owner until completion of project to ensure compliance with specifications.
3. Submit copy of Seismic testing report.

C. Shop Drawings / Production Drawings:

1. Submit production drawings for all casework systems and countertops and required equipment, ends, cross-sections, face modular values, service run spaces and location of services.
2. Include layout of units with relation to surrounding walls, doors, windows, and other building components.
3. Coordinate production drawings with other work and trades involved.

1.7 PRODUCT HANDLING

- A. Deliver casework and countertops only after wet operations in building are completed.
- B. Store completed casework and countertops in a ventilated place, protected from the weather, with relative humidity range of 20% to 50%.
- C. Protect finished surfaces from soiling and damage during handling and installation.
- D. General Contractor shall be responsible for protection of all casework and tops after installation is completed.
- E. Refer to Division 1 Sections "Summary of Work" and "**Special Conditions**" for additional information and requirements regarding stored materials.

**1.8 JOB CONDITIONS**

- A. Humidity and Temperature Controls: Before the delivery and installation of casework and equipment, building conditions shall be as follows:
1. The building shall be secure and weather tight, with windows and doors installed, heat and air conditioning systems functional.
  2. Walls and openings shall be plumb, straight and square. Concrete floors shall be level within acceptable trade tolerances. Specifically the floor must be within 1/8" of level per 10 foot run, non-accumulative, when tested with a straight edge in any one direction.
  3. Flooring required to be placed under casework and equipment must be installed.
  4. Wood or metal blocking (wall grounds) shall be installed within partitions prior to delivery of casework and furnishings to allow for immediate installation on delivery.
  5. General Contractor shall have heat and air conditioning systems providing consistent temperature and humidity conditions as required. Related humidity must be maintained at not less than 25%, nor more than 55%. Temperatures must not range lower than 65 degrees F, not to exceed 80 degrees F in areas of material installation.
  6. All overhead mechanical, electrical or plumbing rough-in work shall be complete.
  7. Any "wet" operation performed by other trades must be complete prior to delivery.
  8. Ceiling grids (with or without ceiling tiles), overhead soffits, duct work and lighting shall be installed.
  9. Painting shall be complete.
  10. General Contractor shall provide a secure storage area within the building that is clean, dry well ventilated, and protected from direct sunlight and broom clean.

1.9 WARRANTY

- A. Special Project Warranty/Guarantee: All plastic laminate casework, all other products herein specified, and all materials and workmanship shall be guaranteed by the manufacturer for a period of 5 years from the date of project Substantial Completion.
  - 1. Any defective materials and/or workmanship shall be reported by the Owner and shall be promptly repaired or replaced by the manufacturer subject to Owner's approval and at no expense to the owner, within 15 days thereafter.
  - 2. In the event the manufacturer fails to make repairs or replacements in compliance with requirements, the Owner may elect to have repairs made by others at the expense of the manufacturer and with no effect on any remaining warranty or guarantee.
  
- B. In-Service Training Seminar:
  - 1. The casework system contractors shall conduct a one day in-service training seminar for all staff, including facility maintenance personnel. The program will be held prior to move in or at the convenience of owner representatives.
  - 2. Seminar shall include orientation of use of casework system(s), maintenance of casework and description of modularity and /or relocation of system components.
  
- C. The Warranty and Guarantee shall be in addition to and run concurrent with other warranties and guarantees made by the Contractor under the requirements of the Contract Documents, and shall not be construed to limit or otherwise deprive the Owner of any other rights the Owner may have for remedy.

**PART 2 – PRODUCTS**

2.1 PLASTIC LAMINATE CASEWORK

- A. Manufacturers: Subject to compliance with requirements, provide products by one of the following:
  - 1. Casework Systems:

- a. Cabinets By Design; Duluth, GA
  - b. Case Systems, Inc.; Midland, MI
  - c. Interior Wood Specialties, Inc.; Highpoint, NC
  - d. LSI Corporation of America, Inc.; Minneapolis, MN
  - e. Stevens Industries, Inc.; Teutopolis, IL
  - f. TMI Systems Design Corporation; Dickinson, ND (Basis of design)
  - g. Westmark Products, Inc.; Tacoma, WA
  - h. Remmert & Company; Tuscaloosa, AL
  - i. RPA, Inc.
  - j. Phipps Cabinets, Inc.
  - k. Tailored Living, LLC
2. Plastic Laminate: Subject to compliance with requirements, provide solid, stippled, textured, and/or patterned high pressure decorative laminates of one of the following:
- a. Formica Corporation.
  - b. Micarta Division, Westinghouse Electric Corporation.
  - c. Nevamar Division, International Paper Co.
  - d. Ralph Wilson Plastics Co.
  - e. or Approved equal
- B. General:
1. For purpose of determining minimum performance and quality standards for the plastic laminate casework herein specified, the drawings and specifications are based on manufacturer's literature from TMI SYSTEMS DESIGN CORPORATION; Dickinson, North Dakota; Phone: 1-800-456-6716, by one of the above named preapproved manufacturers, for all fixed, modular, flexible rail mounted, mobile plastic laminate casework, plastic laminate tops, and accessories. Construction and features shall be in accordance with TMI catalog, fixed modular, flexible rail mounted, and mobile plastic laminate casework, tops and accessories. Products of other manufacturers may be considered for preapproval based on

complete and properly submitted request indicating compliance with all requirements of this specification and submitting all required documents and guarantees to architect at least 10 days prior to Bid date. Any deviations from this specification shall be listed. Proof of equivalency shall be the sole responsibility of the proposer. Refer to Division 1 Section "Special Conditions" for additional information and requirements regarding submittals and substitutions. Any additional preapproved manufacturers will be issued by the Architect in writing or by addendum only.

2. All flexible wall and under counter cabinets, under counter support brackets, that are an integral part of the system, shall be provided with "ADA Justable" hardware package allowing for component placement in strict compliance with Accessibility Guidelines of the Americans with Disabilities Act (ADA-AG), as required. All units shall be readily adjustable to accommodate specialized ADA-AG height requirements when needed and returned to more traditional stand-up and/or sit-down heights when needs change. All changes may be accomplished without special tools or procedures and with no alterations to building construction and/or finishes. Flexible systems not meeting this requirement will be rejected; no exceptions. Manufacturer to provide brochure to the architect specifically depicting ADA-AG requirements and system compliance ten days prior to bid opening.

B. Substitutions:

1. It is the intent of this specification to establish performance and quality criteria consistent with pre-established standards of design and function herein described. Casework systems not meeting these minimum standards will not be accepted.
2. Where specific materials finish options, construction details, modularity, hardware and test data are specified herein, the casework storage system will be held in strict compliance. Substitutions will be considered prior to bid date provided request is submitted to the Architect in writing no later than ten (10) days prior to bid date; substitution request shall list any and all deviations from this specification. Acceptable substitutions be issued by the Architect in writing or by addendum only.

## 2.2 MATERIALS

A. Core Materials:

1. Particleboard up to 7/8 inch thick: Industrial Grade average 47-pound density particleboard, ANSI A 208.1-1993, M-3.

2. Particleboard 1 inch thick and thicker: Industrial Grade average 47-pound density particle-board, ANSI A 208.1-1993, M-2.
  3. MR Moisture Resistant Particleboard: Average 47-pound density particleboard, ANSI A 208.1 1-1993, M-3.
  4. Medium Density Fiberboard: Average 47-pound density grade, ANSI A 208.2.
  5. Grade A-B Plywood
- B. Hardboard: 1/4 inch thick prefinished hardboard, CS-251.
- C. Decorative Laminates:
1. High-pressure decorative laminate VGS (.028), NEMA Test LD 3-1995. for vertical surfaces.
  2. High-pressure decorative laminate HGS (.048), NEMA Test LD 3-1995 for horizontal surfaces.
  3. High-pressure decorative laminate HGP (.039), NEMA Test LD 3-1995 for post formed tops.
  4. High-pressure cabinet liner CLS (.020), NEMA Test LD 3-1995. where required for balance construction of closed cabinets and herein specified.
  5. High-pressure backer BKH (.048), (.039), (.028), NEMA Test LD3-1995. where required for balance construction of closed cabinets.
  6. Thermally fused melamine laminate, NEMA Test LD 3-1995 where required for open and closed cabinet interiors to create balance construction.
- D. Laminate Color Selection: Maximum 1 color per unit face and 5 colors per project.
- E. Edging Materials:
1. 1 mm PVC banding, where required and herein specified.
  2. 3mm PVC banding, machine profiled to 1/8 inch radius where required and herein specified.



## 2.3 SPECIALTY ITEMS

## A. Metal Parts:

1. Countertop support brackets, under-counter support frames, legs and miscellaneous metal parts shall be furniture steel, welded, degreased, cleaned, treated and epoxy powder painted. Color shall be as selected by Architect, from these three color offerings: Dove Grey, Frosty White, or Light Beige.

## B. Hinges:

1. Furnish five knuckle, epoxy powder coated, institutional grade, 2-3/4 inch overlay type with hospital tip.0.095 inch thick. ANSI-BHMA standard A156.9, Grade 1.
  - a. Doors 48 inch and over in height shall have 3 hinges per door.
  - b. Provide a magnetic door catch with maximum 5 pound pull provided, attached with screws and slotted for adjustment.

## C. Pulls:

1. Door and drawer front pulls, brushed chrome, 96mm spacing on screws, or equivalent priced pulls selected by Architect after bidding. Pull design shall comply with the Accessibilities Guidelines of the Americans with Disabilities Act (ADA-AG).

## D. Drawer Slides:

1. Regular, knee space and pencil slides shall be 100-pound load rated epoxy coated steel, bottom corner mounted with smooth and quiet nylon rollers and have a positive stop both directions with self-closing feature. Paper storage units shall have 150-pound load rated epoxy coated steel slides.
2. File: Full extension, Shall have 150-pound load rated epoxy coated steel, bottom corner mounted with smooth and quiet nylon rollers and have positive stop both directions with self-closing feature.

## E. Adjustable Shelf Supports:

1. Injection molded transparent polycarbonate friction shall fit into cabinet end panels and vertical dividers, adjustable on 32mm centers. Each shelf support shall have 2 integral support pins, 5mm diameter, to interface pre-

drilled holes, and to prevent accidental rotation of support. The support shall automatically adapt to 3/4 inch or 1 inch thick shelving and provide a non-tip feature for shelving. Supports may be field fixed if desired. Structural load to 1200 pounds (300 pounds per support) without failure.

F. Locks:

1. Shall be National #M49054, removable core, disc tumbler, cam style lock with strike, as part of a grand master keying system. Keys in each room where lockable cabinets occur shall be keyed alike and master keyed. Furnish 2 keys per lock and 5 grand master keys. Lock for sliding 3/4 inch doors shall be a disc type plunger lock, sliding door type with strike, keyed alike and master keyed. Lock for sliding glass/acrylic doors shall be a ratchet type sliding showcase lock, keyed alike and master keyed.
2. Automatic door bolt shall be equivalent to Hafele #530-1604, used to secure inactive door on all locked cabinets.

G. Sliding Door Track: Shall be extruded, anodized aluminum double channel.

H. Coat Rods: Shall be 1 inch diameter, 14-gauge chrome plated steel installed in captive mounting hardware.

I. Closet rods & closet Shelves:

1. Closet rods shall be 1 inch diameter plated steel. The shelves shall be 3/4 inch Melamine covered plywood with 1 mm PVC edging all four sides.

J. File Suspension System:

1. Shall be extruded plastic file suspension rails. File followers, or other split bottom hardware, will not be acceptable. Provide one file suspension system for every required file drawer.

K. Mirrors: To be 1/4 inch thick polished mirror plate, with edge and back sealer.

2.4 FABRICATION:

A. Fabricate casework, countertops and related products to dimensions, profiles, and details shown.

B. Cabinet Body Construction:

1. Tops and bottoms are glued and doweled to cabinet sides and internal cabinet components such as fixed horizontals, rails and verticals. Minimum 6 dowels each joint for 24 inch deep cabinets and a minimum of

4 dowels each joint for 12 inch deep cabinets or Mod-Eez Fasteners installed per AWI Guidelines.

- a. Tops, bottoms and sides of all cabinets are 3/4 inch thick particleboard core.
2. Cabinet backs: 1/4 inch thick pre-finished hardboard or 1/2 inch particleboard. Wall and tall cabinets are provided with a 1 inch x 1-3/4 inch PVC mounting strip used to secure the cabinet to the wall.
  - a. Exposed back on fixed or movable cabinets: 3/4 inch particleboard with the exterior surface finished in VGS laminate as selected.
  - b. Flexible rail mounted cabinet backs: 3/4 inch thick particleboard structurally doweled into cabinet sides and top panels.
3. Fixed base and tall units have an individual factory-applied base, constructed of 3/4 inch exterior grade plywood. Base is 96mm (nominal 4 inch) high unless otherwise indicated on the drawing.
4. Base units, except sink base units: Full sub-top. Sink base units are provided with open top, a welded steel/epoxy painted sink rail full width at top front edge concealed behind face rail/doors, a split back removable access panel.
5. Side panels and vertical dividers shall receive adjustable shelf hardware at 32mm line boring centers. Mount door hinges, drawer slides and pull-out shelves in the line boring for consistent alignment.
6. Exposed and semi exposed edges
  - a. Edging: 1mm PVC
7. Adjustable shelf core: one inch thick particleboard for all shelves
  - a. Front edge: 1mm PVC.
8. Interior finish, units with open Interiors:
  - a. Top, bottom, sides, horizontal and vertical members, and adjustable shelving faces with thermally fused melamine laminate with matching prefinished back.
9. Interior finish, units with closed and exposed Interiors:

- a. Top, bottom, sides, horizontal and vertical members, and adjustable shelving faces with thermally fused melamine laminate with matching prefinished back.

10. Exposed ends:

- a. Faced with VGS high-pressure decorative laminate.

11. Wall unit bottom:

- a. Faced with thermally fused melamine laminate.

12. Wall and tall unit tops:

- a. Top surface is faced with thermally fused melamine laminate.

13. Balanced construction of all laminated panels is mandatory. Unfinished core stock surfaces, even on concealed surfaces (excluding edges), not permitted.

C. Drawers:

1. Sides, backs and sub fronts: Minimum 1/2 inch thick particleboard, laminated with thermally fused melamine doweled and glued into sides. Top edge banded with 1mm PVC.
2. Drawer bottom: Minimum 1/2 inch thick particleboard laminated with thermally fused melamine, screwed directly to the bottom edges of drawer box. 1/4" thick drawer bottoms will ONLY be accepted IF FULLY ENCASED BY SIDES.
3. Paper storage drawers: Minimum 3/4 inch thick particleboard sides, back, and sub front laminated with thermally fused melamine. Minimum 1/2 inch thick particleboard drawer bottoms screwed directly to the bottom edges of the drawer box. Provide PVC angle retaining bar at the rear of the drawer. 1/4" thick drawer bottoms will ONLY be accepted IF FULLY ENCASED BY SIDES.

D. Door/Drawer Fronts:

1. Core: 3/4 inch thick particleboard.
2. Provide double doors in opening in excess of 24 inches wide.

3. Faces:
  - a. Exterior: VGS High-pressure decorative laminate.
  - b. Interior: High-pressure cabinet liner CLS.
4. Door/drawer edges: 3mm PVC, external edges and outside corners machine profiled to 1/8 inch radius.
5. Miscellaneous Shelving:
  - a. Core material: 3/4 inch or 1 inch particleboard.
  - b. Exterior: VGS High-pressure decorative laminate.
  - c. Edges: 3mm PVC, external edges and outside corners machine profiled to inch radius

## 2.5 COUNTERTOPS

- A. Laminate Tops: All shall be nominal 1" thick laminate clad countertops as shown on the drawings and shall be constructed with 1" particleboard core or moisture resistant particleboard as called for and have a laminated top face with GP50 (.050) high pressure decorative laminate, with BK20 backer underside. Furnish moisture resistant particleboard tops and splashes at all sink locations. Moisture resistant particleboard cores shall extend 36" of either side of center line of sink. Provide tight joint fasteners where needed. All exposed edges, including edges of backsplash where used, shall have 3mm PVC banding, machine applied with waterproof hot melt adhesive. Exposed edges and corners shall be machine profiled to 1/8" radius for safety. Edging color shall be as selected by architect. Furnish 4" high back splashes where indicated.

## 2.6 COLOR SELECTION:

- A. Laminate Color Selection: Exteriors
  1. Selected from the full range of Wilsonart® stock color charts for cabinet faces, exposed ends, open interiors, and countertops.
- B. Hinge and Pull Color Selection:
  1. Selected from stock colors matched to White, Beige, Gray, Black and Chrome.

- C. Miscellaneous Hardware Color Selection (support brackets, table frames, rail):
  - 1. Selected from stock colors matched to White, Beige, Gray and Black.
- D. 1mm PVC Edge Banding Color Selection:
  - 1. Selected from 1mm PVC stock colors matched to White, Beige, Gray and Black or a color matching Wilson-Art Stock VGS laminates, if available.
- E. 3mm PVC Edge Banding Color Selection:
  - 1. Selected from 3mm PVC stock VGS laminate colors matched to White, Beige, Gray and Black or a color matching Wilson-Art Stock VGS laminates, if available
- F. The interior cabinet material color for all fully enclosed cabinets only to be selected from manufacturer's full color range.

**PART 3 - EXECUTION**

3.1 INSPECTION:

- A. The casework contractor shall examine the job site and the conditions under which the work under this section is to be performed, and notify the building owner in writing of unsatisfactory conditions. Do not proceed with work under this Section until satisfactory conditions have been corrected in a manner acceptable to the installer.

3.2 SITE EXAMINATION

- A. Verification by supplier required prior to installation to ensure that site condition are ready to receive system and dimensions are in compliance with manufacturer instructions.

3.3 PREPARATION

- A. Condition casework to average prevailing humidity conditions in installation areas prior to installing.

3.4 INSTALLATION

- A. Erect casework, plumb, level, true and straight with no distortions. Shim as required. Where laminate clad casework abuts other finished work, scribe and cut to accurate fit.

- B. Adjust casework and hardware so that doors and drawers operate smoothly without warp or bind.
- C. Repair minor damage per plastic laminate manufacturer's recommendations. Replace other damaged cabinets or materials.

3.5 CLEANING:

- A. Leave cabinets broom clean inside and out. Wipe off fingerprints, pencil marks, and surface soil etc., in preparation for final cleaning by the building owner.
- B. Remove and dispose of all packing materials and related construction debris.

**END OF SECTION 12 32 16**

THIS PAGE INTENTIONALLY LEFT BLANK



Revisions		
No.	Date	Description
1	2/19/25	ADDENDUM #3




100% CD'S

**IRONDALE FIRE STATION #3**  
 2101 JOHN ROGERS DR  
 BIRMINGHAM, AL 35210  
 CITY OF IRONDALE

CHARLES WILLIAMS & ASSOCIATES ARCHITECTS  
 3601 8TH AVE. SOUTH BIRMINGHAM, ALABAMA 35222  
 PH: 205-250-0700  
 FAX: 205-250-0515

**CWA**  
 SHEET TITLE: SITE LAYOUT PLAN  
 PROJECT NUMBER: CWA No. 2023-01  
 DATE: 8/30/24  
 DRAWN BY: WCV  
 CHECKED BY: CIE  
 SHEET NUMBER: **C1.0**

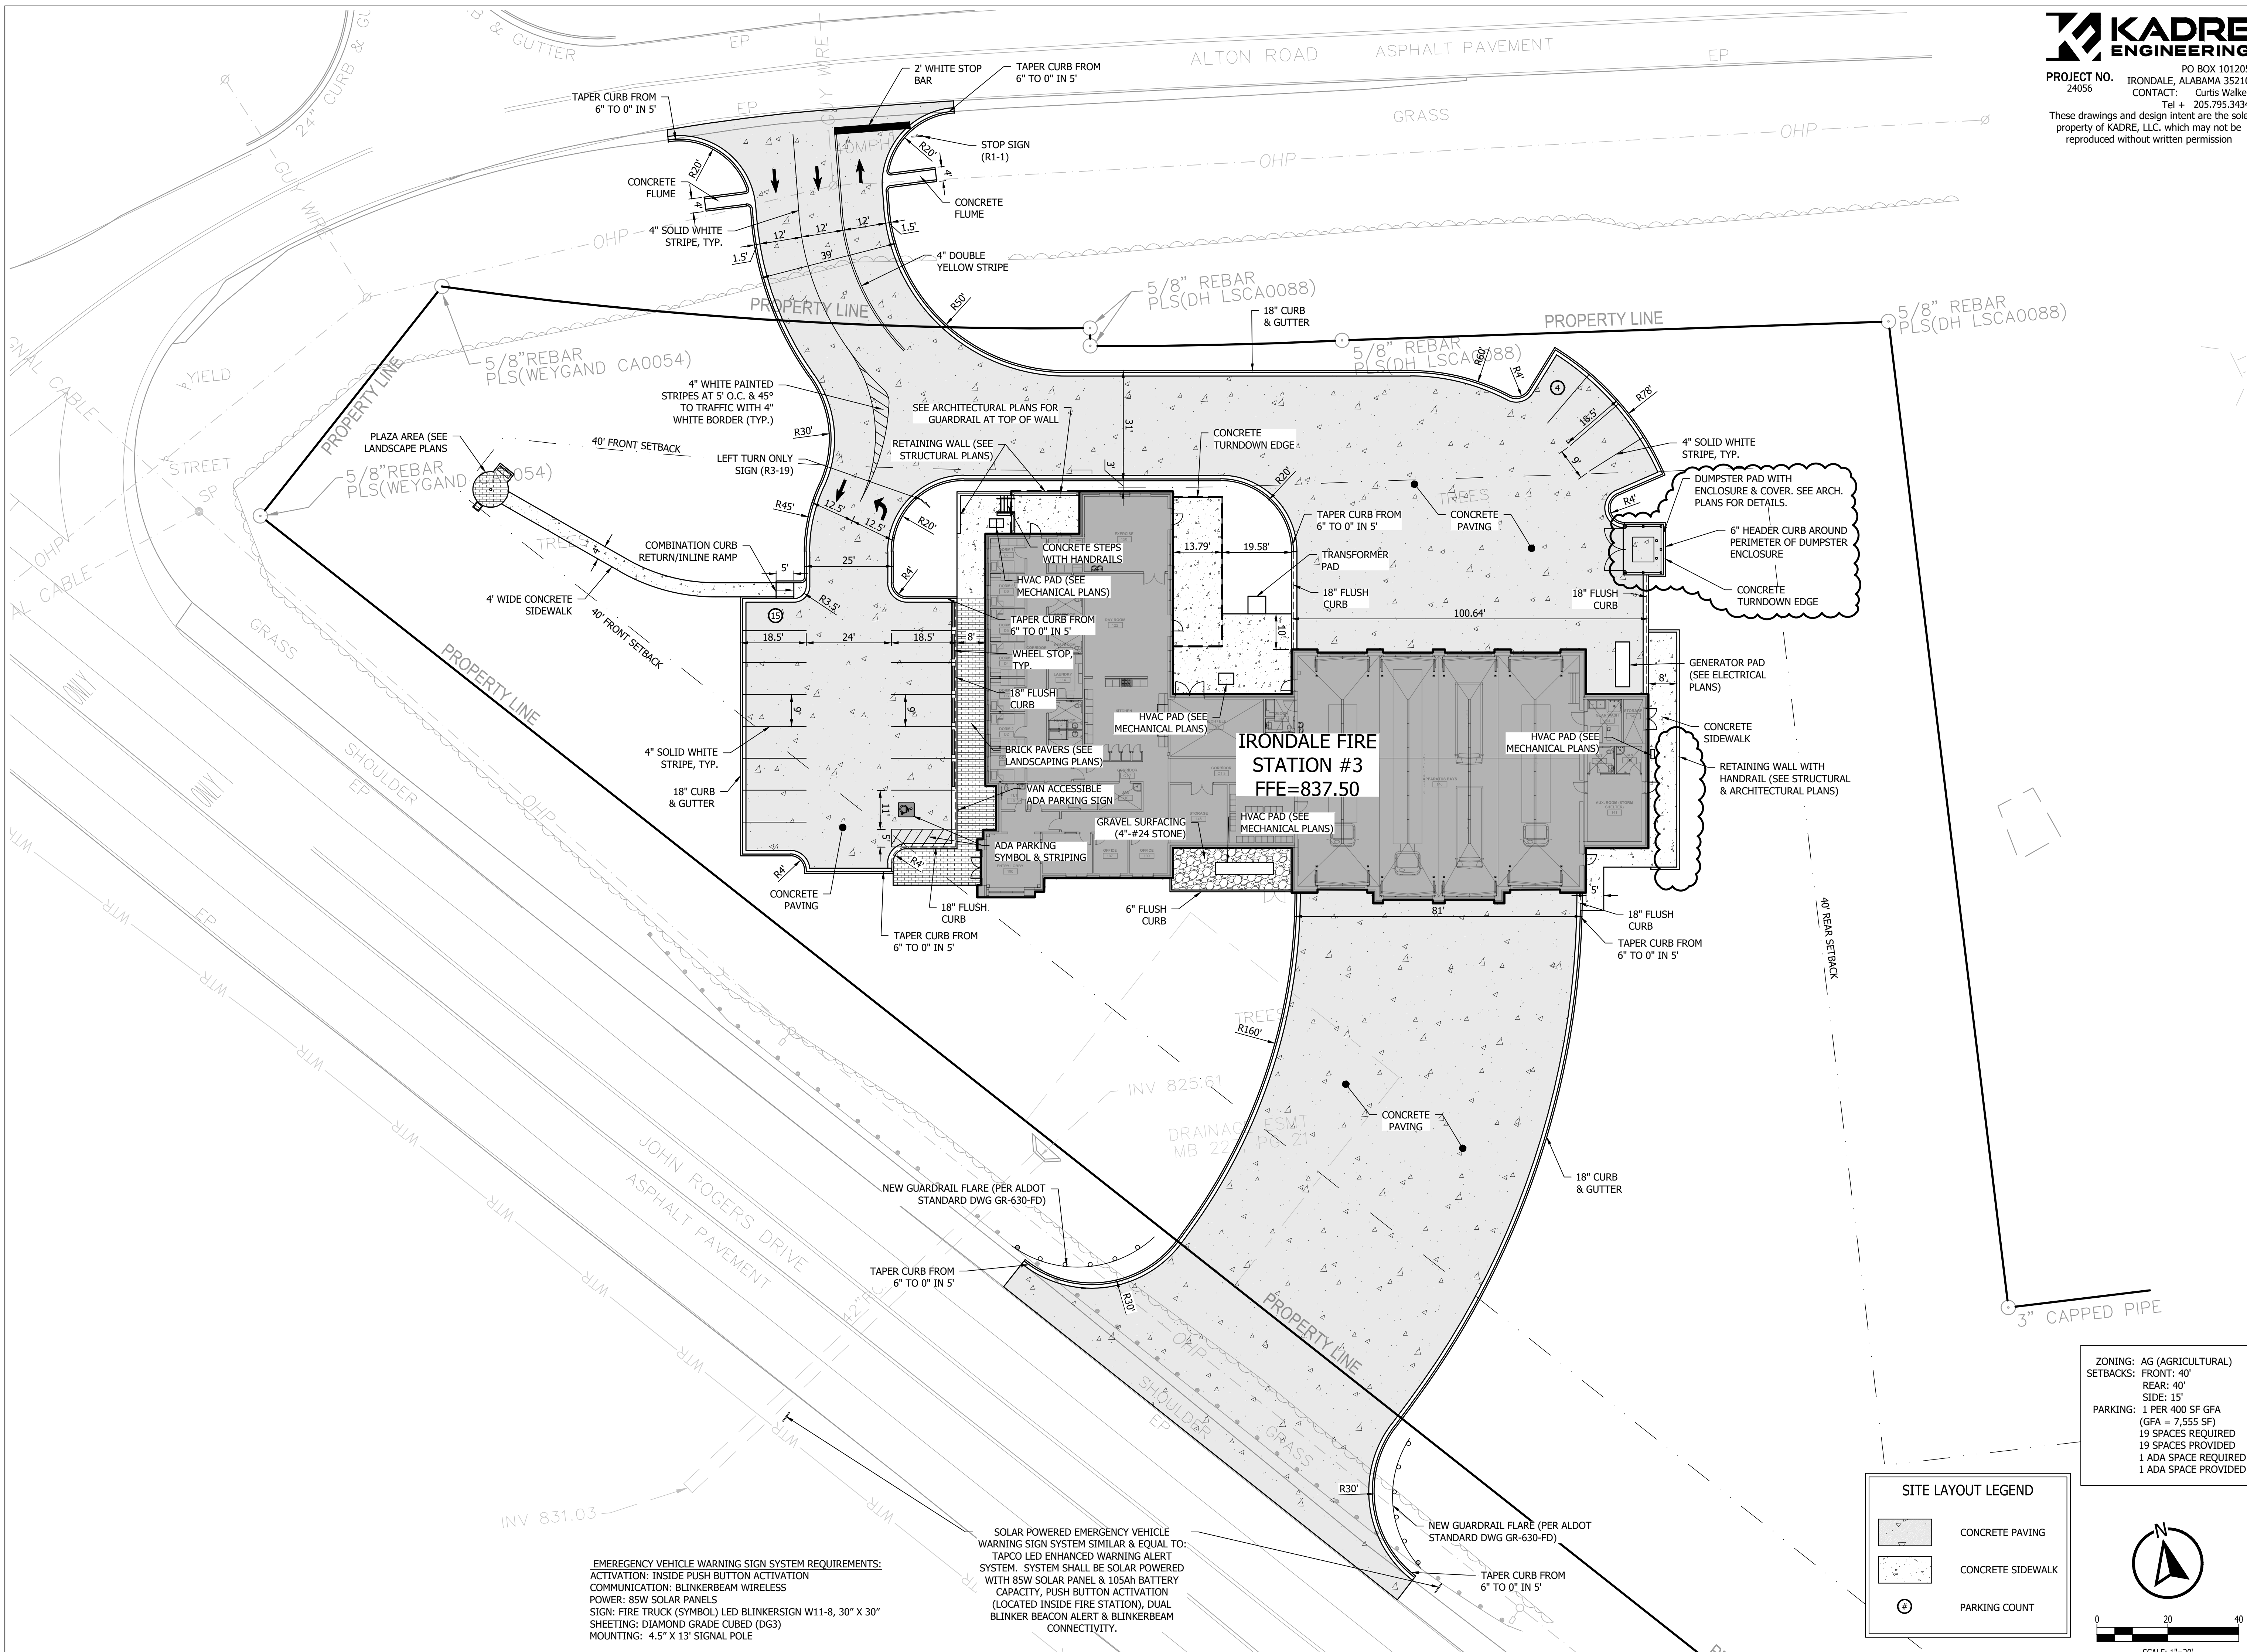


**EMERGENCY VEHICLE WARNING SIGN SYSTEM REQUIREMENTS:**  
 ACTIVATION: INSIDE PUSH BUTTON ACTIVATION  
 COMMUNICATION: BLINKERBEAM WIRELESS  
 POWER: 85W SOLAR PANELS  
 SIGN: FIRE TRUCK (SYMBOL) LED BLINKERSIGN W11-8, 30" X 30"  
 SHEETING: DIAMOND GRADE CUBED (DG3)  
 MOUNTING: 4.5" X 13" SIGNAL POLE

**SOLAR POWERED EMERGENCY VEHICLE WARNING SIGN SYSTEM SIMILAR & EQUAL TO:**  
 TAPCO LED ENHANCED WARNING ALERT SYSTEM. SYSTEM SHALL BE SOLAR POWERED WITH 85W SOLAR PANEL & 105AH BATTERY CAPACITY, PUSH BUTTON ACTIVATION (LOCATED INSIDE FIRE STATION), DUAL BLINKER BEACON ALERT & BLINKERBEAM CONNECTIVITY.

ZONING: AG (AGRICULTURAL)  
 SETBACKS: FRONT: 40'  
 REAR: 40'  
 SIDE: 15'  
 PARKING: 1 PER 400 SF GFA (GFA = 7,555 SF)  
 19 SPACES REQUIRED  
 19 SPACES PROVIDED  
 1 ADA SPACE REQUIRED  
 1 ADA SPACE PROVIDED


**SITE LAYOUT LEGEND**

	CONCRETE PAVING
	CONCRETE SIDEWALK
	PARKING COUNT

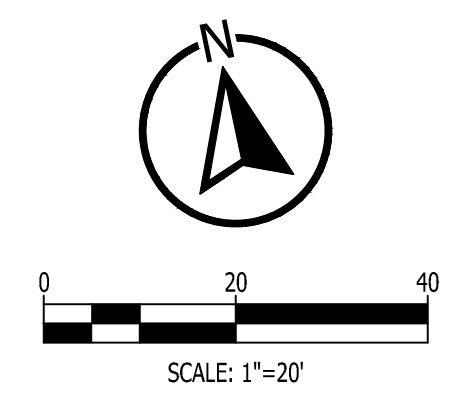



Revisions		
No.	Date	Description
1	2/19/25	ADDENDUM #3

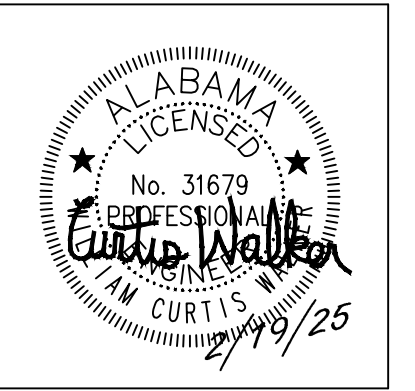


100% CD'S

**IRONDALE FIRE STATION #3**  
 2101 JOHN ROGERS DR  
 BIRMINGHAM, AL 35210  
 CITY OF IRONDALE

CHARLES WILLIAMS & ASSOCIATES ARCHITECTS  
 PH: 205-250-0700  
 3601 8TH AVE. SOUTH BIRMINGHAM, ALABAMA 35222  
 FAX: 205-250-0515


SHEET TITLE: **SITE GRADING PLAN**  
 PROJECT NUMBER: **CWA No. 2023-01**  
 DATE: **8/30/24**  
 DRAWN BY: **WCW** CHECKED BY: **CIE**  
 SHEET NUMBER: **C2.0**

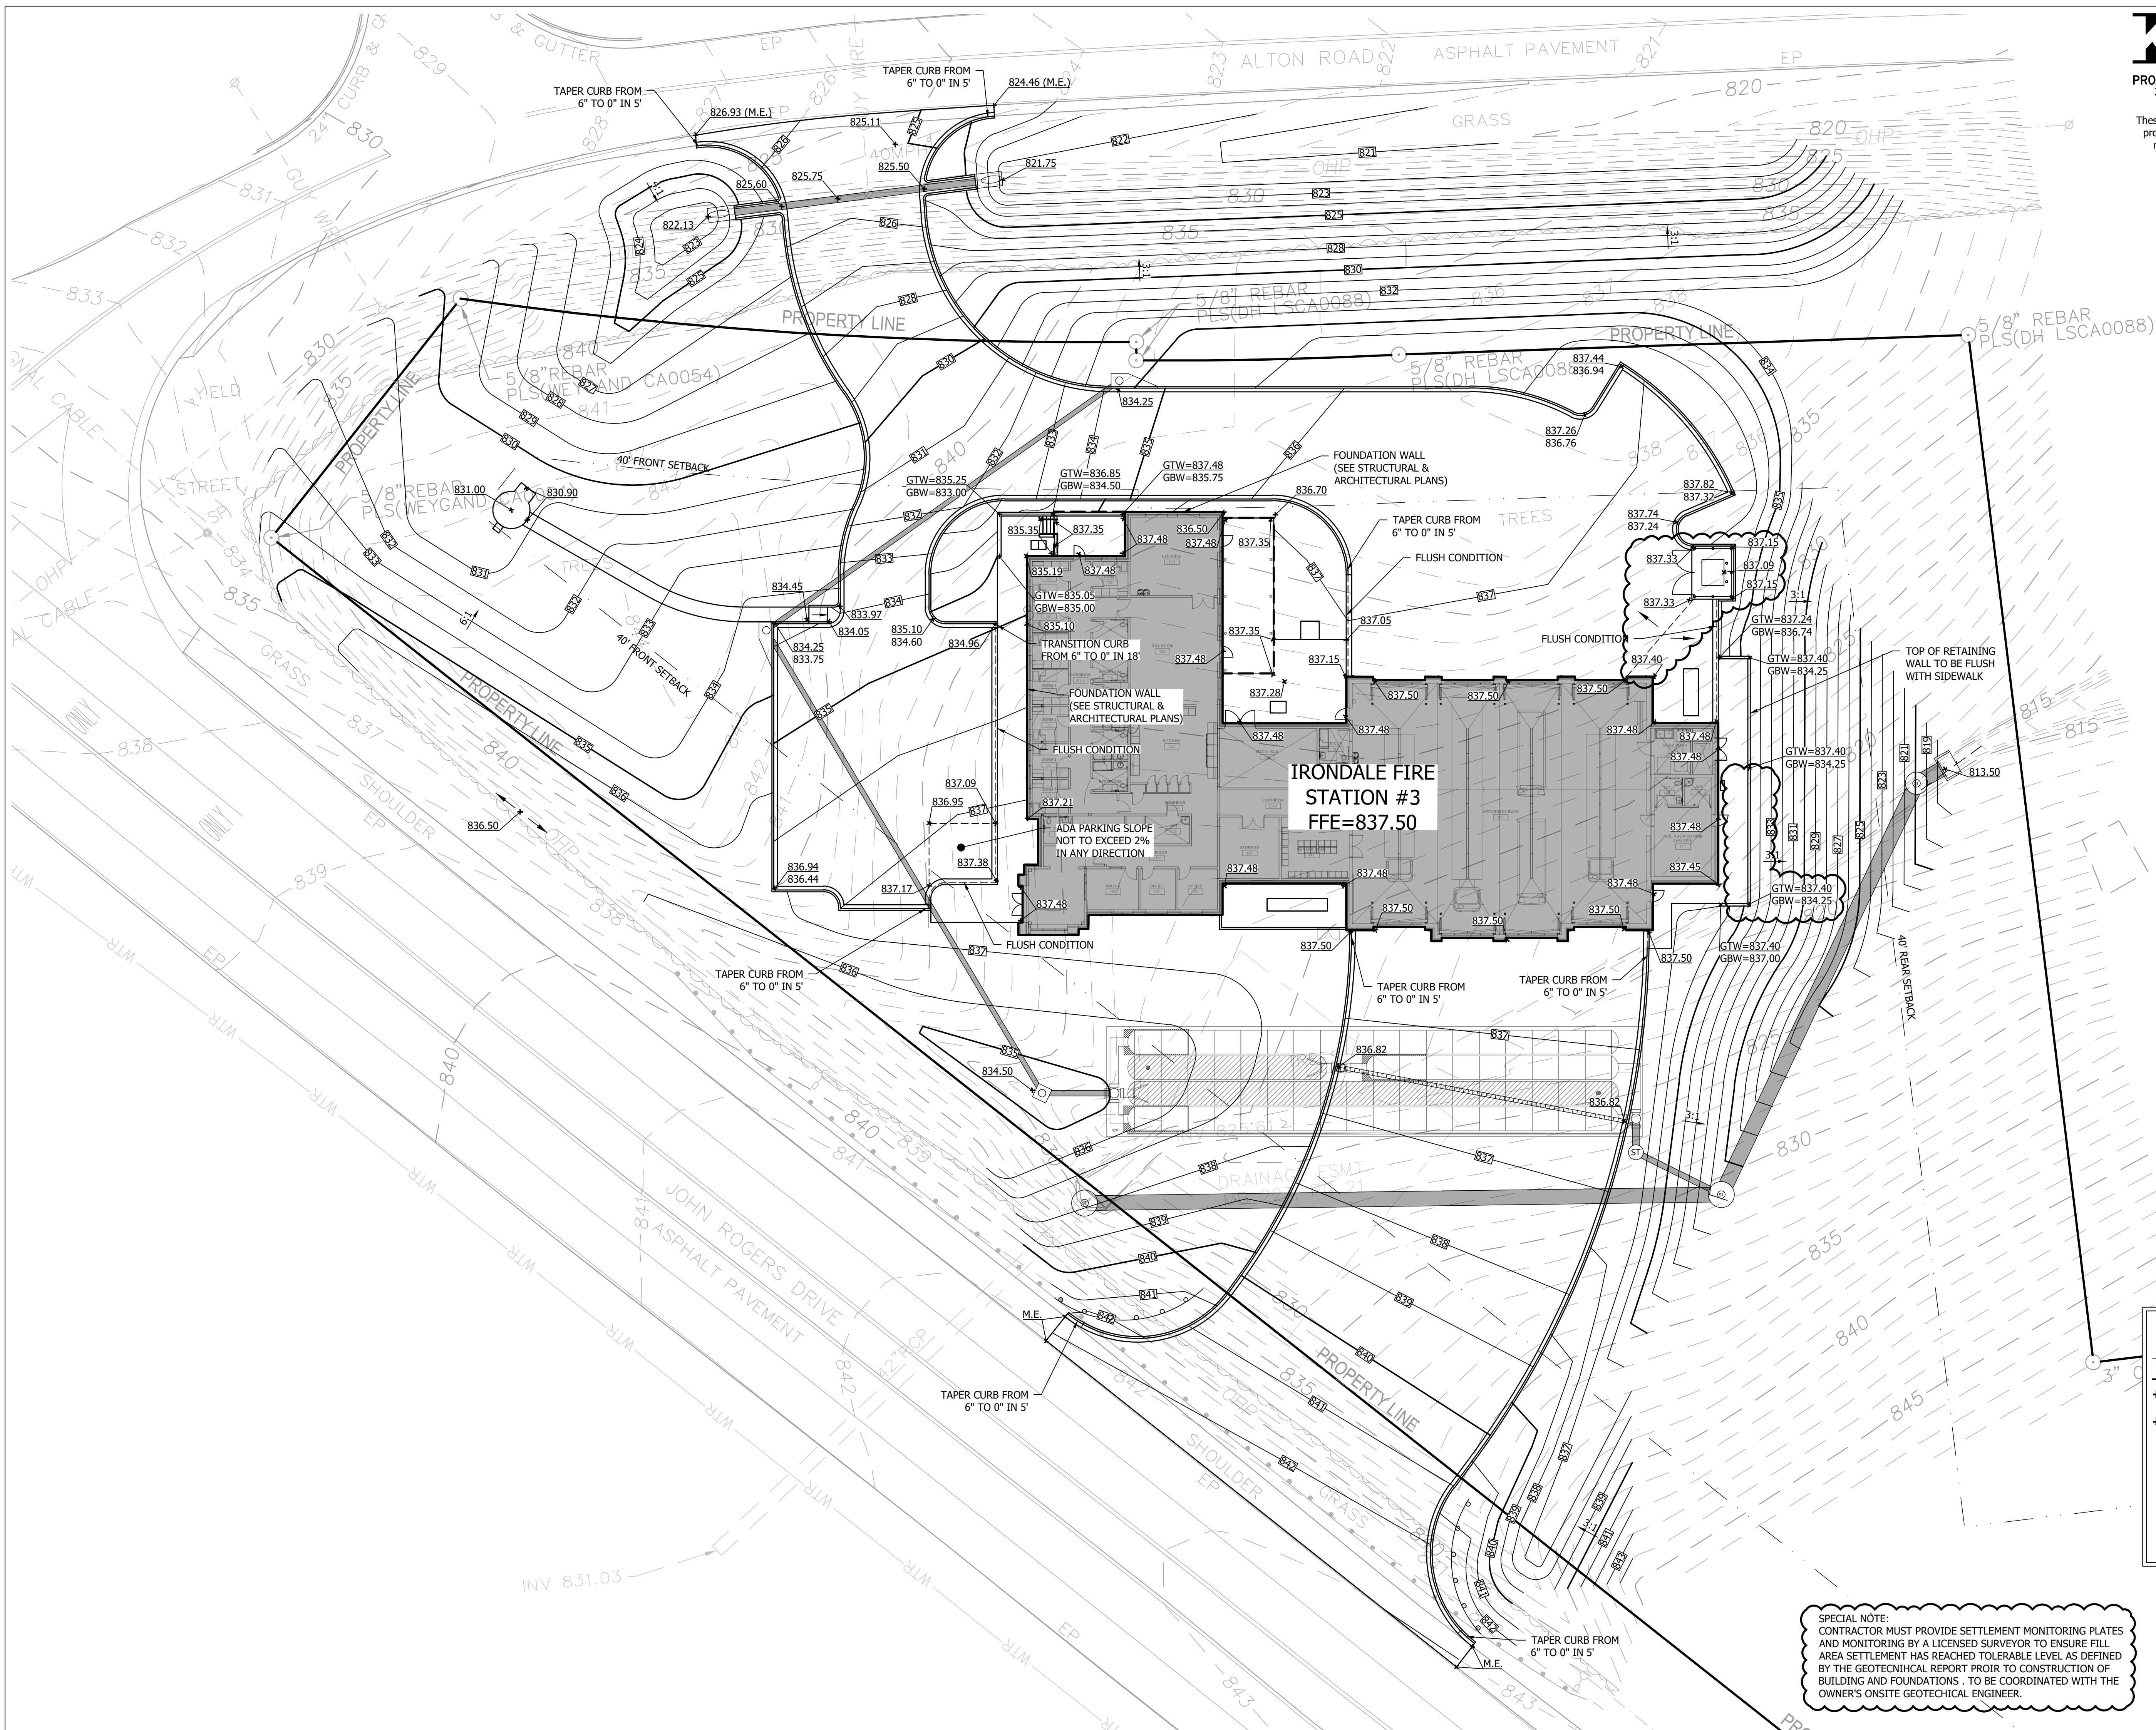

**GRADING LEGEND**


50.1	MINOR CONTOUR
50.0	MAJOR CONTOUR
500.00	SPOT ELEVATION
500.50	TOP OR CURB ELEV
500.00	BOTTOM OF CURB ELEV
GTW	FINISHED GRADE ELEV ON HIGH SIDE OF WALL
GBW	FINISHED GRADE ELEV ON LOW SIDE OF WALL
M.E.	MATCH EXISTING ELEV

**SPECIAL NOTE:**  
 CONTRACTOR MUST PROVIDE SETTLEMENT MONITORING PLATES AND MONITORING BY A LICENSED SURVEYOR TO ENSURE FILL AREA SETTLEMENT HAS REACHED TOLERABLE LEVEL AS DEFINED BY THE GEOTECHNICAL REPORT PRIOR TO CONSTRUCTION OF BUILDING AND FOUNDATIONS. TO BE COORDINATED WITH THE OWNER'S ONSITE GEOTECHNICAL ENGINEER.

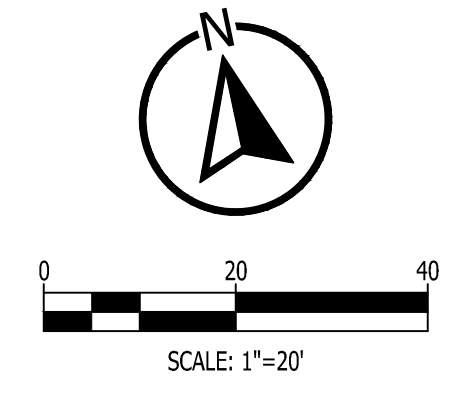



Revisions		
No.	Date	Description
1	2/19/25	ADDENDUM #3

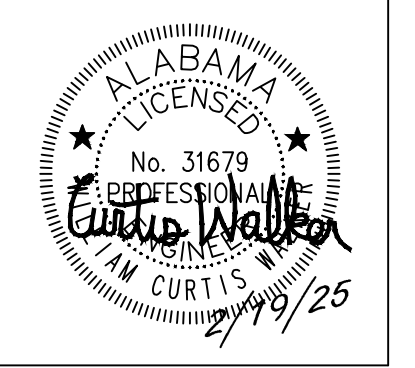


100% CD'S

**IRONDALE FIRE STATION #3**  
 2101 JOHN ROGERS DR  
 BIRMINGHAM, AL 35210  
 CITY OF IRONDALE

CHARLES WILLIAMS & ASSOCIATES ARCHITECTS  
 PH: 205-250-0700  
 3601 8TH AVE. SOUTH BIRMINGHAM, ALABAMA 35222  
 FAX: 205-250-0515


SHEET TITLE: SITE DRAINAGE PLAN  
 PROJECT NUMBER: CWA No. 2023-01  
 DATE: 8/30/24  
 DRAWN BY: WCV CHECKED BY: CIE  
 SHEET NUMBER: **C2.1**

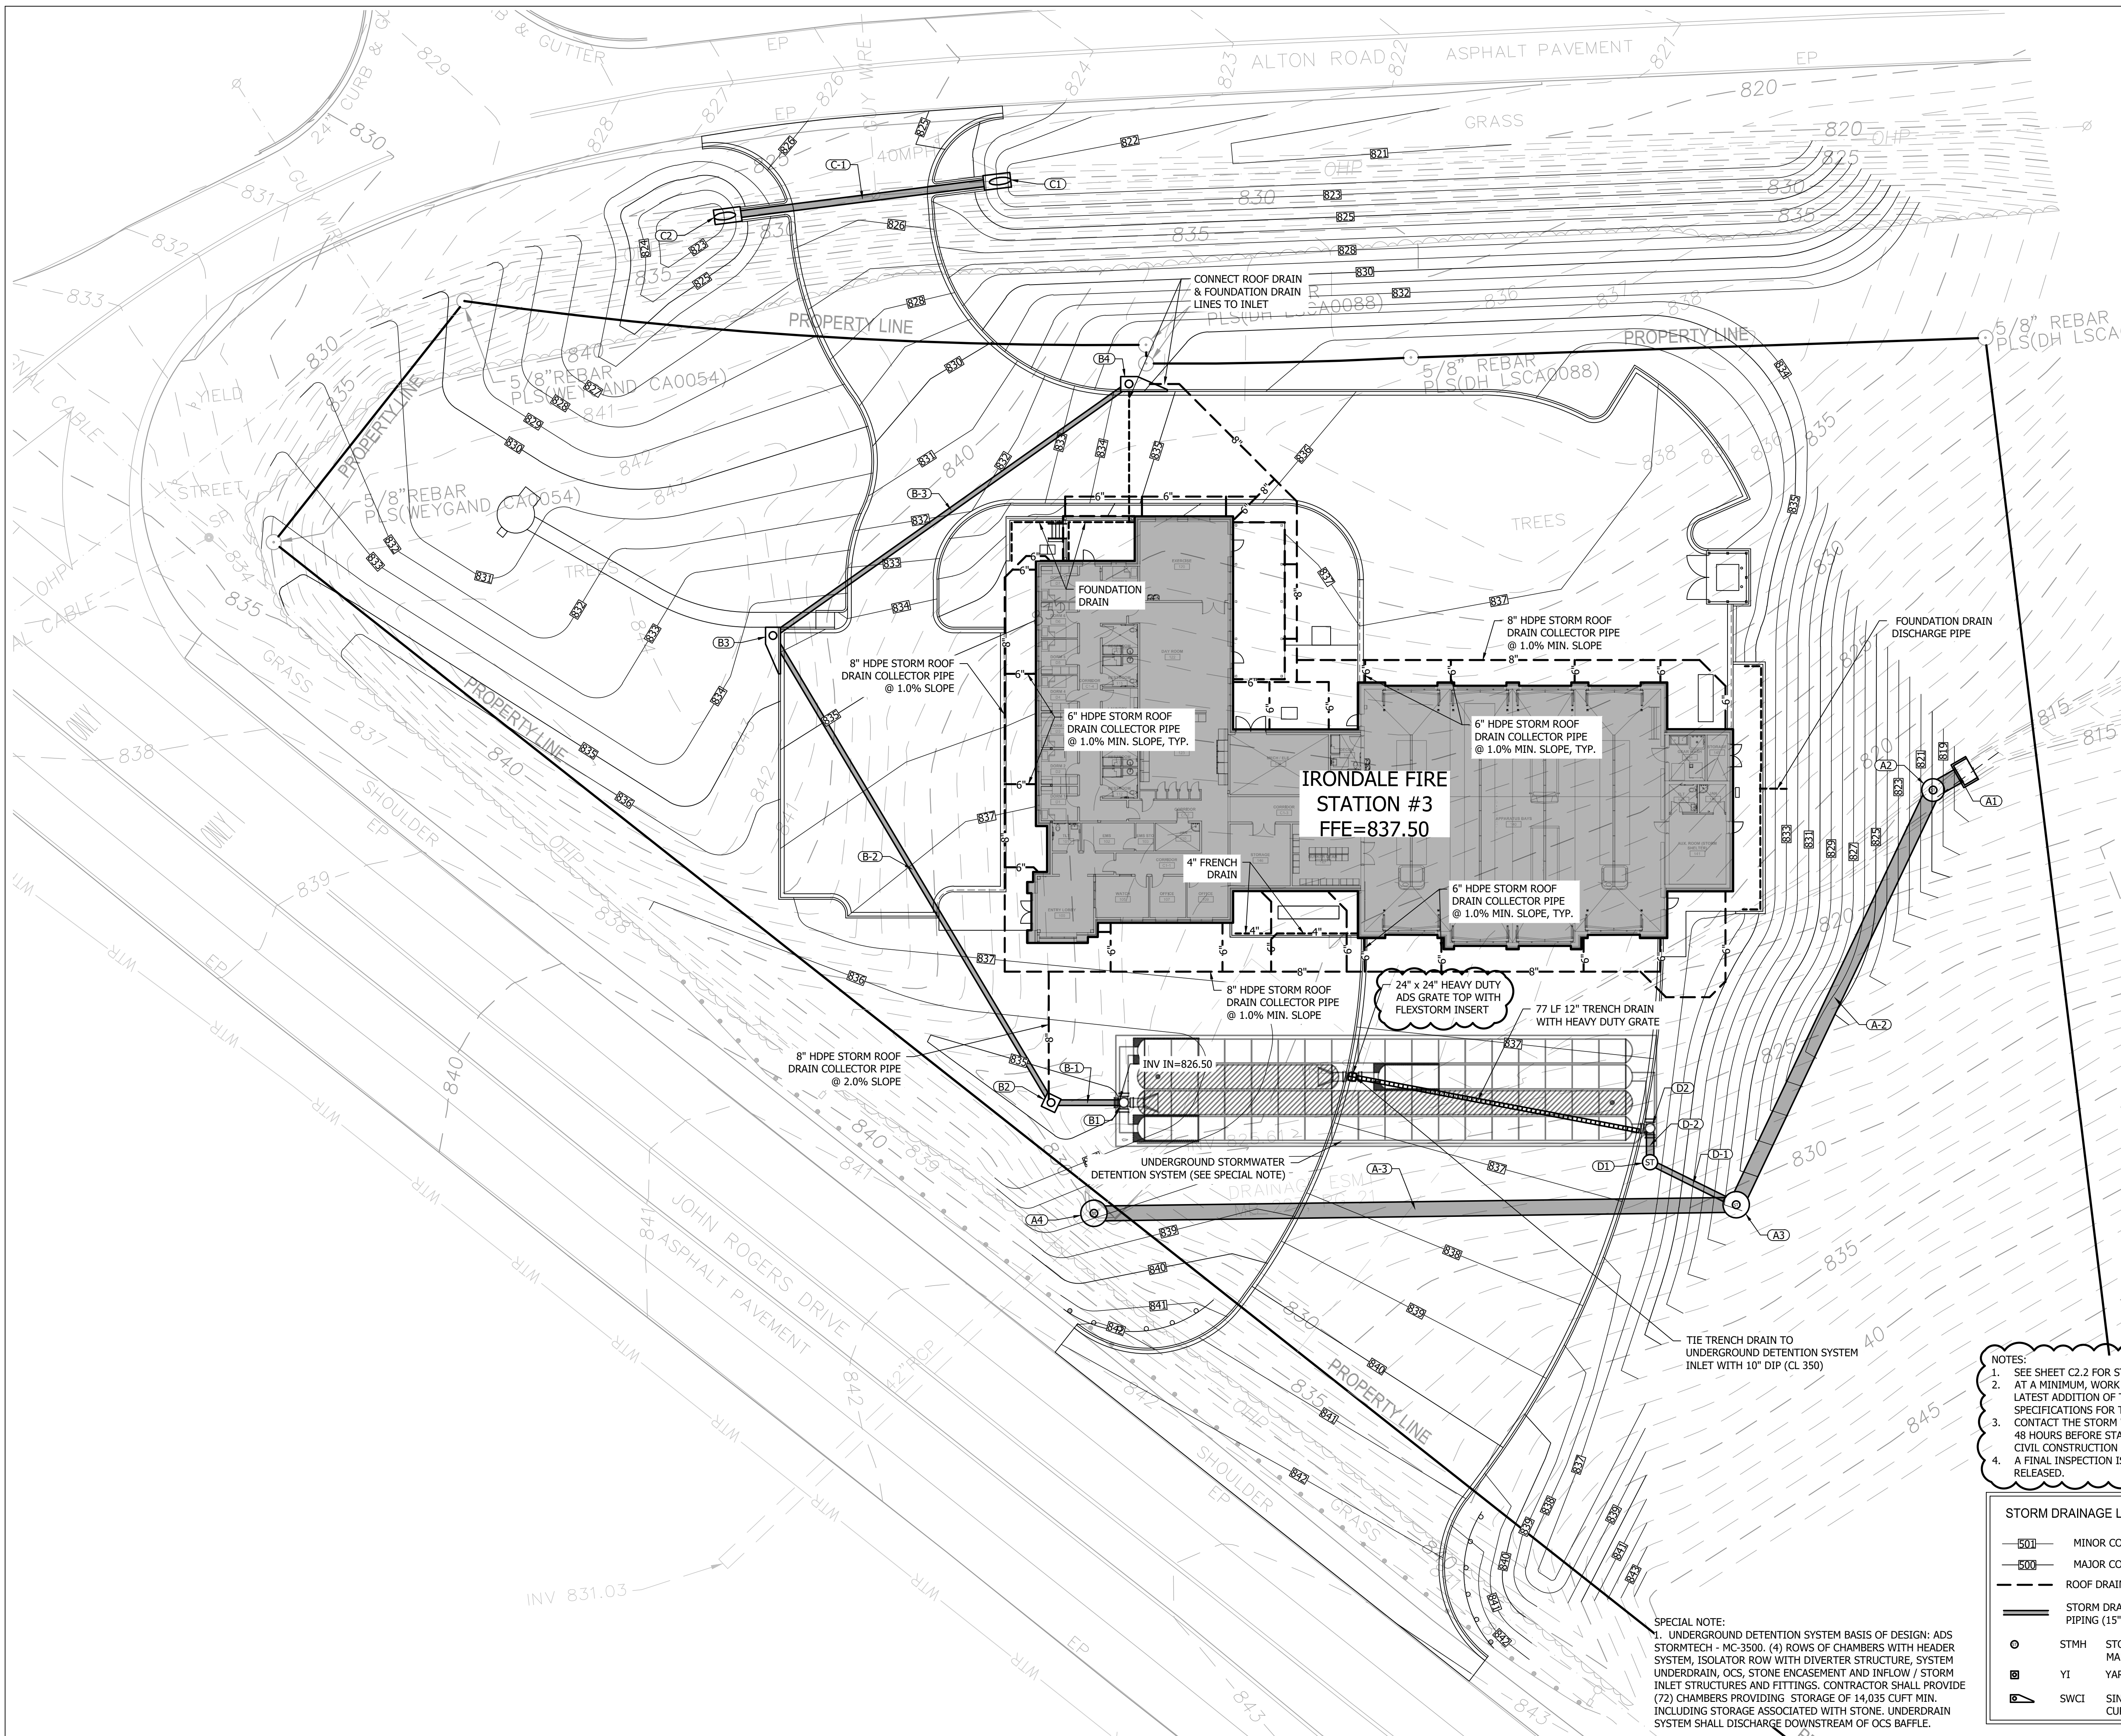

- NOTES:
- SEE SHEET C2.2 FOR STORM PROFILE INFORMATION.
  - AT A MINIMUM, WORK WILL BE DONE IN ACCORDANCE WITH THE LATEST ADDITION OF THE BIRMINGHAM STANDARDS AND SPECIFICATIONS FOR THE CONSTRUCTION OF PUBLIC WORKS PROJECTS.
  - CONTACT THE STORM WATER MANAGEMENT OFFICE AT 205-297-8168, 48 HOURS BEFORE STARTING WORK TO SCHEDULE STORMWATER AND CIVIL CONSTRUCTION INSPECTIONS.
  - A FINAL INSPECTION IS REQUIRED BEFORE THE PROJECT CAN BE RELEASED.

**STORM DRAINAGE LEGEND**


	MINOR CONTOUR
	MAJOR CONTOUR
	ROOF DRAINAGE PIPING
	STORM DRAINAGE PIPING (15' OR MORE)
	STMH STORM SEWER MANHOLE
	YI YARD INLET
	SWCI SINGLE WING CURB INLET

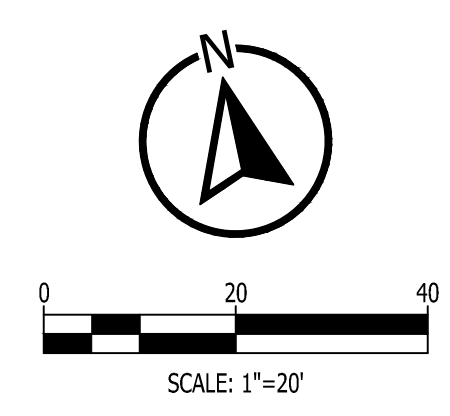

SPECIAL NOTE:  
 1. UNDERGROUND DETENTION SYSTEM BASIS OF DESIGN: ADS STORMTECH - MC-3500, (4) ROWS OF CHAMBERS WITH HEADER SYSTEM, ISOLATOR ROW WITH DIVER STRUCTURE, SYSTEM UNDERDRAIN, OCS, STONE ENCASMENT AND INFLOW / STORM INLET STRUCTURES AND FITTINGS. CONTRACTOR SHALL PROVIDE (72) CHAMBERS PROVIDING STORAGE OF 14,035 CUFT MIN. INCLUDING STORAGE ASSOCIATED WITH STONE. UNDERDRAIN SYSTEM SHALL DISCHARGE DOWNSTREAM OF OCS BAFFLE.



Revisions		
No.	Date	Description
1	2/12/25	ADDENDUM #2
2	2/19/25	ADDENDUM #3

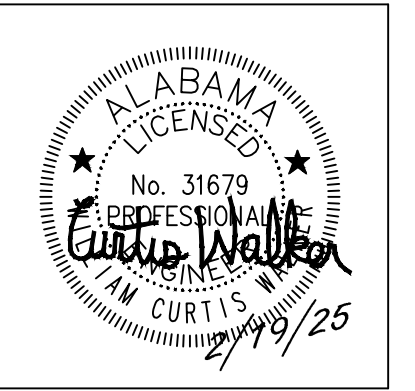

100% CD'S

**IRONDALE FIRE STATION #3**

2101 JOHN ROGERS DR  
 BIRMINGHAM, AL 35210  
 CITY OF IRONDALE

CHARLES WILLIAMS & ASSOCIATES ARCHITECTS  
 PH: 205-250-0700  
 BIRMINGHAM, ALABAMA 35222



SHEET TITLE:  
 SITE UTILITY PLAN


PROJECT NUMBER:  
 CWA No. 2023-01

DATE:  
 8/30/24

DRAWN BY:  
 WCV

CHECKED BY:  
 CIE


SHEET NUMBER  
**C3.0**

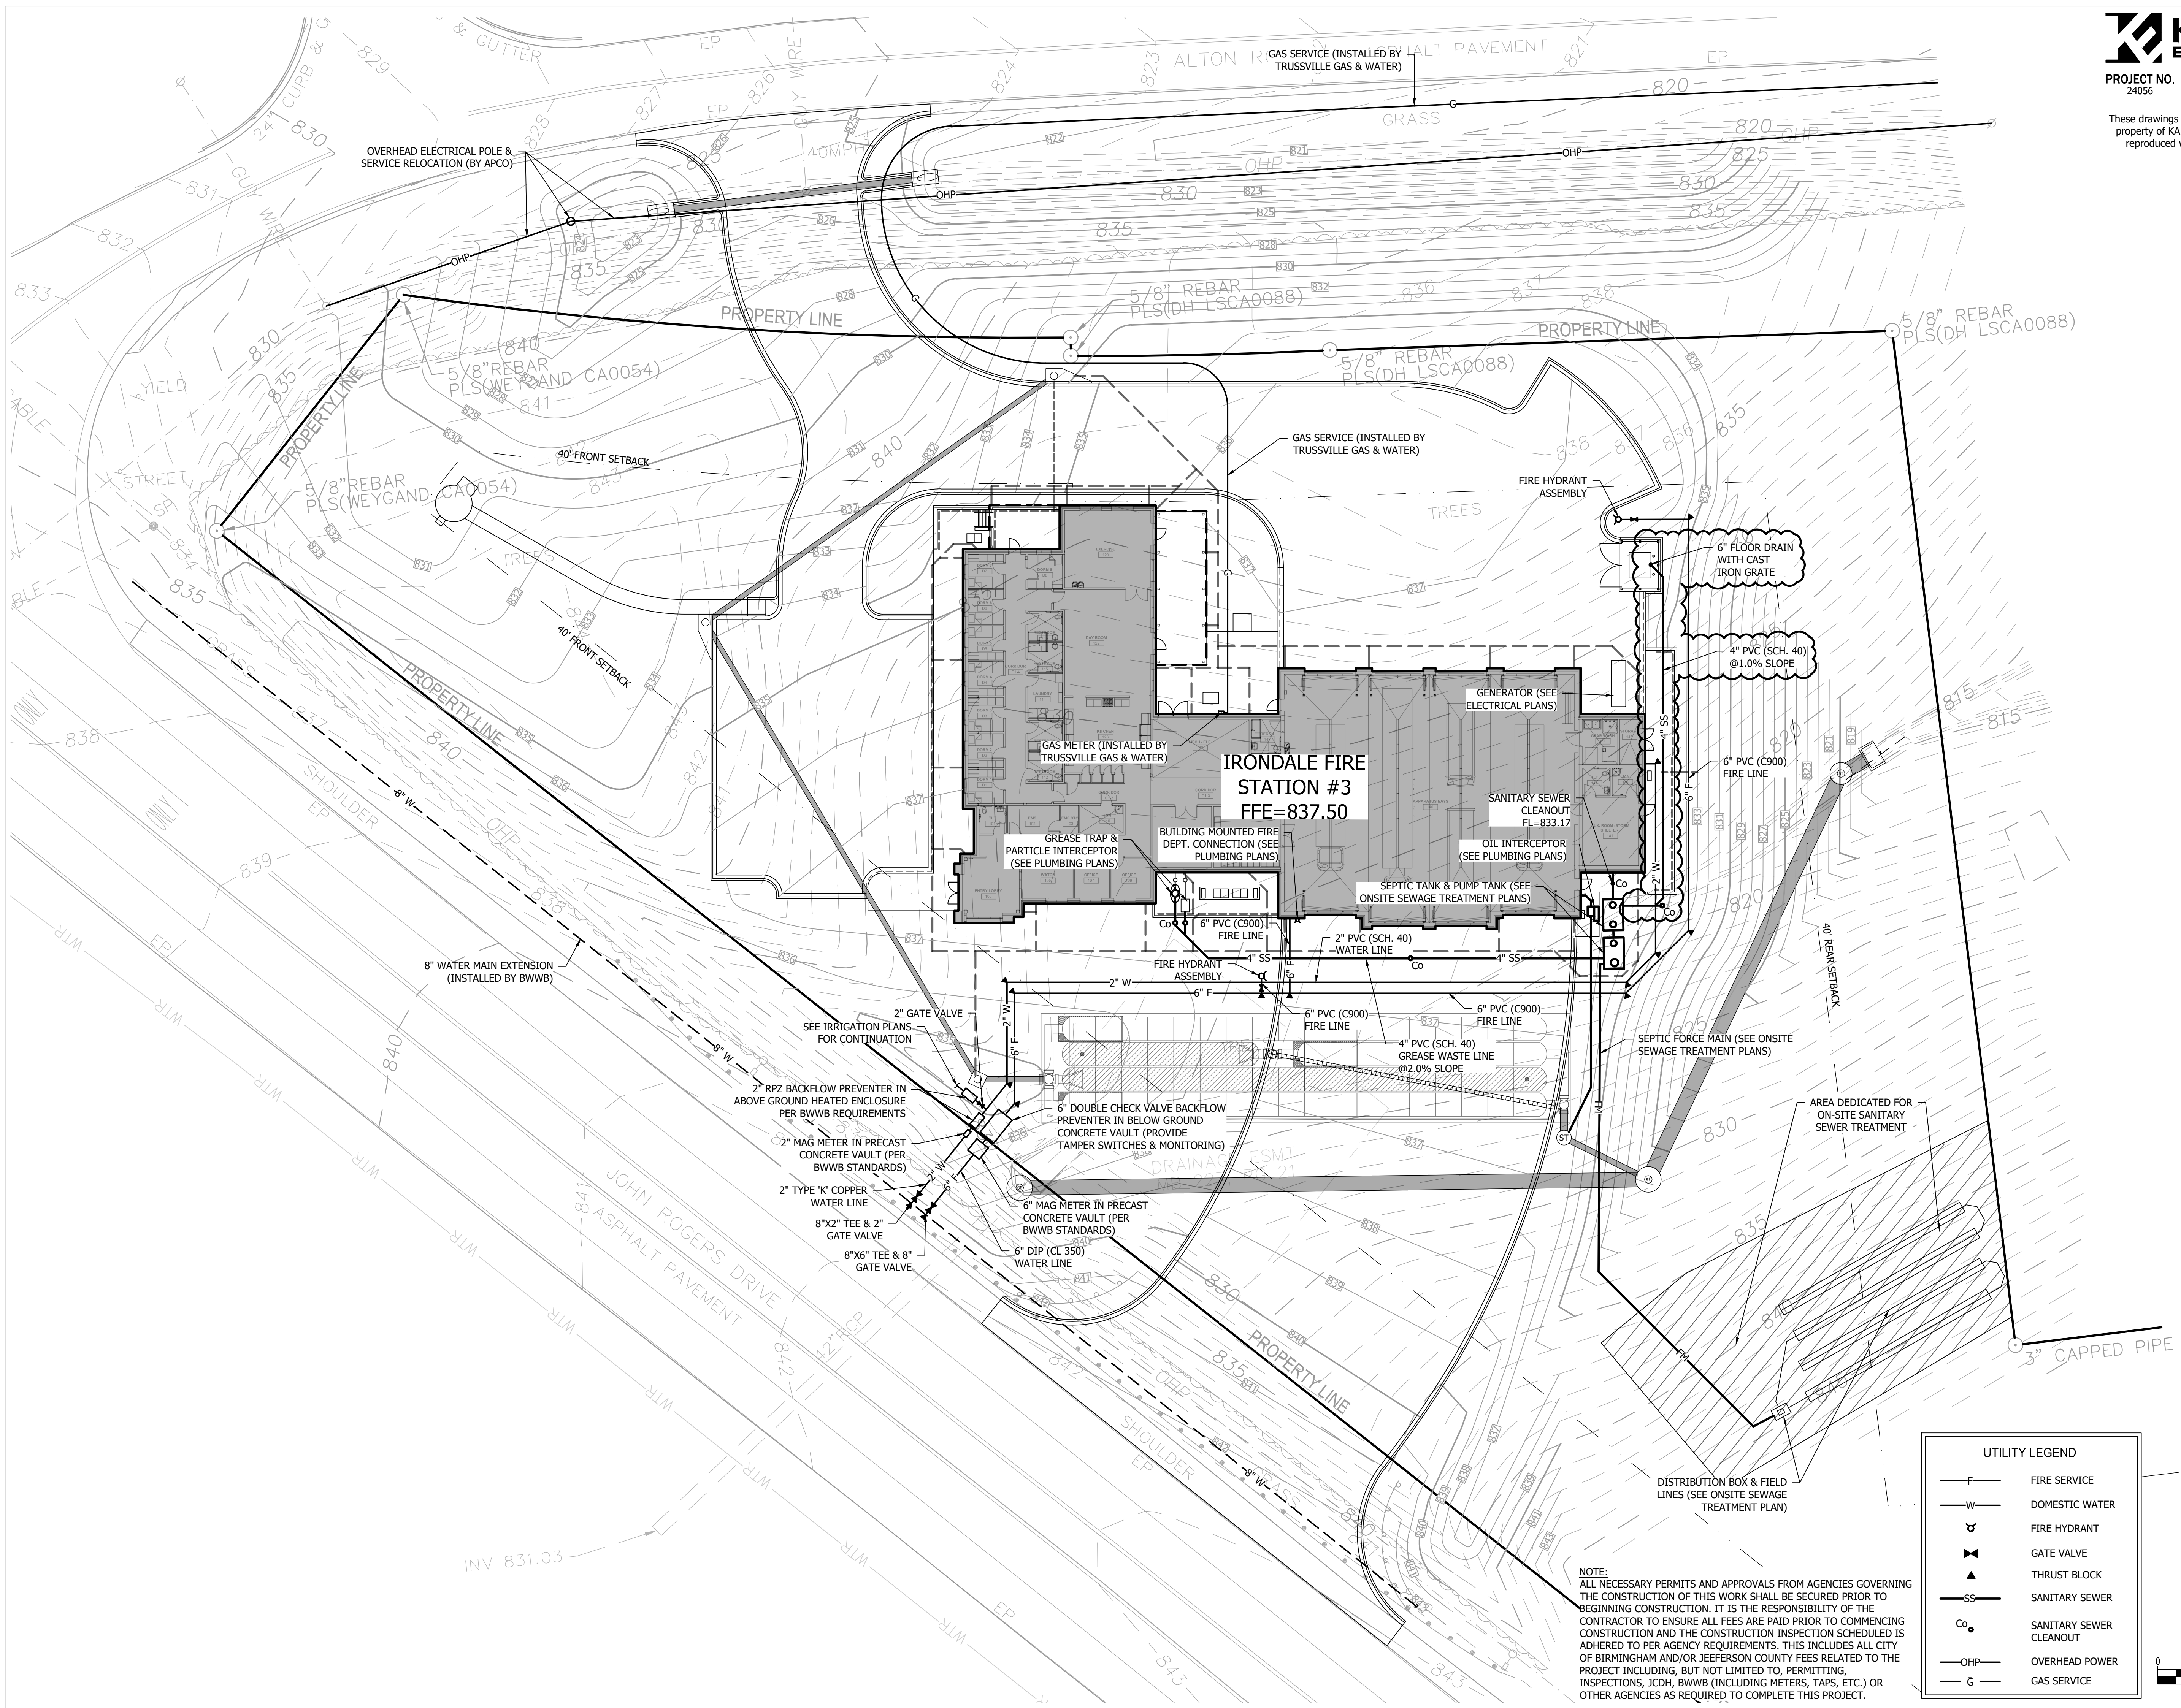

**UTILITY LEGEND**


	FIRE SERVICE
	DOMESTIC WATER
	FIRE HYDRANT
	GATE VALVE
	THRUST BLOCK
	SANITARY SEWER
	SANITARY SEWER CLEANOUT
	OVERHEAD POWER
	GAS SERVICE

NOTE:  
 ALL NECESSARY PERMITS AND APPROVALS FROM AGENCIES GOVERNING THE CONSTRUCTION OF THIS WORK SHALL BE SECURED PRIOR TO BEGINNING CONSTRUCTION. IT IS THE RESPONSIBILITY OF THE CONTRACTOR TO ENSURE ALL FEES ARE PAID PRIOR TO COMMENCING CONSTRUCTION AND THE CONSTRUCTION INSPECTION SCHEDULED IS ADHERED TO PER AGENCY REQUIREMENTS. THIS INCLUDES ALL CITY OF BIRMINGHAM AND/OR JEFFERSON COUNTY FEES RELATED TO THE PROJECT INCLUDING, BUT NOT LIMITED TO, PERMITTING, INSPECTIONS, JCDH, BWWB (INCLUDING METERS, TAPS, ETC.) OR OTHER AGENCIES AS REQUIRED TO COMPLETE THIS PROJECT.

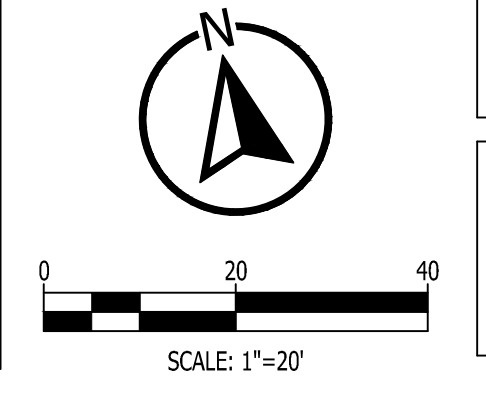



Revisions		
No.	Date	Description
1	2/19/25	ADDENDUM #3

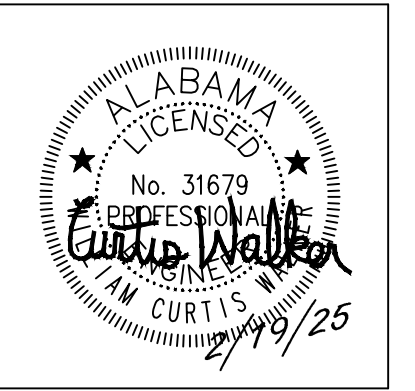

100% CD'S

# IRONDALE FIRE STATION #3

2101 JOHN ROGERS DR  
 BIRMINGHAM, AL 35210  
 CITY OF IRONDALE

CHARLES WILLIAMS & ASSOCIATES ARCHITECTS  
  
 3601 8TH AVE. SOUTH BIRMINGHAM, ALABAMA 35222  
 PH: 205-250-0700 FAX: 205-250-0515

SHEET TITLE:  
**EROSION CONTROL PLAN - INTERMEDIATE**


PROJECT NUMBER:  
**CWA No. 2023-01**

DATE:  
**8/30/24**

DRAWN BY:  
**WCW**

CHECKED BY:  
**CIE**

SHEET NUMBER  
**C4.1**

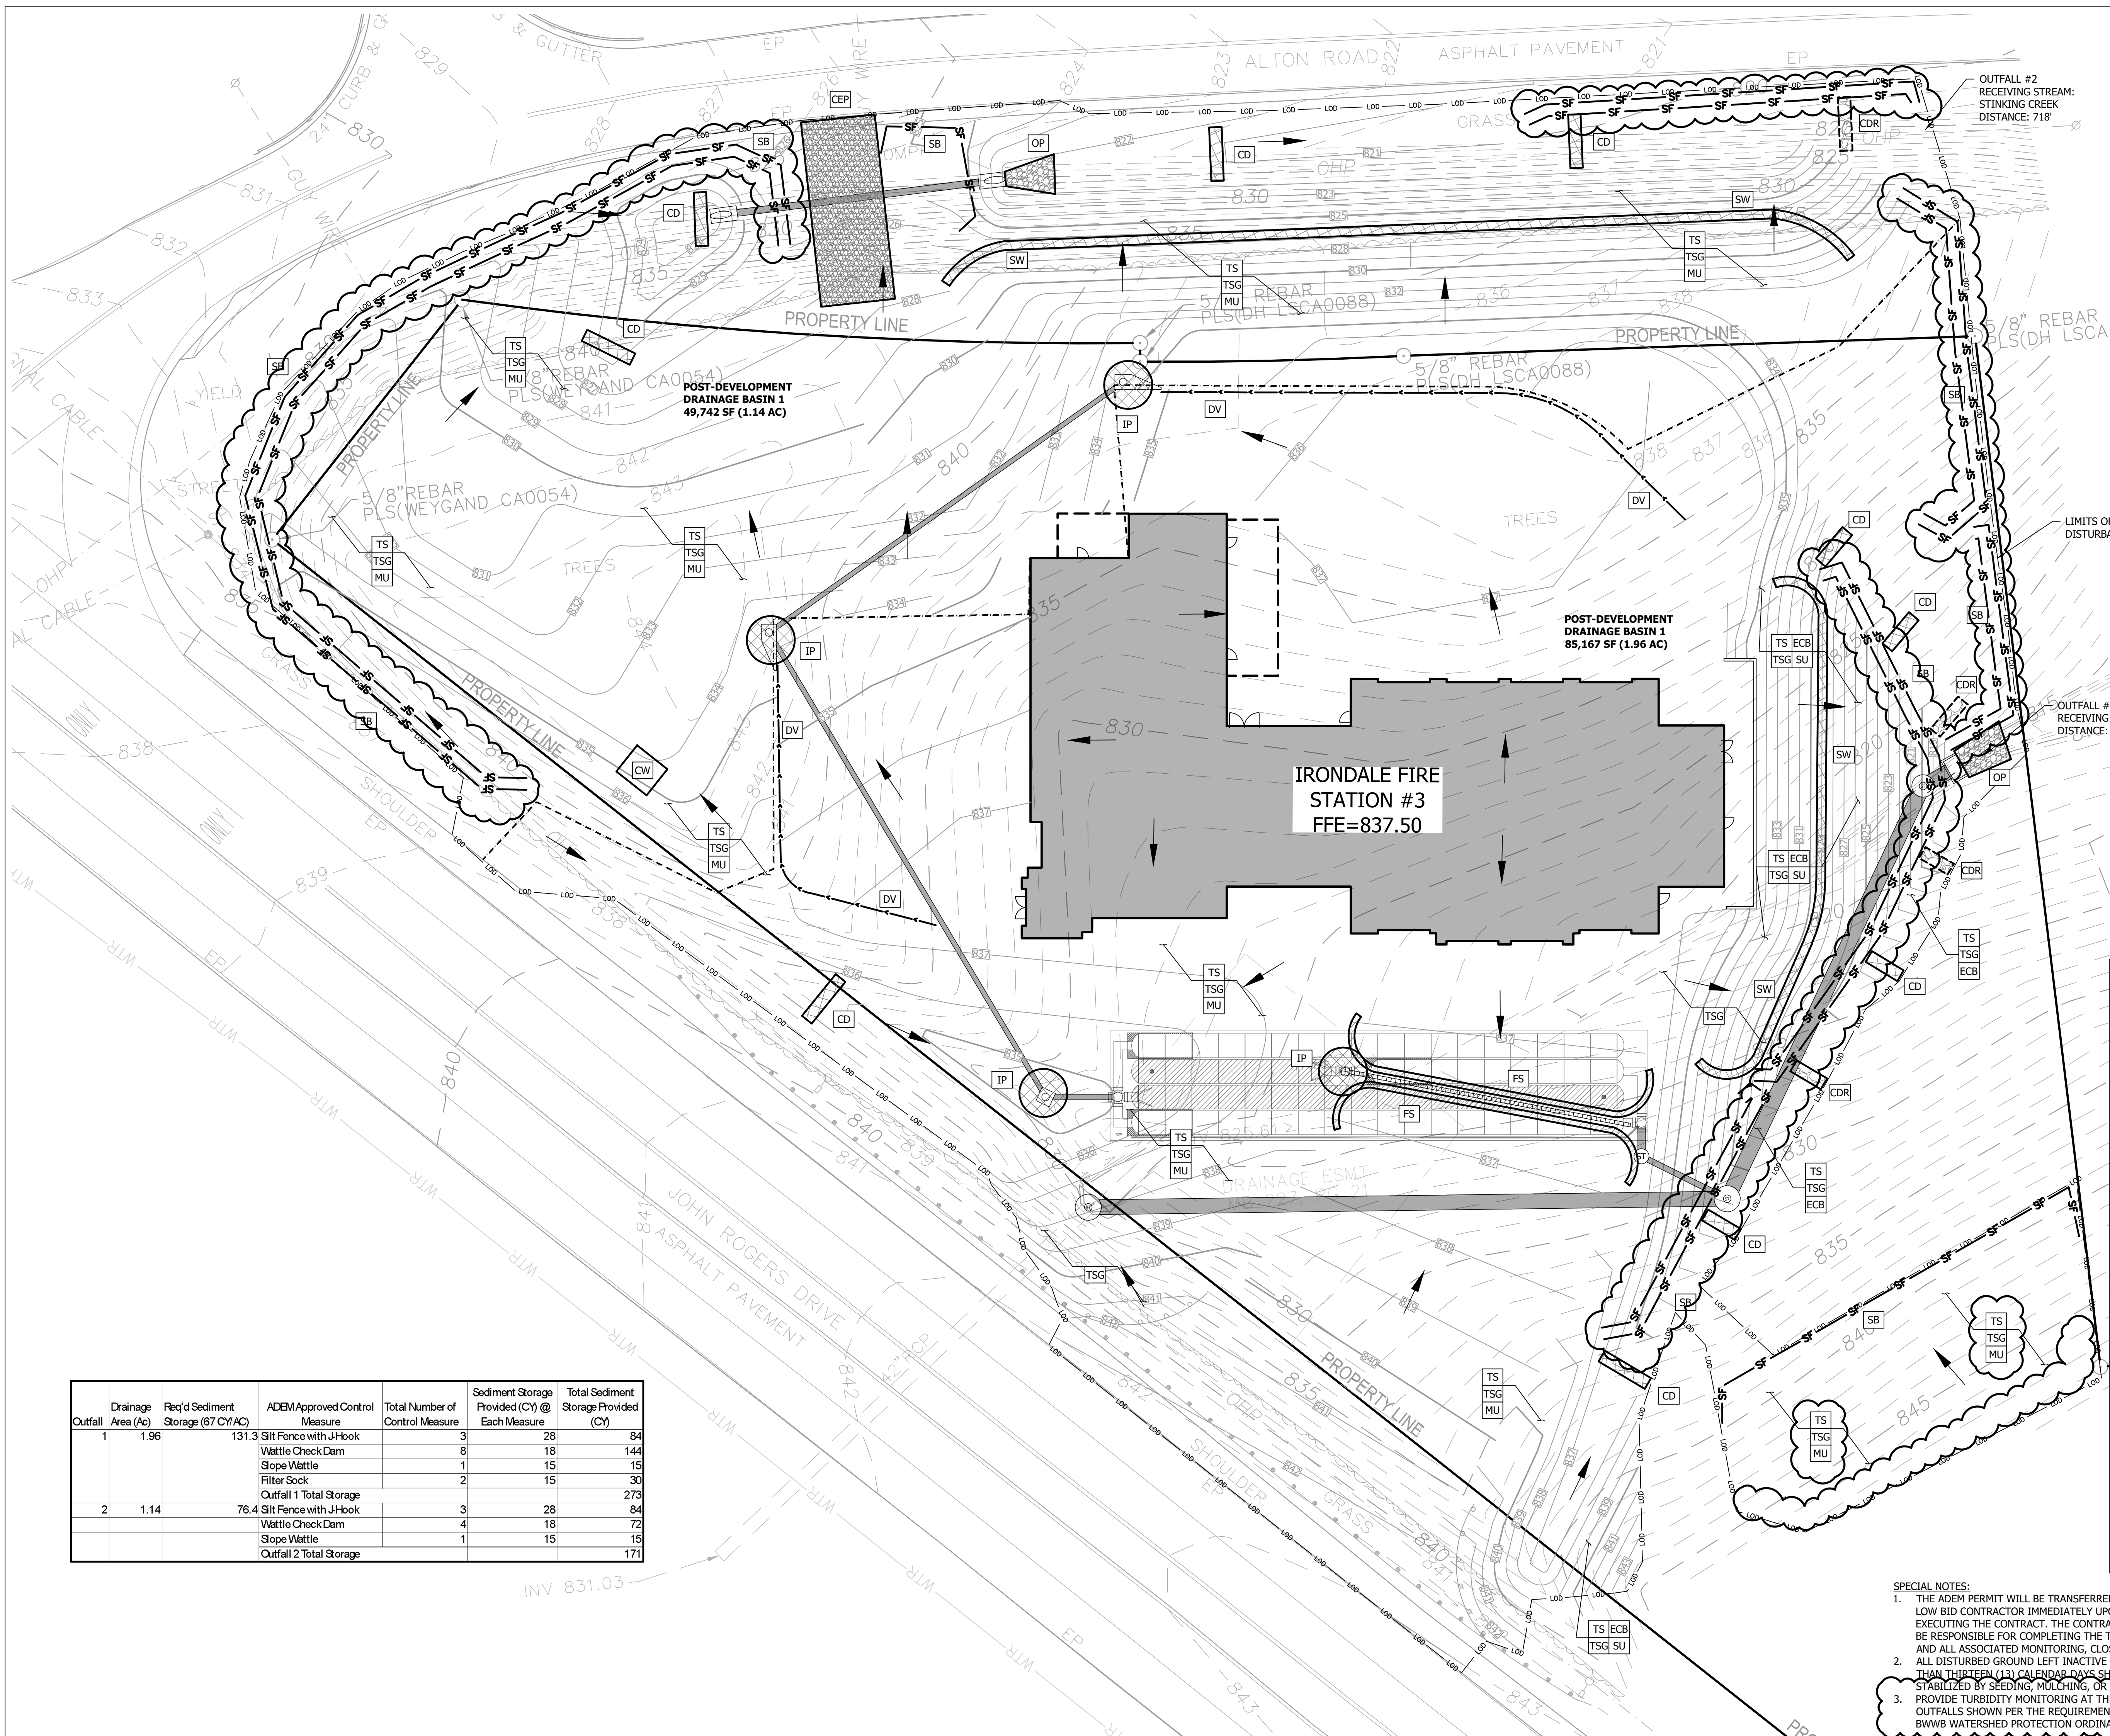


**EROSION CONTROL LEGEND**

	SB	SILT FENCING
	IP	SILT SAVER / DANDY SACK INLET PROTECTION
	CD	CHECK DAM - WATTLE
	CDR	CHECK DAM - ROCK
	SW	SLOPE WATTLE
	CEP	CONSTRUCTION EXIT PAD
	OP	OUTLET PROTECTION
	TSG	TOPSOIL
	ECB	EROSION CONTROL BLANKET
	CW	CONCRETE WASHOUT
	PS	PERMANENT SEEDING
	TS	TEMPORARY SEEDING
	MU	MULCHING
	SU	SURFACE ROUGHENING
	SOD	SODDING
	DV	DIVERSION BERM
	LS	LANDSCAPING

Outfall	Drainage Area (Ac)	Req'd Sediment Storage (67 CY/AC)	ADEM Approved Control Measure	Total Number of Control Measure	Sediment Storage Provided (CY) @ Each Measure	Total Sediment Storage Provided (CY)	
1	1.96	131.3	Silt Fence with J-hook	3	28	84	
			Wattle Check Dam	8	18	144	
			Slope Wattle	1	15	15	
			Filter Sock	2	15	30	
			Outfall 1 Total Storage				273
2	1.14	76.4	Silt Fence with J-hook	3	28	84	
			Wattle Check Dam	4	18	72	
			Slope Wattle	1	15	15	
			Outfall 2 Total Storage				171


**SPECIAL NOTES:**

- THE ADEM PERMIT WILL BE TRANSFERRED TO THE LOW BID CONTRACTOR IMMEDIATELY UPON EXECUTING THE CONTRACT. THE CONTRACTOR WILL BE RESPONSIBLE FOR COMPLETING THE TRANSFER AND ALL ASSOCIATED MONITORING, CLOSEOUT, ETC. ALL DISTURBED GROUND LEFT INACTIVE FOR MORE THAN THIRTEEN (13) CALENDAR DAYS SHALL BE STABILIZED BY SEEDING, MULCHING, OR OTHER BMP.
- PROVIDE TURBIDITY MONITORING AT THE TWO OUTFALLS SHOWN PER THE REQUIREMENTS OF THE BWWB WATERSHED PROTECTION ORDINANCE.

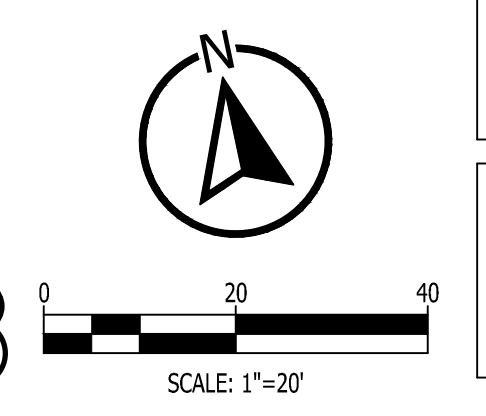



Revisions		
No.	Date	Description
1	2/19/25	ADDENDUM #3

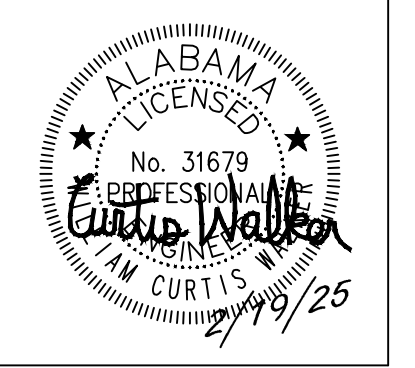

100% CD'S


**IRONDALE FIRE STATION #3**

2101 JOHN ROGERS DR  
 BIRMINGHAM, AL 35210  
 CITY OF IRONDALE

CHARLES WILLIAMS & ASSOCIATES ARCHITECTS  
**CWA**  
 3601 8TH AVE. SOUTH BIRMINGHAM, ALABAMA 35222  
 PH: 205-250-0700  
 FAX: 205-250-0515

SHEET TITLE:  
**EROSION CONTROL PLAN - FINAL**  
 PROJECT NUMBER:  
**CWA No. 2023-01**  
 DATE:  
**8/30/24**  
 DRAWN BY:  
**WCW** CHECKED BY:  
**CIE**


SHEET NUMBER  
**C4.2**

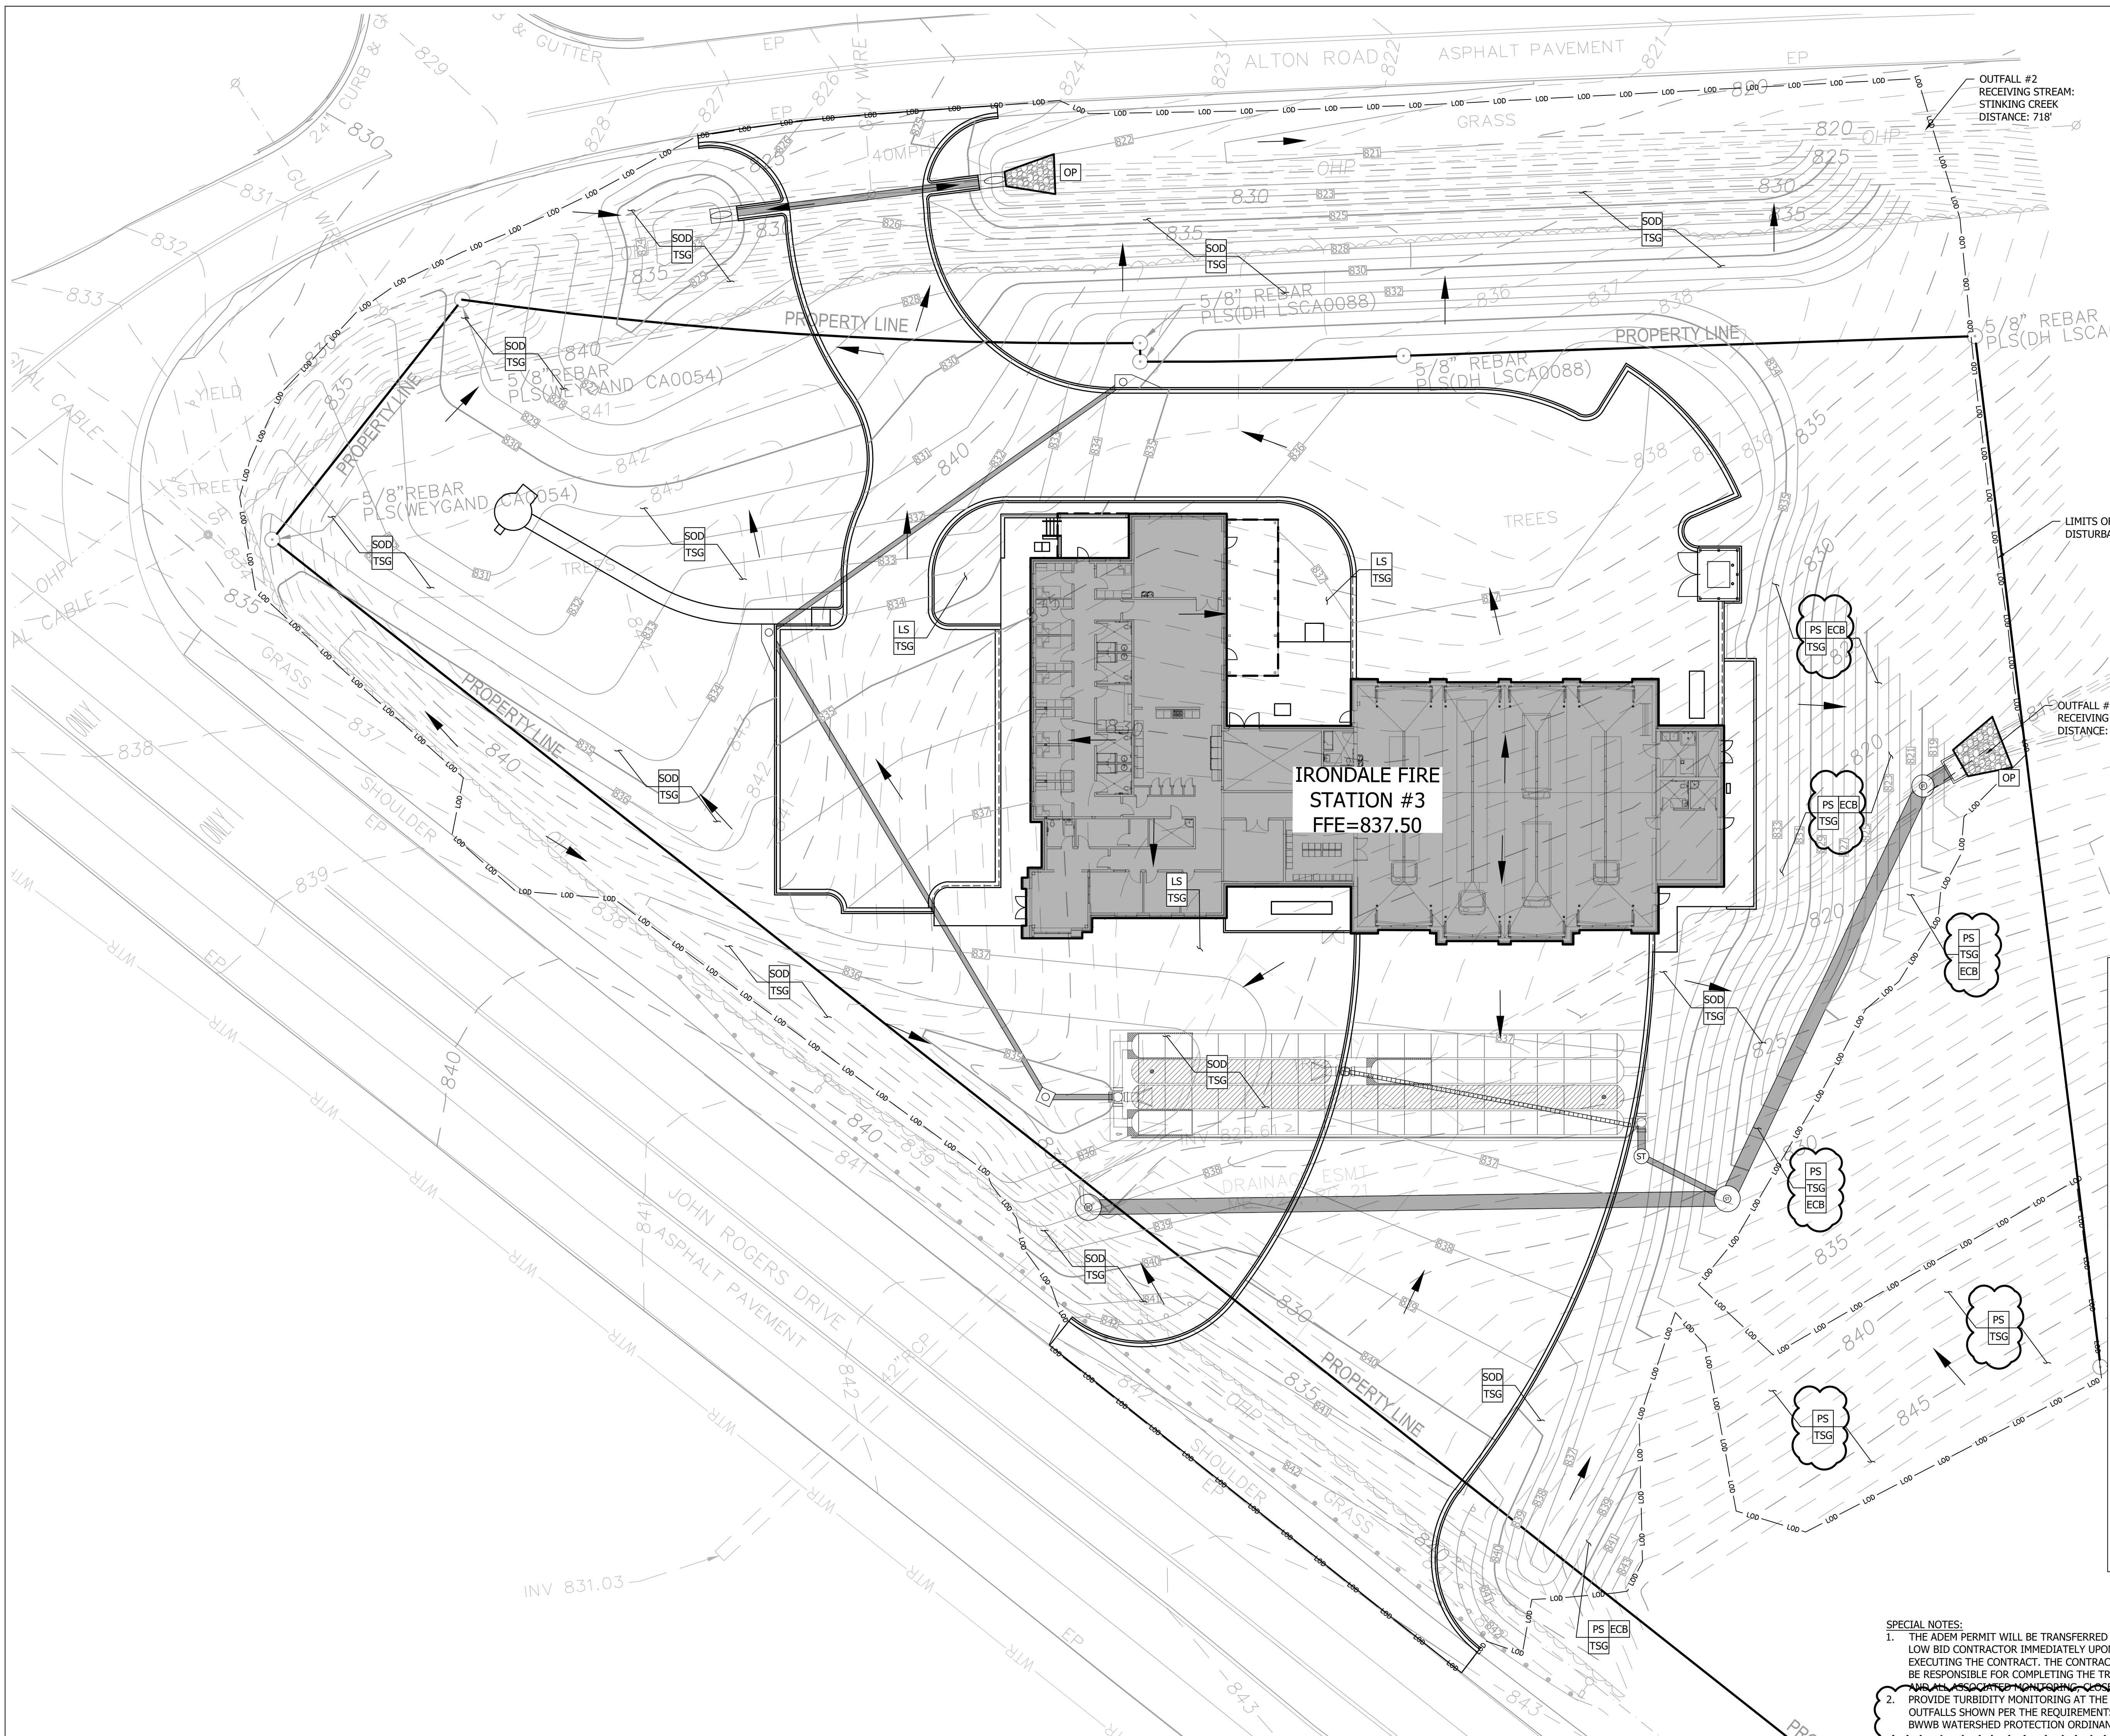

**EROSION CONTROL LEGEND**


	SILT FENCING
	SILT SAVER / DANDY SACK INLET PROTECTION
	CHECK DAM - WATTLE
	CHECK DAM - ROCK
	SLOPE WATTLE
	CONSTRUCTION EXIT PAD
	OUTLET PROTECTION
	TOPSOIL
	EROSION CONTROL BLANKET
	CONCRETE WASHOUT
	PERMANENT SEEDING
	TEMPORARY SEEDING
	MULCHING
	SURFACE ROUGHENING
	SODDING
	DIVERSION BERM
	LANDSCAPING

**SPECIAL NOTES:**  
 1. THE ADEM PERMIT WILL BE TRANSFERRED TO THE LOW BID CONTRACTOR IMMEDIATELY UPON EXECUTING THE CONTRACT. THE CONTRACTOR WILL BE RESPONSIBLE FOR COMPLETING THE TRANSFER AND ALL ASSOCIATED MONITORING, CLOSURE, ETC.  
 2. PROVIDE TURBIDITY MONITORING AT THE TWO OUTFALLS SHOWN PER THE REQUIREMENTS OF THE BWWB WATERSHED PROTECTION ORDINANCE.

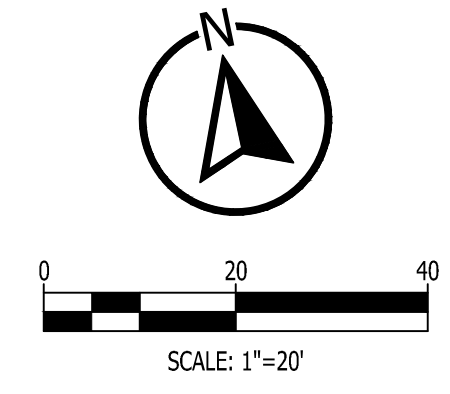



Revisions		
No.	Date	Description
1	2/19/25	ADDENDUM #3

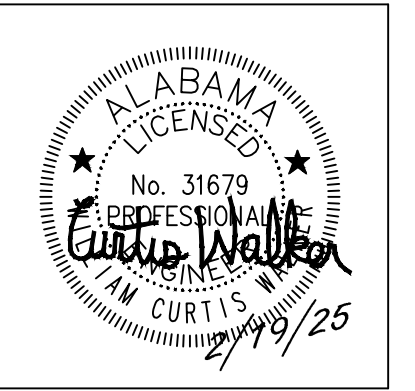

100% CD'S

**IRONDALE FIRE STATION #3**  
 2101 JOHN ROGERS DR  
 BIRMINGHAM, AL 35210  
 CITY OF IRONDALE

CHARLES WILLIAMS & ASSOCIATES ARCHITECTS  
 PH: 205-250-0700  
 3601 8TH AVE. SOUTH  
 BIRMINGHAM, ALABAMA 35222  
 PH: 205-250-0700  
 FAX: 205-250-0515



SHEET TITLE: DETAILS  
 PROJECT NUMBER: CWA No. 2023-01  
 DATE: 8/30/24  
 DRAWN BY: DWW  
 CHECKED BY: CIE  
 SHEET NUMBER: C5.2

PROJECT INFORMATION	
ENGINEER PRODUCT MANAGER	JOSEPH LEACH 470-432-1615 JOSEPH.LEACH@ADSP.COM
ADS SALES REP	BRAGG KNOTT 256-504-3745 BRAGG.KNOTT@ADS.COM
PROJECT NO.	8427886



**IRONDALE FIRE STATION**  
 BIRMINGHAM, AL, USA

**MC-3500 STORMTECH CHAMBER SPECIFICATIONS**

- CHAMBERS SHALL BE STORMTECH MC-3500.
- CHAMBERS SHALL BE ARCH-SHAPED AND SHALL BE MANUFACTURED FROM VIRGIN, IMPACT-MODIFIED POLYPROPYLENE COPOLYMERS.
- CHAMBERS SHALL MEET THE REQUIREMENTS OF ASTM F2418, "STANDARD SPECIFICATION FOR POLYPROPYLENE (PP) CORRUGATED WALL STORMWATER COLLECTION CHAMBERS" CHAMBER CLASSIFICATION 45x76 DESIGNATION SS.
- CHAMBER ROWS SHALL PROVIDE CONTINUOUS, UNOBSTRUCTED INTERNAL SPACE WITH NO INTERNAL SUPPORTS THAT WOULD IMPEDE FLOW OR LIMIT ACCESS FOR INSPECTION.
- THE STRUCTURAL DESIGN OF THE CHAMBERS, THE STRUCTURAL BACKFILL, AND THE INSTALLATION REQUIREMENTS SHALL ENSURE THAT THE LOAD FACTORS SPECIFIED IN THE AASHTO LRFD BRIDGE DESIGN SPECIFICATIONS, SECTION 12.12, ARE MET FOR: 1) LONG-DURATION DEAD LOADS AND 2) SHORT-DURATION LIVE LOADS, BASED ON THE AASHTO DESIGN TRUCK WITH CONSIDERATION FOR IMPACT AND MULTIPLE VEHICLE PRESENCES.
- CHAMBERS SHALL BE DESIGNED, TESTED AND ALLOWABLE LOAD CONFIGURATIONS DETERMINED IN ACCORDANCE WITH ASTM F2787, "STANDARD PRACTICE FOR STRUCTURAL DESIGN OF THERMOPLASTIC CORRUGATED WALL STORMWATER COLLECTION CHAMBERS". LOAD CONFIGURATIONS SHALL INCLUDE: 1) INSTANTANEOUS (<1 MIN) AASHTO DESIGN TRUCK LIVE LOAD ON MINIMUM COVER 2) MAXIMUM PERMANENT (75-YR) COVER LOAD AND 3) ALLOWABLE COVER WITH PARKED (1-WEEK) AASHTO DESIGN TRUCK.
- REQUIREMENTS FOR HANDLING AND INSTALLATION:
  - TO MAINTAIN THE WIDTH OF CHAMBERS DURING SHIPPING AND HANDLING, CHAMBERS SHALL HAVE INTEGRAL, INTERLOCKING STACKING LOGS.
  - TO ENSURE A SECURE JOINT DURING INSTALLATION AND BACKFILL, THE HEIGHT OF THE CHAMBER JOINT SHALL NOT BE LESS THAN 3".
  - TO ENSURE THE INTEGRITY OF THE ARCH SHAPE DURING INSTALLATION, THE ARCH STIFFNESS CONSTANT SHALL BE GREATER THAN OR EQUAL TO 450 LBS/FT<sup>2</sup>. THE ASC IS DEFINED IN SECTION 6.2.8 OF ASTM F2418, AND b) TO RESIST CHAMBER DEFORMATION DURING INSTALLATION AT ELEVATED TEMPERATURES (ABOVE 73° F / 23° C), CHAMBERS SHALL BE PRODUCED FROM REFLECTIVE GOLD OR YELLOW COLORS.
- ONLY CHAMBERS THAT ARE APPROVED BY THE SITE DESIGN ENGINEER WILL BE INSTALLED. UPON REQUEST BY THE SITE DESIGN ENGINEER OR OWNER, THE CHAMBER MANUFACTURER SHALL SUBMIT A STRUCTURAL EVALUATION FOR APPROVAL BEFORE DELIVERING CHAMBERS TO THE PROJECT SITE AS FOLLOWS:
  - THE STRUCTURAL EVALUATION SHALL BE SEALED BY A REGISTERED PROFESSIONAL ENGINEER.
  - THE STRUCTURAL EVALUATION SHALL DEMONSTRATE THAT THE SAFETY FACTORS ARE GREATER THAN OR EQUAL TO 1.95 FOR DEAD LOAD AND 1.75 FOR LIVE LOAD, THE MINIMUM REQUIRED BY ASTM F2787 AND BY SECTIONS 3 AND 12.12 OF THE AASHTO LRFD BRIDGE DESIGN SPECIFICATIONS FOR THERMOPLASTIC PIPE.
  - THE TEST DERIVED CREEP MODULUS AS SPECIFIED IN ASTM F2418 SHALL BE USED FOR PERMANENT DEAD LOAD DESIGN EXCEPT THAT IT SHALL BE THE 75-YEAR MODULUS USED FOR DESIGN.
- CHAMBERS AND END CAPS SHALL BE PRODUCED AT AN ISO 9001 CERTIFIED MANUFACTURING FACILITY.
- MANHOLE SIZE TO BE DETERMINED BY SITE DESIGN ENGINEER. SEE TECH NOTE #6.33 FOR MANHOLE SIZING GUIDANCE. DUE TO THE ADAPTATION OF THIS CHAMBER SYSTEM TO SPECIFIC SITE AND DESIGN CONSTRAINTS, IT MAY BE NECESSARY TO CUT AND COUPLE ADDITIONAL PIPE TO STANDARD MANHOLE COMPONENTS IN THE FIELD.
- ADS DOES NOT DESIGN OR PROVIDE MEMBRANE LINER SYSTEMS. TO MINIMIZE THE LEAKAGE POTENTIAL OF LINER SYSTEMS, THE MEMBRANE LINER SYSTEM SHOULD BE DESIGNED BY A KNOWLEDGEABLE GEOTECHNICAL PROFESSIONAL AND INSTALLED BY A QUALIFIED CONTRACTOR.

**IMPORTANT - NOTES FOR THE BIDDING AND INSTALLATION OF MC-3500 CHAMBER SYSTEM**

- STORMTECH MC-3500 CHAMBERS SHALL NOT BE INSTALLED UNTIL THE MANUFACTURER'S REPRESENTATIVE HAS COMPLETED A PRE-CONSTRUCTION MEETING WITH THE INSTALLERS.
- STORMTECH MC-3500 CHAMBERS SHALL BE INSTALLED IN ACCORDANCE WITH THE "STORMTECH MC-3500MC-4500 CONSTRUCTION GUIDE".
- CHAMBERS ARE NOT TO BE BACKFILLED WITH A DOZER OR AN EXCAVATOR SITUATED OVER THE CHAMBERS. STORMTECH RECOMMENDS 3 BACKFILL METHODS:
  - STONESHOTTER LOCATED OFF THE CHAMBER BED.
  - BACKFILL AS ROWS ARE BUILT USING AN EXCAVATOR ON THE FOUNDATION STONE OR SUBGRADE.
  - BACKFILL FROM OUTSIDE THE EXCAVATION USING A LONG BOOM HOE OR EXCAVATOR.
- THE FOUNDATION STONE SHALL BE LEVELED AND COMPACTED PRIOR TO PLACING CHAMBERS.
- JOINTS BETWEEN CHAMBERS SHALL BE PROPERLY SEATED PRIOR TO PLACING STONE.
- MAINTAIN MINIMUM - 6" (150 mm) SPACING BETWEEN THE CHAMBER ROWS.
- INLET AND OUTLET MANIFOLDS MUST BE INSERTED A MINIMUM OF 12" (300 mm) INTO CHAMBER END CAPS.
- EMBEDMENT STONE SURROUNDING CHAMBERS MUST BE A CLEAN, CRUSHED, ANGULAR STONE MEETING THE AASHTO M43 DESIGNATION OF #3 OR #4.
- STONE MUST BE PLACED ON THE TOP CENTER OF THE CHAMBER TO ANCHOR THE CHAMBERS IN PLACE AND PRESERVE ROW SPACING.
- THE CONTRACTOR MUST REPORT ANY DISCREPANCIES WITH CHAMBER FOUNDATION MATERIALS BEARING CAPACITIES TO THE SITE DESIGN ENGINEER.
- ADS RECOMMENDS THE USE OF "FLEXSTORM CATCH IT" INSERTS DURING CONSTRUCTION FOR ALL INLETS TO PROTECT THE SUBSURFACE STORMWATER MANAGEMENT SYSTEM FROM CONSTRUCTION SITE RUNOFF.

**NOTES FOR CONSTRUCTION EQUIPMENT**


- STORMTECH MC-3500 CHAMBERS SHALL BE INSTALLED IN ACCORDANCE WITH THE "STORMTECH MC-3500MC-4500 CONSTRUCTION GUIDE".
- THE USE OF EQUIPMENT OVER MC-3500 CHAMBERS IS LIMITED:
  - NO RUBBER Tired LOADER, DUMP TRUCK, OR EXCAVATORS ARE ALLOWED UNTIL PROPER FILL DEPTHS ARE REACHED IN ACCORDANCE WITH THE "STORMTECH MC-3500MC-4500 CONSTRUCTION GUIDE".
  - WEIGHT LIMITS FOR CONSTRUCTION EQUIPMENT CAN BE FOUND IN THE "STORMTECH MC-3500MC-4500 CONSTRUCTION GUIDE".
- FULL 36" (900 mm) OF STABILIZED COVER MATERIALS OVER THE CHAMBERS IS REQUIRED FOR DUMP TRUCK TRAVEL OR DUMPING.

USE OF A DOZER TO PUSH EMBEDMENT STONE BETWEEN THE ROWS OF CHAMBERS MAY CAUSE DAMAGE TO CHAMBERS AND IS NOT AN ACCEPTABLE BACKFILL METHOD. ANY CHAMBERS DAMAGED BY USING THE "DUMP AND PUSH" METHOD ARE NOT COVERED UNDER THE STORMTECH STANDARD WARRANTY.

CONTACT STORMTECH AT 1-800-821-6710 WITH ANY QUESTIONS ON INSTALLATION REQUIREMENTS OR WEIGHT LIMITS FOR CONSTRUCTION EQUIPMENT.

PROPOSED LAYOUT	PROPOSED ELEVATIONS
70 STORMTECH MC-3500 CHAMBERS	838.08 MAXIMUM ALLOWABLE GRADE (TOP OF PAVEMENT/UNPAVED)
10 STORMTECH MC-3500 END CAPS	832.08 MINIMUM ALLOWABLE GRADE (UNPAVED WITH TRAFFIC)
12 STONE ABOVE (in)	831.58 MINIMUM ALLOWABLE GRADE (UNPAVED NO TRAFFIC)
9 STONE BELOW (in)	831.58 MINIMUM ALLOWABLE GRADE (BASE OF FLEXIBLE PAVEMENT)
40 % STONE VOID	831.58 MINIMUM ALLOWABLE GRADE (TOP OF RIGID PAVEMENT)
14,163 INSTALLED SYSTEM VOLUME (CF)	831.08 TOP OF STONE
4,298 SYSTEM AREA (ft <sup>2</sup> )	830.08 TOP OF MC-3500 CHAMBER
348 SYSTEM PERIMETER (ft)	827.54 24" TOP MANIFOLD CONNECTION INVERT
	826.50 24" ISOLATOR ROW PLUS CONNECTION INVERT
	826.33 BOTTOM OF MC-3500 CHAMBER
	825.58 UNDERDRAIN INVERT
	825.58 BOTTOM OF STONE

PART TYPE	ITEM ON LAYOUT	DESCRIPTION	INVERT	MAX FLOW
PREFABRICATED END CAP	A	24" BOTTOM CORED END CAP PART# MC3500EPP24BC TYP OF ALL 24" BOTTOM CONNECTIONS AND ISOLATOR PLUS ROWS	2.06"	
PREFABRICATED END CAP	B	24" TOP CORED END CAP PART# MC3500EPP24TC TYP OF ALL 24" TOP CONNECTIONS	14.48"	
FLAMP	C	INSTALL FLAMP ON 24" ACCESS PIPE PART# MCFLAMP (TYP 2 PLACES)		
MANIFOLD	D	24" x 24" BOTTOM MANIFOLD, ADS N-12	2.06"	
MANIFOLD	E	24" x 24" TOP MANIFOLD, ADS N-12	14.48"	
MANIFOLD	F	24" x 24" TOP MANIFOLD, ADS N-12	14.48"	
PIPE CONNECTION	G	24" BOTTOM CONNECTION	2.06"	
NYLOPLAST (INLET W/ ISO PLUS ROW)	H	30" DIAMETER (48" SUMP DEPTH REQUIRED)		17.0 CFS IN
NYLOPLAST (INLET W/ ISO PLUS ROW)	I	30" DIAMETER (48" SUMP DEPTH REQUIRED)		8.5 CFS IN
NYLOPLAST (OUTLET)	J	30" DIAMETER (48" SUMP DEPTH REQUIRED)		14.0 CFS OUT
UNDERDRAIN	K	6" ADS N-12 DRAIN MANHOLE MANHOLE UNDERDRAIN		
INSPECTION PORT CONNECTION	L	4" SEE DETAIL (TYP 2 PLACES)		
CONNECTION	M	24" TOP CONNECTION, ADS N-12	14.48"	

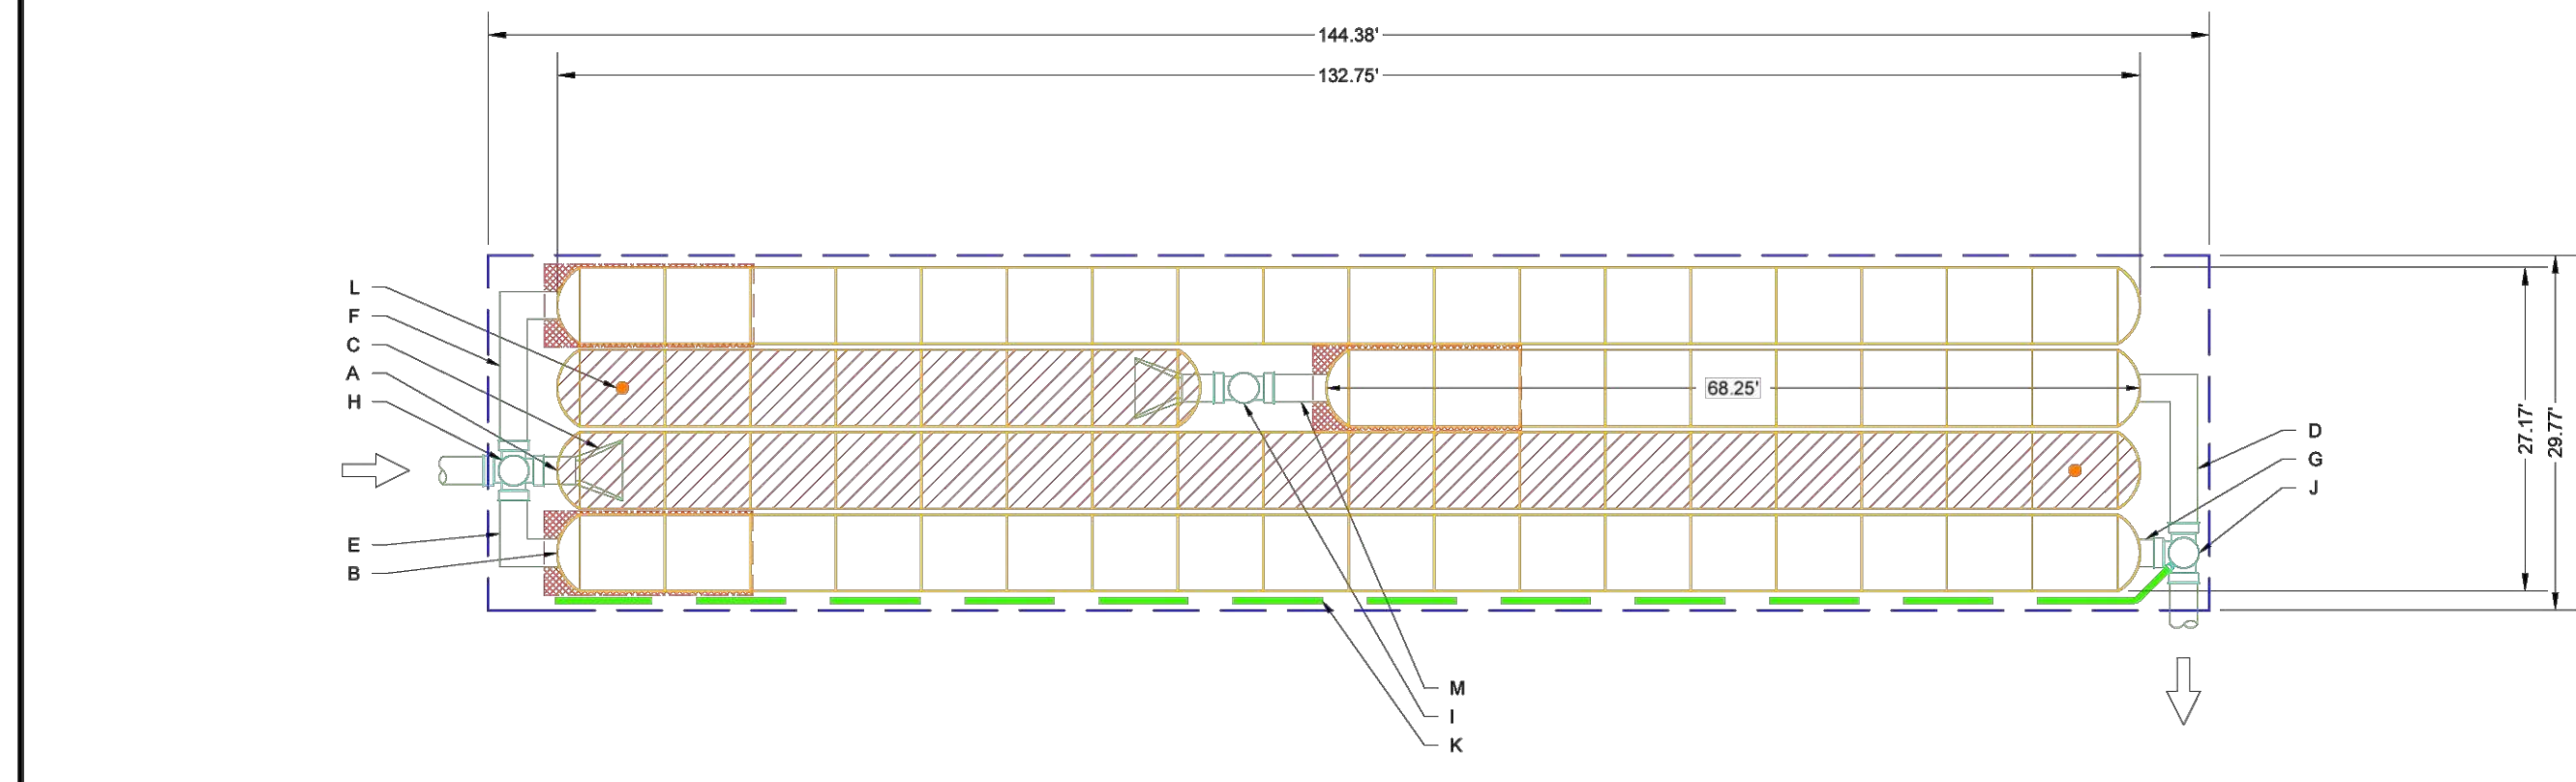


- ISOLATOR ROW PLUS (SEE DETAIL)
- PLACE MINIMUM 17.5' OF ADSPLUS125 WOVEN GEOTEXTILE OVER BEDDING STONE AND UNDERNEATH CHAMBER FEET FOR SCOUR PROTECTION AT ALL CHAMBER INLET ROWS
- BED LIMITS

**NOTES**  
 • NOT FOR CONSTRUCTION: THIS LAYOUT IS FOR DIMENSIONAL PURPOSES ONLY TO PROVE CONCEPT & THE REQUIRED STORAGE VOLUME CAN BE ACHIEVED ON SITE.

**ACCEPTABLE FILL MATERIALS: STORMTECH MC-3500 CHAMBER SYSTEMS**

MATERIAL LOCATION	DESCRIPTION	AASHTO MATERIAL CLASSIFICATIONS	COMPACTION / DENSITY REQUIREMENT
D FINAL FILL: FILL MATERIAL FOR LAYER 'D' STARTS FROM THE TOP OF THE 'C' LAYER TO THE BOTTOM OF FLEXIBLE PAVEMENT OR UNPAVED FINISHED GRADE ABOVE. NOTE THAT PAVEMENT SUBBASE MAY BE PART OF THE 'D' LAYER	ANY SOIL/ROCK MATERIALS, NATIVE SOILS, OR PER ENGINEER'S PLANS. CHECK PLANS FOR PAVEMENT SUBGRADE REQUIREMENTS.	N/A	PREPARE PER SITE DESIGN ENGINEER'S PLANS. PAVED INSTALLATIONS MAY HAVE STRINGENT MATERIAL AND PREPARATION REQUIREMENTS.
C INITIAL FILL: FILL MATERIAL FOR LAYER 'C' STARTS FROM THE TOP OF THE EMBEDMENT STONE ('B' LAYER) TO 24" (600 mm) ABOVE THE TOP OF THE CHAMBER. NOTE THAT PAVEMENT SUBBASE MAY BE PART OF THE 'C' LAYER.	GRANULAR WELL-GRADED SOIL/AGGREGATE MIXTURES, <35% FINES OR PROCESSED AGGREGATE. MOST PAVEMENT SUBBASE MATERIALS CAN BE USED IN LIEU OF THIS LAYER.	AASHTO M145 <sup>1</sup> A-1, A-2-4, A-3 OR AASHTO M43 <sup>1</sup> 3, 357, 4, 467, 5, 56, 57, 6, 67, 68, 7, 78, 8, 89, 9, 10	BEGIN COMPACTIONS AFTER 24" (600 mm) OF MATERIAL OVER THE CHAMBERS IS REACHED. COMPACT ADDITIONAL LAYERS IN 12" (300 mm) MAX LIFTS TO A MIN. 95% PROCTOR DENSITY FOR WELL GRADED MATERIAL AND 90% RELATIVE DENSITY FOR PROCESSED AGGREGATE MATERIALS.
B EMBEDMENT STONE: FILL SURROUNDING THE CHAMBERS FROM THE FOUNDATION STONE ('A' LAYER) TO THE 'C' LAYER ABOVE.	CLEAN, CRUSHED, ANGULAR STONE OR RECYCLED CONCRETE <sup>2</sup>	AASHTO M43 <sup>1</sup> 3, 357, 4, 467, 5, 56, 57	NO COMPACTION REQUIRED.
A FOUNDATION STONE: FILL BELOW CHAMBERS FROM THE SUBGRADE UP TO THE FOOT (BOTTOM) OF THE CHAMBER.	CLEAN, CRUSHED, ANGULAR STONE OR RECYCLED CONCRETE <sup>2</sup>	AASHTO M43 <sup>1</sup> 3, 357, 4, 467, 5, 56, 57	PLATE COMPACT OR ROLL TO ACHIEVE A FLAT SURFACE. <sup>3,4</sup>

PLEASE NOTE:  
 1. THE LISTED AASHTO DESIGNATIONS ARE FOR GRADATIONS ONLY. THE STONE MUST ALSO BE CLEAN, CRUSHED, ANGULAR. FOR EXAMPLE, A SPECIFICATION FOR #4 STONE WOULD STATE: "CLEAN, CRUSHED, ANGULAR NO. 4 (AASHTO M43) STONE".  
 2. STORMTECH COMPACTION REQUIREMENTS ARE MET FOR 'A' LOCATION MATERIALS WHEN PLACED AND COMPACTED IN 6" (230 mm) (MAX) LIFTS USING TWO FULL COVERAGES WITH A VIBRATORY COMPACTOR.  
 3. WHERE INFILTRATION SURFACES MAY BE COMPACTIONED FOR STANDARD DESIGN LOAD CONDITIONS, A FLAT SURFACE MAY BE ACHIEVED BY RAKING OR DRAGGING WITHOUT COMPACTION EQUIPMENT. FOR SPECIAL LOAD DESIGNS, CONTACT STORMTECH FOR COMPACTION REQUIREMENTS.  
 4. ONCE LAYER 'C' IS IN PLACE, SOIL/MATERIAL CAN BE PLACED IN LAYER 'D' UP TO THE FINISHED GRADE. MOST PAVEMENT SUBBASE SOILS CAN BE USED TO REPLACE THE MATERIAL REQUIREMENTS OF LAYER 'C' OR 'D' AT THE SITE DESIGN ENGINEER'S DISCRETION.  
 5. WHERE RECYCLED CONCRETE AGGREGATE IS USED IN LAYERS 'A' OR 'B' THE MATERIAL SHOULD ALSO MEET THE ACCEPTABILITY CRITERIA OUTLINED IN TECHNICAL NOTE 6.20 "RECYCLED CONCRETE STRUCTURAL BACKFILL".

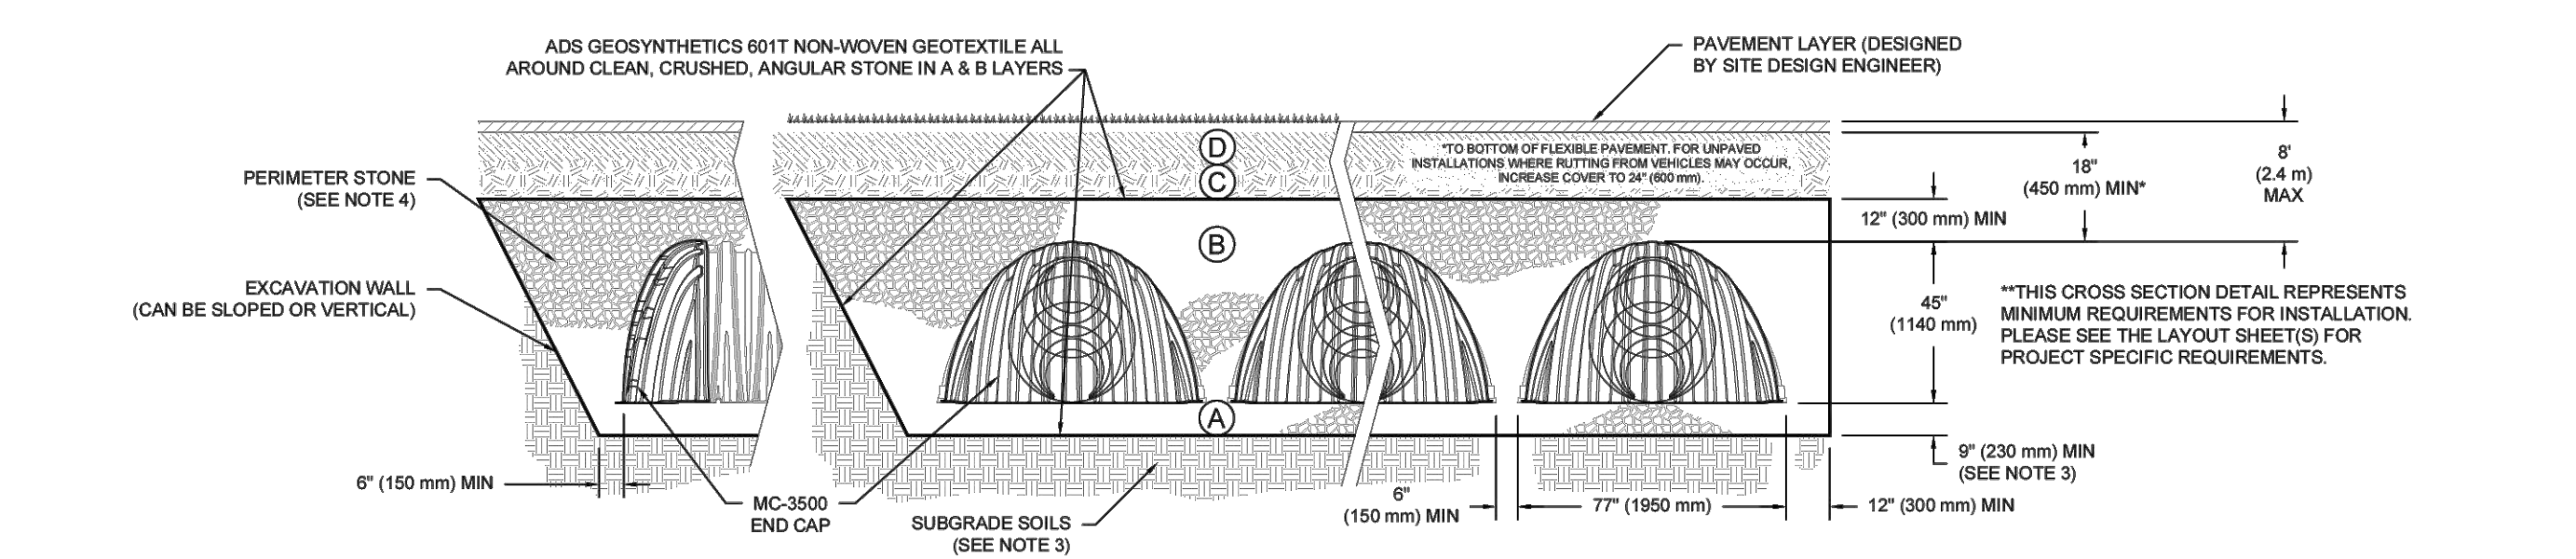


- NOTES:**
- CHAMBERS SHALL MEET THE REQUIREMENTS OF ASTM F2418, "STANDARD SPECIFICATION FOR POLYPROPYLENE (PP) CORRUGATED WALL STORMWATER COLLECTION CHAMBERS" CHAMBER CLASSIFICATION 45x76 DESIGNATION SS.
  - MC-3500 CHAMBERS SHALL BE DESIGNED IN ACCORDANCE WITH ASTM F2787 "STANDARD PRACTICE FOR STRUCTURAL DESIGN OF THERMOPLASTIC CORRUGATED WALL STORMWATER COLLECTION CHAMBERS".
  - THE SITE DESIGN ENGINEER IS RESPONSIBLE FOR ASSESSING THE BEARING RESISTANCE (ALLOWABLE BEARING CAPACITY) OF THE SUBGRADE SOILS AND THE DEPTH OF FOUNDATION STONE WITH CONSIDERATION FOR THE RANGE OF EXPECTED SOIL MOISTURE CONDITIONS. REFERENCE STORMTECH DESIGN MANUAL FOR BEARING CAPACITY GUIDANCE.
  - PERIMETER STONE MUST BE EXTENDED HORIZONTALLY TO THE EXCAVATION WALL FOR BOTH VERTICAL AND SLOPED EXCAVATION WALLS.
  - REQUIREMENTS FOR HANDLING AND INSTALLATION:
    - TO MAINTAIN THE WIDTH OF CHAMBERS DURING SHIPPING AND HANDLING, CHAMBERS SHALL HAVE INTEGRAL, INTERLOCKING STACKING LOGS.
    - TO ENSURE A SECURE JOINT DURING INSTALLATION AND BACKFILL, THE HEIGHT OF THE CHAMBER JOINT SHALL NOT BE LESS THAN 3".
    - TO ENSURE THE INTEGRITY OF THE ARCH SHAPE DURING INSTALLATION, THE ARCH STIFFNESS CONSTANT SHALL BE GREATER THAN OR EQUAL TO 450 LBS/FT<sup>2</sup>. THE ASC IS DEFINED IN SECTION 6.2.8 OF ASTM F2418, AND b) TO RESIST CHAMBER DEFORMATION DURING INSTALLATION AT ELEVATED TEMPERATURES (ABOVE 73° F / 23° C), CHAMBERS SHALL BE PRODUCED FROM REFLECTIVE GOLD OR YELLOW COLORS.

**INSPECTION & MAINTENANCE**


- STEP 1) INSPECT ISOLATOR ROW PLUS FOR SEDIMENT
- INSPECTION PORTS (IF PRESENT)
  - REMOVE/OFFEN LID ON NYLOPLAST INLINE DRAIN
  - REMOVE AND CLEAN FLEXSTORM FILTER IF INSTALLED
  - USING A FLASHLIGHT AND STADIA ROD, MEASURE DEPTH OF SEDIMENT AND RECORD ON MAINTENANCE LOG
  - LOWER A CAMERA INTO ISOLATOR ROW PLUS FOR VISUAL INSPECTION OF SEDIMENT LEVELS (OPTIONAL)
  - IF SEDIMENT IS AT, OR ABOVE, 3" (90 mm) PROCEED TO STEP 2. IF NOT, PROCEED TO STEP 3.
- B. ALL ISOLATOR PLUS ROWS
- REMOVE COVER FROM STRUCTURE AT UPSTREAM END OF ISOLATOR ROW PLUS
  - USING A FLASHLIGHT, INSPECT DOWN THE ISOLATOR ROW PLUS THROUGH OUTLET PIPE
    - MIRRORS ON POLES OR CAMERAS MAY BE USED TO AVOID A CONFINED SPACE ENTRY
    - FOLLOW OSHA REGULATIONS FOR CONFINED SPACE ENTRY IF ENTERING MANHOLE
  - IF SEDIMENT IS AT, OR ABOVE, 3" (90 mm) PROCEED TO STEP 2. IF NOT, PROCEED TO STEP 3.
- STEP 2) CLEAN OUT ISOLATOR ROW PLUS USING THE JETVAC PROCESS
- A FIXED CULVERT CLEANING NOZZLE WITH REAR FACING SPRAY OF 45" (1.1 m) OR MORE IS PREFERRED
  - APPLY MULTIPLE PASSES OF JETVAC UNTIL BACKFLUSH WATER IS CLEAR
  - VACUUM STRUCTURE SUMP AS REQUIRED
- STEP 3) REPLACE ALL COVERS, GRATES, FILTERS, AND LIDS; RECORD OBSERVATIONS AND ACTIONS.
- STEP 4) INSPECT AND CLEAN BASINS AND MANHOLES UPSTREAM OF THE STORMTECH SYSTEM.

**NOTES**

- INSPECT EVERY 6 MONTHS DURING THE FIRST YEAR OF OPERATION. ADJUST THE INSPECTION INTERVAL BASED ON PREVIOUS OBSERVATIONS OF SEDIMENT ACCUMULATION AND HIGH WATER ELEVATIONS.
- CONDUCT JETTING AND VACTORING ANNUALLY OR WHEN INSPECTION SHOWS THAT MAINTENANCE IS NECESSARY.

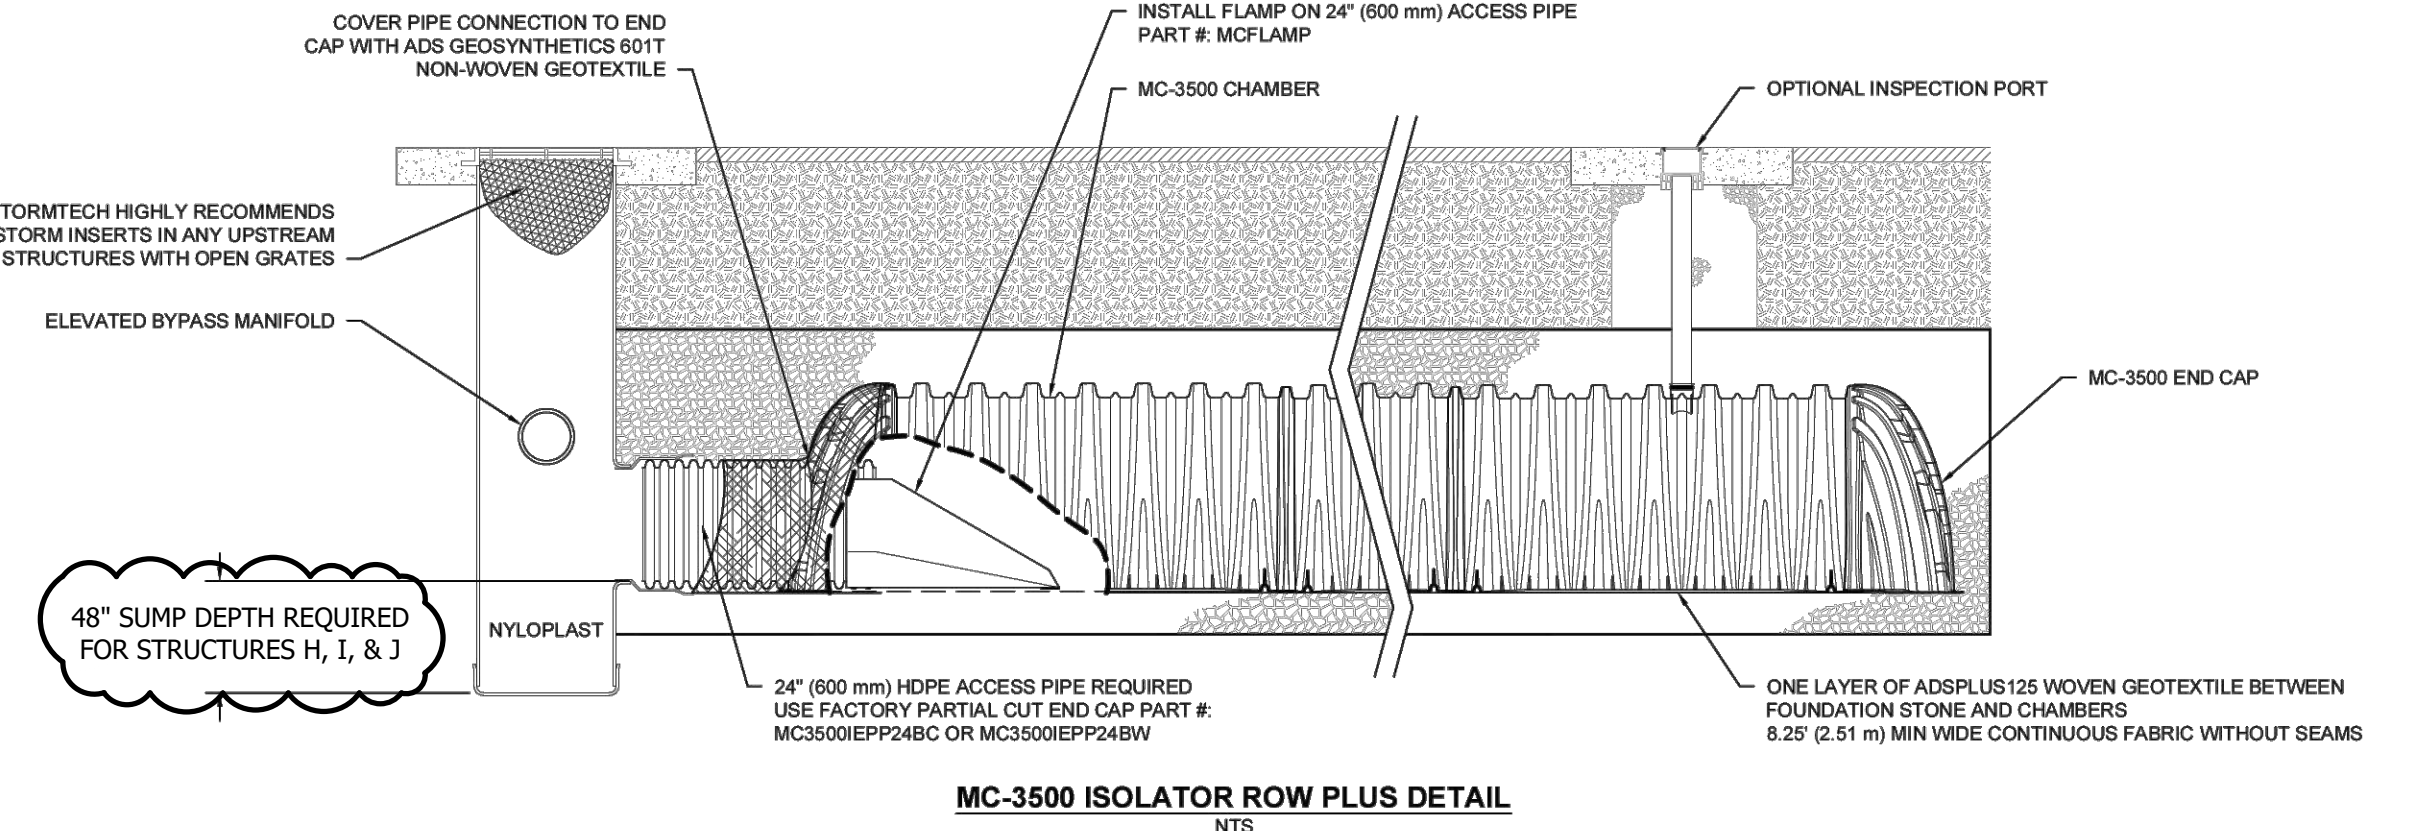

**MC-3500 ISOLATOR ROW PLUS DETAIL**  
 NTS

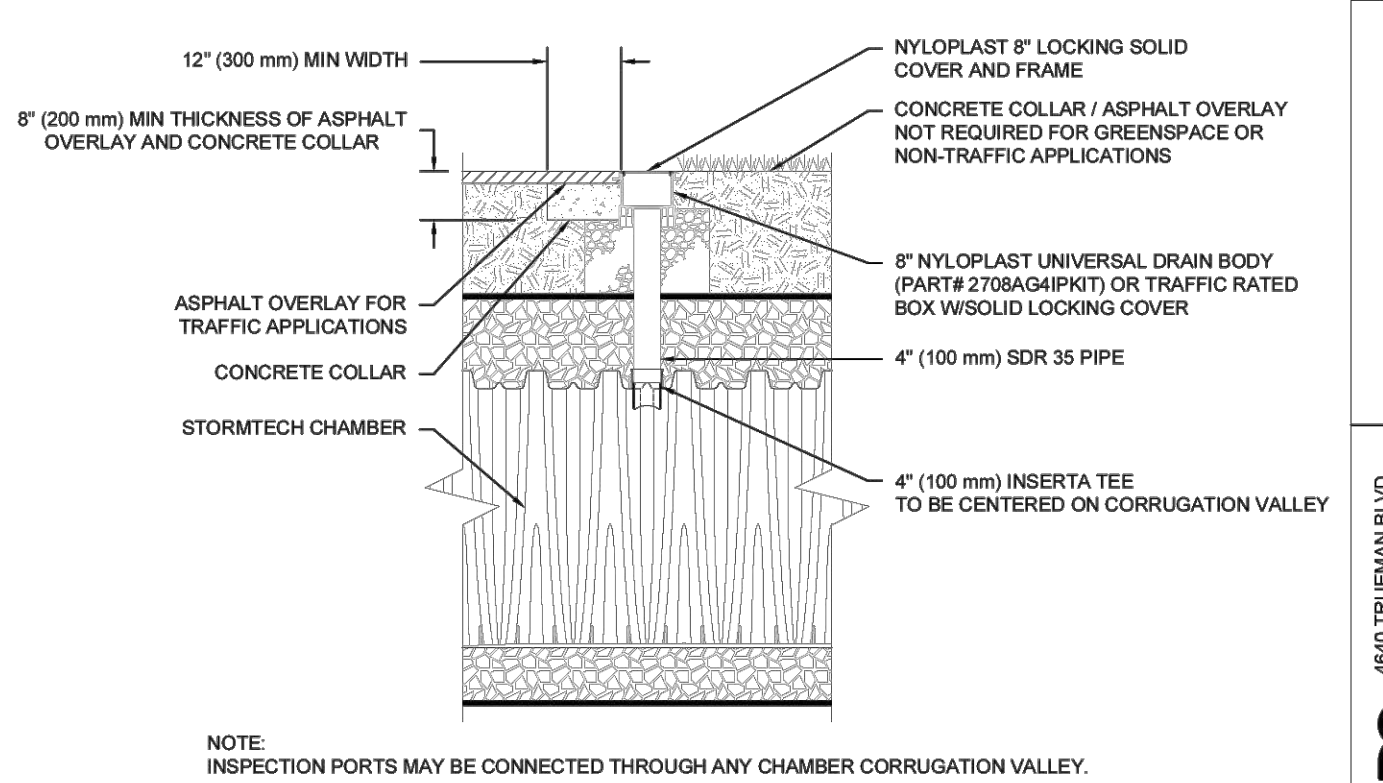


**4" INSPECTION PORT DETAIL**  
 (MC SERIES CHAMBER)  
 NTS

IRONDALE FIRE STATION  
 BIRMINGHAM, AL, USA  
 DATE: 08/14/24  
 PROJECT #: 8427886  
 DRAWN: CLB  
 CHECKED: N/A  
 REVISIONS: NONE  
 STORMTECH Chamber System  
 4640 TREILMAN BLVD  
 HILLIARD, OH 43026  
 1-800-733-7473  
 SHEET 3 OF 6

IRONDALE FIRE STATION  
 BIRMINGHAM, AL, USA  
 DATE: 08/14/24  
 PROJECT #: 8427886  
 DRAWN: CLB  
 CHECKED: N/A  
 REVISIONS: NONE  
 STORMTECH Chamber System  
 4640 TREILMAN BLVD  
 HILLIARD, OH 43026  
 1-800-733-7473  
 SHEET 4 OF 6



Revisions		
No.	Date	Description
1	2/12/25	ADDENDUM #2
2	2/19/25	ADDENDUM #3

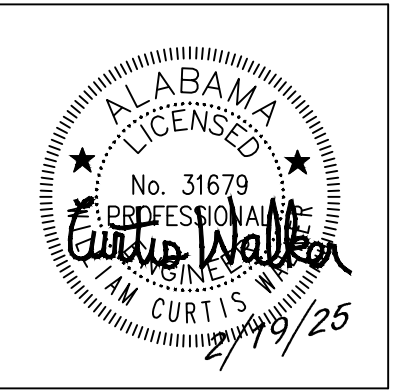


100% CD'S

**IRONDALE FIRE STATION #3**  
2101 JOHN ROGERS DR  
BIRMINGHAM, AL 35210  
CITY OF IRONDALE



**CWA**  
CHARLES WILLIAMS & ASSOCIATES ARCHITECTS  
PH: 205-250-0700  
3601 8TH AVE. SOUTH  
BIRMINGHAM, ALABAMA 35222  
FAX: 205-250-0515

SHEET TITLE: DETAILS  
PROJECT NUMBER: CWA No. 2023-01  
DATE: 8/30/24  
DRAWN BY: WCV  
CHECKED BY: CIE  
SHEET NUMBER

**C5.4**

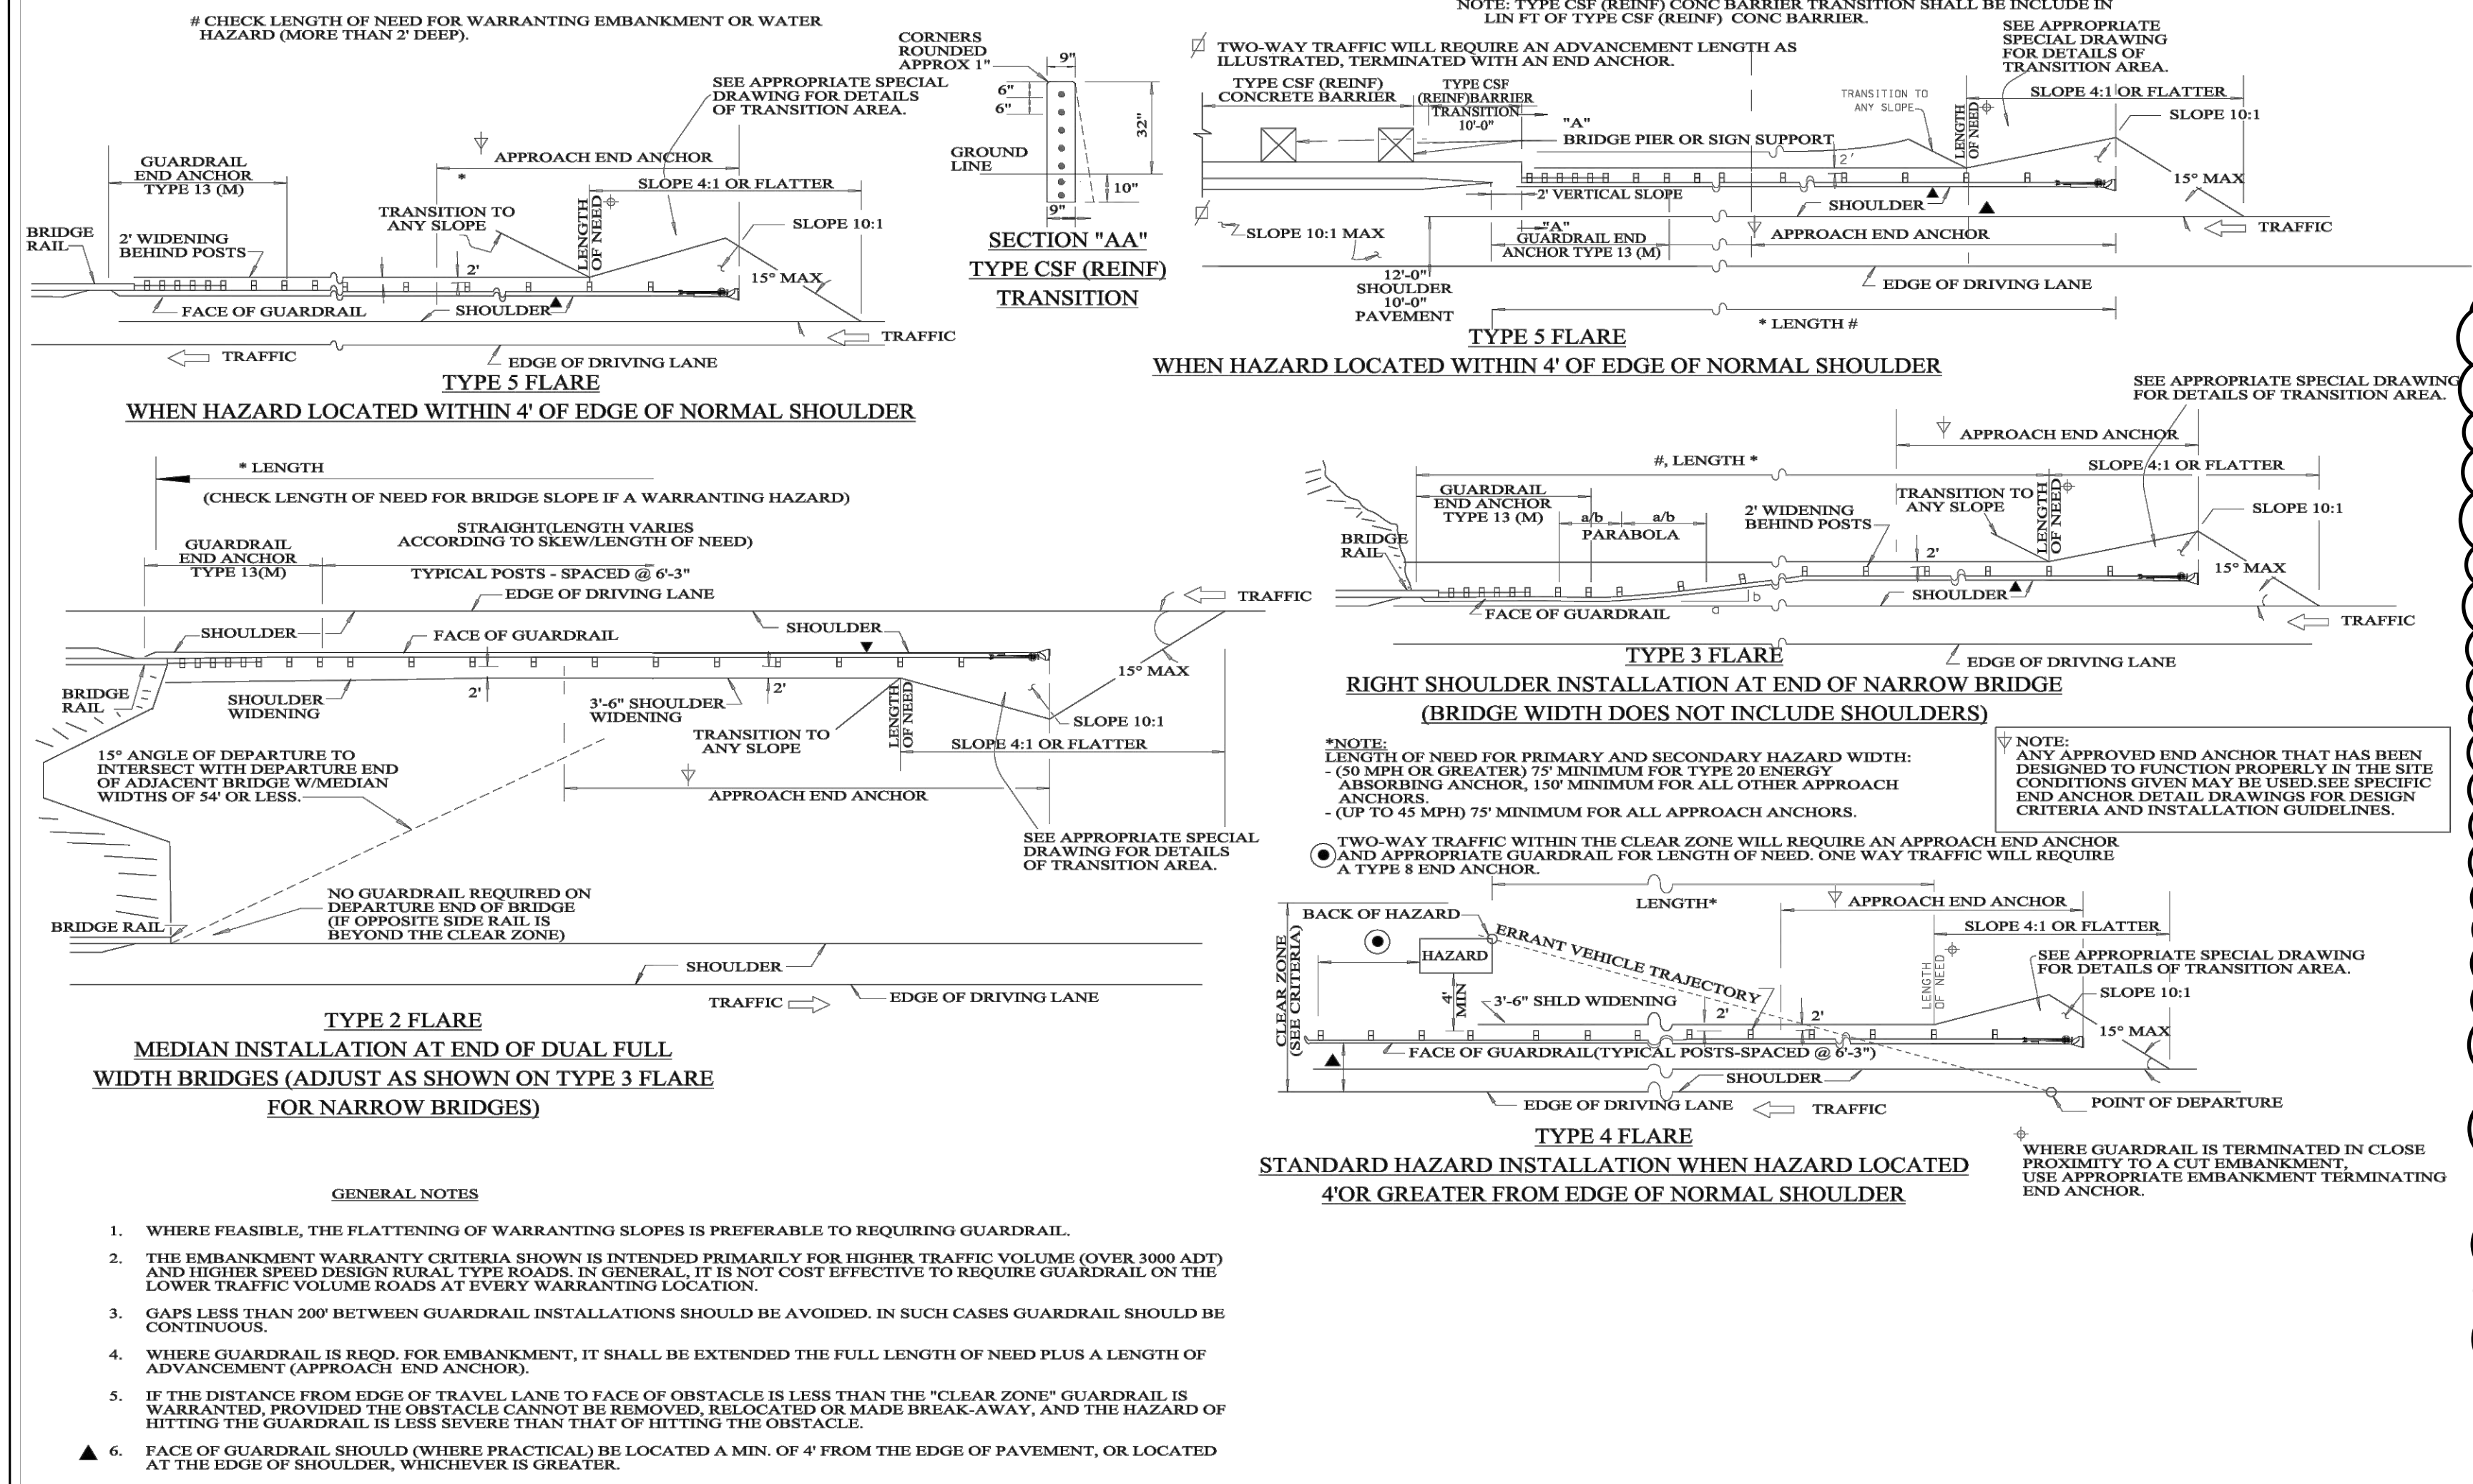

DESIGN SPEED	DESIGN ADT	FILL SLOPES	CUT SLOPES
40 MPH OR LESS	UNDER 750	6:1 OR FLATTER	4:1 TO 5:1
	750-1500	7:10	7:10
	1500-6000	12-14	12-14
45-50 MPH	UNDER 750	10-12	8-10
	750-1500	14-16	10-12
	1500-6000	16-18	14-16
55 MPH	UNDER 750	12-14	10-12
	750-1500	16-18	14-16
	1500-6000	20-22	18-20
60 MPH	UNDER 750	16-18	12-14
	750-1500	20-24	16-18
	1500-6000	26-30	22-24
65-70 MPH	UNDER 750	18-20	14-16
	750-1500	24-26	18-20
	1500-6000	28-32	24-26

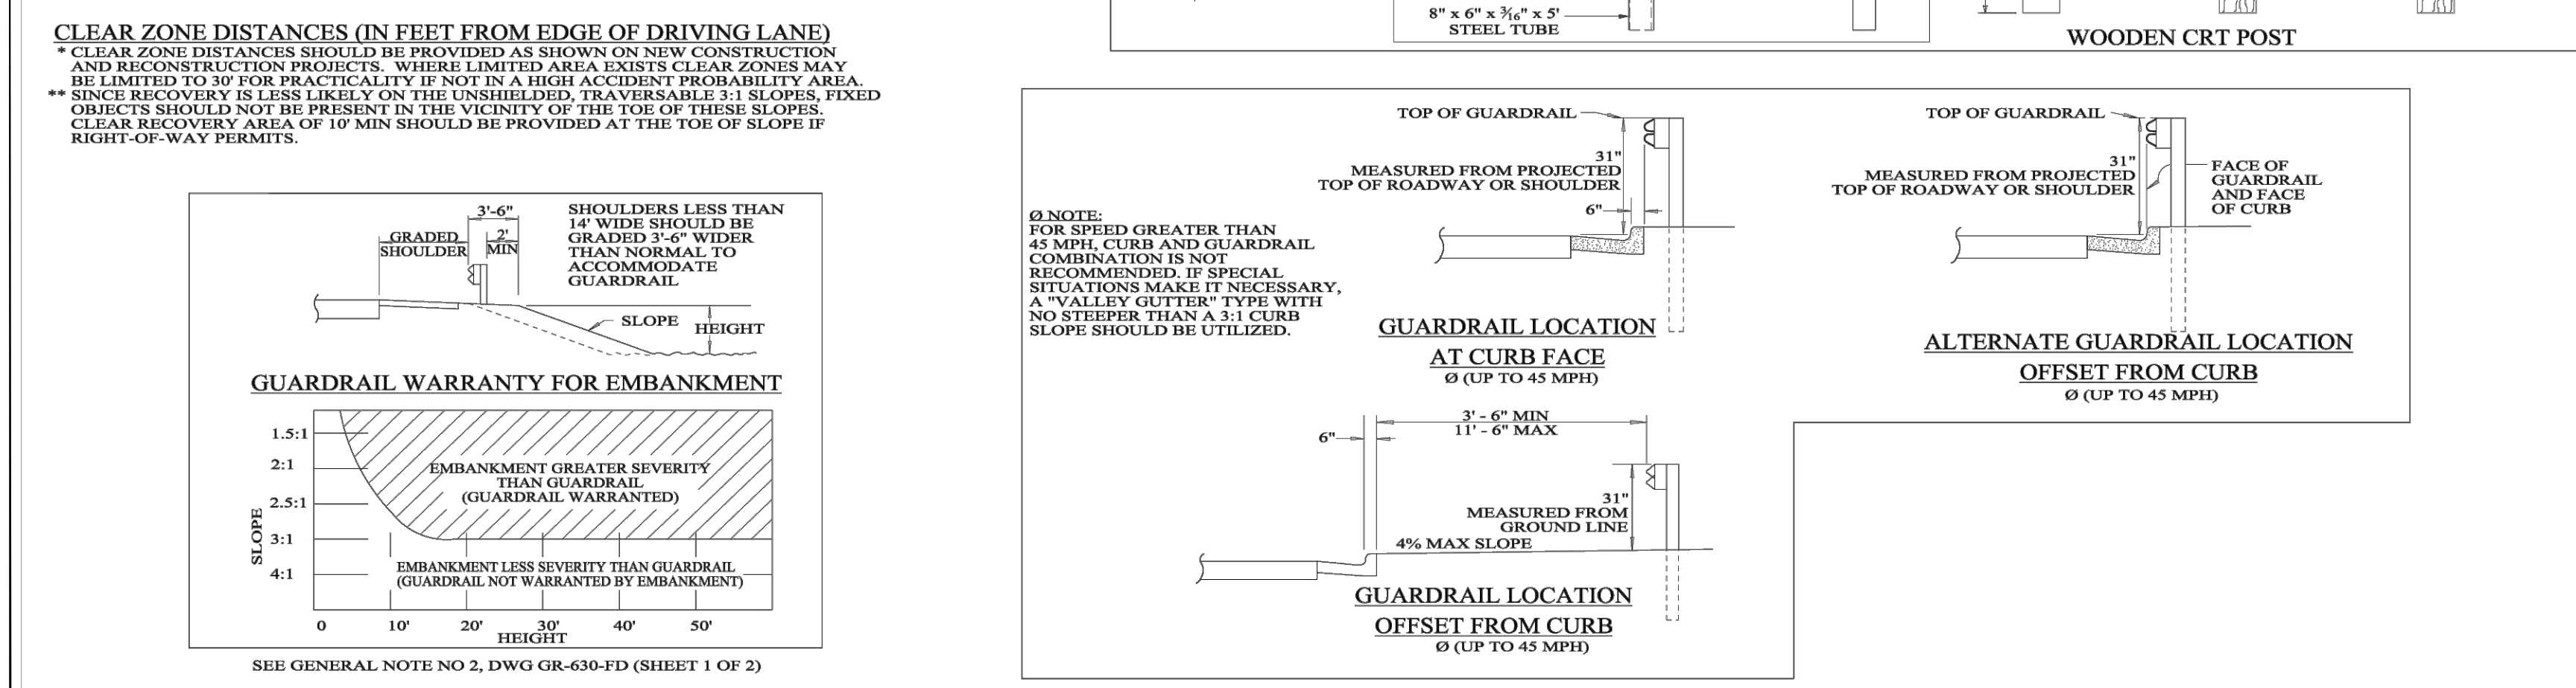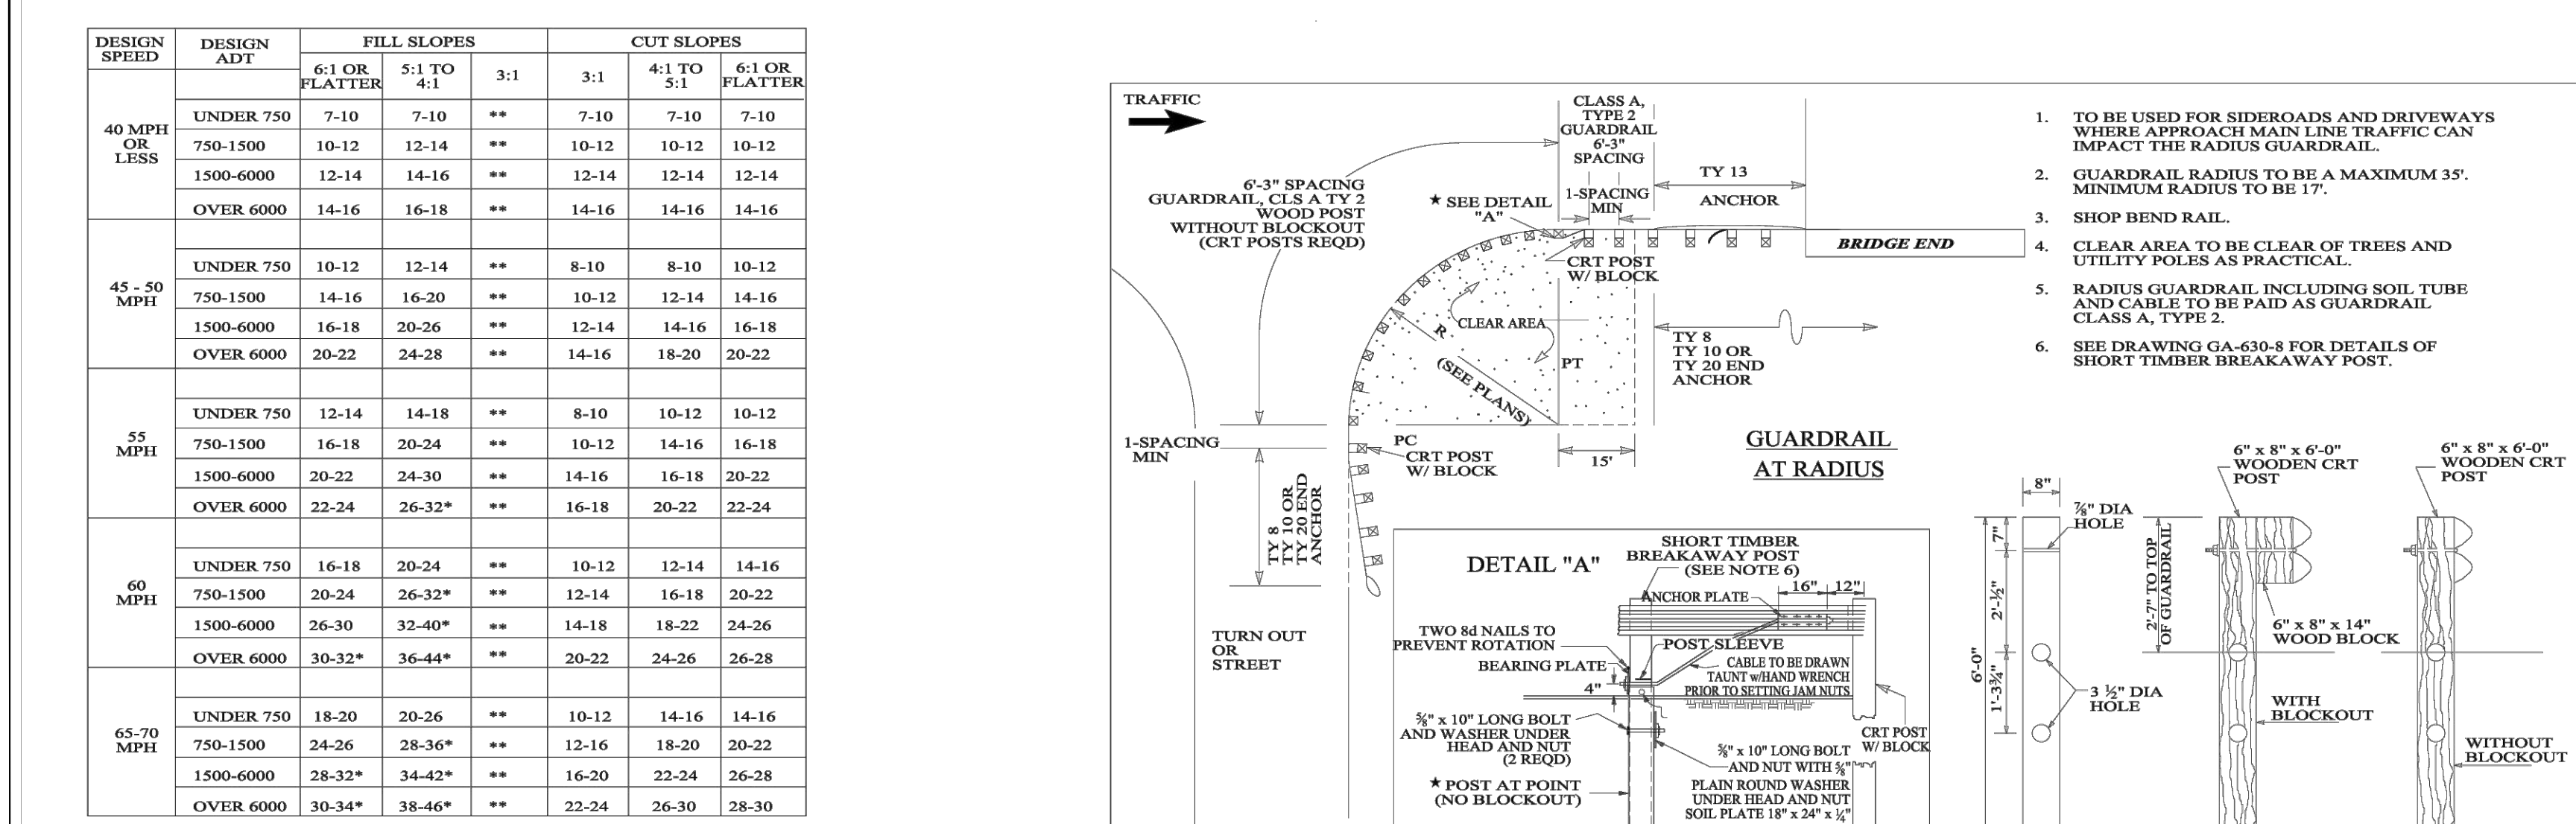



DESIGN SPEED	DESIGN ADT	FILL SLOPES	CUT SLOPES
40 MPH OR LESS	UNDER 750	7:10	7:10
	750-1500	12-14	12-14
	1500-6000	14-16	12-14
45-50 MPH	UNDER 750	10-12	8-10
	750-1500	14-16	10-12
	1500-6000	16-18	14-16
55 MPH	UNDER 750	12-14	10-12
	750-1500	16-18	14-16
	1500-6000	20-22	18-20
60 MPH	UNDER 750	16-18	12-14
	750-1500	20-24	16-18
	1500-6000	26-30	22-24
65-70 MPH	UNDER 750	18-20	14-16
	750-1500	24-26	18-20
	1500-6000	28-32	24-26

TABLE MU-1: MULCHING MATERIALS AND APPLICATION RATES			TABLE TS-1: COMMONLY USED PLANTS FOR TEMPORARY COVER				TABLE PS-1: COMMONLY USED PLANTS FOR PERMANENT COVER WITH SEEDING RATES AND DATES					
MATERIAL	RATE PER ACRE (PER 1,000 SQ. FT.)	NOTES	SPECIES	SEEDING RATE PER AC PLS	NORTH	CENTRAL	SOUTH	SPECIES	SEEDING RATE PER AC PLS	NORTH	CENTRAL	SOUTH
STRAW WITH SEED	1 1/2 - 2 TONS (70 LBS - 90 LBS)	SPREAD BY HAND OR MACHINE TO ATTAIN 75% GROUND COVER; ANCHOR WHEN SUBJECT TO BLOWING.	MILLET, BROWNTOP, OR GERMAN RYE	40 LBS	MAY 1 - AUG 1	ARP 1 - AUG 15	ARP 1 - AUG 15	BAHIA GRASS, PENSACOLA	40 LBS	MAR 1 - JULY 1	FEB 1 - NOV 1	
STRAW ALONE (NO SEED)	2 1/2 - 3 TONS (115 LBS - 160 LBS)	SPREAD BY HAND OR MACHINE; ANCHOR WHEN SUBJECT TO BLOWING.	RYEGRASS	30 LBS	SEPT 1 - SEPT 15	SEPT 1 - OCT 15	SEPT 1 - OCT 15	BERMUDAGRASS, COMMON	10 LBS	APR 1 - JULY 1	MAR 1 - JULY 15	MAR 1 - JULY 15
WOOD CHIPS	5-6 TONS (225 LBS - 270 LBS)	TREAT WITH 12 LBS. NITROGEN/TON.	SORGHUM - SUDAN HYBRIDS	40 LBS	MAY 1 - AUG 1	APR 15 - AUG 1	ARP 1 - AUG 15	BERMUDAGRASS, COMMON	5 LBS	MAR 1 - JULY 1	MAR 1 - JULY 15	MAR 1 - JULY 15
BARK	35 CUBIC YARDS (0.8 CUBIC YARD)	CAN APPLY WITH MULCH BLOWER.	SUNDANGRASS	40 LBS	MAY 1 - AUG 1	APR 15 - AUG 1	ARP 1 - AUG 15	BERMUDAGRASS, HYBRID (LAWN TYPES)	SOLID SOD	ANYTIME	ANYTIME	ANYTIME
PINE STRAW	1-2 TONS (45 LBS - 90 LBS)	SPREAD BY HAND OR MACHINE; WILL NOT BLOW LIKE STRAW.	WHEAT	3 BU	SEPT 1 - NOV 1	SEPT 15 - NOV 15	SEPT 15 - NOV 15	BERMUDAGRASS, HYBRID (LAWN TYPES)	SPRIGS 1/SQ FT	MAR 1 - AUG 1	MAR 1 - AUG 1	FEB 15 - SEPT 1
PEANUT HULLS	10-20 TON (450 LBS - 900 LBS)	WILL WASH OFF SLOPES. TREAT WITH 12 LBS. NITROGEN/TON.	COMMON BERMUDAGRASS	10 LBS	APR 1 - JULY 1	MAR 15 - JULY 15	MAR 1 - JULY 15	FESCUE, TALL	40 - 50 LBS	SEPT 1 - NOV 1	SEPT 1 - NOV 1	
			CRIMSON CLOVER	10 LBS	SEPT 1 - NOV 1	SEPT 1 - NOV 1	SEPT 1 - NOV 1	SERICEA	40 - 60 LBS	MAR 15 - JULY 15	MAR 1 - JULY 15	FEB 15 - JULY 15
								SERICEA & COMMON BERMUDAGRASS	40 - 60 LBS 10 LBS	MAR 15 - JULY 15	MAR 1 - JULY 15	FEB 15 - JULY 15
								SWITCHGRASS, ALAMO	4 LBS	APR 1 - JUN 15	MAR 15 - JUN 15	MAR 15 - JUN 15


**NOTES:**

- ANY DISTURBED AREA, MUST BE PLANTED OR OTHERWISE PROVIDED WITH GROUND COVER, MATERIALS, DEVICES, AND/OR STRUCTURES SUFFICIENT TO RESTRAIN ALL FORMS OF EROSION, TO THE MAXIMUM EXTENT PRACTICABLE WITHIN FOURTEEN (14) DAYS OF STOPPING WORK.
- CONTRACTOR TO COORDINATE PERMANENT SEEDING WITH OWNER.


**MULCHING, TEMPORARY SEEDING, & PERMANENT SEEDING DIRECTIONS**

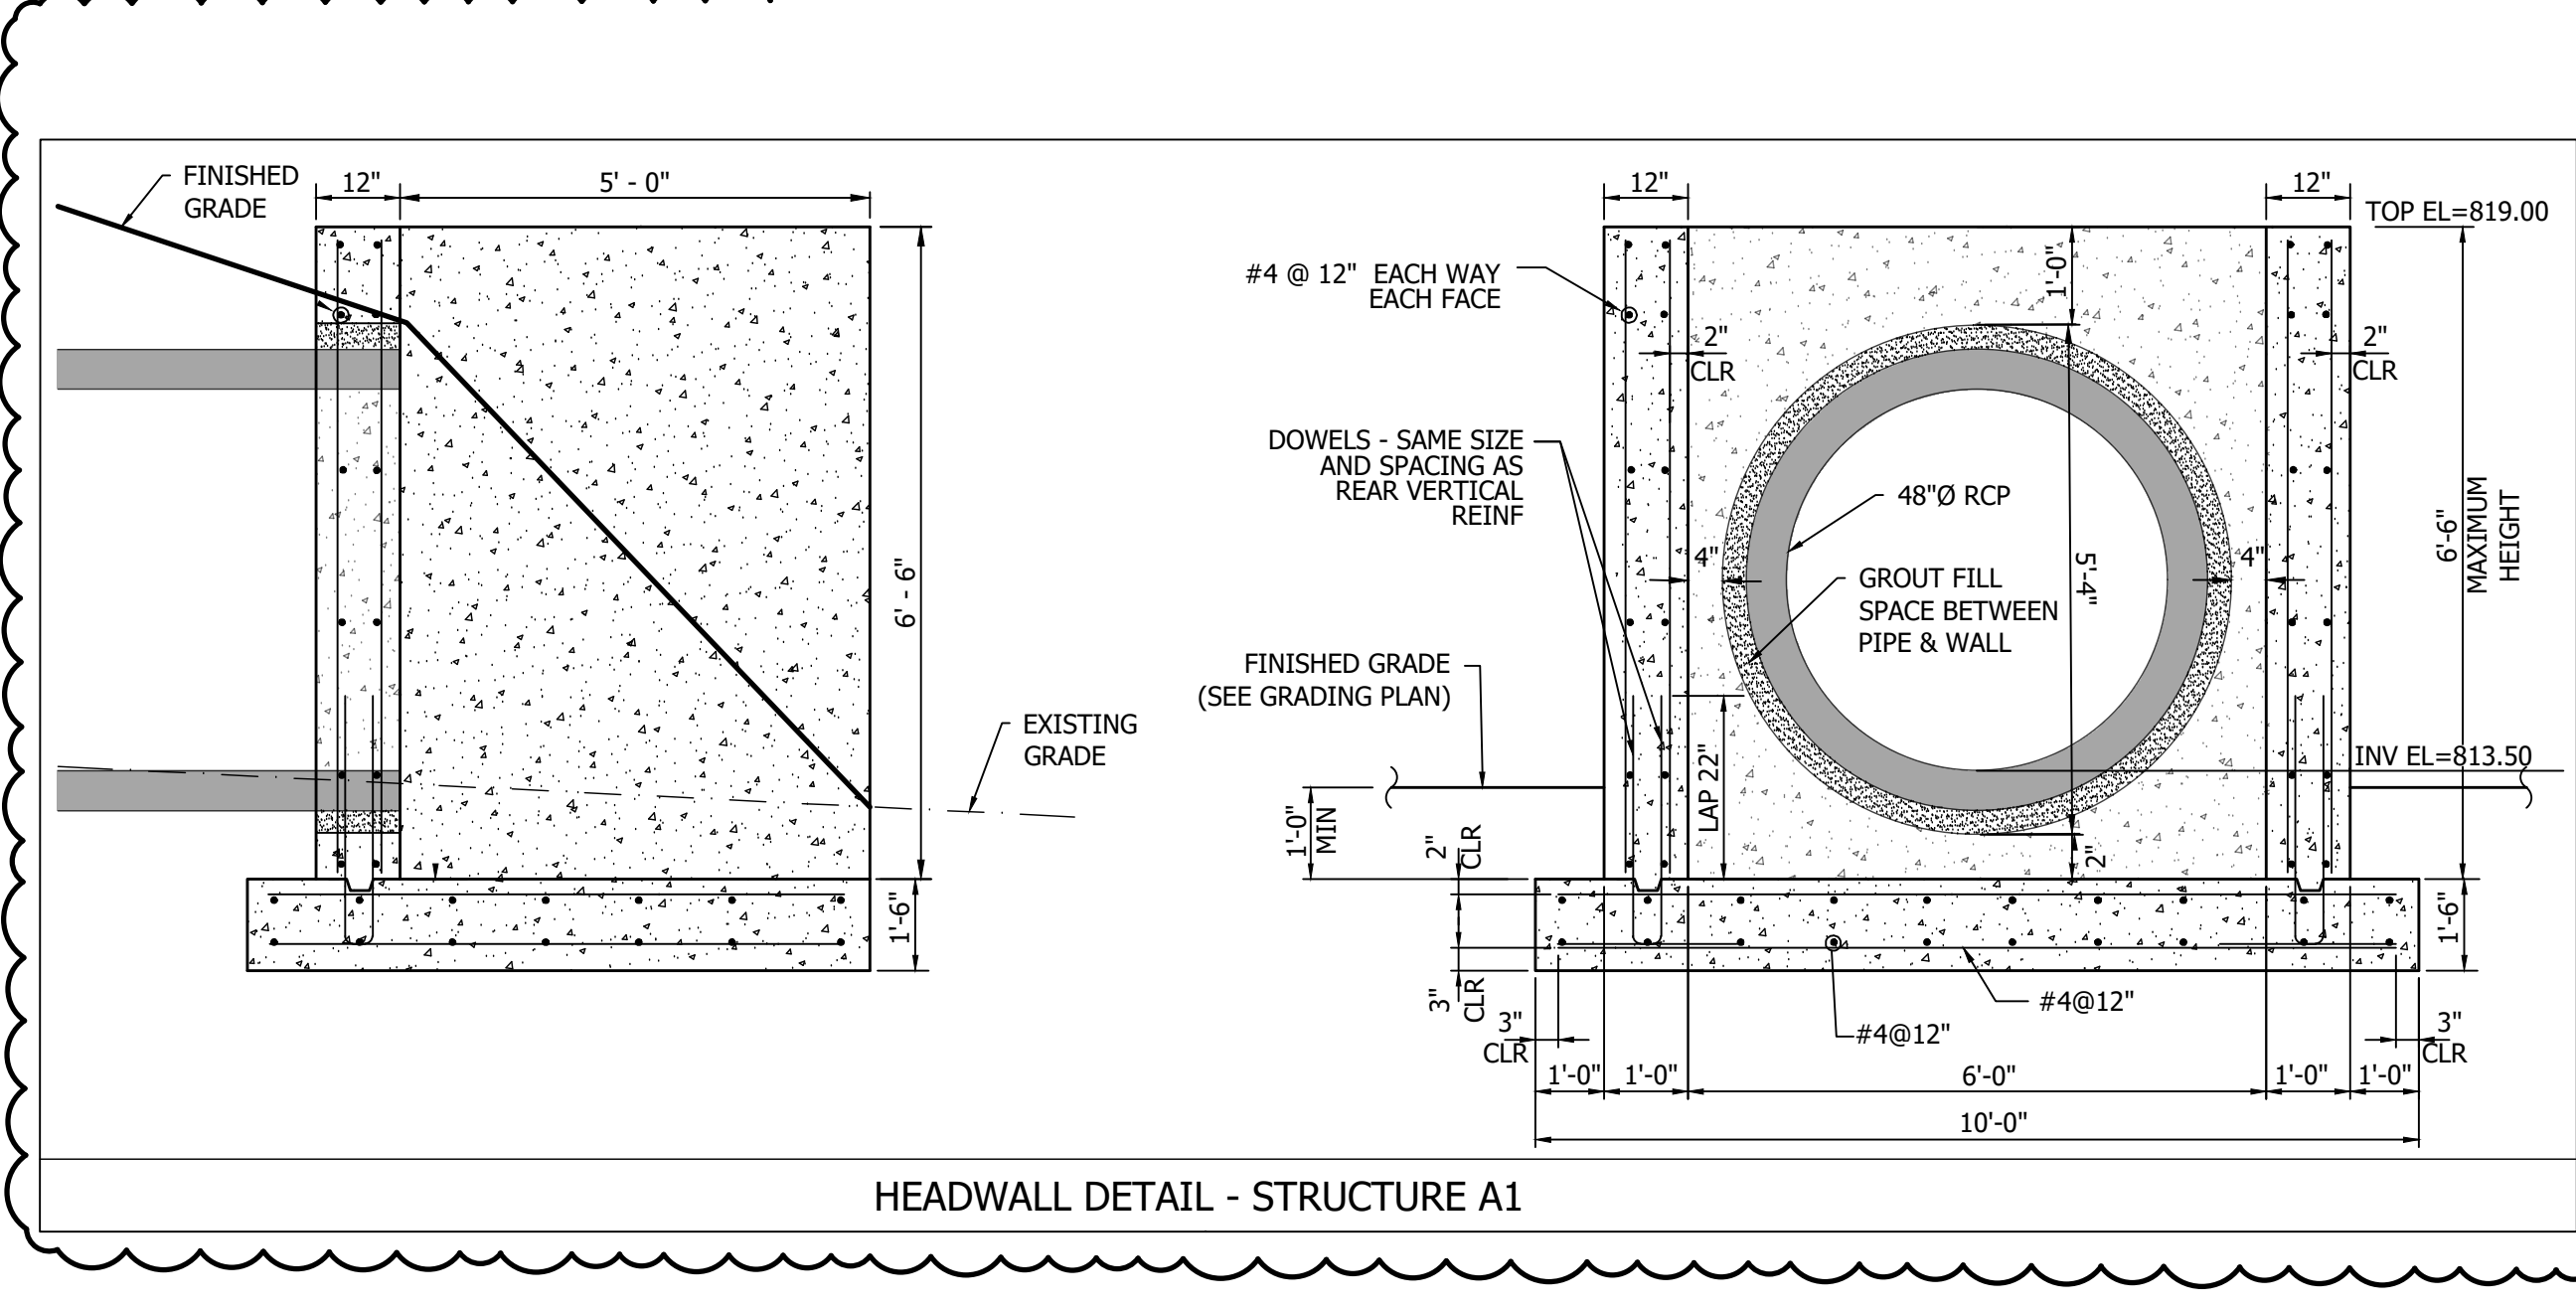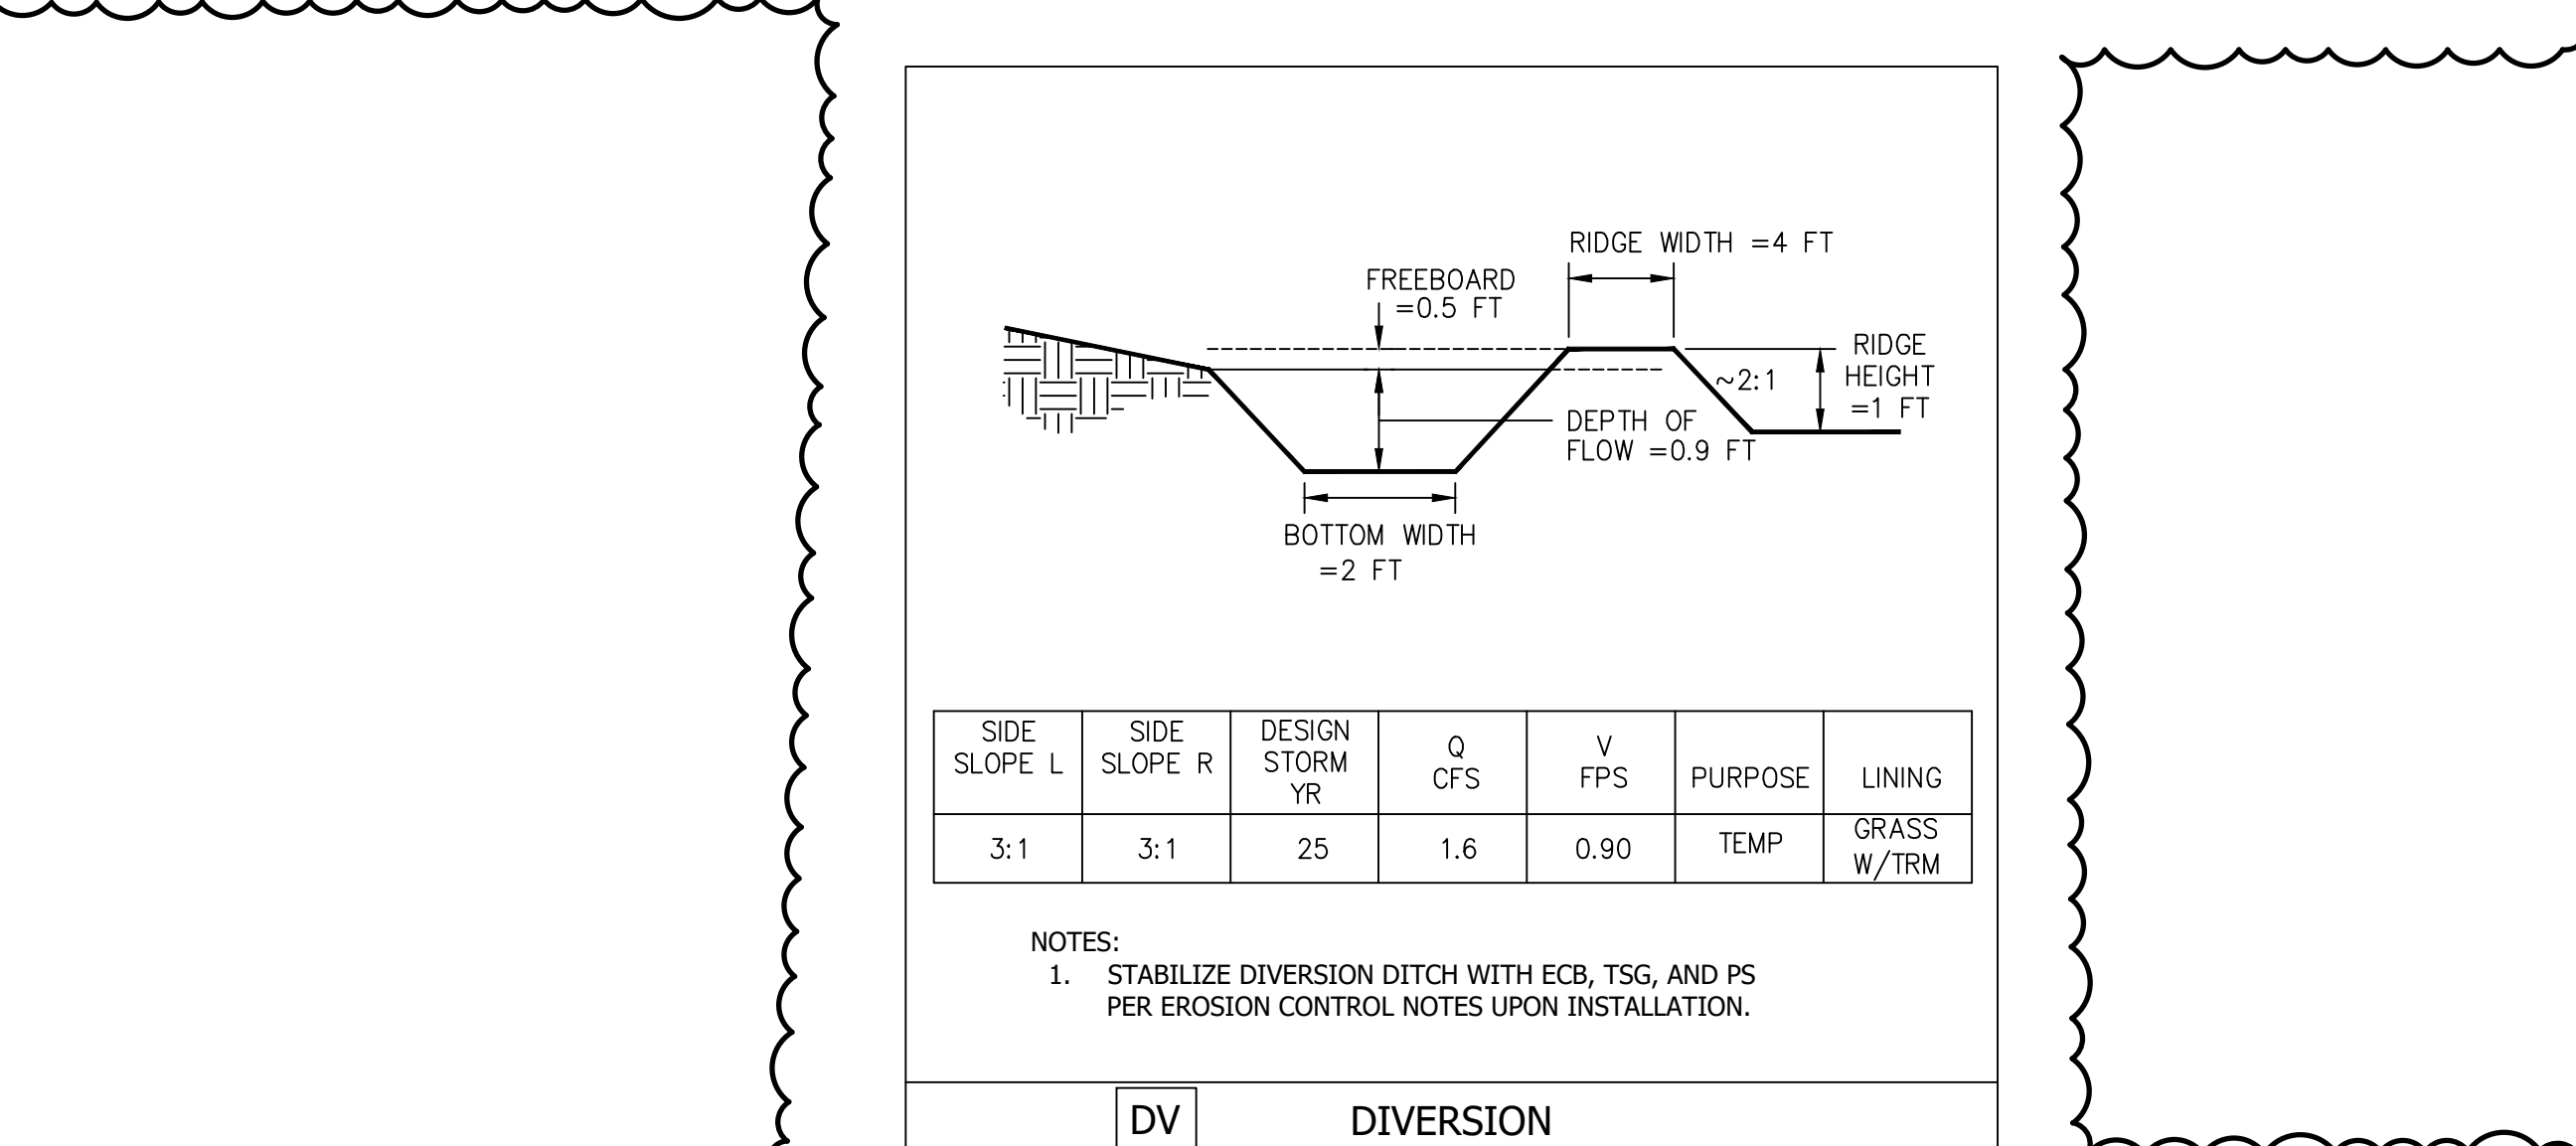



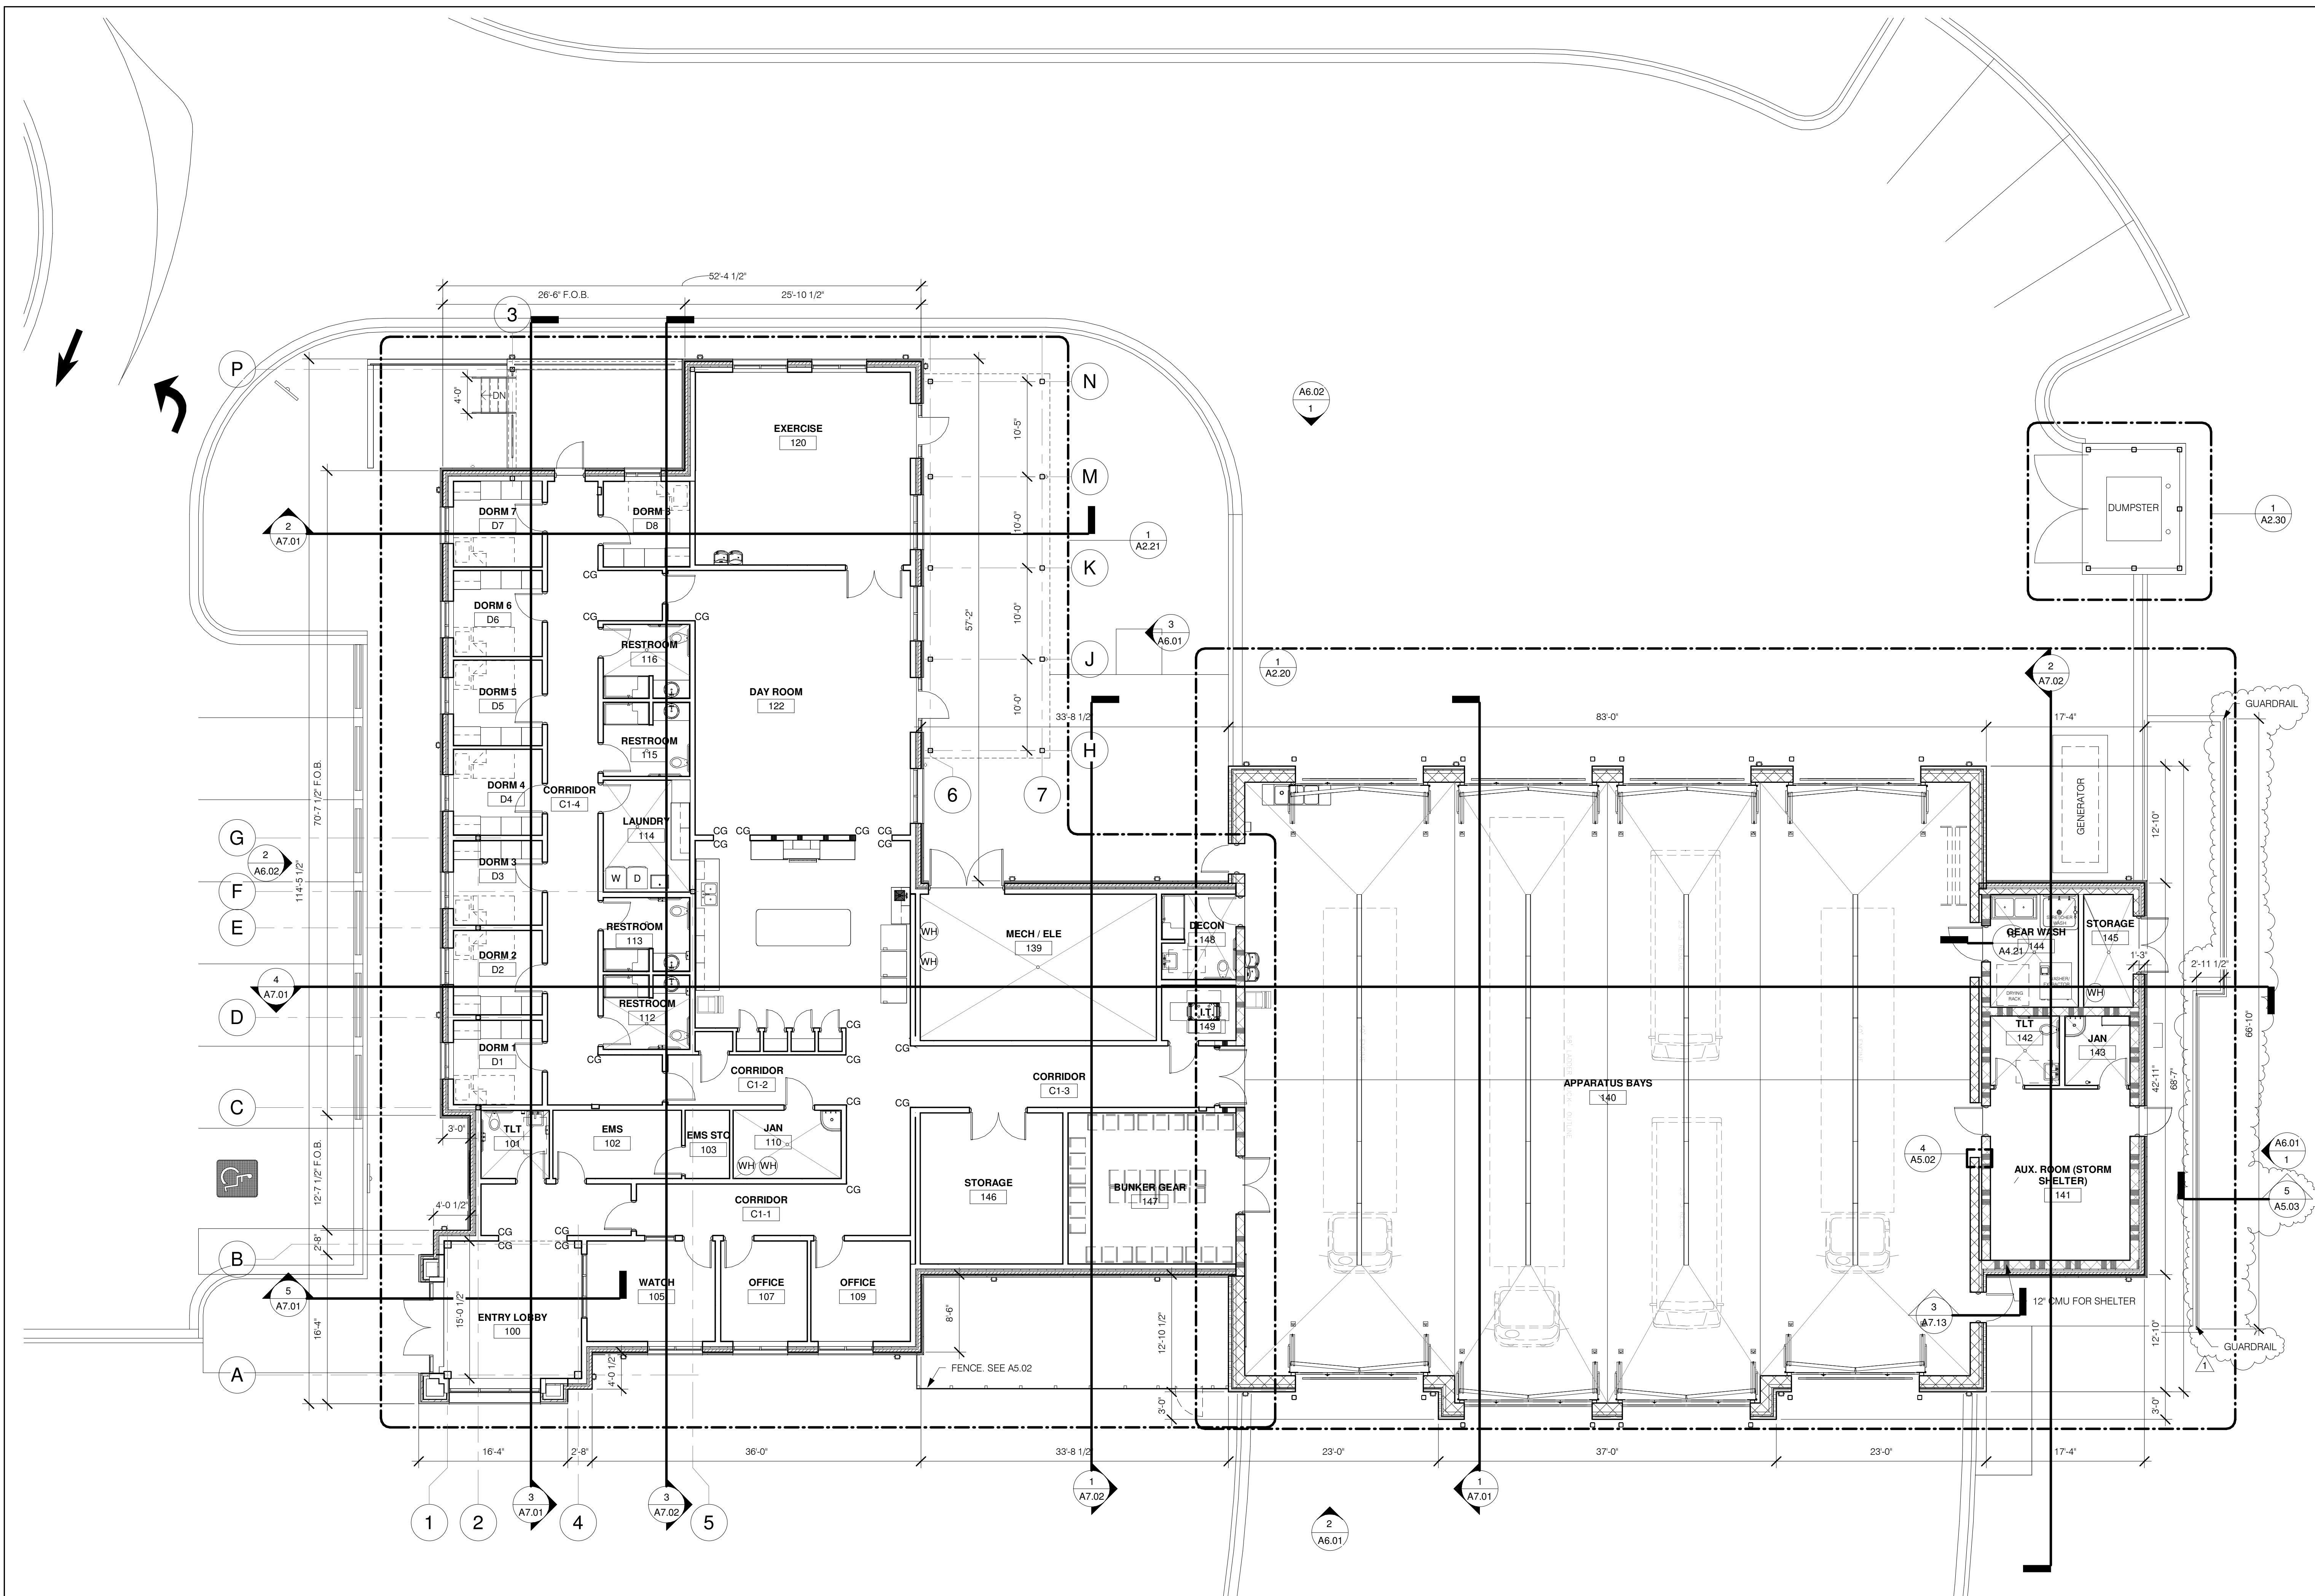

Revisions		
No.	Date	Description
1	2/18/25	ADDENDUM 3

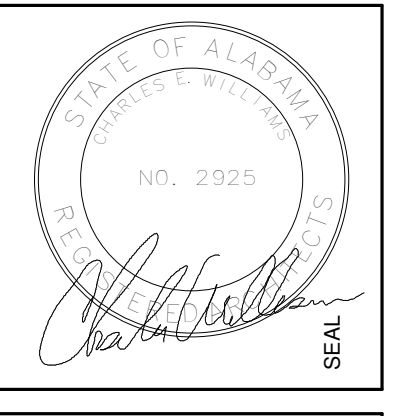

100% CDS

**IRONDALE FIRE STATION #3**  
 2920 ALTON RD  
 BIRMINGHAM, AL 35210  
 CITY OF IRONDALE

CHARLES WILLIAMS  
 & ASSOCIATES  
 ARCHITECTS  
**CWA**  
 3601 8TH AVE. SOUTH  
 BIRMINGHAM, ALABAMA 35222  
 PH: 205-250-0700  
 FAX: 205-250-0515

SHEET TITLE:  
**OVERALL FLOOR PLAN**

PROJECT NUMBER:  
**CWA No. 2023-01**


DATE:  
**08/30/24**

DRAWN BY: **CSV** CHECKED BY: **CW**

SHEET NUMBER  
**A2.01**

1 COMPOSITE FLOOR PLAN  
 1/8" = 1'-0"

Revisions		
No.	Date	Description
1	2/18/25	ADDENDUM 3

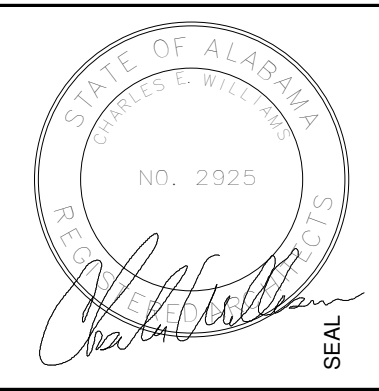


100% CDS

**IRONDALE FIRE STATION #3**  
 2920 ALTON RD  
 BIRMINGHAM, AL 35210  
 CITY OF IRONDALE


CHARLES WILLIAMS & ASSOCIATES ARCHITECTS  
 PH: 205-250-0700  
 BIRMINGHAM, ALABAMA 35222  
 FAX: 205-250-0515

SHEET TITLE:  
**DUMPSTER ENCLOSURE PLAN & DETAILS**  
 PROJECT NUMBER:  
**CWA No. 2023-01**  
 DATE:  
**08/30/24**  
 DRAWN BY:  
**CSV** CHECKED BY:  
**CW**


SHEET NUMBER  
**A2.30**

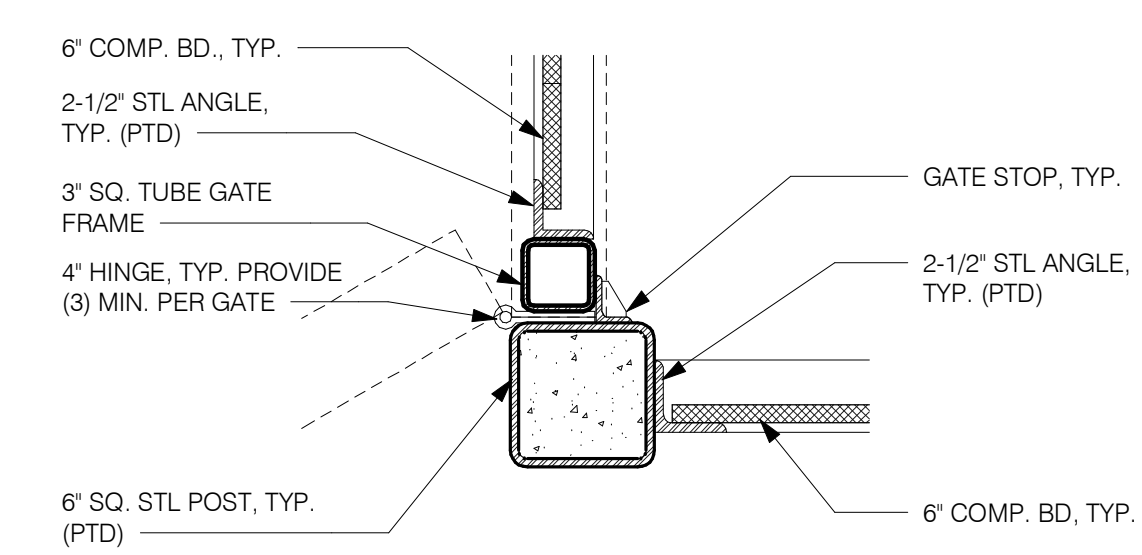


**6** GATE DETAIL @ POST  
 A2.30 1 1/2" = 1'-0"

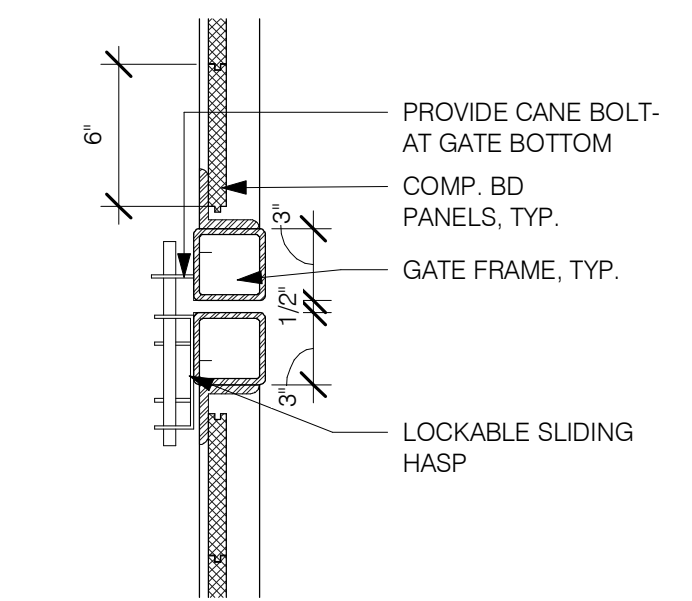


**5** GATE DETAIL - LATCH  
 A2.30 1 1/2" = 1'-0"

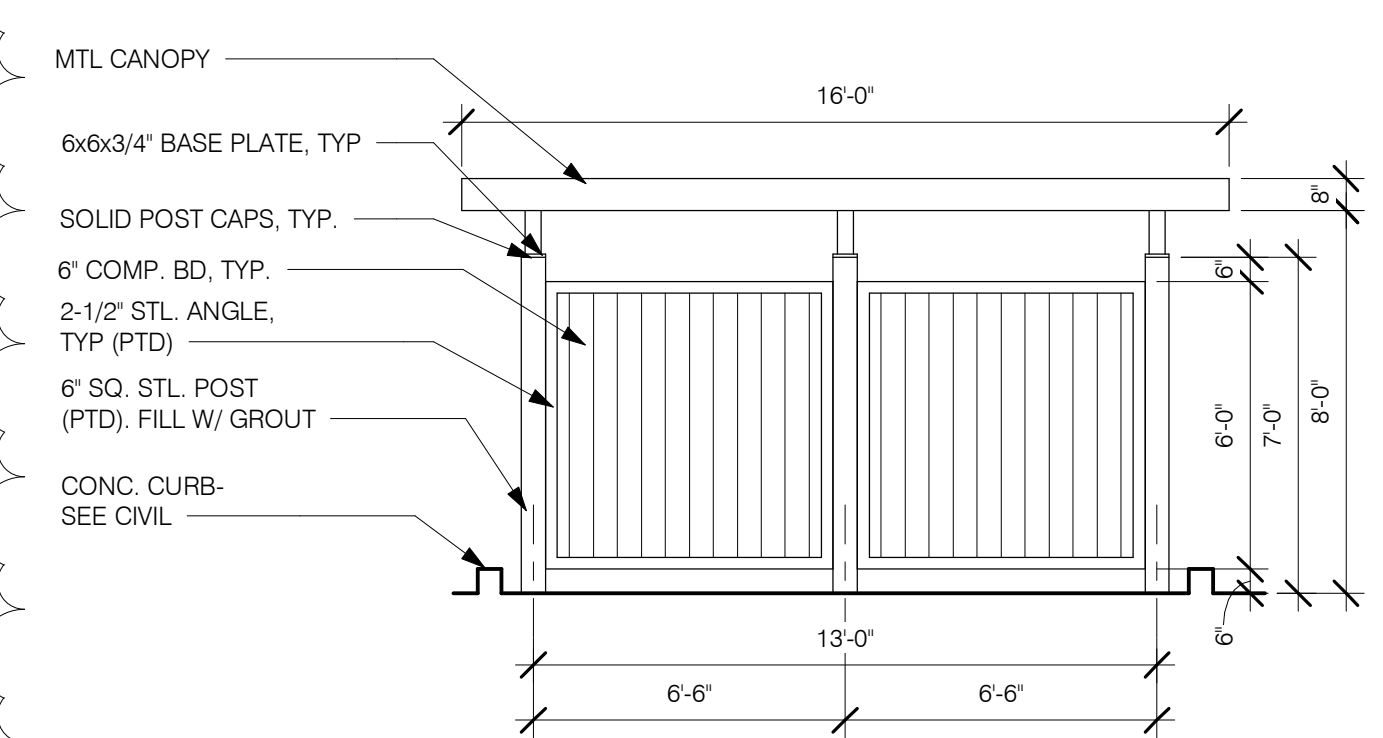


**4** DUMPSTER ELEV.- REAR  
 A2.30 1/4" = 1'-0"

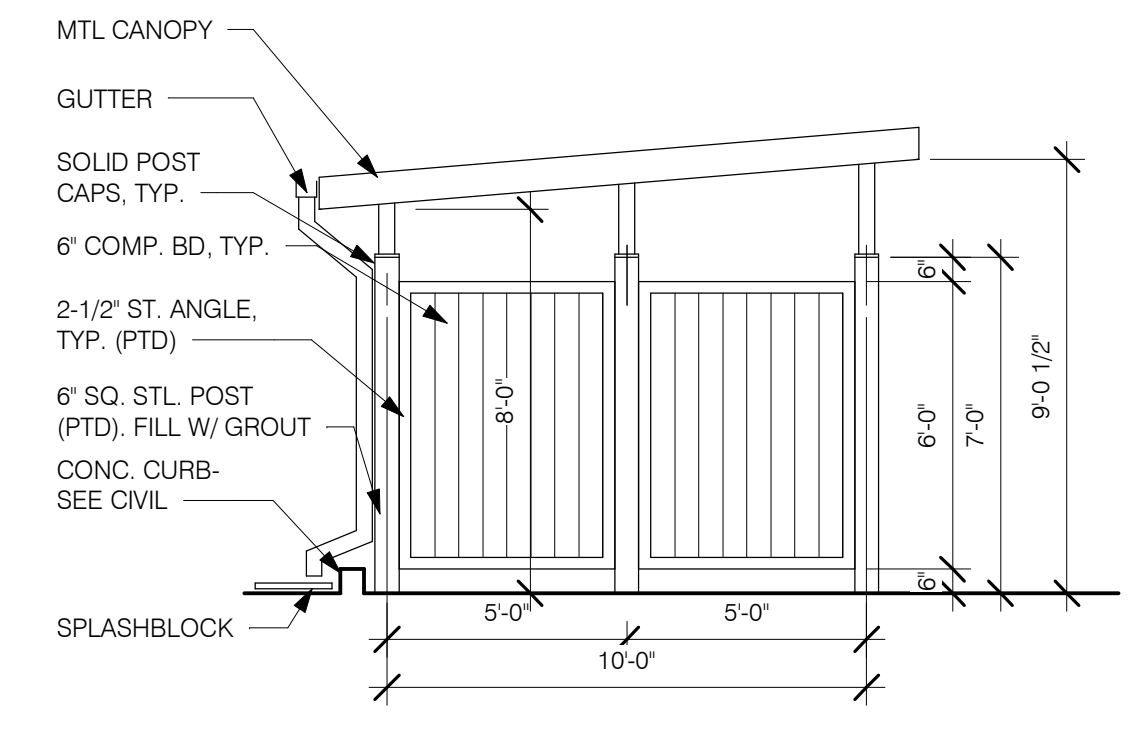

**3** DUMPSTER ELEV.- SIDE  
 A2.30 1/4" = 1'-0"

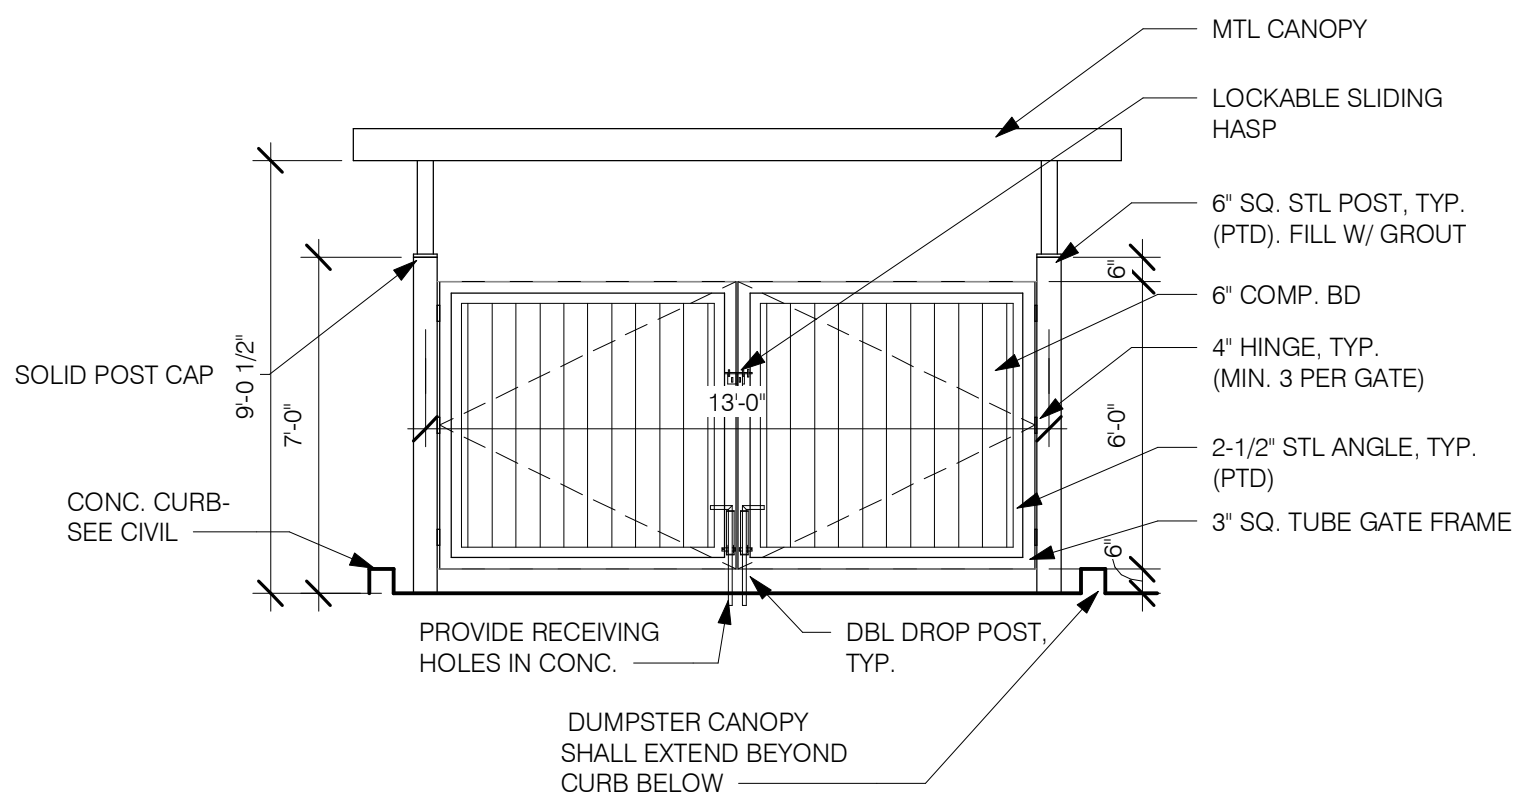

**2** DUMPSTER ELEV.- GATE  
 A2.30 1/4" = 1'-0"

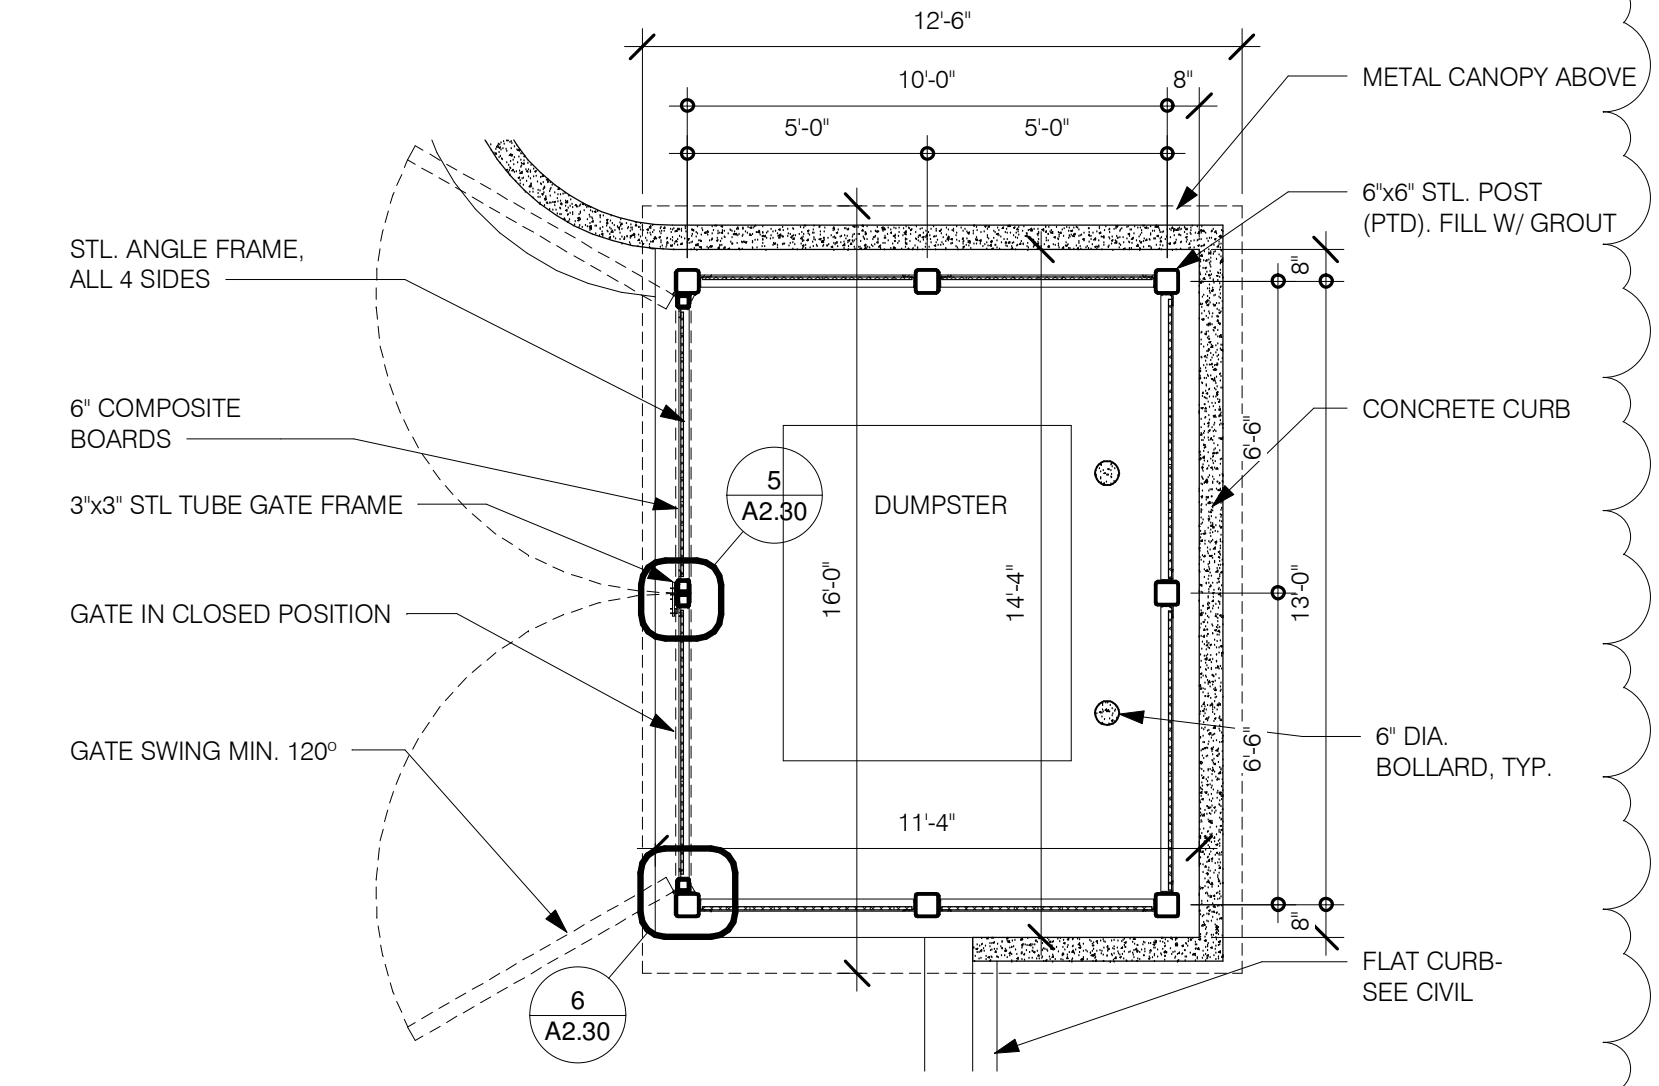

**1** DUMPSTER FENCE PLAN  
 A2.30 1/4" = 1'-0"

Revisions		
No.	Date	Description
1	2/18/25	ADDENDUM 3




100% CDS

**IRONDALE FIRE STATION #3**  
 2920 ALTON RD  
 BIRMINGHAM, AL 35210  
 CITY OF IRONDALE


CHARLES WILLIAMS & ASSOCIATES ARCHITECTS  
**CWA**  
 3601 8TH AVE. SOUTH BIRMINGHAM, ALABAMA 35222  
 PH: 205-250-0700 FAX: 205-250-0515

SHEET TITLE:  
**STAIR DETAILS**  
 PROJECT NUMBER:  
**CWA No. 2023-01**  
 DATE:  
**08/30/24**  
 DRAWN BY: **RM** CHECKED BY: **CSV**


SHEET NUMBER  
**A5.03**

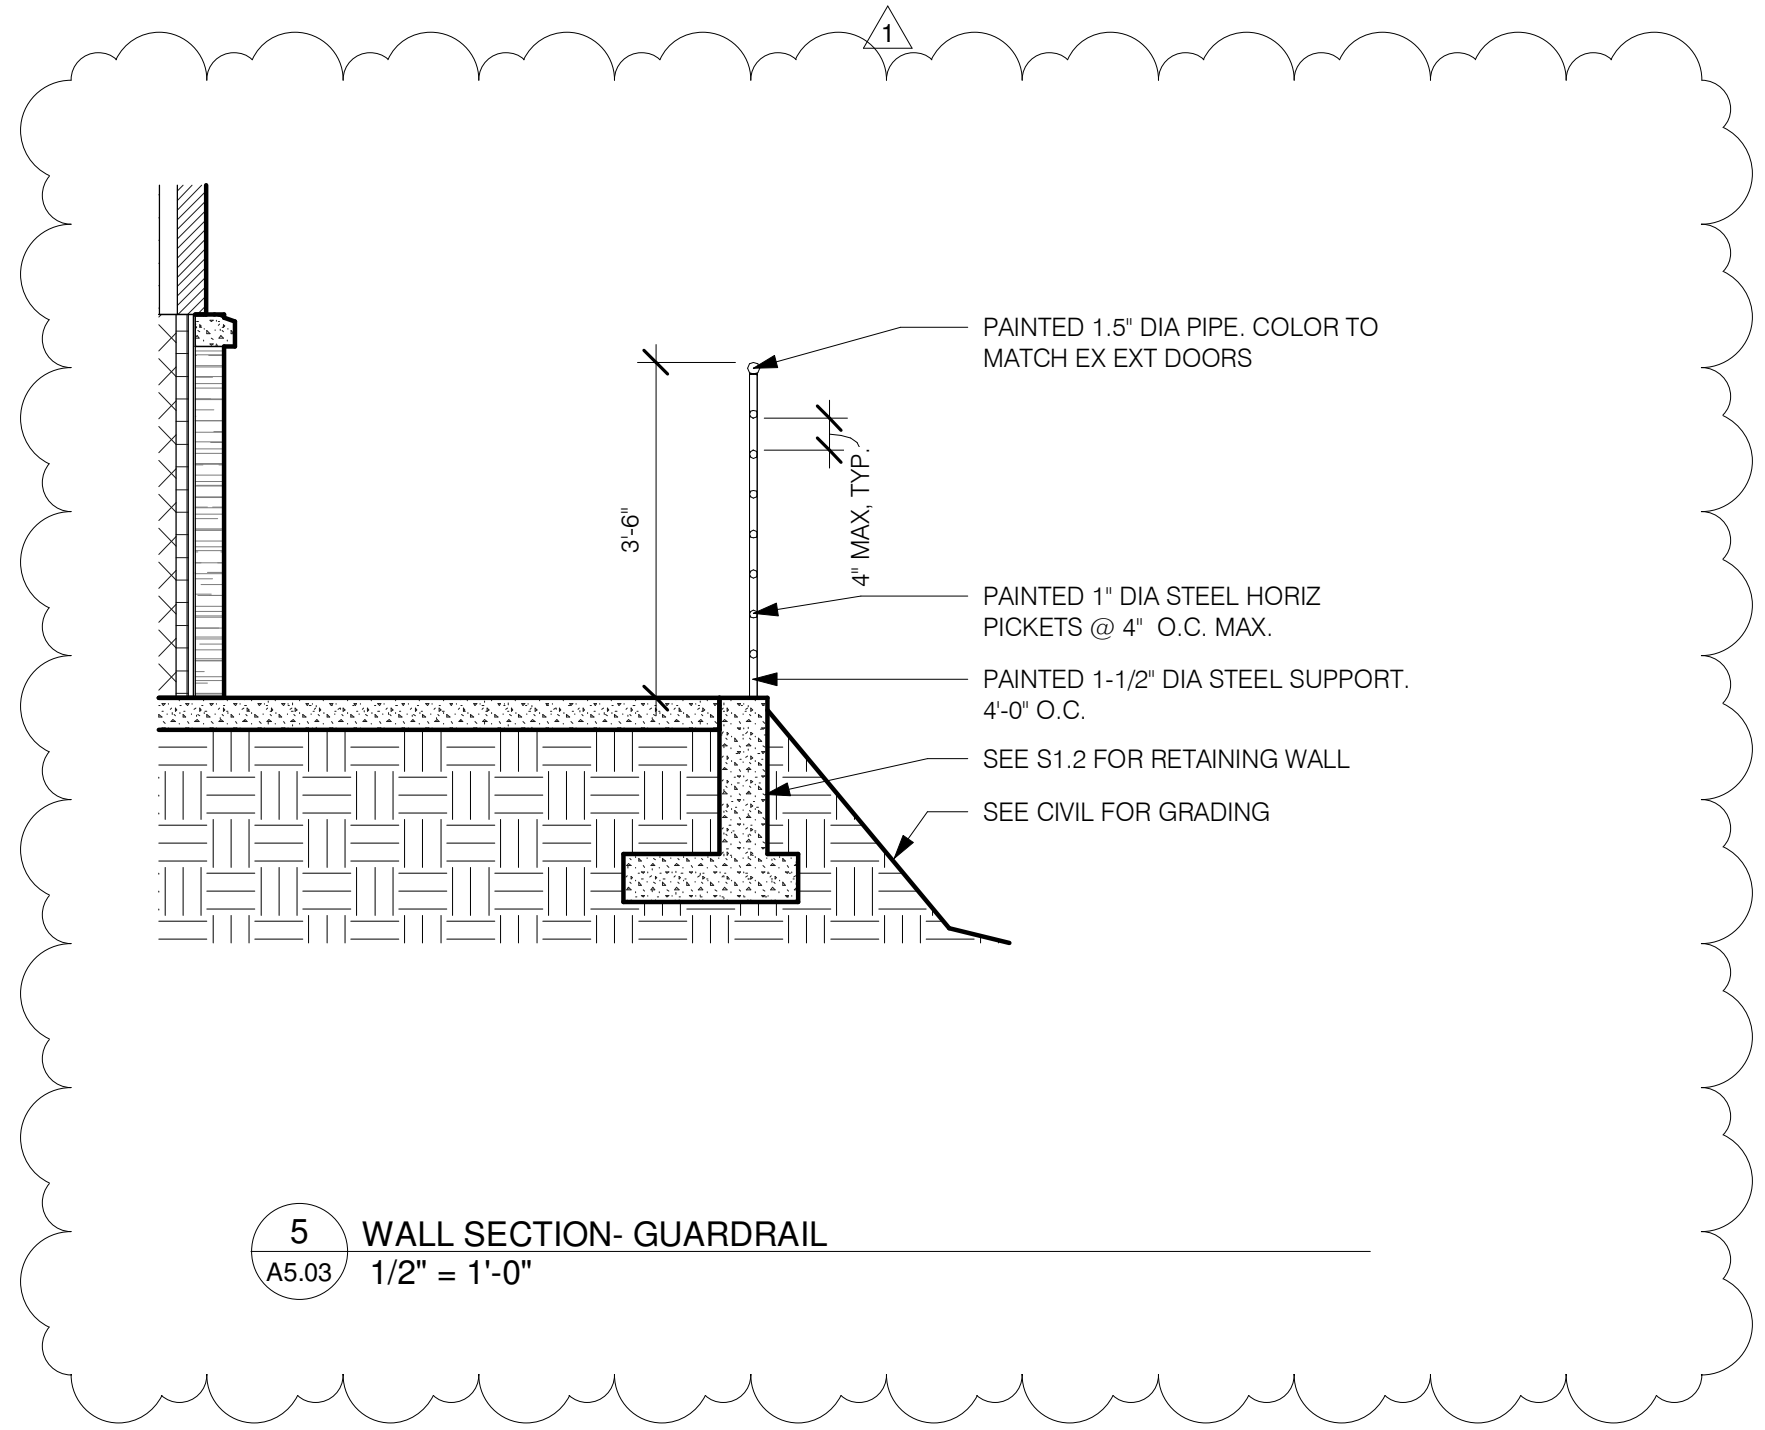


**5** WALL SECTION- GUARDRAIL  
 A5.03 1/2" = 1'-0"

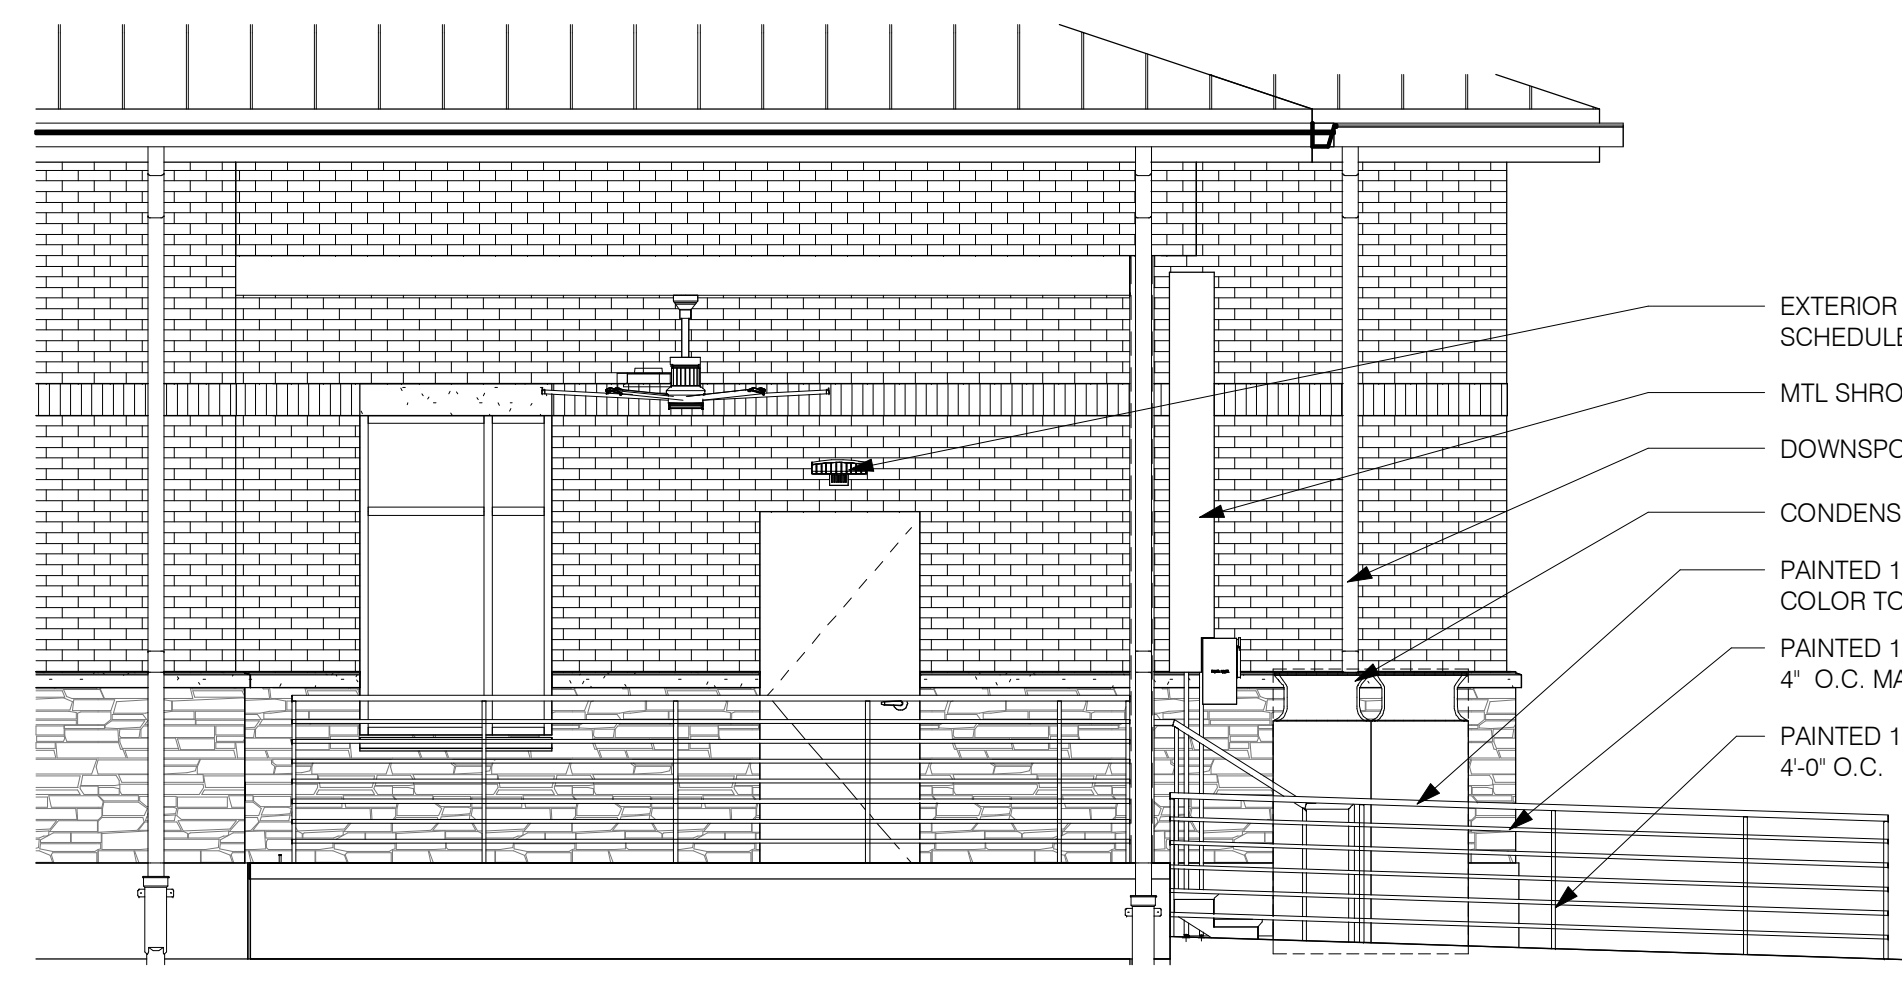


**4** PORCH WEST  
 A5.03 1/4" = 1'-0"

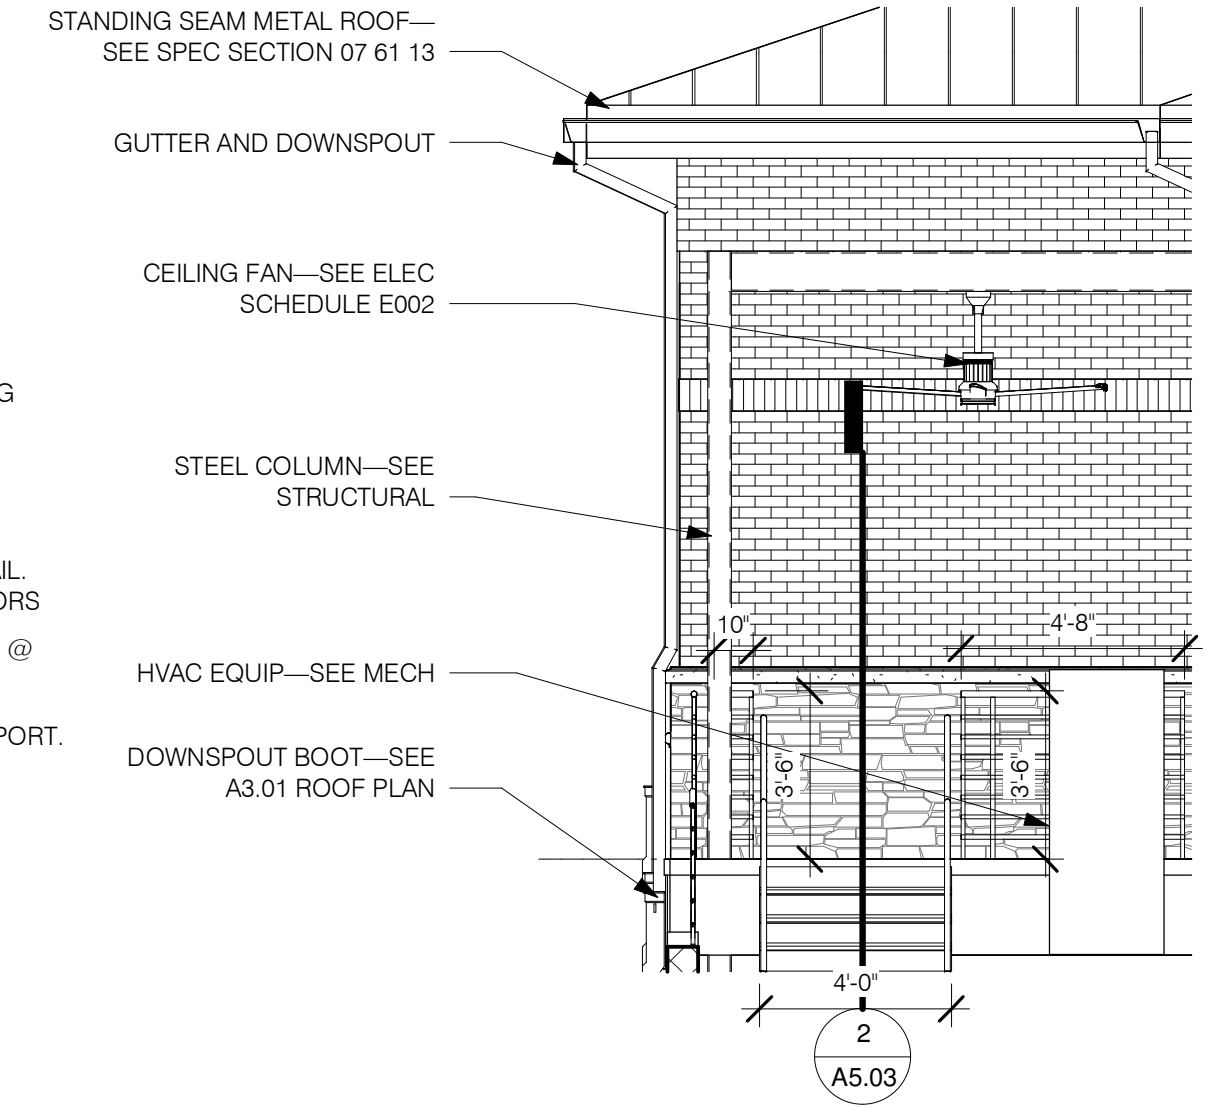


**3** PORCH NORTH  
 A5.03 1/4" = 1'-0"

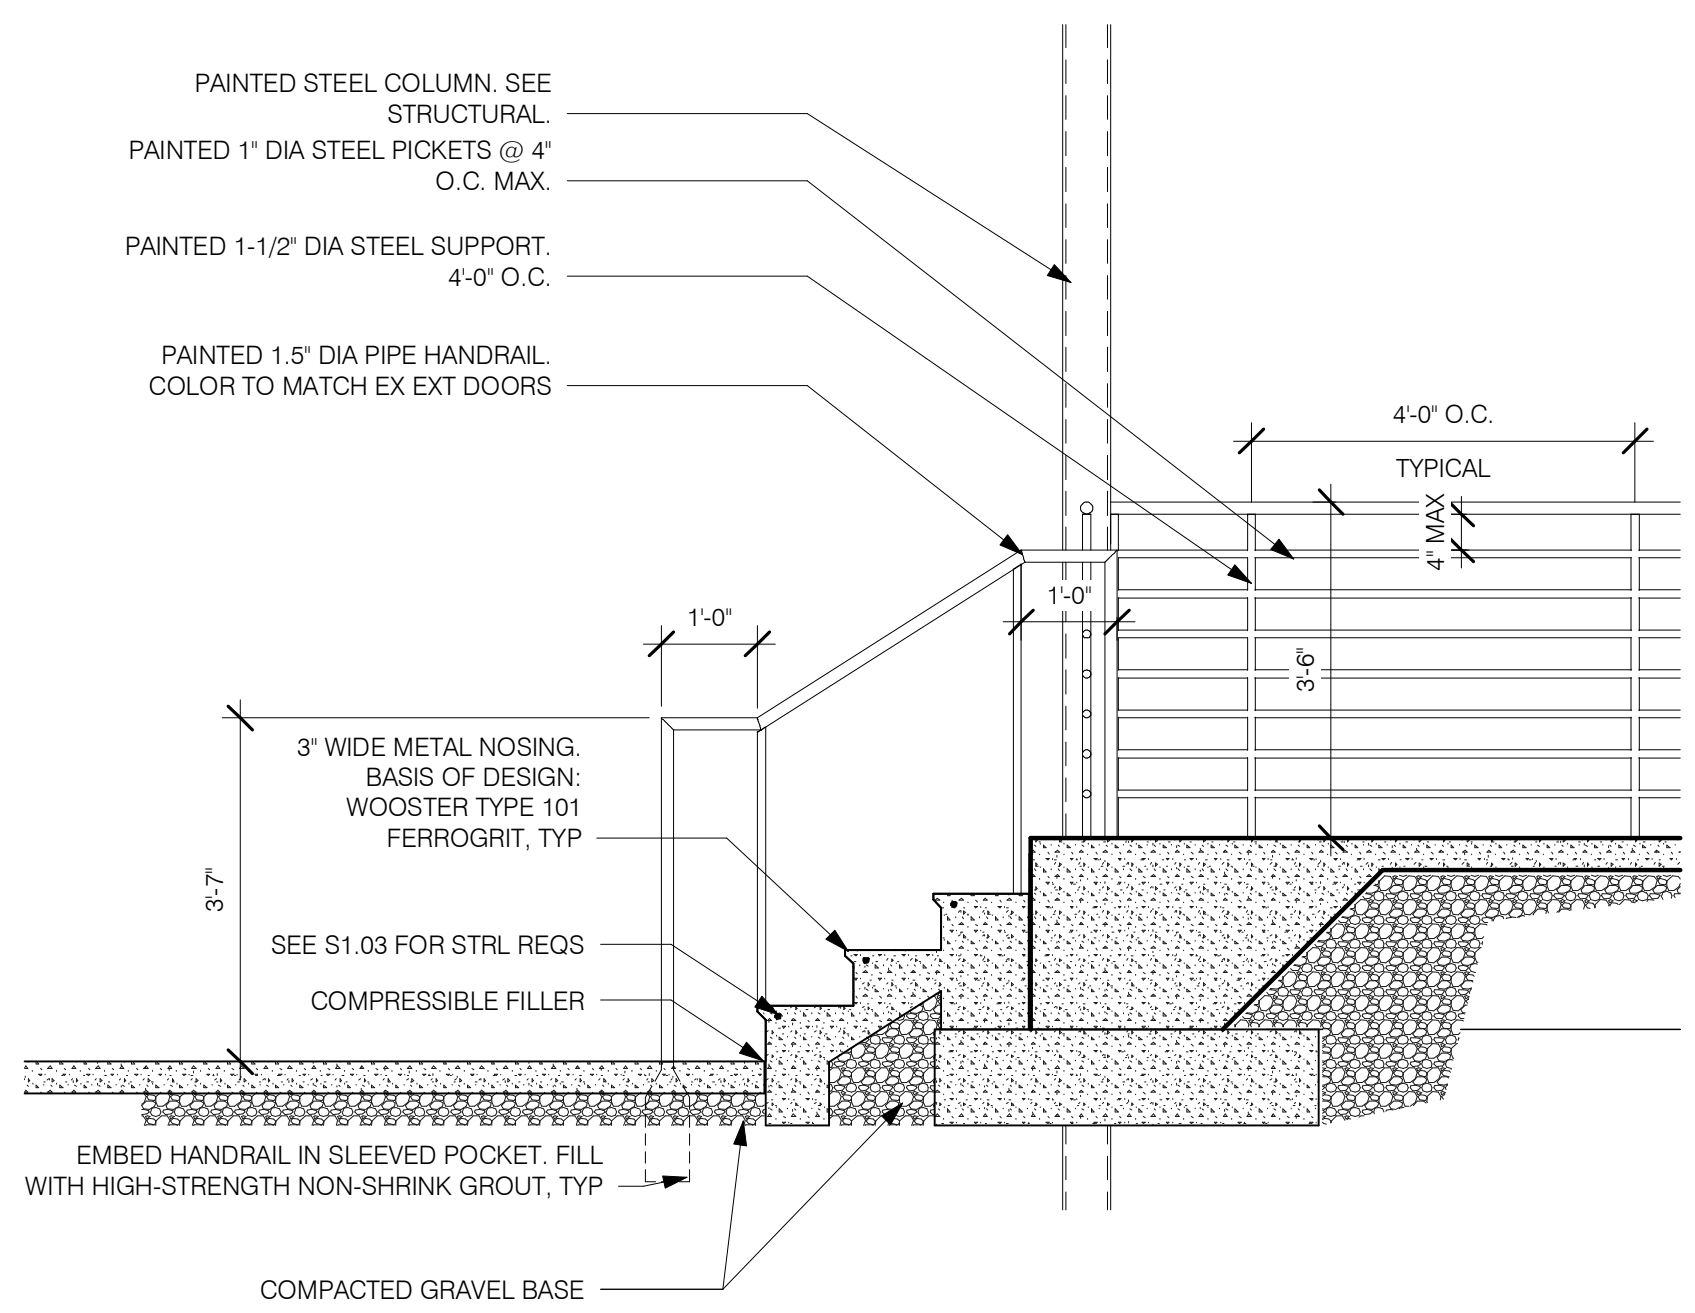


**2** STAIR SECTION  
 A5.03 1/2" = 1'-0"

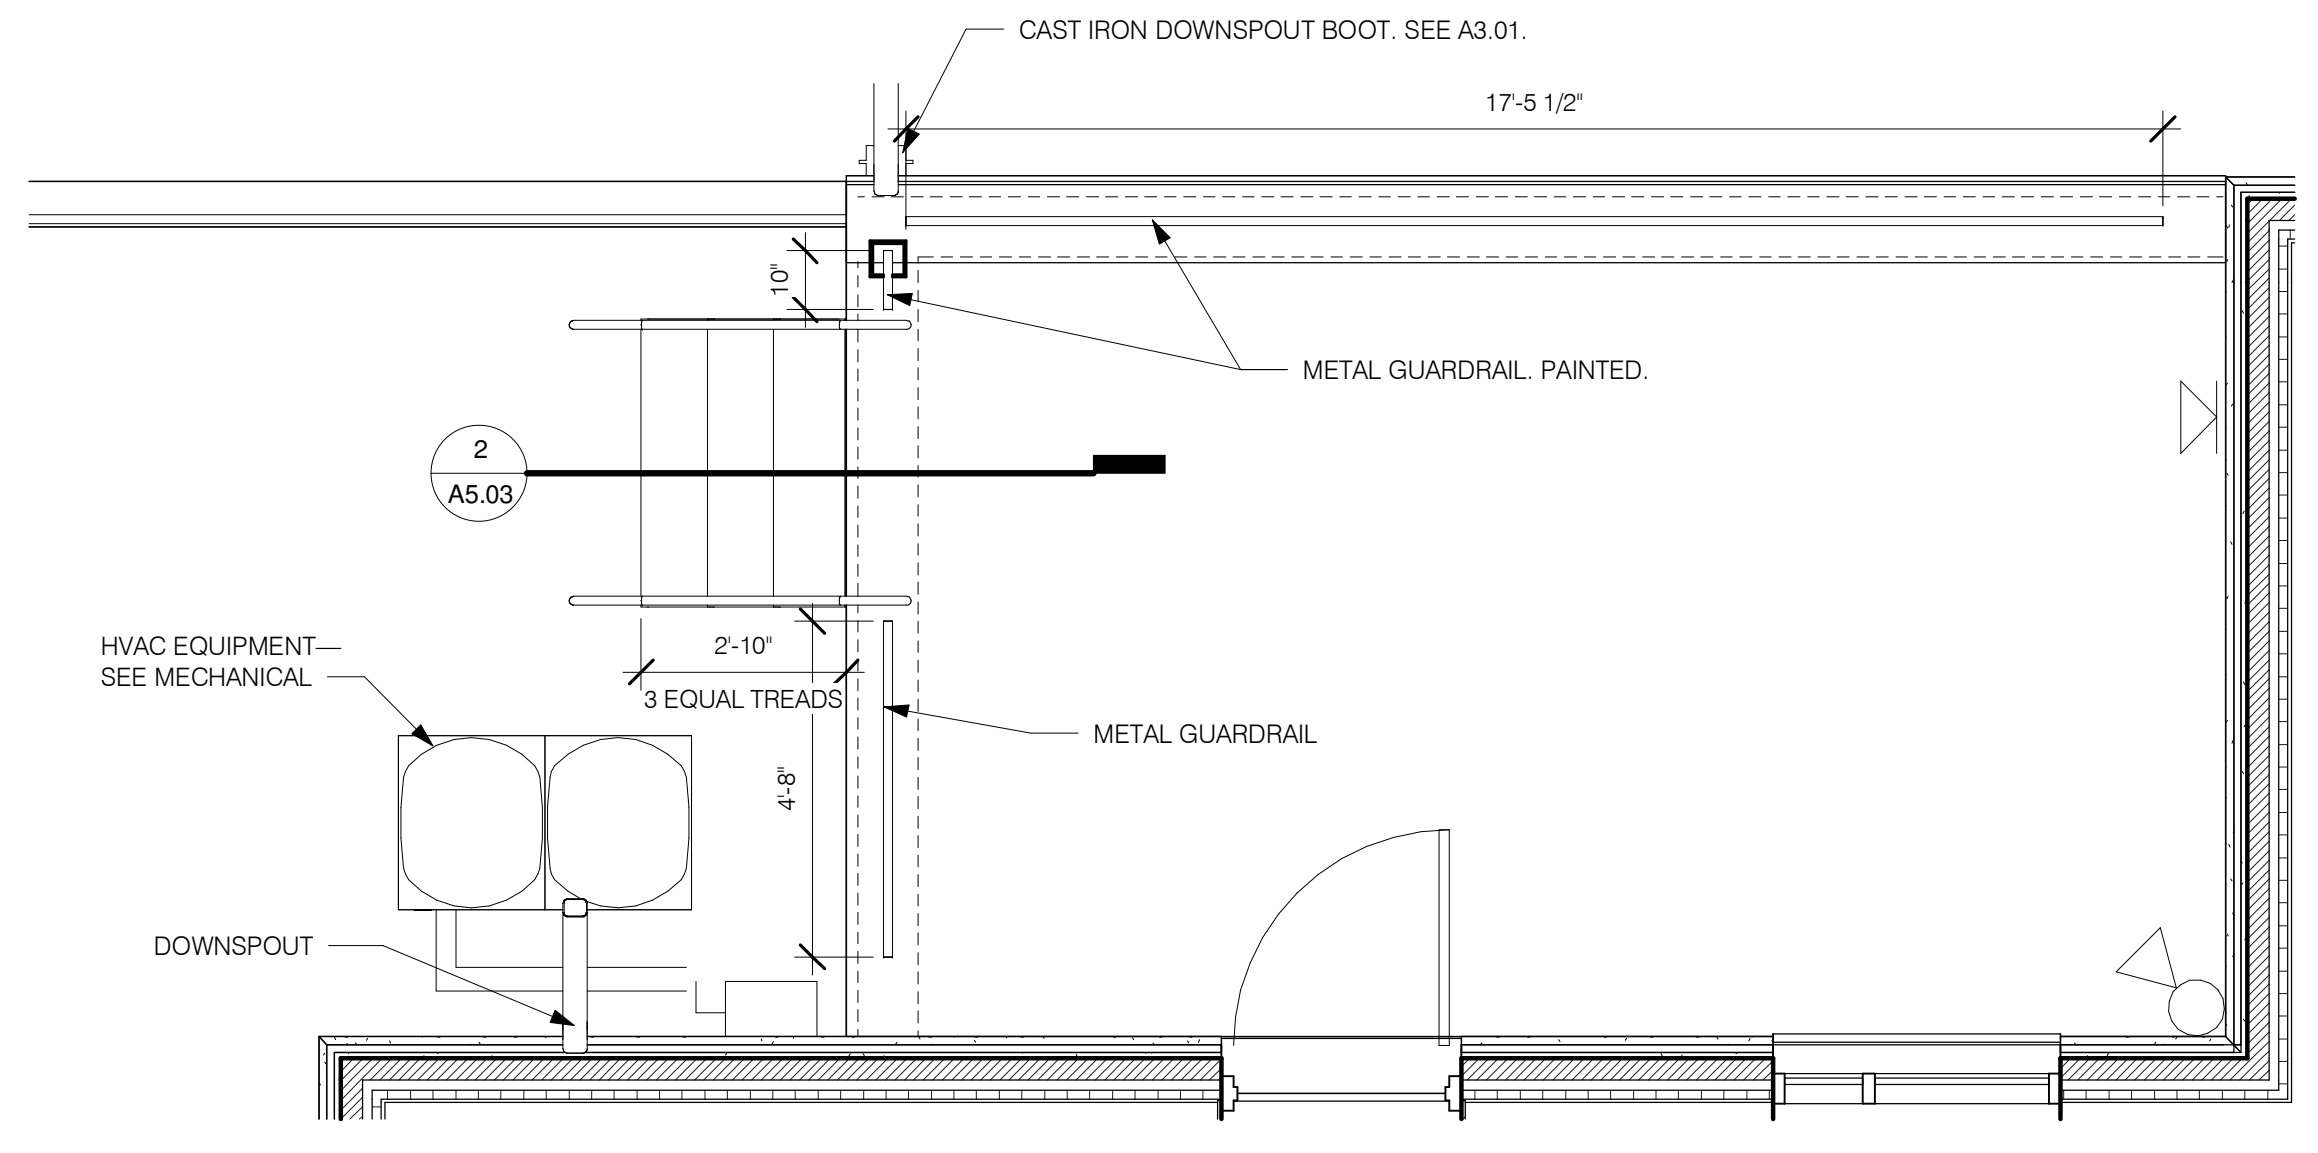


**1** STAIR DETAILS  
 A5.03 3/8" = 1'-0"

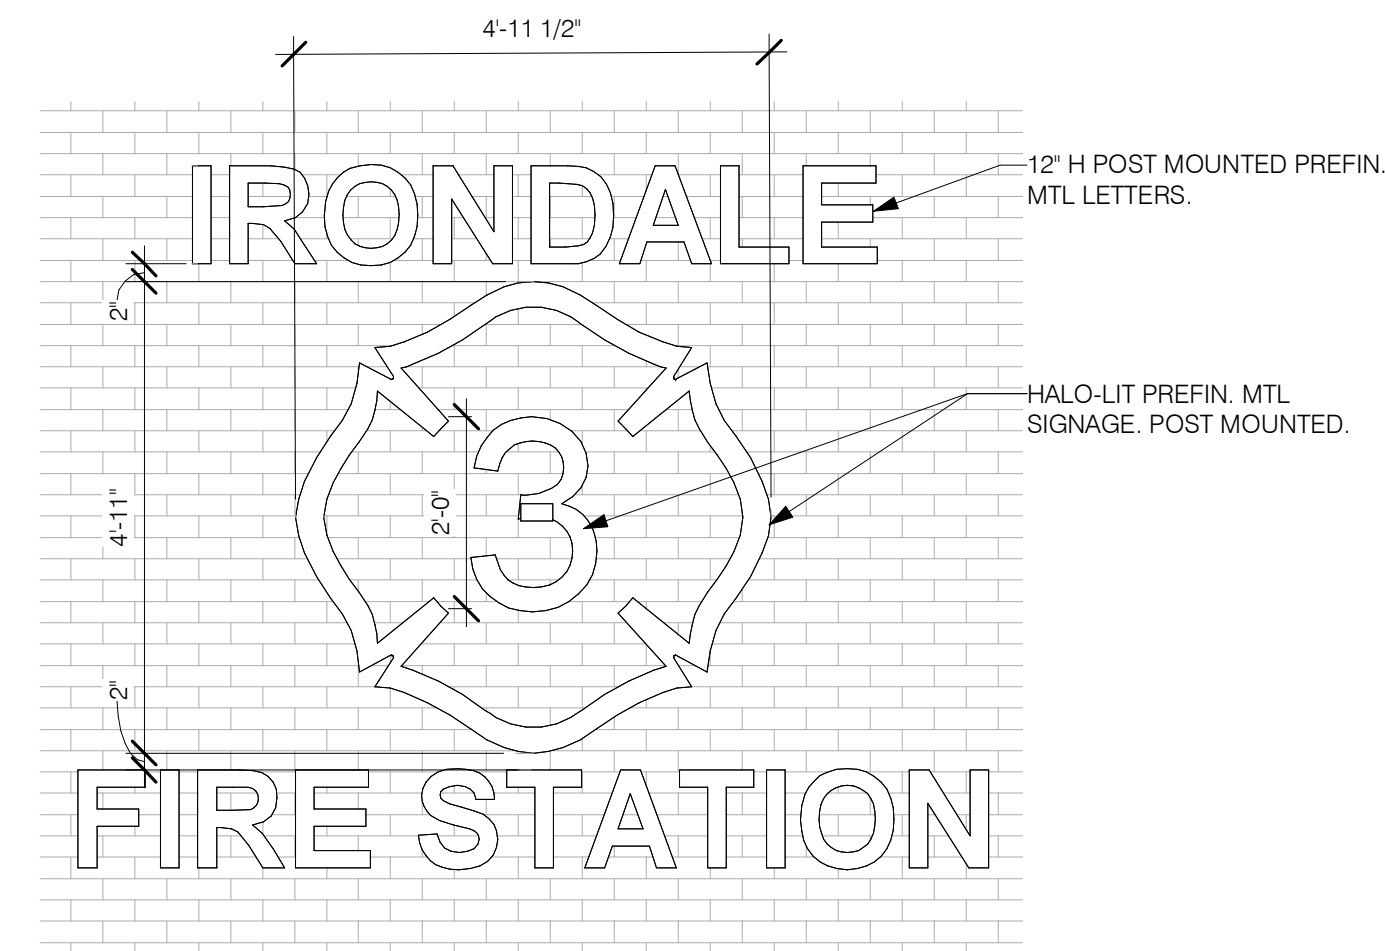


4 EXT. SIGNAGE DETAIL  
A6.01 1/2" = 1'-0"

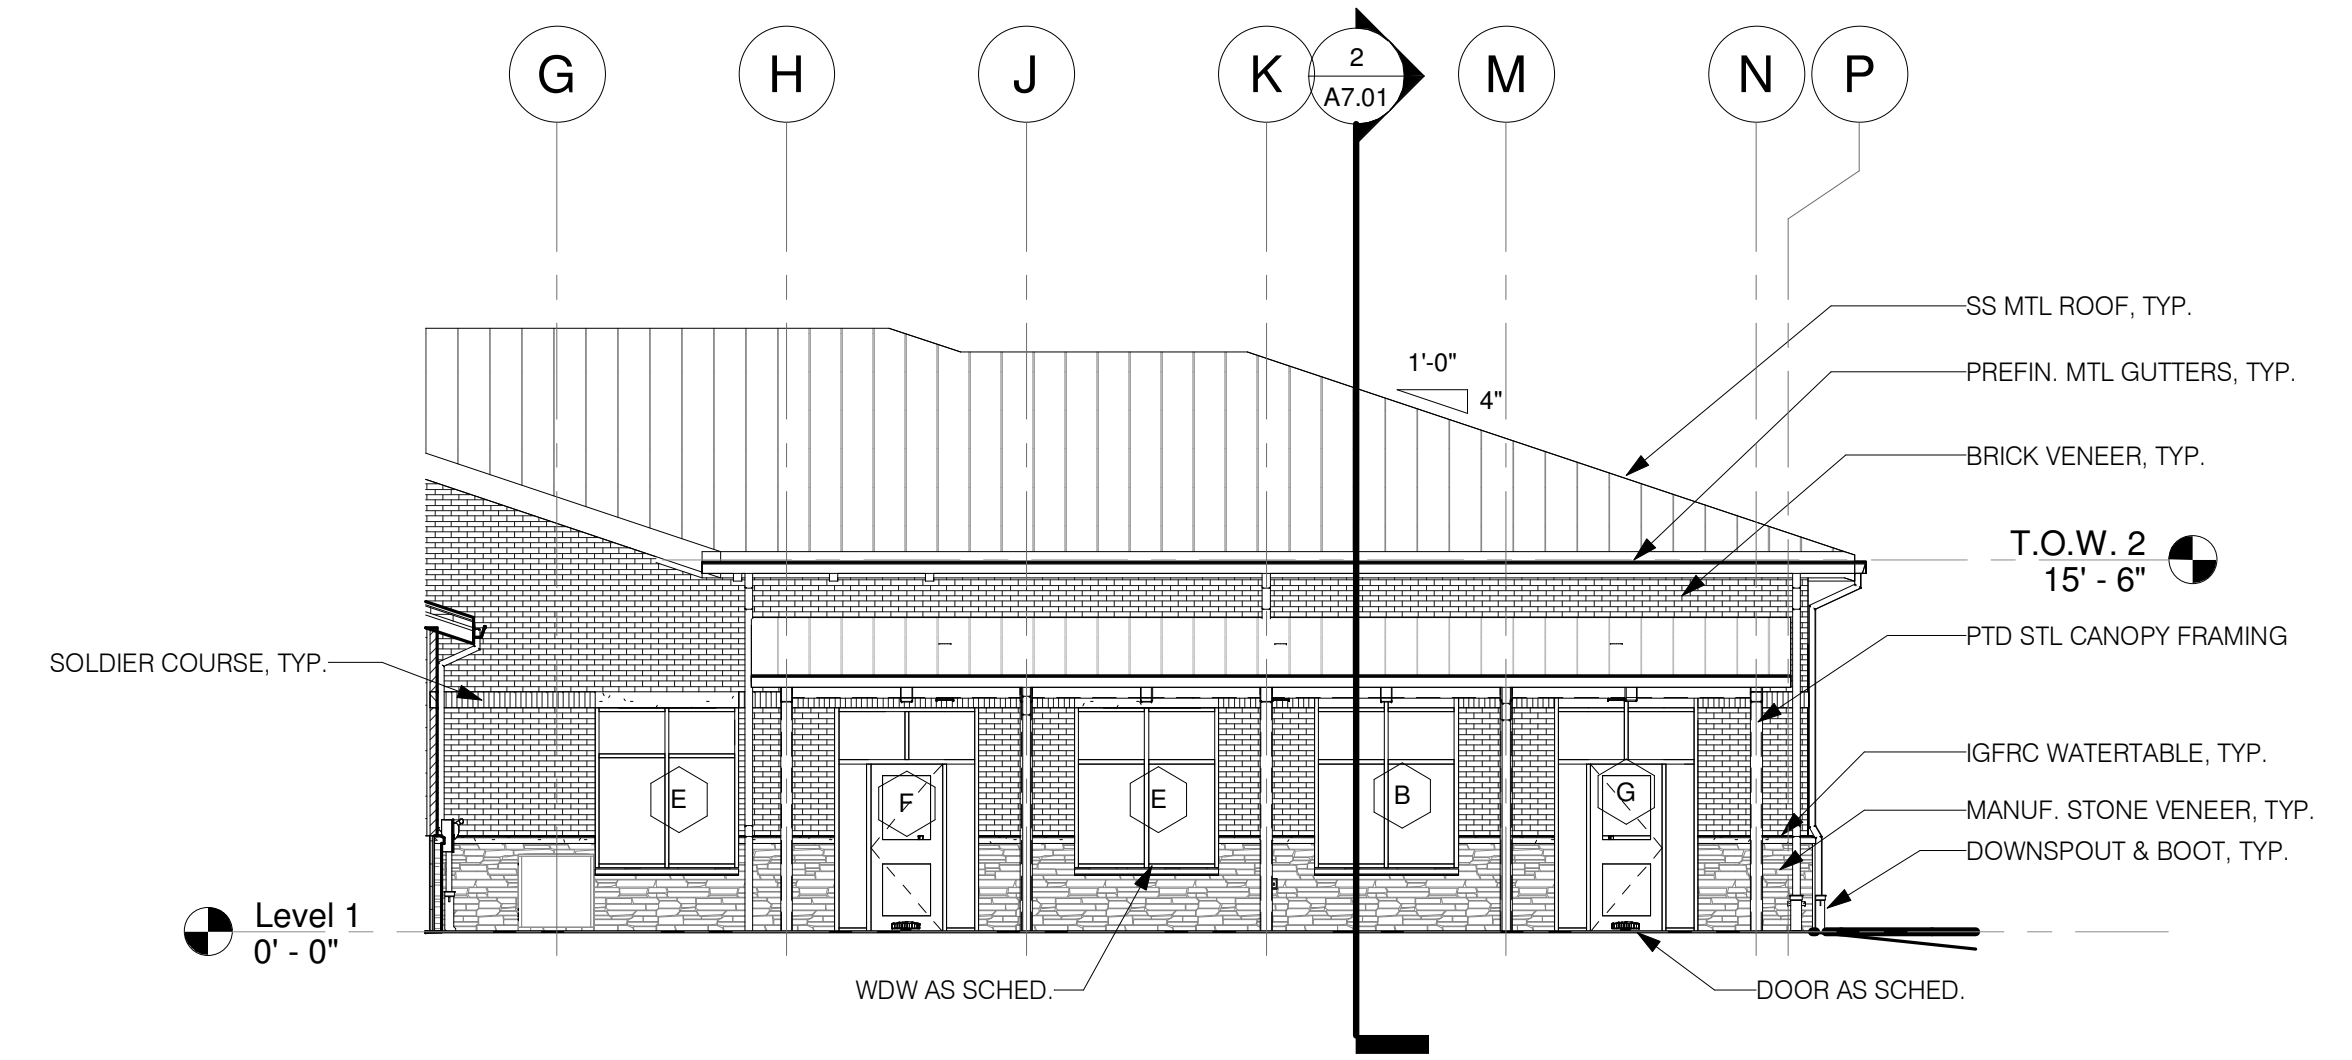

3 EAST ELEVATION (PARTIAL)  
A6.01 1/8" = 1'-0"

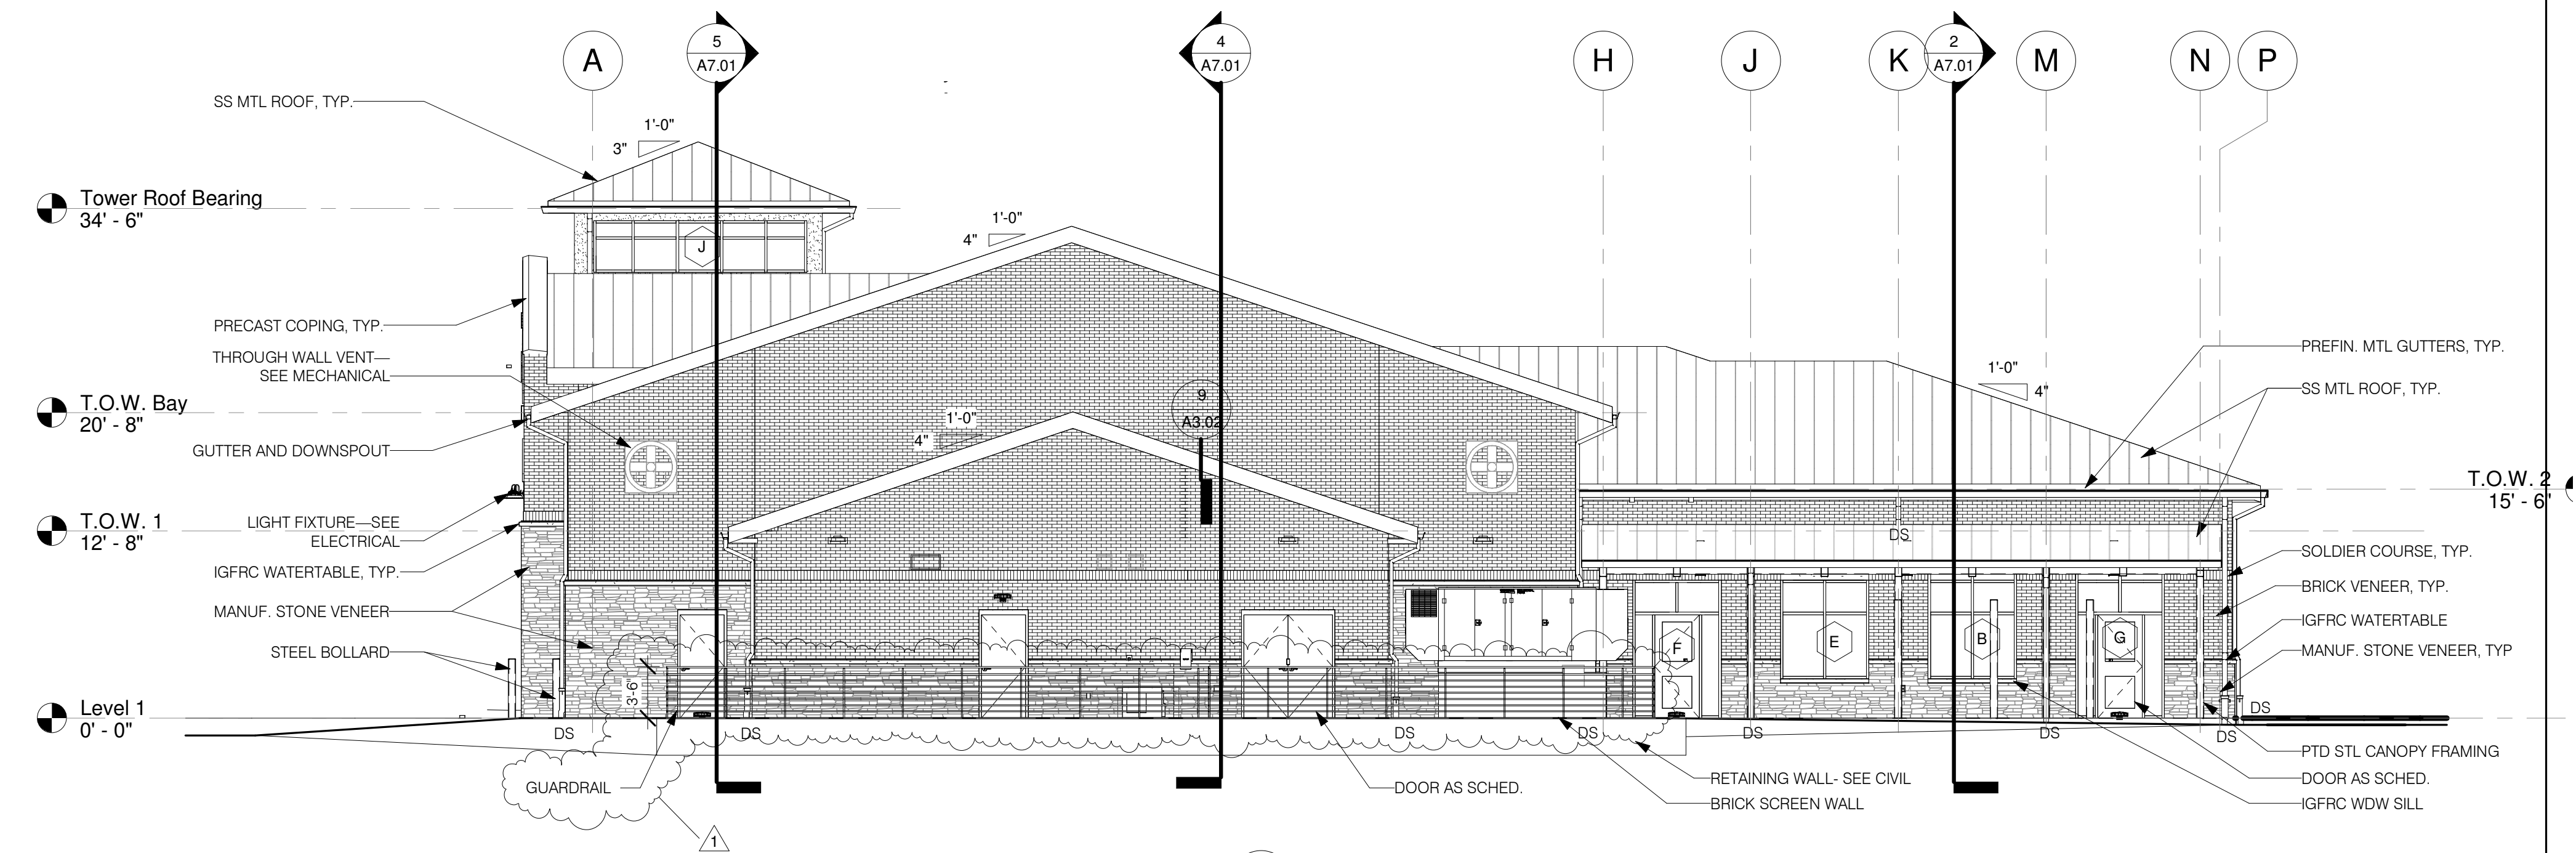


1 EAST ELEVATION  
A6.01 1/8" = 1'-0"

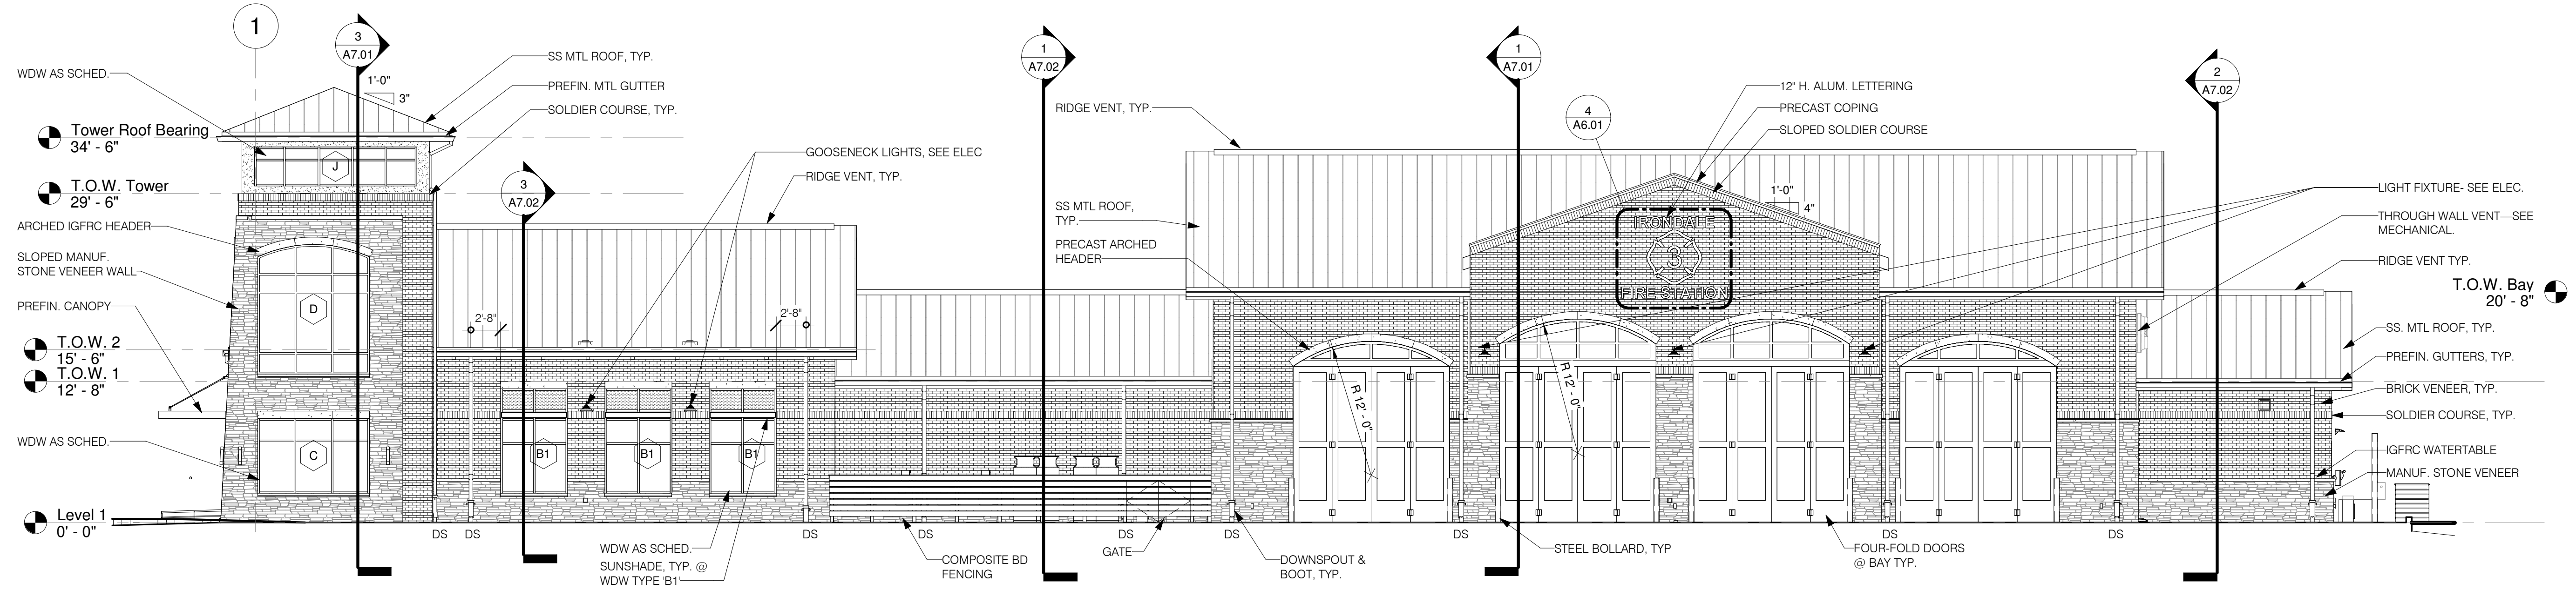

2 NORTH ELEVATION  
A6.01 1/8" = 1'-0"

Revisions		
No.	Date	Description
1	2/18/25	ADDENDUM 3

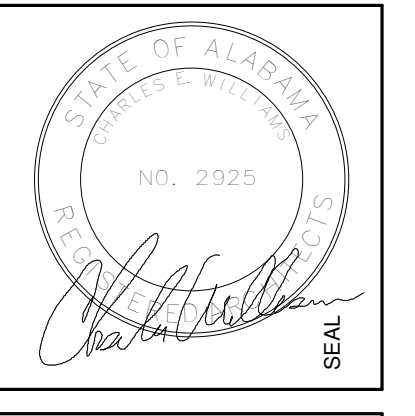

100% CDS


**IRONDALE FIRE STATION #3**  
2920 ALTON RD  
BIRMINGHAM, AL 35210  
CITY OF IRONDALE

CHARLES WILLIAMS & ASSOCIATES ARCHITECTS  
PH: 205-250-0700  
3601 8TH AVE. SOUTH BIRMINGHAM, ALABAMA 35222  
FAX: 205-250-0515

SHEET TITLE: EXTERIOR ELEVATIONS	
PROJECT NUMBER: CWA No. 2023-01	
DATE: 08/30/24	
DRAWN BY: CSV	CHECKED BY: CW

SHEET NUMBER  
**A6.01**



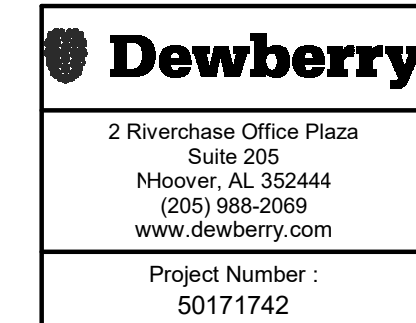

Revisions		
No.	Date	Description
2	2/21/2025	ADDENDUM 3

MARK	SUPPLY FAN			EXHAUST FAN			SUMMER			WINTER			ELECTRICAL			ELECTRIC HEAT		DX COOLING COIL				BASIS OF DESIGN					
	*CFM	W.G. E.S.P.	HP	*CFM	W.G. E.S.P.	HP	OUTSIDE AIR		EXHAUST ENTERING (DB/WB)	OUTSIDE AIR		EXHAUST ENTERING (DB/WB)	V	PH	Hz	** MCA	** MOCP	INPUT (KW)	STAGES	LAT (DB/WB)	TOTAL (MBH)	SENSIBLE (MBH)	NOM. TONS	WEIGHT (LBS)	ACCESSORIES	MANUFACTURER	MODEL
	EAT (DB/WB)	LAT (DB/WB)	EAT (DB/WB)	LAT (DB/WB)	EAT (DB/WB)	LAT (DB/WB)	V	PH	Hz	** MCA	** MOCP	INPUT (KW)	STAGES	LAT (DB/WB)	TOTAL (MBH)	SENSIBLE (MBH)	NOM. TONS	WEIGHT (LBS)	ACCESSORIES	MANUFACTURER	MODEL						
ERU-1	1450 / 2120	1.2"	3	1320 / 1360	1.2"	1.5	95.0°F / 78.0°F	84.4°F / 70.6°F	75.0°F / 62.5°F	17.0°F / 15.0°F	43.3°F / 39.6°F	70.0°F / 58.0°F	208	3	60	27 / 94.3	40 / 100	26	SCR	53.8°F / 53.0°F	112.3	74.2	10	2510	1,2,3,4,5,6,7,8,9	TRANE	CSAA006

### INDOOR HEAT PUMP UNIT - VARIABLE REFRIGERANT SCHEDULE

**AIR HANDLER UNIT TYPE:**  
1. 4-WAY CEILING CASSETTE.  
2. INDOOR, WALL MOUNTED.  
3. CONCEALED ABOVE CEILING.

**ACCESSORIES:**  
1. 3-POLE DISCONNECT SWITCH.  
2. HARD WIRED UNIT CONTROLLER.  
3. FULL PORT BALL VALVES & SCHRADER VALVES WITH FLARED CONNECTIONS.  
4. WASHABLE AIR FILTER (PROVIDE (1) EXTRA FILTER PER AC UNIT).  
5. INTEGRAL CONDENSATE LIFT MECHANISM.  
6. HARD WIRED UNIT CONTROLLER.  
7. CONDENSATE PUMP (120/1/60) - 1 GPH @ 33 FT. HD.

**NOTES:**  
1. AIRFLOW RATED AT HIGH FAN SPEED.  
2. COOLING CAPACITY RATED AT 95°F.  
3. HEATING CAPACITY RATED AT 17°F.  
4. ALL REFRIGERANT PIPING JOINTS TO BE BRAZED AND LEAK TESTED.  
5. SIZE AND ROUTING OF REFRIGERANT PIPING PER MANUFACTURER'S RECOMMENDATIONS.

MARK	TYPE	AIRFLOW (CFM)	E.S.P. (IN.-W.G.)	NOMINAL TONNAGE	CONNECTED TO: OUTDOOR UNIT	COOLING CAPACITY			DX HEATING CAPACITY		DIMENSIONS	ELECTRICAL					ACCESSORIES	BASIS OF DESIGN
						TOTAL (MBH)	SENSIBLE (MBH)	EAT (DB°F/WB°F)	TOTAL (MBH)	EAT (DB°F)		V	PH	Hz	MCA (A)	MOCP (A)		
IHP-1-1	2	315	0.6	0.5	OHP-1	7.5	6.2	75.0/62.5	9.0	70	23 x 23 x 9	208 V	1	60	0.28 A	15 A	1,2,3,4,5,6	TRANE
IHP-1-2	2	315	0.6	0.5	OHP-1	7.5	6.2	75.0/62.5	9.0	70	23 x 23 x 9	208 V	1	60	0.28 A	15 A	1,2,3,4,5,6	TRANE
IHP-1-3	2	315	0.6	0.5	OHP-1	7.5	6.2	75.0/62.5	9.0	70	23 x 23 x 9	208 V	1	60	0.28 A	15 A	1,2,3,4,5,6	TRANE
IHP-1-4	2	315	0.6	0.5	OHP-1	7.5	6.2	75.0/62.5	9.0	70	23 x 23 x 9	208 V	1	60	0.28 A	15 A	1,2,3,4,5,6	TRANE
IHP-1-5	2	315	0.6	0.5	OHP-1	7.5	6.2	75.0/62.5	9.0	70	23 x 23 x 9	208 V	1	60	0.28 A	15 A	1,2,3,4,5,6	TRANE
IHP-1-6	2	315	0.6	0.5	OHP-1	7.5	6.2	75.0/62.5	9.0	70	23 x 23 x 9	208 V	1	60	0.28 A	15 A	1,2,3,4,5,6	TRANE
IHP-1-7	2	315	0.6	0.5	OHP-1	7.5	6.2	75.0/62.5	9.0	70	23 x 23 x 9	208 V	1	60	0.28 A	15 A	1,2,3,4,5,6	TRANE
IHP-1-8	2	315	0.6	0.5	OHP-1	7.5	6.2	75.0/62.5	9.0	70	23 x 23 x 9	208 V	1	60	0.28 A	15 A	1,2,3,4,5,6	TRANE
IHP-1-9	3	885	0.6	1.5	OHP-1	16.9	16.8	75.0/62.5	20.0	70	44 x 29 x 10	208 V	1	60	2.88 A	15 A	1,2,3,4,5,6	TRANE
IHP-2-1	3	1270	0.6	2.5	OHP-2	28	25.8	75.0/62.5	33.0	70	56 x 29 x 10	208 V	1	60	4.25 A	15 A	1,2,3,4,6,7	TRANE
IHP-2-2	3	1270	0.6	2.5	OHP-2	28	25.8	75.0/62.5	33.0	70	56 x 29 x 10	208 V	1	60	4.25 A	15 A	1,2,3,4,6,7	TRANE
IHP-2-3	3	1270	0.6	2.5	OHP-2	28	25.8	75.0/62.5	33.0	70	56 x 29 x 10	208 V	1	60	4.25 A	15 A	1,2,3,4,6,7	TRANE
IHP-2-4	2	600	0.6	1.0	OHP-2	11.2	9.7	75.0/62.5	13.1	70	23 x 23 x 9	208 V	1	60	0.39 A	15 A	1,2,3,4,5,6	TRANE
IHP-2-5	3	885	0.6	1.5	OHP-2	16.9	16.8	75.0/62.5	19.4	70	44 x 29 x 10	208 V	1	60	2.88 A	15 A	1,2,3,4,6,7	TRANE
IHP-3-1	3	1270	0.6	3.0	OHP-3	33.7	28.3	75.0/62.5	40.0	70	56 x 29 x 10	208 V	1	60	4.25 A	15 A	1,2,3,4,6,7	TRANE
IHP-3-2	2	335	0.6	0.75	OHP-3	11.2	8.1	75.0/62.5	13.5	70	23 x 23 x 9	208 V	1	60	0.29 A	15 A	1,2,3,4,5,6	TRANE
IHP-3-3	2	335	0.6	0.75	OHP-3	11.2	8.1	75.0/62.5	13.5	70	23 x 23 x 9	208 V	1	60	0.29 A	15 A	1,2,3,4,5,6	TRANE
IHP-3-4	2	335	0.6	0.75	OHP-3	11.2	8.1	75.0/62.5	13.5	70	23 x 23 x 9	208 V	1	60	0.29 A	15 A	1,2,3,4,5,6	TRANE
IHP-3-5	3	885	0.6	1.5	OHP-3	16.9	16.8	75.0/62.5	20.0	70	44 x 29 x 10	208 V	1	60	2.88 A	15 A	1,2,3,4,5,6	TRANE
IHP-3-6	1	300	0.6	0.75	OHP-3	7.5	6.2	75.0/62.5	9.0	70	23 x 23 x 9	208 V	1	60	0.28 A	15 A	1,2,3,4,5,6	TRANE

### OUTDOOR HEAT PUMP UNIT - VARIABLE REFRIGERANT SCHEDULE

**TYPE:**  
1. OUTDOOR HEAT PUMP, VRF, HEAT RECOVERY

**NOTES:**  
1. UNIT TO BE PROVIDED WITH HAIL GUARDS.  
2. MANUFACTURER MUST BE CERTIFIED, LISTED, AND LABELED PER AHRI 1230.  
3. SYSTEM RATING BASED ON DESIGN AMBIENT CONDITIONS FOR HEATING AND COOLING.  
4. CONDENSING UNITS MUST HAVE AUTO CHANGEOVER FUNCTIONS.  
5. CONDENSING UNITS MUST HAVE FULLY MODULATING INVERTER COMPRESSORS.  
6. SUBMITTED PERFORMANCE DATA MUST BE FULLY DERATED FOR ALL COMPONENTS AND ACCESSORIES, INCLUDING, BUT NOT LIMITED TO, LINE LENGTH, VERTICAL SEPERATION, CONNECTION RATIO, AND DESIGN.  
7. REFRIGERANT CIRCUIT ACCESS PORTS LOCATED OUTDOORS SHALL BE FITTED WITH LOCKING TYPE TAMPER RESISTANT CAPS.  
8. PROVIDE SEPARATE POWER CONNECTION WITH DISCONNECT SWITCH AT EACH OUTDOOR UNIT SECTION (DISCONNECT SWITCH PROVIDED BY ELECTRICAL).  
9. ALL REFRIGERANT PIPING JOINTS TO BE BRAZED AND LEAK TESTED.

MARK	TYPE	COOLING		HEATING		ELECTRICAL					EFFICIENCY		BASIS OF DESIGN		
		CAPACITY (MBH)	AMBIENT (DB°F)	CAPACITY (MBH)	AMBIENT (WB°F)	VOLTAGE	PH	Hz	MCA	MOCP	EER	IEER	COP @ 17°F	MANUFACTURER	MODEL
OHP-1	1	96	95°F	108	43°F	208 V	3	60	44 A	70 A	13.7	26.5	3.9	TRANE	TURYE096
OHP-2	1	120	95°F	135	43°F	208 V	3	60	56 A	90 A	12.6	25.0	3.7	TRANE	TURYE120
OHP-3	1	96	95°F	108	43°F	208 V	3	60	44 A	70 A	13.7	26.5	3.9	TRANE	TURYE096

### BRANCH SELECTOR BOX SCHEDULE

**NOTES:**  
1. SIZE REFRIGERANT PIPING PER MANUFACTURER'S RECOMMENDATIONS.  
2. PROVIDE BALL VALVES AND CAP ANY PIPING CONNECTION NOT USED.  
3. PROVIDE BALL VALVES WITH SCHRADER VALVE IN EACH PIPE CONNECTION TO THE CONTROLLER ON THE INLET AND OUTLET.  
4. PROVIDE DISCONNECT SWITCH FOR EACH BRANCH SELECTOR BOX.  
5. PROVIDE CONDENSATE PUMP (120/1/60) - 1 GPH @ 33 FT. HD.

MARK	ELECTRICAL					NUMBER OF CONNECTIONS	WEIGHT (LBS)	BASIS OF DESIGN
	V	PH	Hz	MCA (A)	MOCP (A)			
BCU-1	208	1	60	1.1	20	12	109	TRANE
BCU-2	208	1	60	0.55	20	6	109	TRANE
BCU-3	208	1	60	0.74	20	8	109	TRANE

### CEILING HEATER SCHEDULE

**HEATER TYPE:**  
1. ELECTRIC CEILING HEATER.  
2. BASIS OF DESIGN: MARKEL 3470

**ACCESSORIES:**  
1. SURFACE MOUNTING.  
2. UNIT MOUNTED THERMOSTAT.  
3. DISCONNECT SWITCH.  
4. HIGH LIMIT CONTROLS.  
5. RADIAL DIFFUSER.

MARK	SIZE	ELECTRICAL			ACCESSORIES
		V	PH	Hz	
ECH-1	3.5 KW	208	1	60	1,2,3,4,5
ECH-2	5 KW	208	1	60	1,2,3,4,5
ECH-3	3.5 KW	208	1	60	1,2,3,4,5
ECH-4	3.5 KW	208	1	60	1,2,3,4,5

### AIR PURIFICATION SCHEDULE

FLOW	GPS MODEL	GPS QUANTITY	MINIMUM NEEDLE SPACING	VOLTAGE	WATTS	MOUNTING LOCATION	MINIMUM ION DENSITY (IONS/CC)
CV	GPS-IMOD	1 PER COOLING COIL	1 EVERY 3/4"	115	15	UNIT SERVED	40 MILLION PER 0.75"

**NOTES:**  
1. BASIS OF DESIGN: GLOBAL PLASMA SOLUTIONS: APPROVED EQUALS BY PHENOMENAL AIRE, ACTIVE AIR, AIRGENICS AND BIOXGEN SUBJECT TO SPECIFICATION COMPLIANCE.  
2. MOUNT GPS-IMOD TO AIR INLET SIDE OF COOLING COIL.  
3. IF CONTRACTOR SUBSTITUTES BASIS OF DESIGN WITH ANOTHER MANUFACTURER, CONTRACTOR SHALL COORDINATE ALL ELECTRICAL AND MECHANICAL CHANGES.  
4. BI-POLAR IONIZATION SYSTEMS REQUIRING PERISHABLE GLASS TUBES ARE NOT ACCEPTABLE.  
5. ALL MANUFACTURER'S MUST PASS UL-967-2007 OZONE CHAMBER TESTING BY EITHER US OR ETL.  
6. IONIZATION BAR TO HAVE A MINIMUM OF 1 NEEDLEPOINT EVERY 0.75" OF COIL WIDTH. SYSTEMS WITH NEEDLES FURTHER APART SHALL NOT BE ACCEPTABLE.  
7. IONIZATION SYSTEMS WITH MULTIPLE ION MODULES MOUNTED TO A BAR SHALL NOT BE AN ACCEPTABLE SUBSTITUTE.  
8. IONIZATION SYSTEMS THAT DO NOT USE EPOXY TO PROTECT THE ION CIRCUITRY SHALL NOT BE ACCEPTABLE.  
9. IONIZATION OUTPUT SHALL BE A MINIMUM OF 40 MILLION IONS/CC FOR EVERY 0.75" OF COIL WIDTH.

\*PROVIDE FOR THE FOLLOWING UNITS: ERU-1

### CONDENSING UNIT SCHEDULE

**TYPE:**  
1. AIR COOLED CONDENSING UNIT.

**ACCESSORIES:**  
1. PHASE PROTECTION.  
2. MICROPROCESSOR CONTROLS.  
3. ISOLATION VALVES.  
4. LIQUID LINE REFRIGERANT FILTER DRIER.  
5. ANTI SHORT CYCLE TIMER.  
6. LOW AMBIENT CONTROL DOWN TO 0°F.  
7. HAIL / VANDAL GUARDS.  
8. THERMAL EXPANSION VALVE.  
9. HOT GAS BYPASS WITH RAWAL DEVICE AT CONDENSING UNIT.

**NOTES:**  
1. CAPACITY TO BALANCE RESPECTIVE INDOOR AC UNIT.  
2. COOLING CAPACITY RATED AT 95°F.  
3. UL LISTED, AHRI CERTIFIED.  
4. REFRIGERANT CIRCUIT ACCESS PORTS LOCATED OUTDOORS SHALL BE FITTED WITH LOCKING TYPE TAMPER-RESISTANT CAPS. ANY ACCESS DEVICE REQUIRED SHALL BE LEFT ON SITE WITH THE OWNER AT PROJECT CLOSE OUT.  
5. MANIFOLD COMPRESSORS AND SINGLE REFRIGERANT CIRCUIT FOR TWO STAGE COOLING.

REFRIGERANT: R454B

MARK	TYPE	NOMINAL TONS	ELECTRICAL					EFFICIENCY	BASIS OF DESIGN	
			V	PH	Hz	MCA (A)	MOCP (A)		MANUFACTURER	MODEL
CU-1	1	10	208 V	3	60	41	50	11.5 EER / 14.8 IEER	TRANE	TTA120

### FAN SCHEDULE

**FAN TYPE:**  
1. CEILING MOUNTED EXHAUST FAN.  
2. CENTRIFUGAL SQUARE INLINE FAN - DIRECT DRIVE WITH SPRING ISOLATOR HANGERS.  
3. PROPELLER WALL FAN - BELT DRIVE.  
4. CENTRIFUGAL SQUARE INLINE FAN - BELT DRIVE WITH SPRING ISOLATOR HANGERS.

**FAN ACCESSORIES:**  
1. BACKDRAFT DAMPER.  
2. DISCONNECT SWITCH.  
3. ALUMINUM CEILING EXHAUST GRILLE.  
4. DIRECT DRIVE WITH FAN MOUNTED SOLID STATE SPEED CONTROL EC MOTOR W/ VFD FOR SOFT START.  
5. 5A-120V FAN SPEED CONTROLLER.  
6. FLEXIBLE CONNECTION.  
7. WEATHERPROOF MOTOR ENCLOSURE.  
8. WALL SWITCHES FOR SF-1 AND ALL ASSOCIATED AUTO DAMPERS AND CONTROLS TO BE ON EMERGENCY POWER.  
9. EF-1 AND EF-2 TO BE PLACED ON EMERGENCY POWER.  
10. MOTOR SIDE GUARD.  
11. LINT TRAP.  
12. HINGED ACCESS TO IMPELLAR.  
13. SHALL MEET UL 705 FOR USE IN DRYER EXHAUST DUCT SYSTEMS PROVIDE ALARM ANNUCIATOR PANEL WITH SIGNAGE. PROVIDE SIGNAGE FOR FAN LOCATION.

**NOTES:**  
1. TIE WITH LIGHTS. COORDINATE WITH ELECTRICAL CONTRACTOR.  
2. TIE TO EMERGENCY WALL SWITCH.  
3. TIE WITH THERMOSTAT AND CO2 SENSOR ON WALL.  
4. INTERLOCK WITH DRYER.

MARK	FAN TYPE	NOTES	AIRFLOW (CFM)	E.S.P. (IN.-W.G.)	WHEEL SIZE (INCHES)	FAN RPM	MOTOR (HP / W)	ELECTRICAL			WEIGHT (LBS)	ACCESSORIES	BASIS OF DESIGN	
								V	PH	Hz			MANUFACTURER	MODEL
EF-1	1	1	70	0.167	8"	665	28 W	120 V	1	60	15	1,2,3,5,9	LOREN COOK	GC
EF-2	1	1	50	0.167	8"	566	23 W	120 V	1	60	15	1,2,3,5,9	LOREN COOK	GC
EF-3	1	1	120	0.167	8"	910	40 W	120 V	1	60	15	1,2,3,5	LOREN COOK	GC
EF-DRYER	4	4	120	0.5	10"	1730	125 W	120 V	1	60	30	2,11,12,13	LOREN COOK	SQNB
SF-1	2	2	250	0.25	10"	1608	0.25 HP	120 V	1	60	70	1,2,4,6,8	LOREN COOK	SQND
VF-1	3	3	6500	0.25	36"	635	1 HP	120 V	1	60	120	2,7,10	LOREN COOK	AWB
VF-2	3	3	6500	0.25	36"	635	1 HP	120 V	1	60	120	2,7,10	LOREN COOK	AWB

SIGNAGE FOR DRYER BOOSTER EXHAUST FAN ALARM (REFER TO ARCHITECTURAL SIGNAGE SPECIFICATION FOR COLOR AND SIZE OF THE SIGN AND TEXT). COORDINATE EXACT LOCATION OF SIGN WITH ARCHITECT.


DRYER BOOSTER EXHAUST FAN. VERIFY PROPER OPERATION. FAN IS LOCATED IN CEILING OF \_\_\_\_\_.

(CONTRACTOR TO ADD EXACT LOCATION OF FAN TO THE SIGN.)



100% CDS

**IRONDALE FIRE STATION #3**  
INT. OF JOHN ROGERS DRIVE & ALTON ROAD  
Birmingham, Alabama  
CITY OF IRONDALE

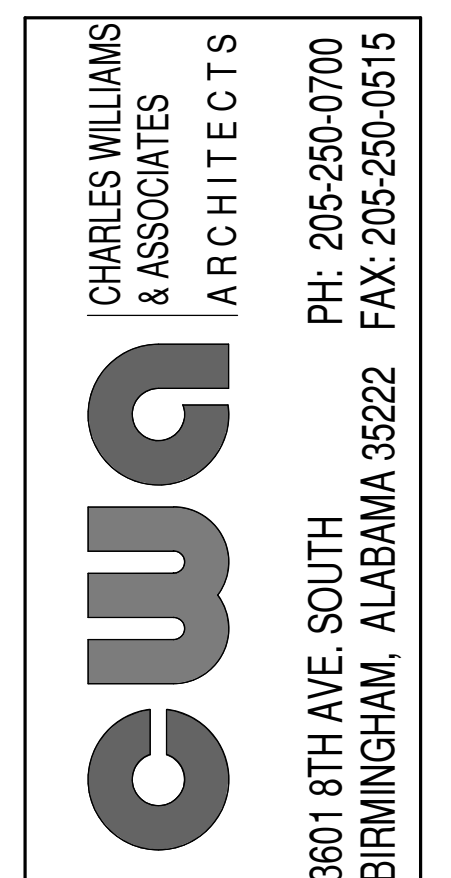

SHEET TITLE:  
**MECHANICAL SCHEDULES**

PROJECT NUMBER:  
**CWA No. 2023-01**


DATE:  
**08.30.24**

DRAWN BY:  
**LWH**

CHECKED BY:  
**JWS**

SHEET NUMBER  
**M0.2**

Revisions		
No.	Date	Description
2	2/21/2025	ADDENDUM 3

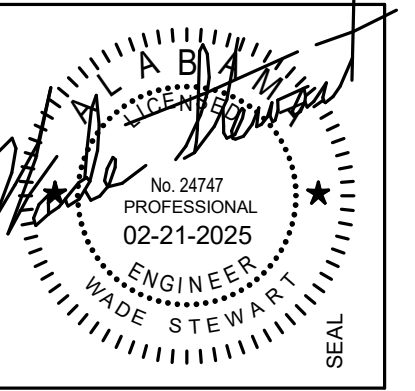


100% CDS

**IRONDALE FIRE STATION #3**  
 INT. OF JOHN ROGERS DRIVE & ALTON ROAD  
 Birmingham, Alabama  
 CITY OF IRONDALE


CHARLES WILLIAMS & ASSOCIATES ARCHITECTS  
 PH: 205-250-0700  
 3601 8TH AVE. SOUTH BIRMINGHAM, ALABAMA 35222  
 FAX: 205-250-0515

SHEET TITLE:  
**MECHANICAL CONTROLS & DETAILS**  
 PROJECT NUMBER:  
**CWA No. 2023-01**  
 DATE:  
**08.30.24**  
 DRAWN BY:  
**LWH**  
 CHECKED BY:  
**JWS**


SHEET NUMBER  
**M0.5**

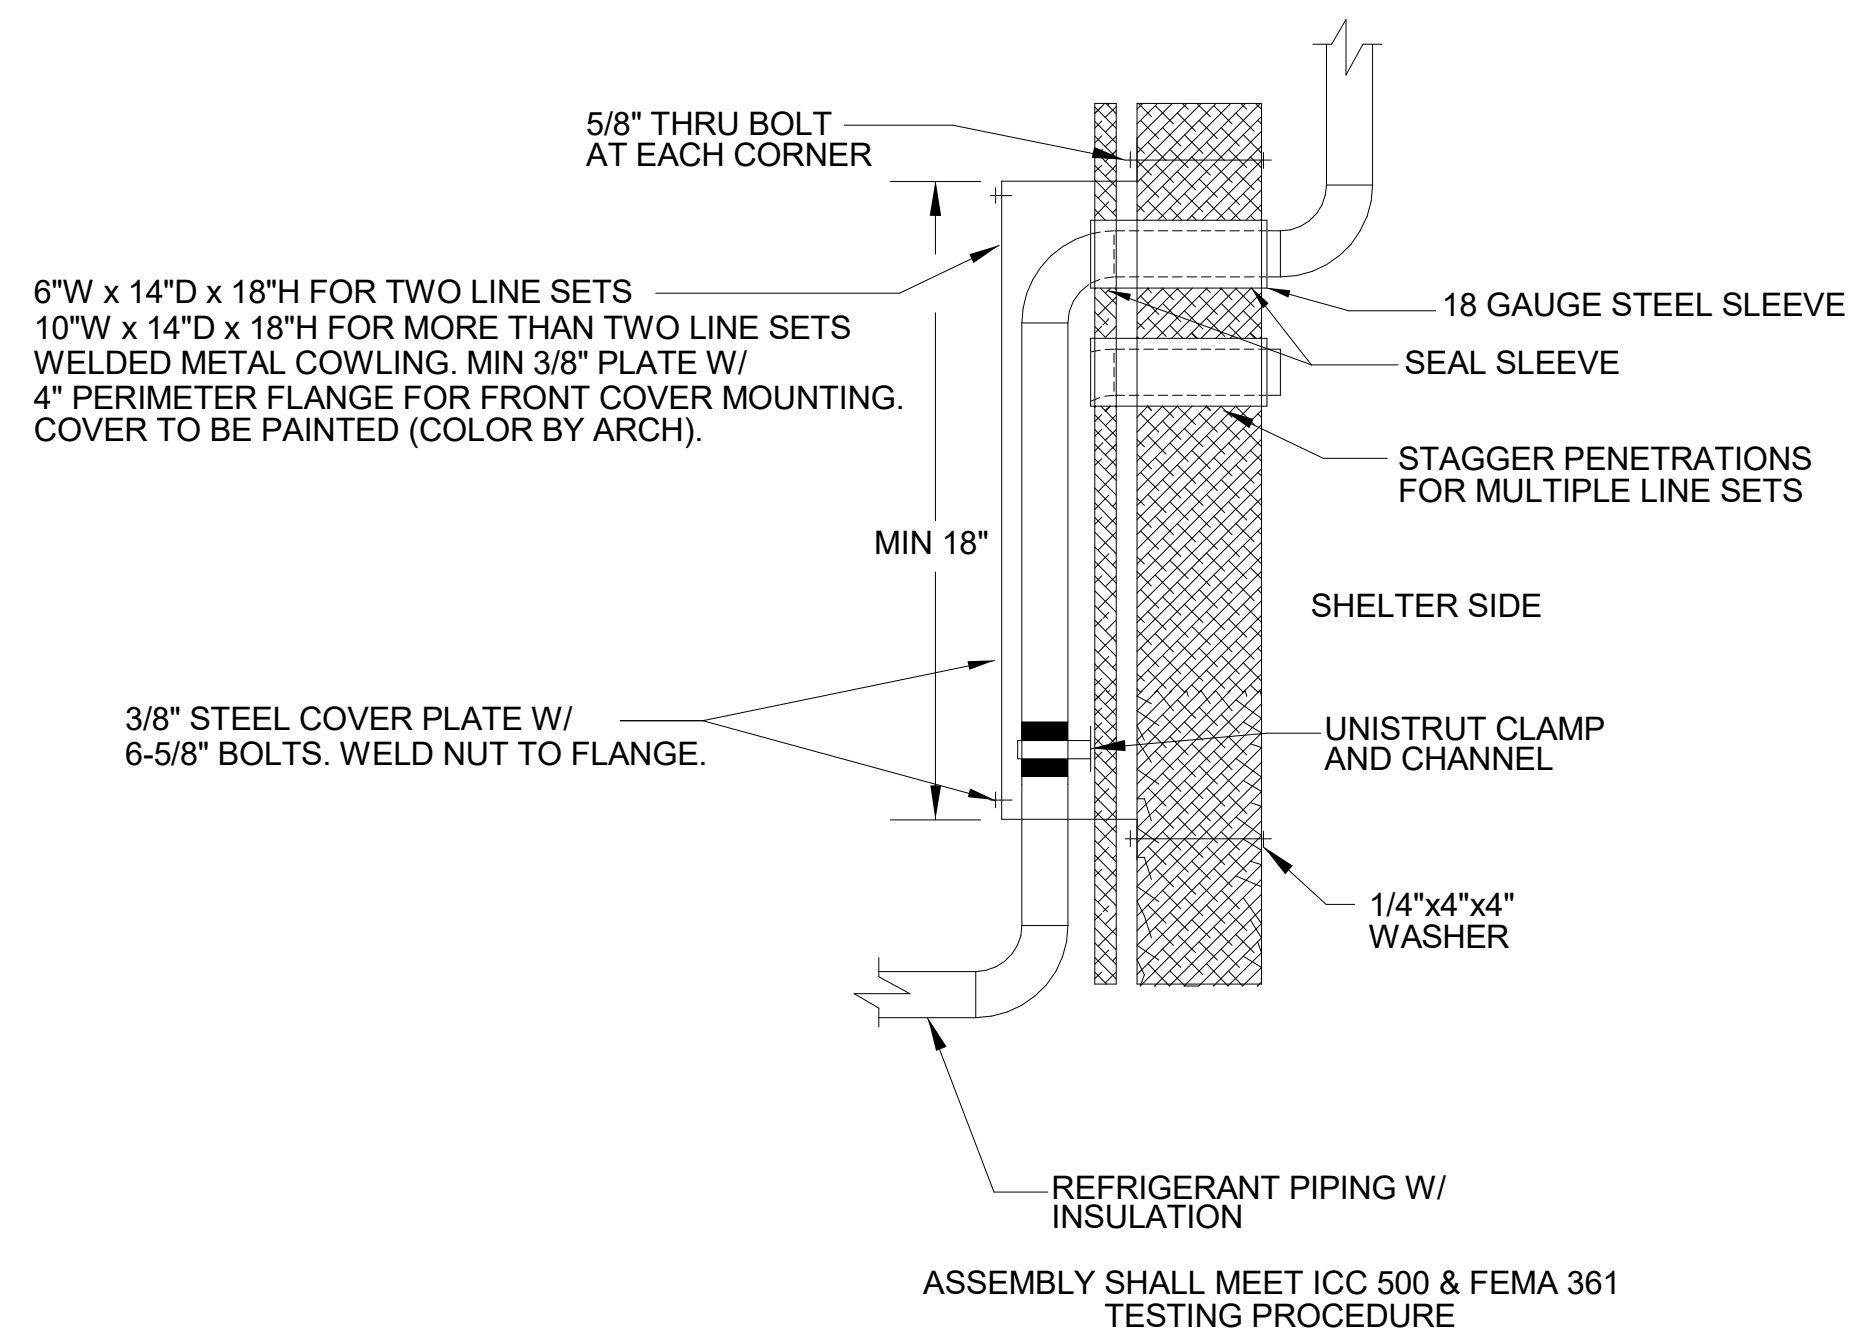


**REFRIGERANT PIPING PENETRATION THRU STORM SHELTER PROTECTION DETAIL**  
 NO SCALE

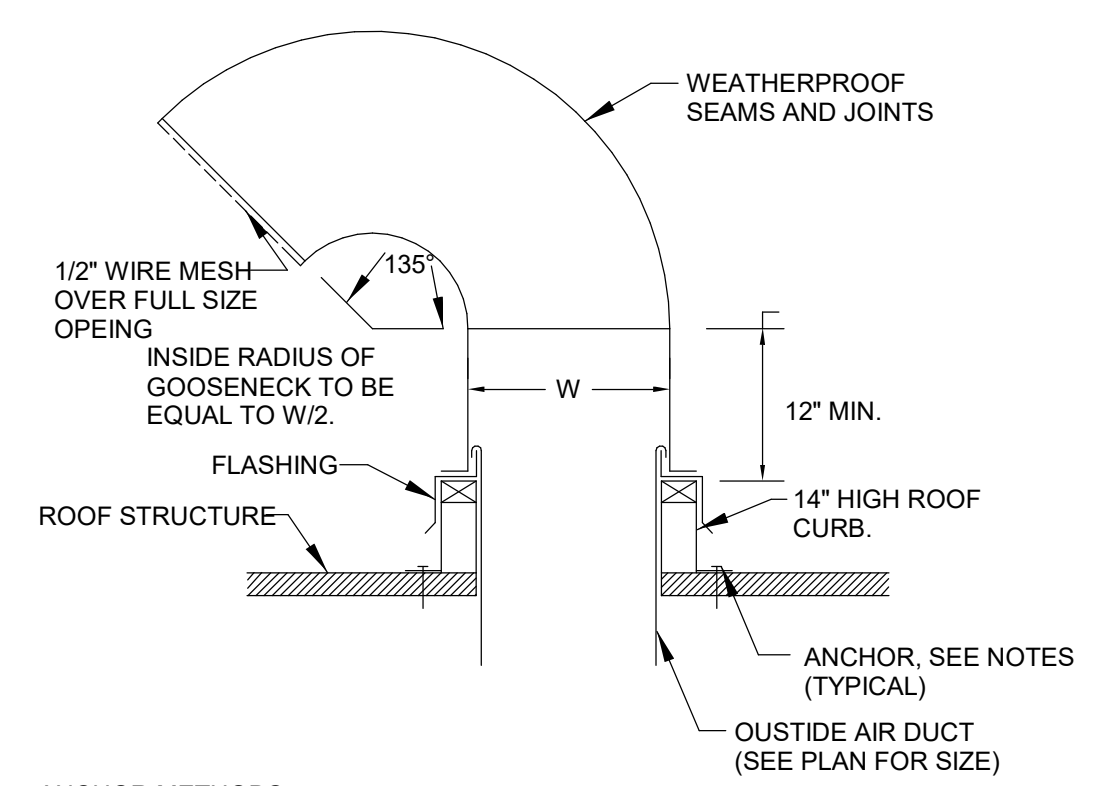

**GOOSENECK INSTALLATION DETAIL**  
 NO SCALE

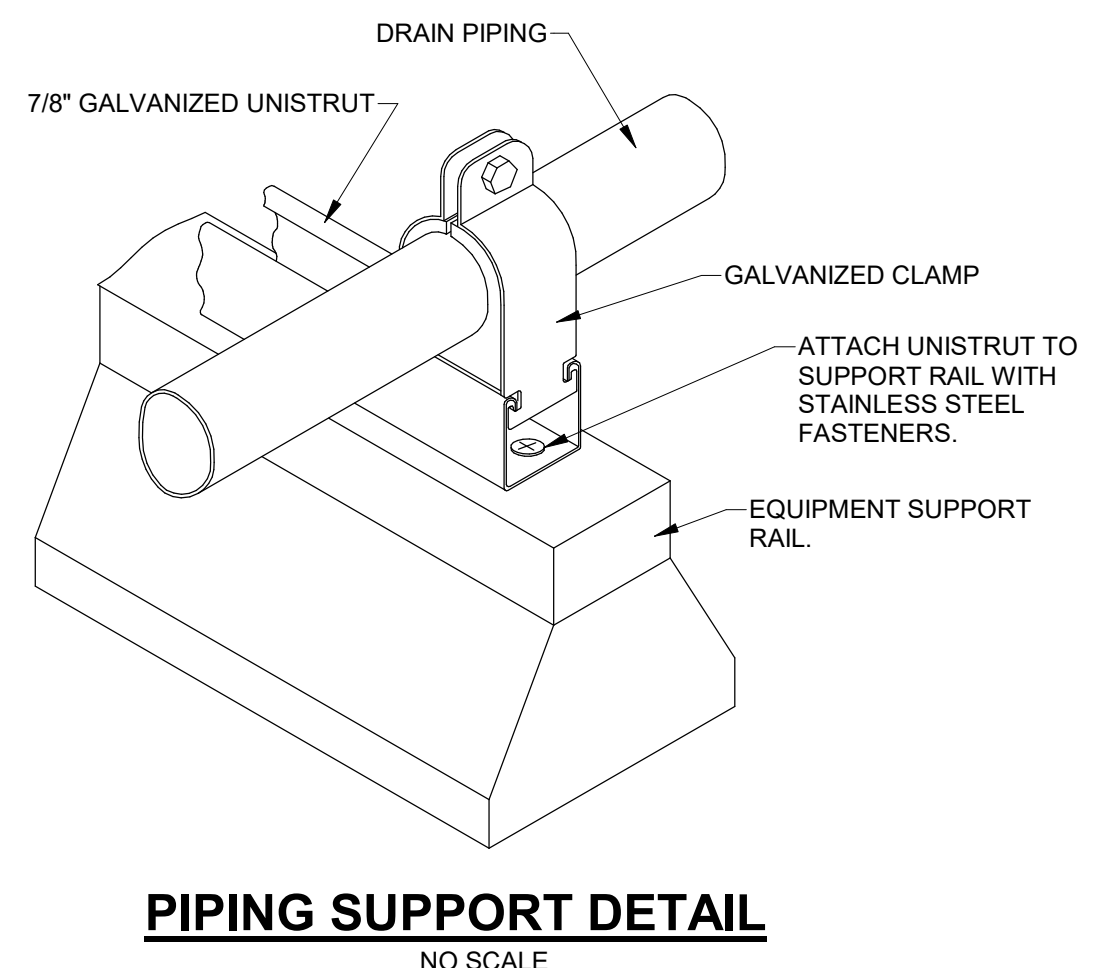


**PIPING SUPPORT DETAIL**  
 NO SCALE

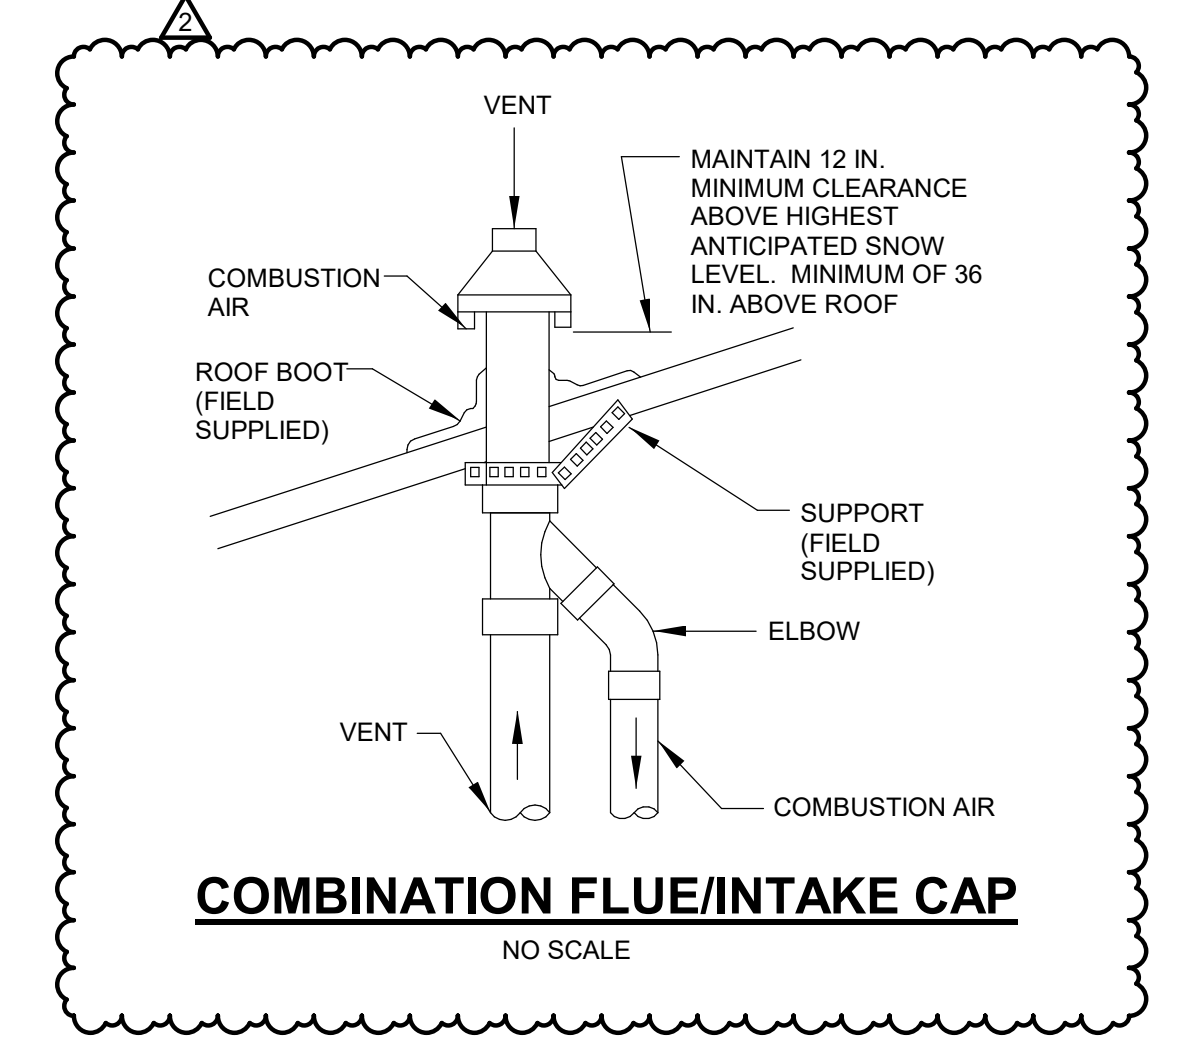


**COMBINATION FLUE/INTAKE CAP**  
 NO SCALE

**HVAC CONTROLS - GENERAL NOTES**


- MECHANICAL CONTRACTOR TO COORDINATE WITH ELECTRICAL CONTRACTOR FOR EXACT QUANTITY AND LOCATIONS OF 120V CONTROL POWER NECESSARY TO CONTROL PANELS AND EQUIPMENT THROUGHOUT PROJECT.
- MECHANICAL CONTRACTOR TO COORDINATE WITH ELECTRICAL CONTRACTOR FOR EXACT QUANTITY AND LOCATIONS OF 120V CONTROL POWER NECESSARY TO POWER AUTOMATIC CONTROL VALVES, AUTOMATIC DAMPER ACTUATORS, AND SMOKE DAMPER ACTUATORS.
- ALL SMOKE DETECTORS ARE PROVIDED AND WIRED BY ELECTRICAL, INSTALLED BY MECHANICAL.
- PROVIDE ALL NECESSARY RELAYS, SWITCHES, SENSORS, LOW VOLTAGE CONTROL WIRING, ACTUATORS, ETC. FOR A COMPLETE AND FUNCTIONAL CONTROL SYSTEM.
- PROVIDE LOCKING COVERS ON ALL THERMOSTATS AND CONTROL DEVICES AS INDICATED ON THE FLOOR PLANS.

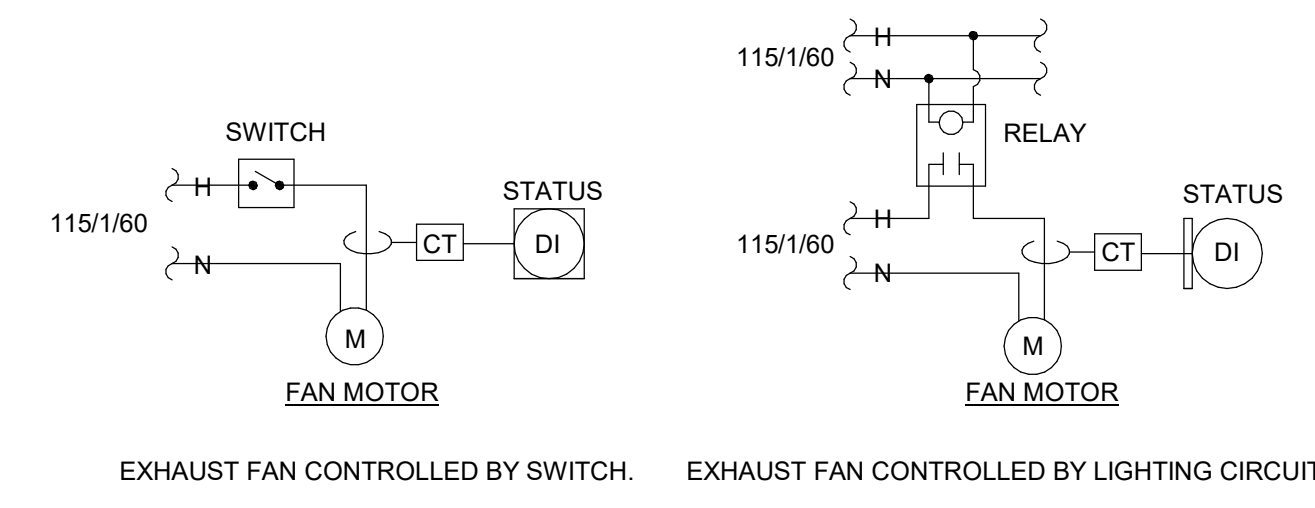


**EXHAUST FAN CONTROLS**  
 NO SCALE

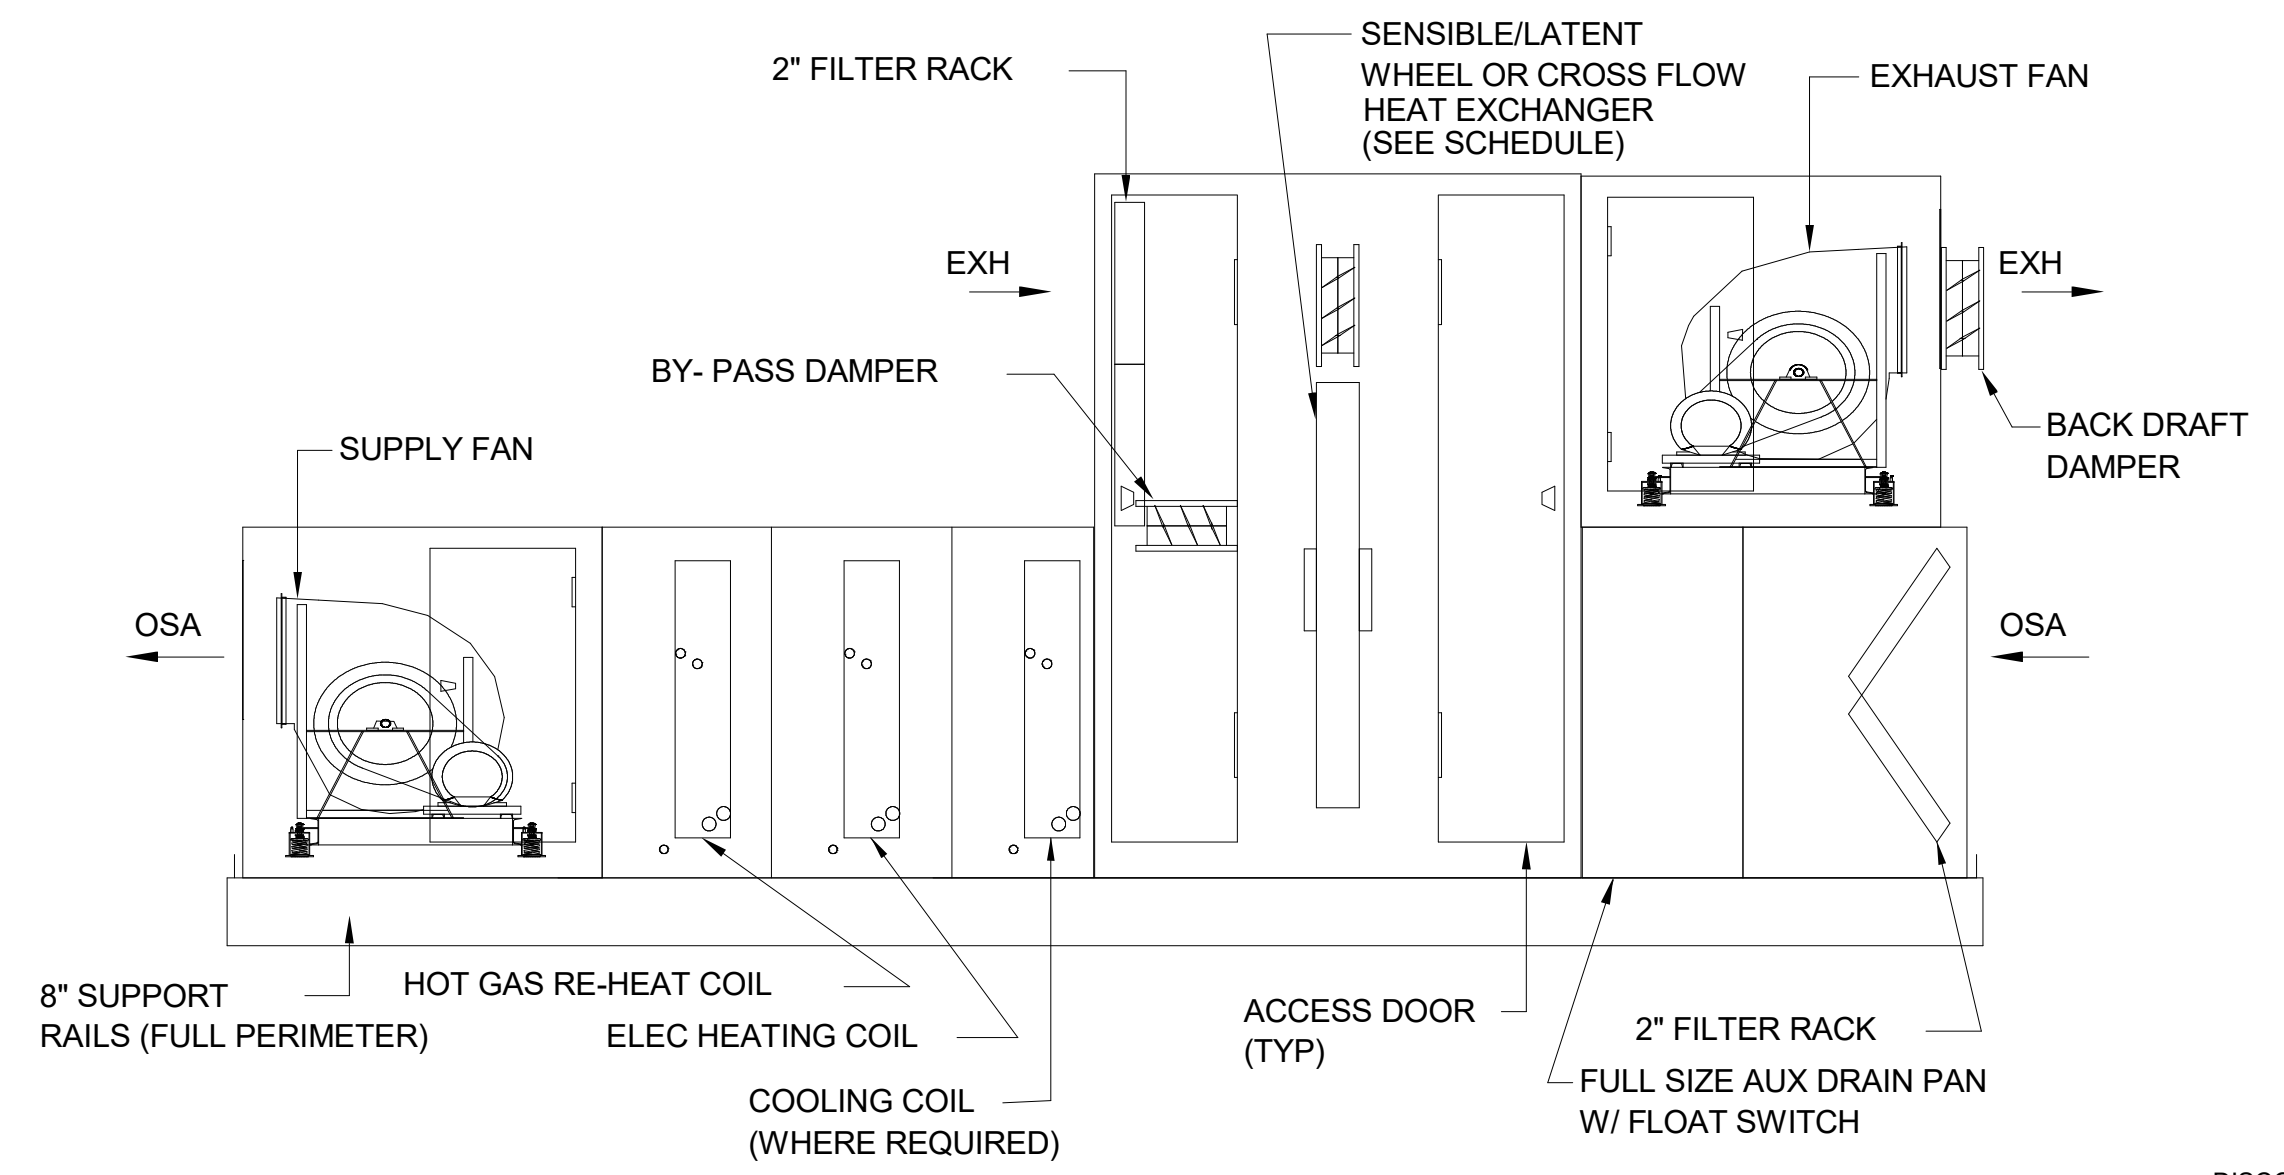


**ENERGY RECOVERY UNIT SCHEMATIC**  
 NO SCALE

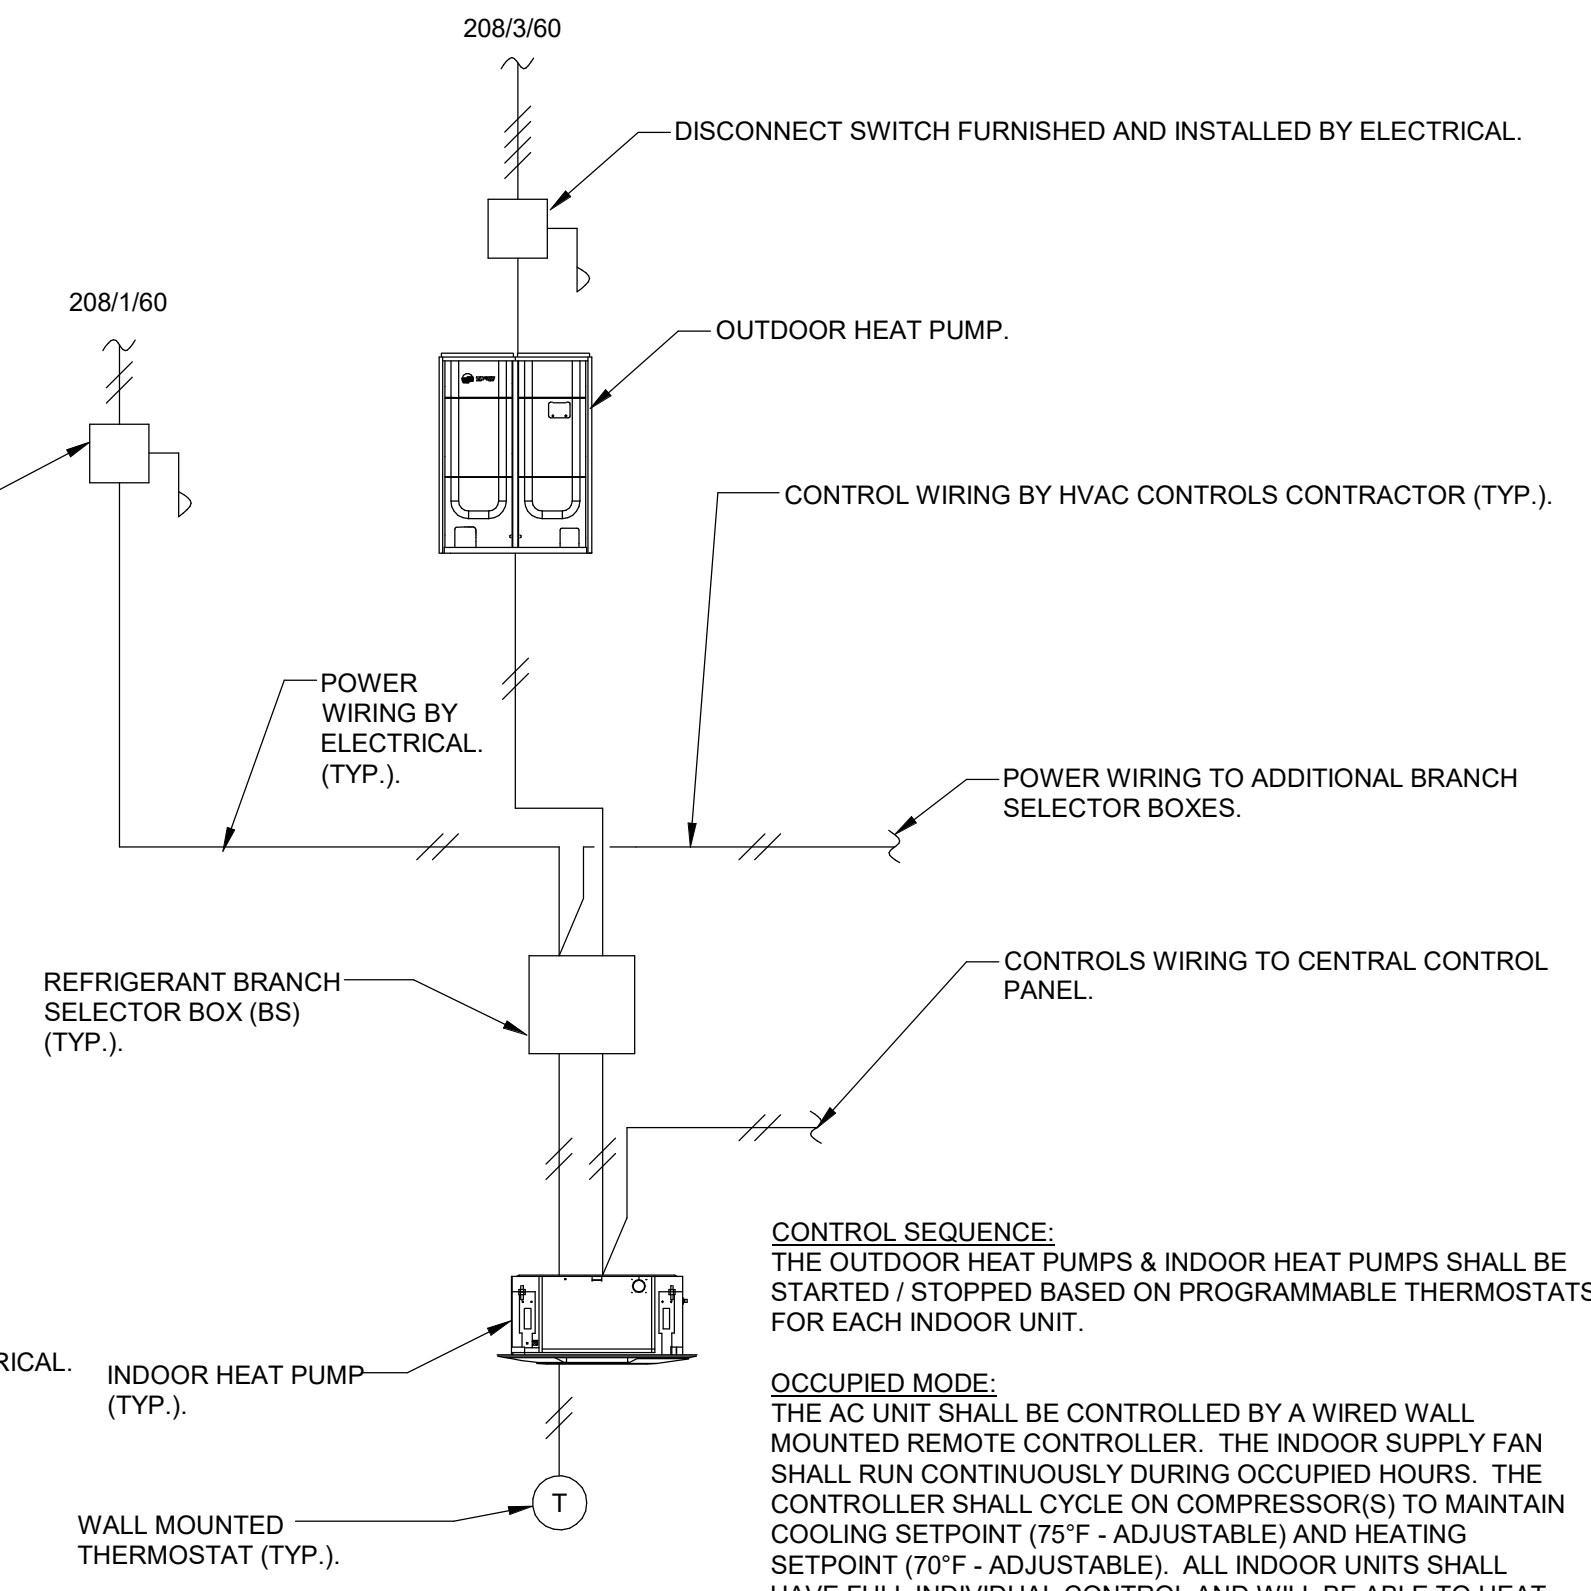

**TYPICAL VARIABLE REFRIGERANT SYSTEM CONTROLS DIAGRAM**  
 NO SCALE

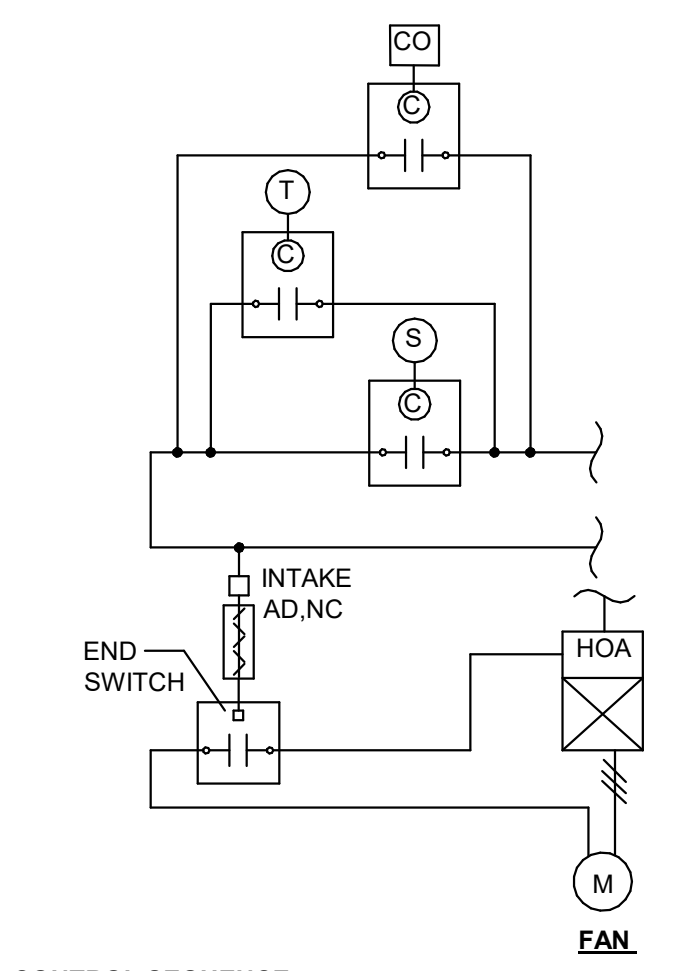

**VENTILATION FAN CONTROLS (VF-1 AND VF-2)**  
 NO SCALE

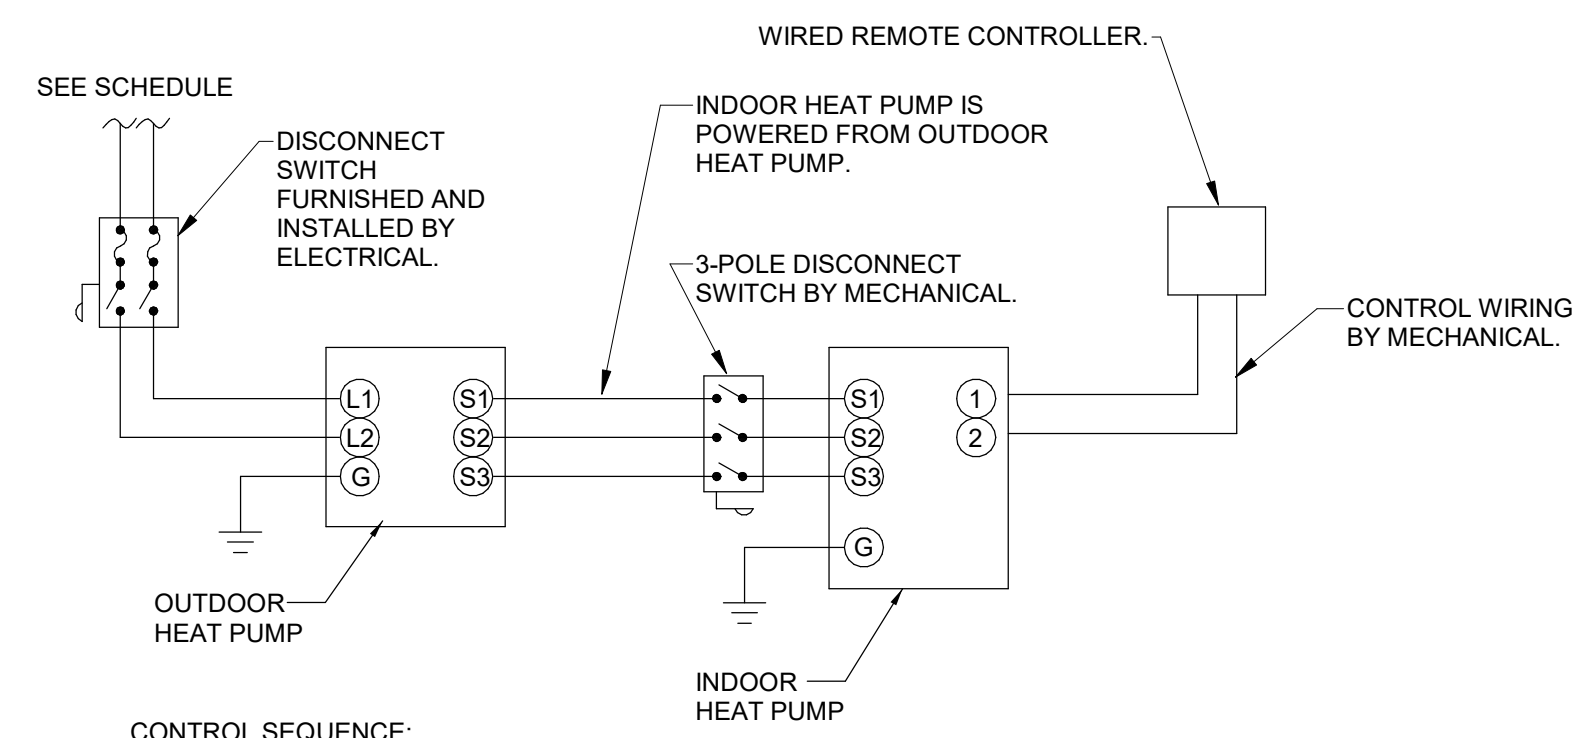

**DUCTLESS SPLIT SYSTEM CONTROLS**  
 NO SCALE

NOTES:  
 1. MECHANICAL CONTRACTOR TO PROVIDE DISCONNECT SWITCH AT ALL INDOOR UNITS AND ALL MCUS. DISCONNECT SWITCH SHALL BE INSTALLED AND WIRED BY ELECTRICAL.  
 2. ALL CONTROLS WIRING FROM OUTDOOR UNIT TO INDOOR UNITS AND MCUS SHALL BE BY MECHANICAL CONTRACTOR.  
 3. ALL POWER WIRING TO ALL INDOOR UNITS AND BRANCH SELECTOR BOXES SHALL BE BY ELECTRICAL.

**CONTROL SEQUENCE:**  
 THE AC UNIT SHALL BE CONTROLLED BY A WIRED WALL MOUNTED REMOTE CONTROLLER. THE CONTROLLER SHALL CYCLE ON COMPRESSOR(S) TO MAINTAIN COOLING SETPOINT (74°F - ADJUSTABLE) AND HEATING SETPOINT (70°F - ADJUSTABLE). ALL MINI-SPLIT AC UNITS THAT SERVE ELECTRIC AND IT ROOMS SHALL NOT SET THEIR TEMPERATURE BACK AT NIGHT. FOR ALL MINI-SPLIT AC UNITS THAT SERVE OFFICES, CLASSROOMS, ETC. SHALL SET THEIR TEMPERATURE BACK TO 4°F ABOVE SETPOINT IN SUMMER AND 4°F BELOW SETPOINT IN THE WINTER. COORDINATE WITH OWNER TO ESTABLISH OCCUPIED / UNOCCUPIED SCHEDULES.



GENERAL NOTES NOTES:

1. ALL DUCT WORK AND EQUIPMENT SHALL BE LOCATED BETWEEN THE CEILING AND BOTTOM OF THE TRUSSES UNLESS OTHERWISE SHOWN.

SHELTER OSA CALCULATIONS								
Room	Room Type	Rp	Pz	Ra	Az	Vbz	Ez	Voz
		cfm / P	People	cfm/ft <sup>2</sup>	ft <sup>2</sup>	cfm		cfm
AUX ROOM (STORM SHELTER) 141	Conference / Meeting	5	50	0.00	287	250	1.00	250
TLT 142	Restroom	5	0	0.00	57	0	1.00	0
JAN 143	Janitor's Closet	5	0	0.00	54	0	1.00	0
		Total Required by SF-1:				250		250
		Total Provided by SF-1:				250		250

SIGNAGE FOR EMERGENCY VENTILATION FAN SWITCHES (REFER TO ARCHITECTURAL SIGNAGE SPECIFICATION FOR SIGN AND TEXT COLOR AND SIZE) (COORDINATE EXACT LOCATION WITH ARCHITECT).

EMERGENCY VENTILATION FANS TO BE SWITCHED ON UPON A LOSS OF POWER IN THE SHELTER DURING A STORM EVENT.


ALL INTERIOR DOORS TO ROOMS IN SHELTER ARE TO BE OPENED IF EMERGENCY VENTILATION FANS ARE ON.

EMERGENCY VENTILATION FANS ARE TO BE SWITCHED OFF UPON POWER RESTORED.

- KEYED NOTES:
- HIGH IMPACT LOUVERS AND WEATHER LOUVERS. HIGH IMPACT LOUVERS SHALL MEET IMPACT TESTING CRITERIA FOR TORNADO SHELTERS IN ICC 500/FEMA 361. LOUVER TO BE RUSKIN XP500S-415 OR EQUAL. SEE DETAIL. WEATHER LOUVER SHALL BE INSTALLED ON EXTERIOR WALL WITH HIGH IMPACT LOUVER INSTALLED BEHIND WEATHER LOUVER. (EXTERIOR WALL APPLICATION ONLY).
  - NORMALLY CLOSED AUTO DAMPER TO REMAIN CLOSED WHEN POWERED CONTINUOUSLY. UPON THE LOSS OF POWER OR DE-ACTIVATION BY WALL SWITCH DURING STORM EVENT, THE DAMPERS SHALL OPEN. DAMPER TO RETURN TO NORMAL POSITION ONCE SWITCH IS DEACTIVATED OR POWER IS RESTORED.
  - WALL SWITCHES FOR SF-1 AND ALL ASSOCIATED AUTO DAMPERS TO BE ACTIVATED UPON THE LOSS OF POWER DURING A STORM EVENT. UPON THE ACTIVATION OF EITHER SWITCH, PROVIDE SIGNAGE OUTSIDE OF JANITOR 143, "EMERGENCY VENTILATION FAN SWITCHES" FOR SF-1. EF-1 AND EF-2 SHALL BE ON EMERGENCY POWER.
  - 4" DRYER EXHAUST UP TO GOOSENECK ON ROOF.
  - RESIDENTIAL STYLE KITCHEN HOOD WITH BUILT IN FAN. 800 CFM EXHAUST. PROVIDED BY OTHERS.
  - 10" EXHAUST DUCT UP TO GOOSENECK ON ROOF.
  - 4" COMBUSTION AIR INTAKE THRU EXTERIOR WALL TO MANUFACTURER'S APPROVED CAP WITH BIRDSCREEN. PROVIDE MATERIALS AND INSTALLATION PER MANUFACTURER.
  - 6" FLUE VENT UP THRU ROOF TO MANUFACTURER'S APPROVED CAP. PROVIDE MATERIALS AND INSTALLATION PER MANUFACTURER.
  - 6" EXHAUST DUCT UP TO GOOSENECK ON ROOF.
  - PROVIDE REMOTE CABLE OPERATED DAMPER IN CEILING FOR DAMPER OPERATION.
  - DRYER BOOSTER EXHAUST FAN ALARM PANEL AND SIGN LOCATION (SEE EXHAUST FAN SCHEDULE FOR SIGNAGE, COORDINATE EXACT LOCATION WITH ARCHITECT).
  - PROVIDE GUARDIAN G300B WET CHEMICAL EXTINGUISHER UNIT COMPLETE WITH ENCLOSURE, EXTINGUISHER ASSEMBLY, DISTRIBUTION ASSEMBLY, AND ELECTRIC SHUT-OFF. SYSTEM SHALL BE CONNECTED TO BUILDING FIRE ALARM SYSTEM. INSTALL IN CABINET ABOVE RANGE.
  - MAGNEGRIP TO BE THE BASIS OF DESIGN FOR THE VEHICLE EXHAUST RAIL SYSTEM EQUIPMENT. ALL VEHICLE EXHAUST RAIL SYSTEM EQUIPMENT AND DUCTWORK TO BE SUPPLIED AND INSTALLED BY MAGNEGRIP. ALL ELECTRICAL WORK SHALL FALL UNDER THE SCOPE OF THE PROJECT ELECTRICIAN. ALL WALL OR ROOF PENETRATIONS AND SEALINGS ARE AT THE CUSTOMERS OR CONTRACTOR'S EXPENSE AND NOT THE RESPONSIBILITY OF MAGNEGRIP. CONTACT DAVID SAPP AT MAGNEGRIP FOR PRICING. DSAPP@MAGNEGRIP.COM, 800-875-5440.
  - APPROX. 12" ROUND FROM MAGNEGRIP CF363-5 THRU EXTERIOR WALL TO EXHAUST STACK. MAGNEGRIP IS NOT RESPONSIBLE FOR WALL PENETRATION OR SEALING. WALL PENETRATIONS AND SEALINGS TO BE DONE BY GENERAL CONTRACTOR.
  - EXHAUST RAIL W/ TAILPIPE HOSE DROP. RAIL SHALL EXTEND LENGTH OF BAY. EACH HOSE SHALL BE SIZED FOR APPROXIMATELY 600 CFM.
  - APPROX. 8" ROUND DROP TO EXHAUST RAIL. ALL DUCT SIZES AND LOCATIONS FOR VEHICLE EXHAUST SYSTEM ARE APPROXIMATE.
  - VEHICLE EXHAUST FAN, BASIS OF DESIGN MAGNEGRIP CF363-5, APPROX. 3300 CFM.
  - APPROX. LOCATION OF VEHICLE EXHAUST SYSTEM CONTROL PANEL. PANEL WILL REQUIRE A DEDICATED 208/360 CIRCUIT.
  - EMERGENCY SHUT-OFF BUTTON FOR VEHICLE EXHAUST FAN (MAGNEGRIP CF363-5) TO BE PROVIDED BY THE CONTROLS CONTRACTOR.
  - DUCT TO BE ROUTED UP AND OVER VAULTED CEILING IN EXERCISE ROOM AND IN TRUSS WEBBING.

3" FLUE AND INTAKE PIPES FROM UNIT UP THRU ATTIC TO CONCENTRIC VENT ON ROOF. WHERE PLASTIC PIPING IS USED FOR VENTING GAS APPLIANCES, THE APPLIANCE SHALL BE LISTED FOR USE WITH SUCH VENTING MATERIALS AND THE APPLIANCE MANUFACTURERS INSTALLATION INSTRUCTIONS SHALL IDENTIFY THE SPECIFIC PLASTIC PIPING MATERIAL. THE PLASTIC PIPE VENTING MATERIALS SHALL BE LABELED IN ACCORDANCE WITH PRODUCT STANDARDS SPECIFIED BY THE APPLIANCE MANUFACTURER OR LISTED AND LABELED IN ACCORDANCE WITH UL1738. COMPLY WITH 2021 IFGC 503.4 TYPE OF VENTING SYSTEM USED. SEE DETAIL.

Revisions		
No.	Date	Description
1	2/5/2025	Revision
2	2/21/2025	ADDENDUM 3

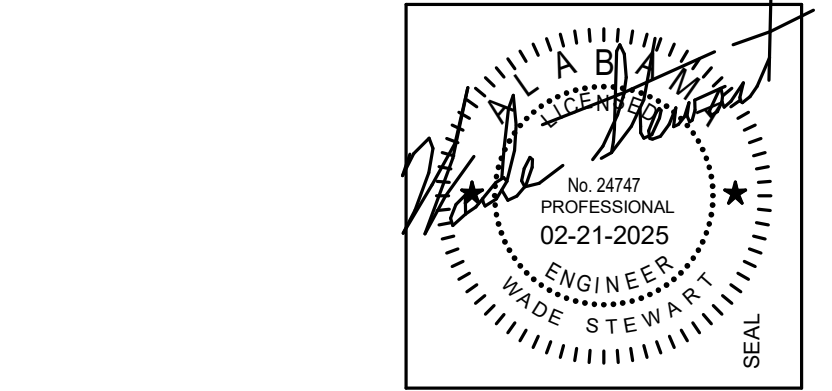

100% CDS

**IRONDALE FIRE STATION #3**  
 INT. OF JOHN ROGERS DRIVE & ALTON ROAD  
 Birmingham, Alabama  
 CITY OF IRONDALE

CHARLES WILLIAMS & ASSOCIATES ARCHITECTS  
 3601 8TH AVE SOUTH BIRMINGHAM, ALABAMA 35222  
 PH: 205-250-0700 FAX: 205-250-0515

SHEET TITLE:  
**MECHANICAL - FLOOR PLAN**


PROJECT NUMBER:  
**CWA No. 2023-01**

DATE:  
**08.30.24**

DRAWN BY:  
**LWH**


CHECKED BY:  
**JWS**

SHEET NUMBER  
**M1.1**

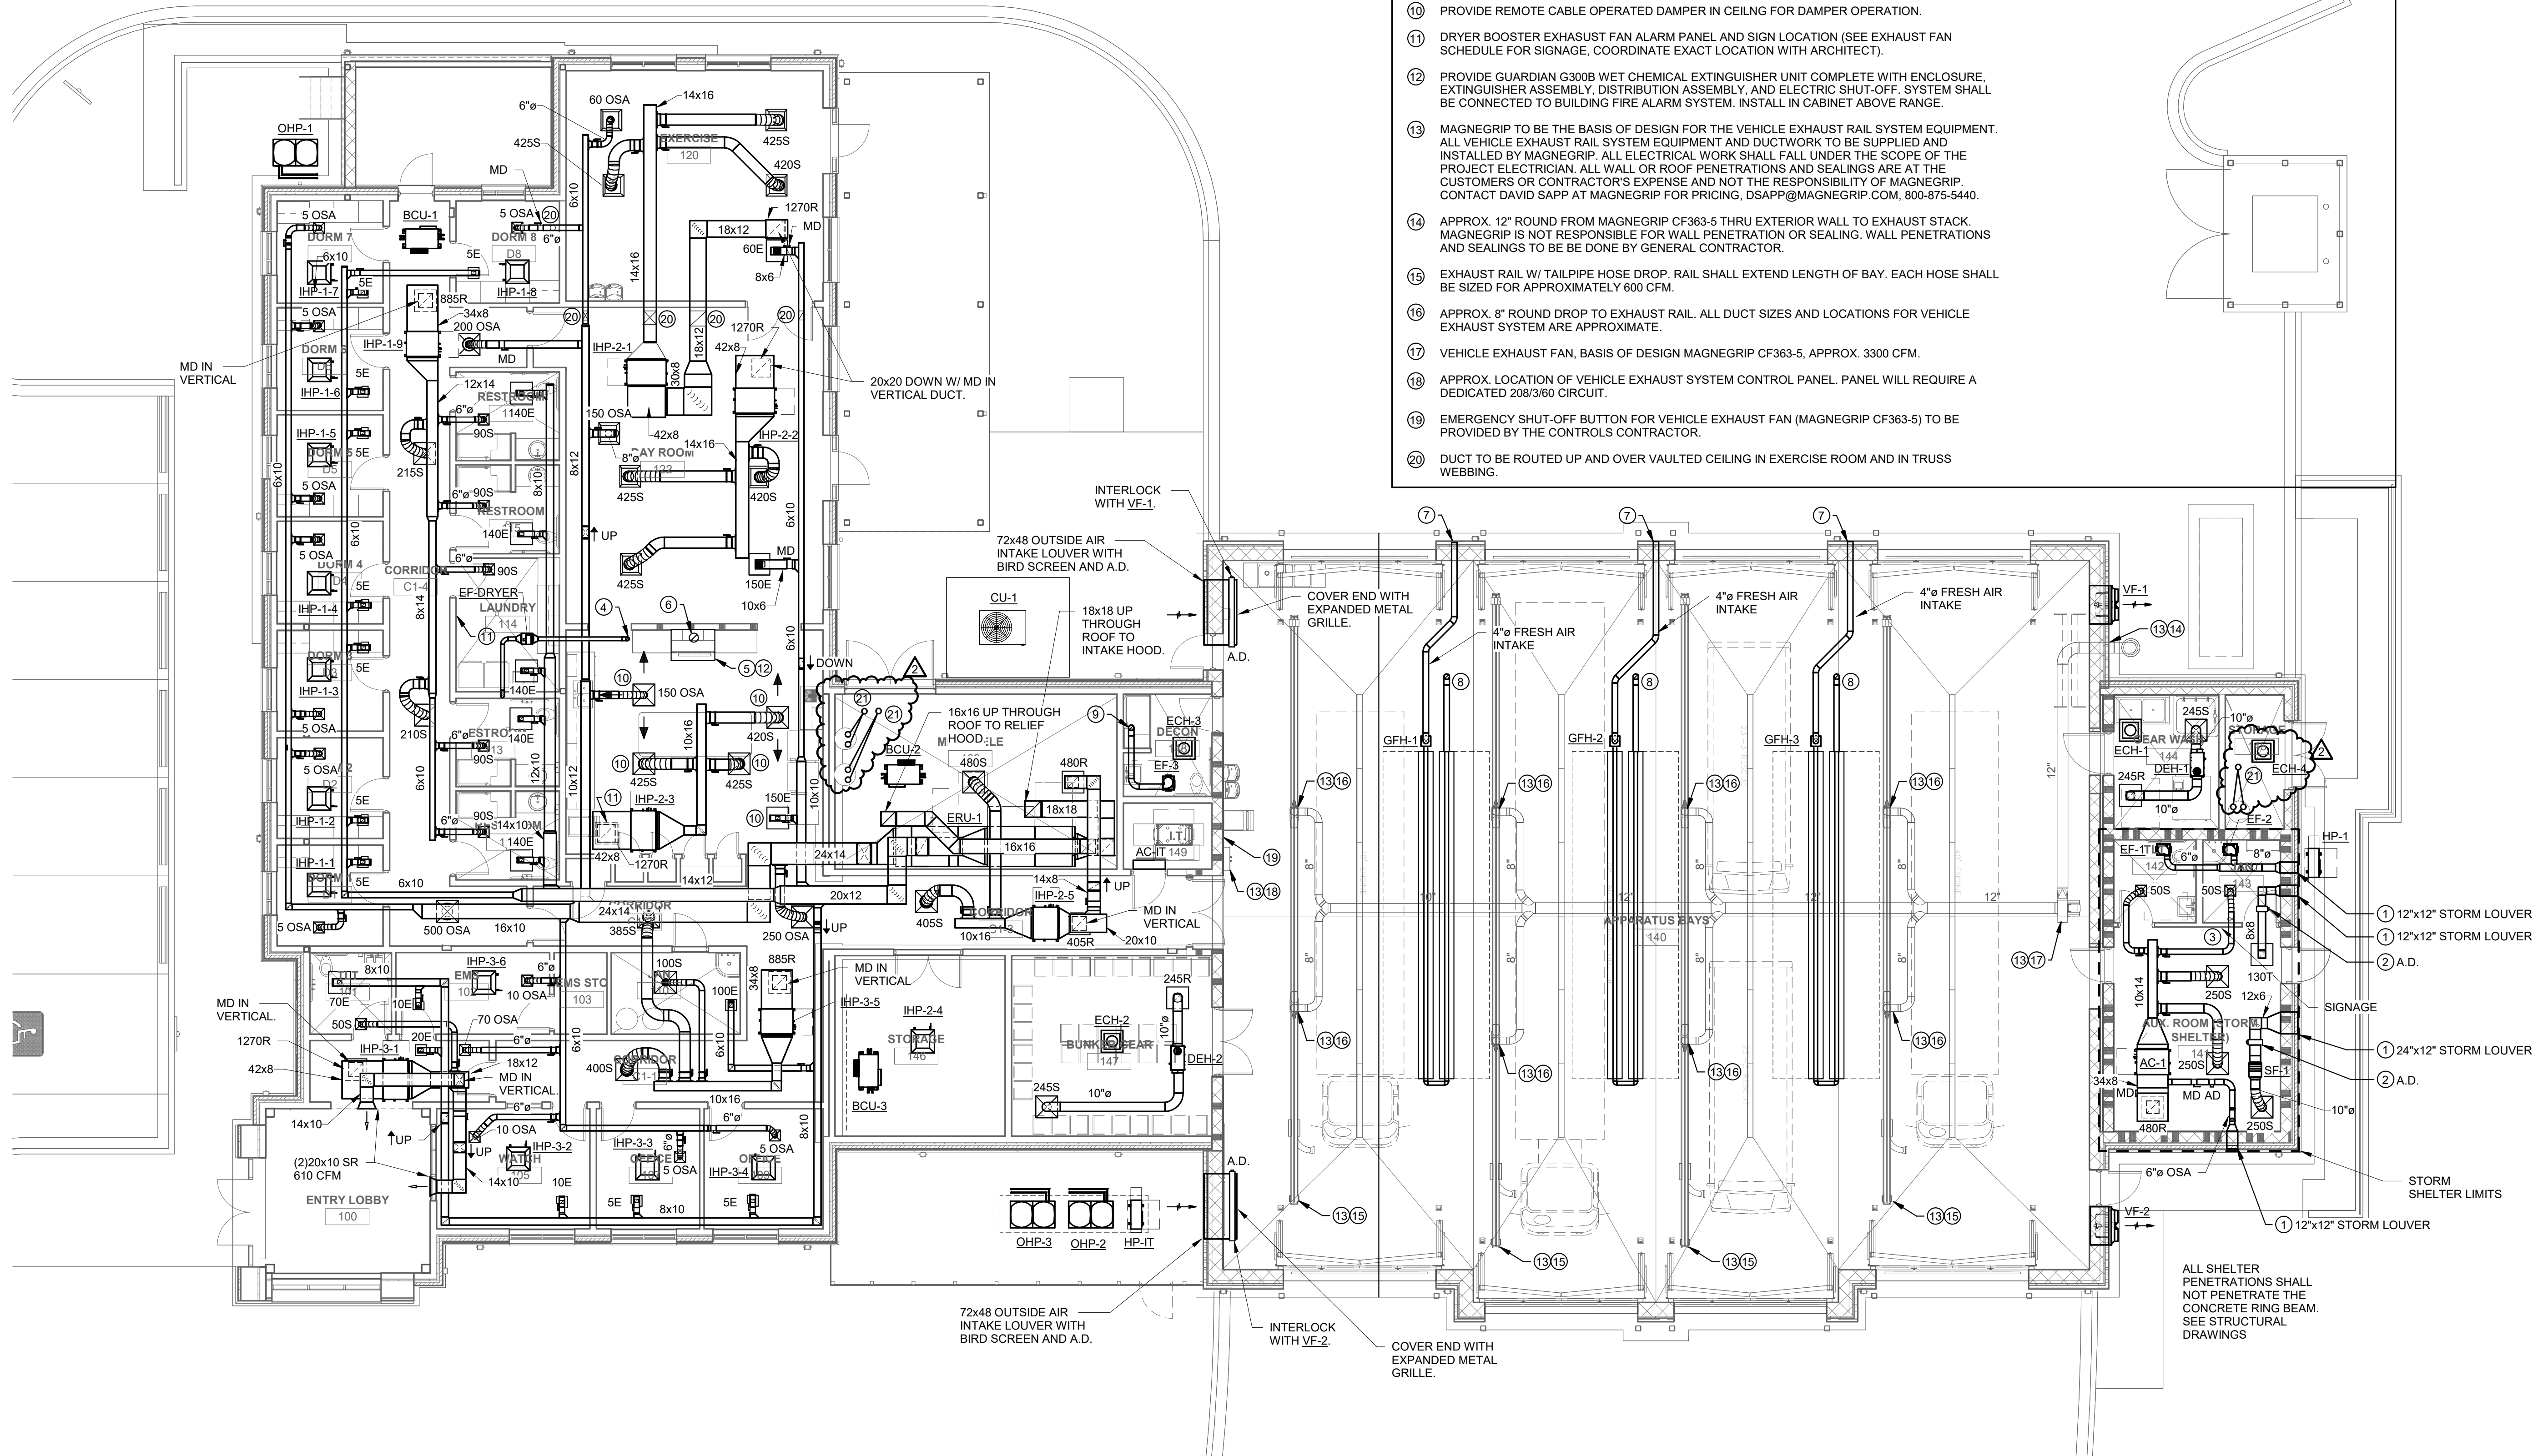

1 MECHANICAL - FLOOR PLAN  
 M1.1  
 1/8" = 1'-0"


Revisions		
No.	Date	Description
1	2/5/2025	Revision 1
2	2/21/2025	ADDENDUM 3

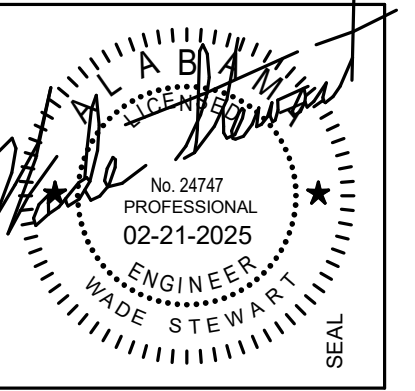

100% CDS

**IRONDALE FIRE STATION #3**  
 INT. OF JOHN ROGERS DRIVE & ALTON ROAD  
 Birmingham, Alabama  
 CITY OF IRONDALE

CHARLES WILLIAMS  
 & ASSOCIATES  
 ARCHITECTS  
**CWA**  
 3601 8TH AVE. SOUTH  
 BIRMINGHAM, ALABAMA 35222  
 PH: 205-250-0700  
 FAX: 205-250-0515

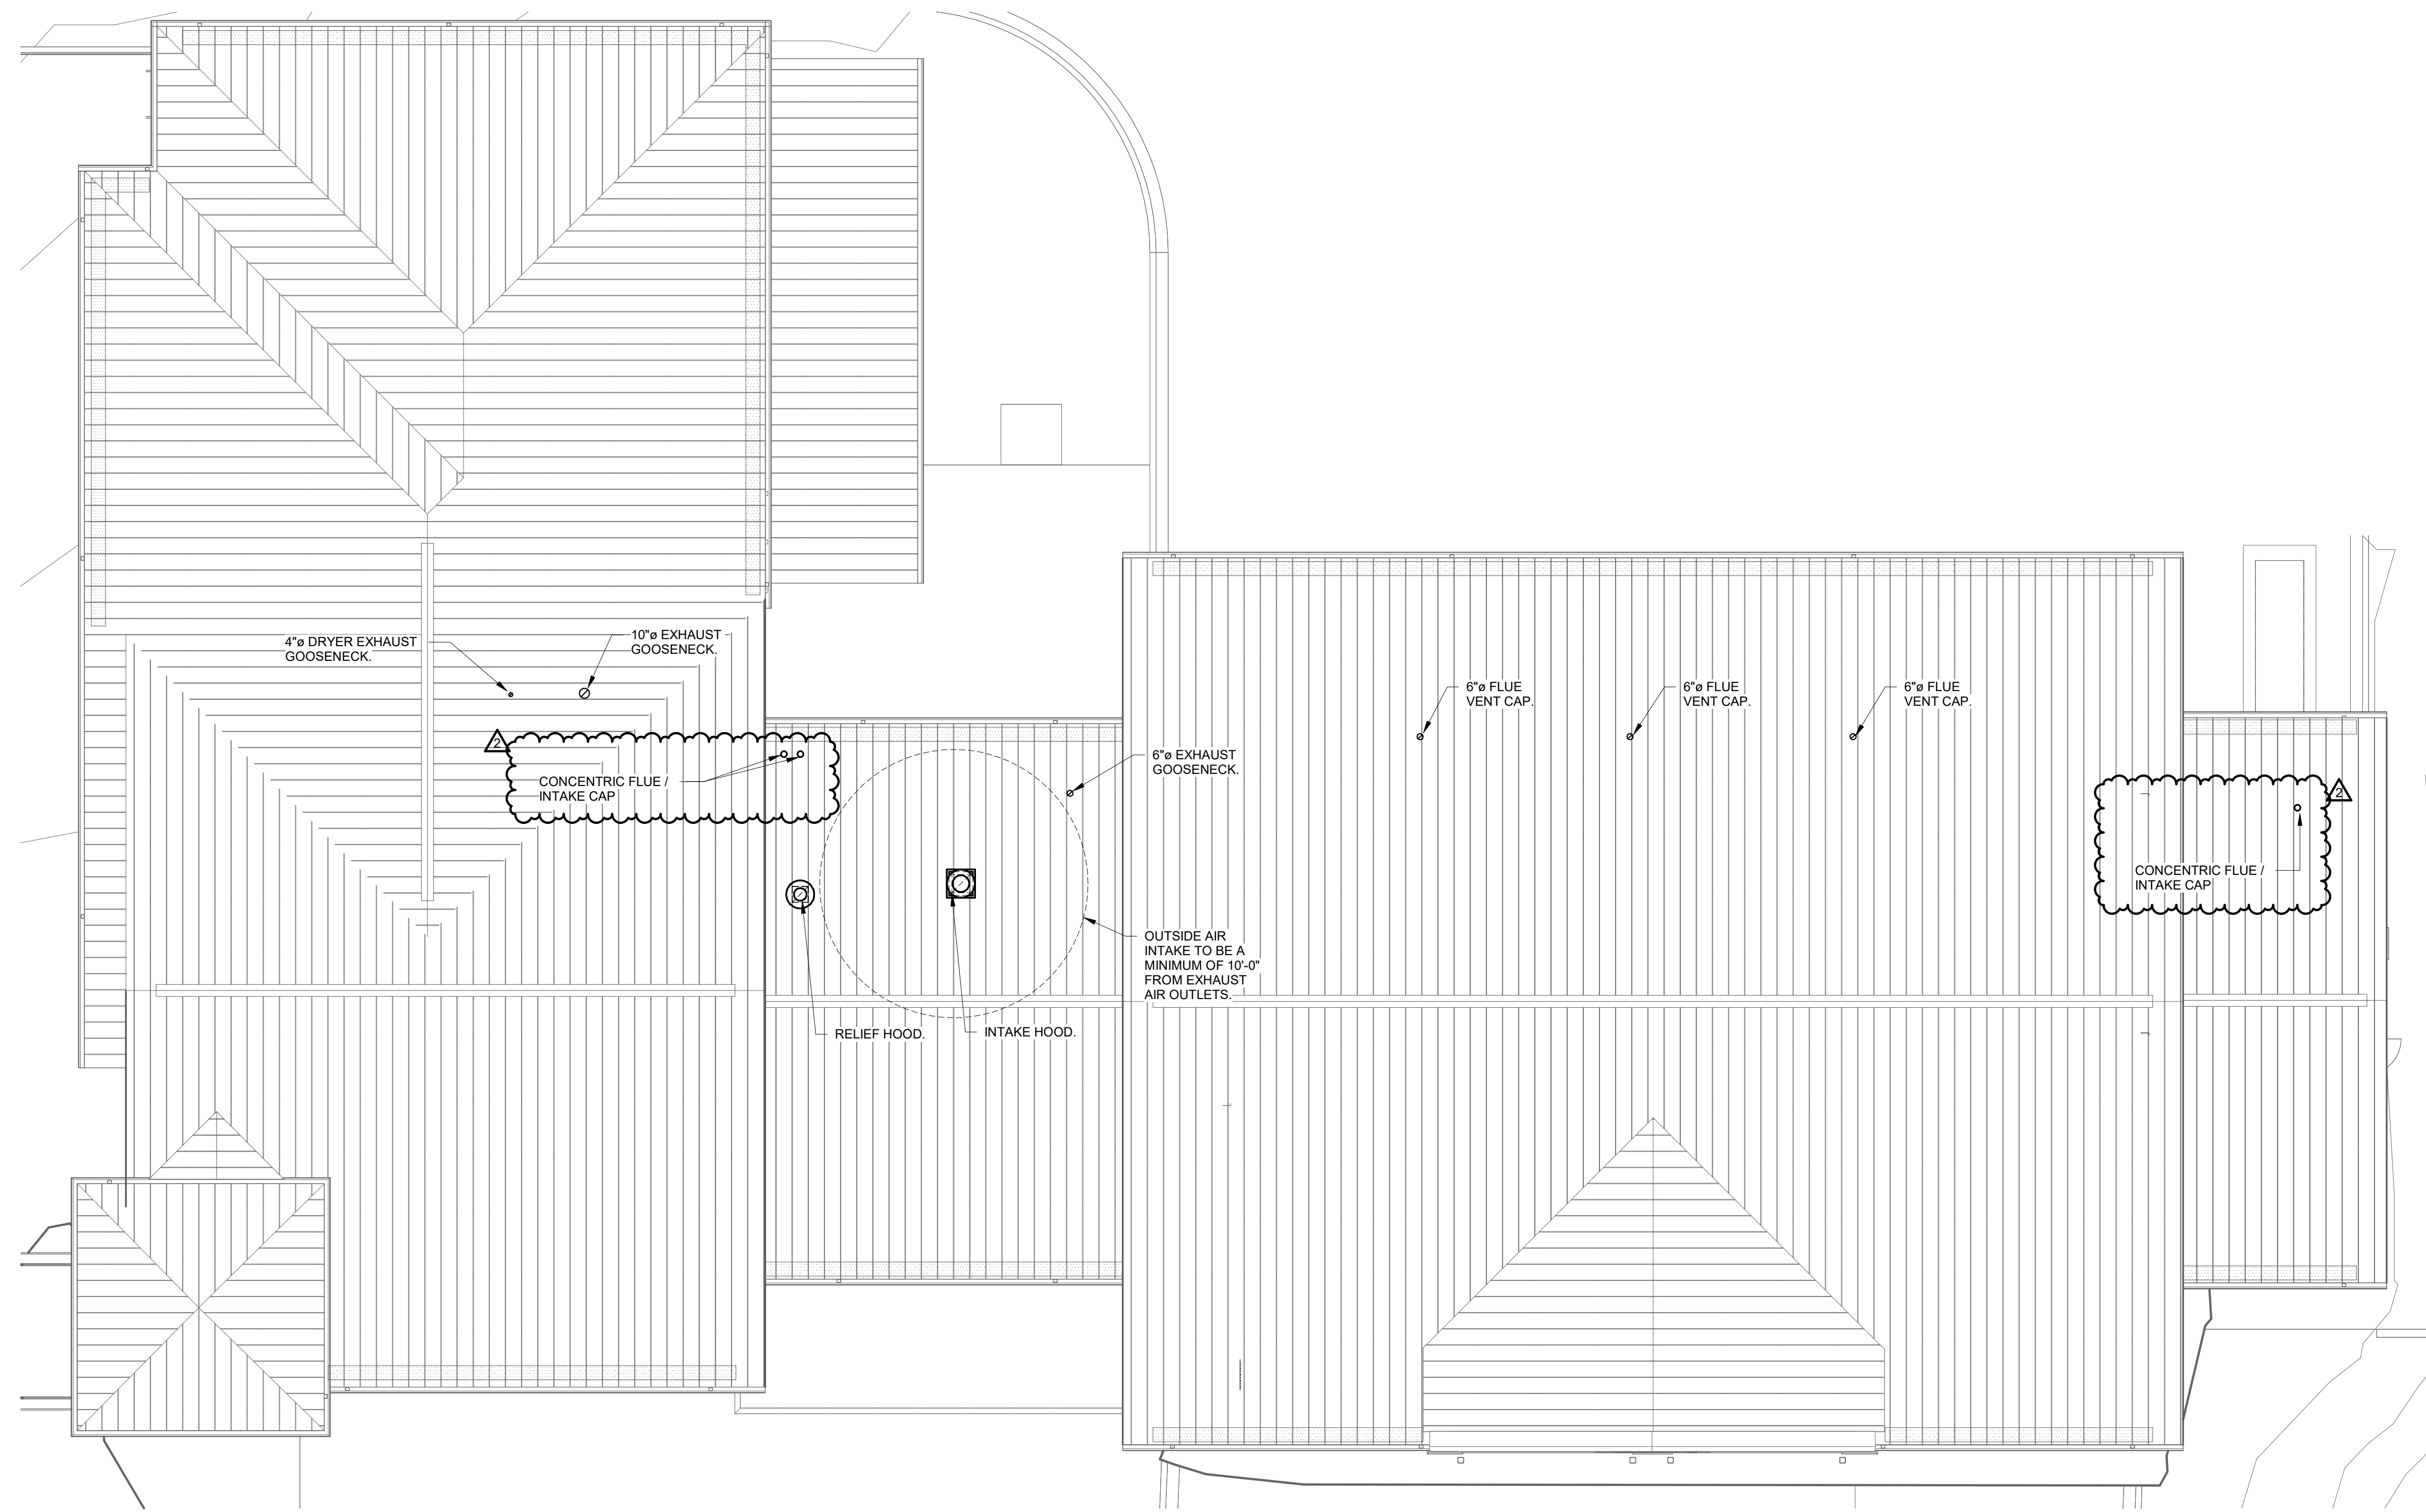

1 MECHANICAL - ROOF PLAN  
 M1.2 1/8" = 1'-0"

SHEET TITLE: <b>MECHANICAL ROOF PLAN</b>	
PROJECT NUMBER: <b>CWA No. 2023-01</b>	
DATE: <b>08.30.24</b>	
DRAWN BY: <b>LWH</b>	CHECKED BY: <b>JWS</b>

SHEET NUMBER  
**M1.2**




**GENERAL NOTES**

- LOCATIONS OF UTILITIES SHOWN ON PLANS ARE APPROXIMATE. VERIFY WITH LOCAL UTILITY PRIOR TO BIDDING.
- CONTRACTOR SHALL VERIFY EXACT LOCATION, SIZE, AND ELEVATION OF ALL EXISTING SERVICES PRIOR TO INSTALLING ANY NEW PIPE.
- ALL OUTSIDE CLEANOUTS SHALL BE BROUGHT TO GRADE AND EMBEDDED IN 18"x18"x16" THICK CONCRETE PAD. (J.R. SMITH 4258 OR EQUAL.)
- WHEREVER DISSIMILAR METALS ARE CONNECTED ON WATER LINES, A DIELECTRIC UNION SHALL BE USED.
- ALL HORIZONTAL WATER AND VENT PIPING SHALL BE RUN ABOVE CEILING ON PLAN WHERE SHOWN UNLESS OTHERWISE NOTED.
- ALL HORIZONTAL SANITARY PIPING IS RUN BELOW FLOOR ON PLAN WHERE SHOWN UNLESS OTHERWISE NOTED.
- ALL WATER PIPING BELOW SLAB ON GRADE SHALL BE BENT UP AT ENDS SO THAT NO JOINTS OCCUR BELOW FLOOR.
- ALL WATER PIPING INSTALLED IN EXTERIOR WALLS SHALL BE LOCATED ON THE INTERIOR SIDE OF THE EXTERIOR WALL INSULATION.
- NO VENT THRU ROOF IS TO BE LOCATED WITHIN 10 FEET OF ANY BUILDING AIR INTAKES, PER CODE. COORDINATE WITH MECHANICAL AND GENERAL CONTRACTORS.
- DOMESTIC WATER PIPING AND FIRE PROTECTION PIPING LOCATED ABOVE THE CEILING, SHALL BE INSTALLED BELOW CEILING INSULATION.
- CONTRACTOR SHALL COORDINATE ALL SINKS WITH CASEWORK PRIOR TO ORDERING SINKS.
- PROVIDE DISINFECTION OF WATER PIPING SYSTEM WITH CHLORINE SOLUTION AS PER CODE.
- INSTALLATION OF BACKFLOW PREVENTER SHALL COMPLY WITH CURRENT INTERNATIONAL BUILDING CODE AND CURRENT INTERNATIONAL PLUMBING CODE.
- ALL OVERHEAD WATER PIPING TO BE RUN BELOW INSULATION AT BOTTOM OF TRUSSES FOR FREEZE PROTECTION.
- INSULATION ON ALL PIPING SHALL MEET SMOKE/FLAME RATING OF 25 & 50.
- NO JOINTS IN WATER PIPING BELOW SLAB.
- THE LOCATION OF LAVATORIES AND WATER CLOSETS RELATIVE TO THE FINISHED WALL IS CRITICAL. REFER TO ARCHITECTURAL AND THE SPECIFICATIONS FOR ADDITIONAL INFORMATION. ALL WATER CLOSETS TO BE 18" FROM FINISH WALL TO CENTER OF WATER CLOSET.
- WATER HAMMER ARRESTORS ARE REQUIRED TO PROTECT WATER PIPING SYSTEMS WHERE QUICK-CLOSING VALVES ARE UTILIZED. WATER HAMMER ARRESTORS SHALL CONFORM TO ASSE 1010.
- THESE DRAWINGS NOT INTENDED TO SHOW ALL POSSIBLE CONDITIONS. IT IS INTENDED THAT A COMPLETE PLUMBING SYSTEM BE PROVIDED WITH ALL NECESSARY EQUIPMENT, APPURTENANCES AND CONTROLS, COMPLETELY COORDINATED WITH ALL DISCIPLINES. ALL PARAMETERS GIVEN IN THESE DOCUMENTS SHALL BE STRICTLY CONFORMED WITH ANY ITEMS AND LABOR REQUIRED FOR A COMPLETE PLUMBING SYSTEM IN ACCORDANCE WITH ALL APPLICABLE CODES, STANDARDS AND THESE CONTRACT DOCUMENTS SHALL BE FURNISHED WITHOUT INCURRING ANY ADDITIONAL COST TO THE PROJECT. CAREFULLY REVIEW ALL CONTRACT DOCUMENTS AND THE DESIGN OF OTHER TRADES BEFORE PREPARING SHOP DRAWINGS.
- COORDINATE PLUMBING PIPING WITH STRUCTURAL, PLUMBING, HVAC, AND ELECTRICAL. MAKE OFFSETS AND TRANSITIONS TO COORDINATE WITH OTHER TRADES WITHOUT ANY ADDITIONAL COST TO THE PROJECT.
- COORDINATE ALL PLUMBING IN SLAB WITH BUILDING FOOTINGS.
- NO PIPING TO BE RUN ABOVE ELECTRICAL PANELS. MAINTAIN ALL REQUIRED CLEARANCES.
- CONTRACTOR SHALL VISIT JOB SITE AND VERIFY EXISTING CONDITIONS BEFORE SUBMITTING A PRICE, ORDERING MATERIALS OR PERFORMING ANY WORK. NOTIFY THE ARCHITECT OF ANY DEVIATION FROM PLUMBING PLAN.
- SUPPORT PIPE AS REQUIRED BY THE CURRENT INTERNATIONAL PLUMBING CODE.
- FIRESTOP ALL RATED WALL AND FLOOR PENETRATIONS. SEE ARCHITECTURAL DRAWINGS FOR RATED WALL AND FLOOR LOCATIONS.
- OFFSET ALL VTR'S TO BACKSIDE OF ROOF RIDGE.
- DO NOT BEGIN WORK UNTIL ELEVATION OF FINAL CONNECTION POINT IS VERIFIED AND GRADING OF ENTIRE SYSTEM CAN BE DETERMINED (EVEN IF FINAL CONNECTION IS SPECIFIED UNDER ANOTHER SECTION).


**PLUMBING LEGEND**

---	DOMESTIC COLD WATER	BFF	BELOW FINISHED FLOOR
---	DOMESTIC HOT WATER SUPPLY	☐	CAP ON END OF PIPE
---	DOMESTIC HOT WATER RETURN	TYP	TYPICAL
---	SOIL, WASTE, OR SANITARY SEWER	CO	CLEANOUT
---	VENT	FD	FLOOR DRAIN
A	COMPRESSED AIR	DN	DOWN
G	NATURAL GAS	P-#	PLUMBING FIXTURE
S	STORM PIPING	VSTR	VENT STACK
OIL	OIL WASTE PIPING	VSTR	VENT THROUGH ROOF
PI	PARTICLE INTERCEPTOR PIPING	⊕	BALL VALVE
⊕	PIPE TURNING DOWN	MFD	MECHANICAL FLOOR DRAIN
⊕	PIPE TURNING UP	WS	WASTE STACK
⊕	TEE DOWN	HWR	HOT WATER RETURN
⊕	TEE UP	HW	HOT WATER
CW	COLD WATER	ABV	ABOVE
WH-#	WATER HEATER	AFF	ABOVE FINISHED FLOOR
PI	PARTICLE INTERCEPTOR PIPING		

COMPRESSED AIR SPECIFICATION:  
COMPRESSED AIR PIPING SYSTEM TO BE TRANSAIR, ALUMINUM PIPE, FITTINGS AND VALVES. SUPPORT IN ACCORDANCE WITH MANUFACTURER'S REQUIREMENTS. PIPING SYSTEM TO BE DRAINED DOWN TO LOWPOINTS - REFERENCE DESIGN.

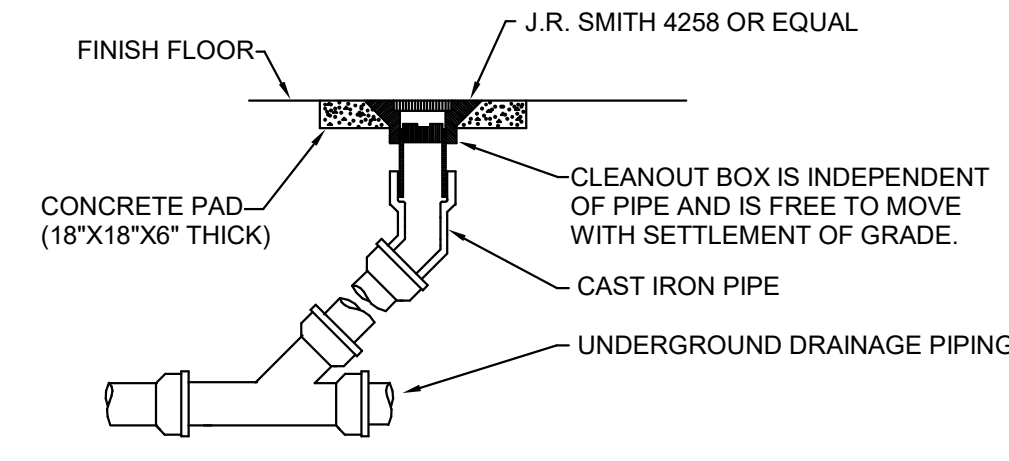


**DETAIL OF CLEANOUT TO GRADE**  
NO SCALE

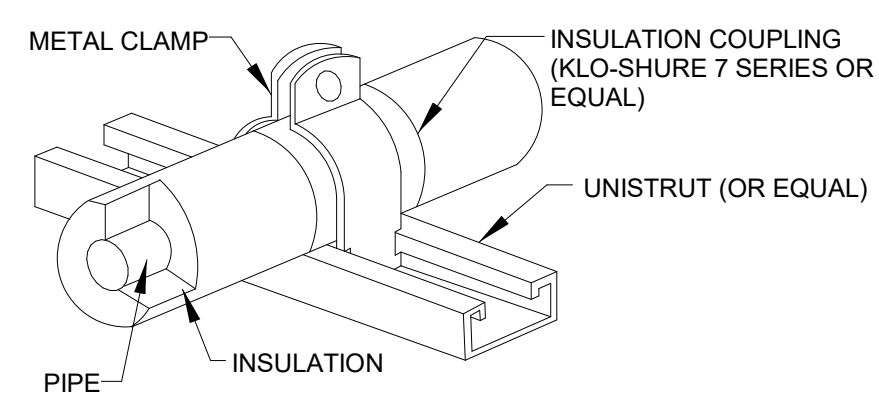


- NOTES:**
- APPLICATION: FOR STRUT MOUNTED, 4 INCH AND SMALLER, COFFEE PIPE WITH FOAMED PLASTIC (ARMAFLEX) OR FIBERGLASS INSULATION.
  - ALLOWED FOR HORIZONTAL OR VERTICAL INSTALLATION.
  - FOR COLD PIPE APPLICATION, APPLY ADHESIVE TO END OF FOAMED PLASTIC INSULATION PRIOR TO INSERTING INTO COUPLING.

**STRUT-MOUNTED PIPING SUPPORT INSULATION COUPLING DETAIL**

NO SCALE

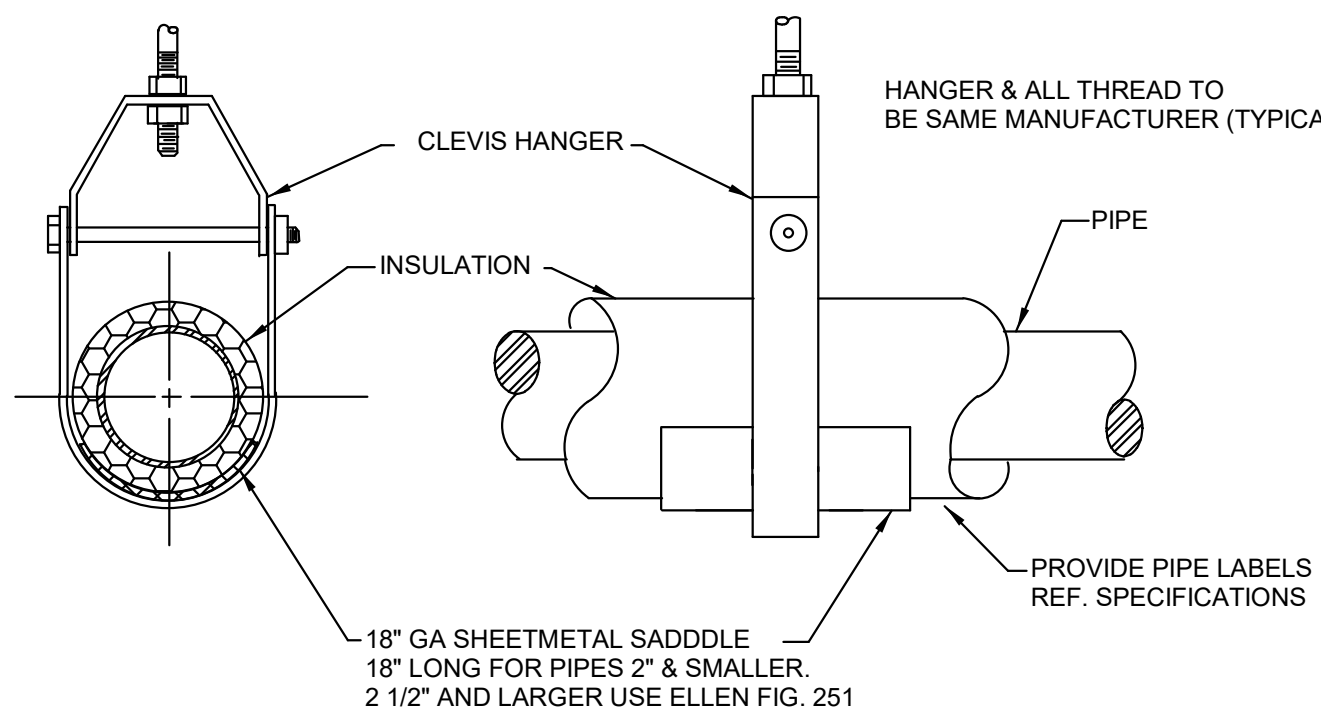

**SUSPENDED PIPE SUPPORT**  
NO SCALE

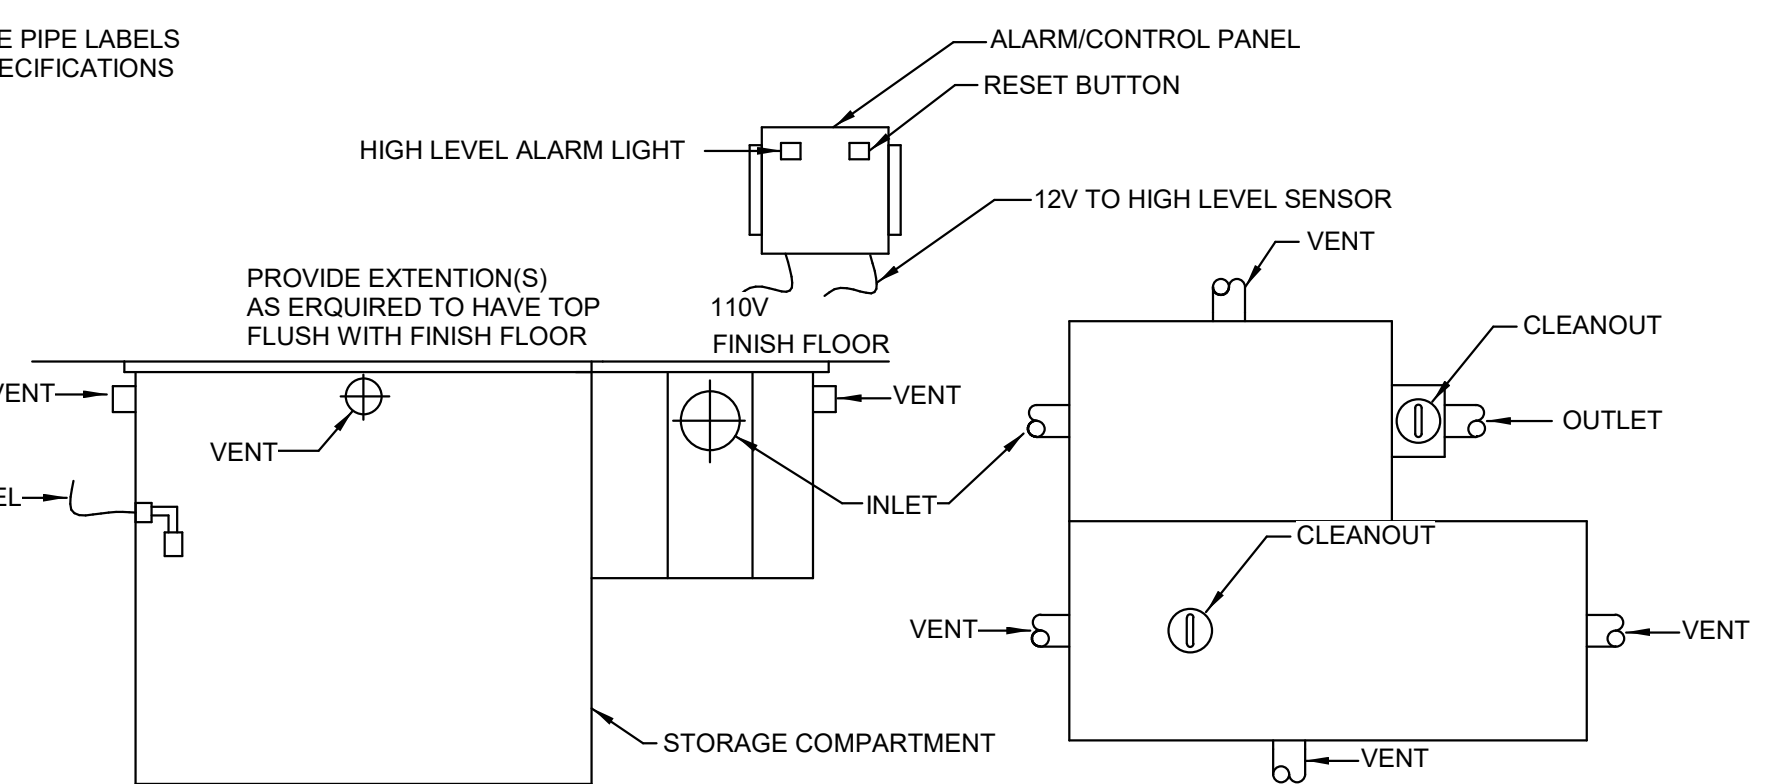

**DETAIL OF OIL/WATER SEPARATOR**  
NO SCALE

**PLUMBING FIXTURE SCHEDULE**

MARK	FIXTURE	WASTE	CW	HW	REMARKS
AC-1	AIR COMPRESSOR				INGERSOLL RAND PREMIUM SIMPLEX PACKAGE 2475 BARE, 80-GAL. TANK, 175 PSIG, AS&S, 5 HP RECIP COMPRESSOR. PROVIDE WITH DRYER, POLYSEP PSG-7 OIL WATER SEPARATOR, FA75IG GENERAL PURPOSE FILTER AND FA75IH HIGH EFFICIENCY FILTER WITH AUTODRAIN. COORDINATE WITH ELECTRICAL. UNIT SHALL BE 208/3.
CB	DRAIN BOX	2"	-	-	PROVIDE A SIOUX CHIEF MODEL #696-3F DRAIN BOX, #696-LC LOUVERED COVER, #696-CF SECONDARY DRAINAGE FUNNEL, AND J.R. SMITH TRAP SEAL INSERT. BOX TO COME COMPLETE WITH WALL FLANGE AND LOUVER. PIPE INDIRECT IN WALL TO DRAIN BOX. COORDINATE EXACT LOCATION WITH ARCHITECT AND GC.
FD	FLOOR DRAIN	3"	-	-	J.R. SMITH #2010 WITH 6" ROUND NICKEL BRONZE GRATE. PROVIDE WITH J.R. SMITH TRAP INSERT.
FS-1	FLOOR SINK	4"	-	-	J.R. SMITH #3100, 8" SQUARE, PORCELAIN ENAMELED CAST IRON INTERIOR WITH 3/4 CAST IRON PORCELAIN ENAMELED GRATE AND DOME BOTTOM STRAINERS. PROVIDE WITH J.R. SMITH TRAP INSERT.
FS-2	FLOOR SINK	4"	-	-	J.R. SMITH #3200, 16" SQUARE, PORCELAIN ENAMELED CAST IRON INTERIOR WITH 3/4 CAST IRON PORCELAIN ENAMELED GRATE AND DOME BOTTOM STRAINERS. PROVIDE WITH J.R. SMITH TRAP INSERT.
GT-1	GREASE TRAP	4"	-	-	ZURN GMC-OMC-SMC50-300
HB	HOSE BIBB	-	3/4"	-	WOODFORD B-24 SERIES, ANTI-SIPHON VACUUM BREAKER CLOSE COUPLED, POLISHED CHROME. INSTALL PER MANUFACTURER'S RECOMMENDATIONS. SUPPORT PIPING AND HOSE BIBB WITH UNI-STRUT MOUNTED TO THE STRUCTURE.
HR-A	HOSE REEL - AIR	-	-	-	REELCRAFT MODEL #7850 OLP COMPLETE WITH 50 FEET OF HOSE, MAXIMUM OPERATING PRESSURE OF 300 PSI. INSTALL PER MANUFACTURER'S INSTRUCTIONS. COORDINATE LOCATION AND MOUNTING HEIGHT WITH GENERAL CONTRACTOR.
HR-W	HOSE REEL - WATER	-	2"	-	CROKER 5000 SERIES ANGLE HOSE VALVE. VALVE SHALL BE COMPATIBLE WITH OWNERS EQUIPMENT.
MFD	MECHANICAL FLOOR DRAIN	4"	-	-	J.R. SMITH #2242 WITH SEDIMENT BUCKET. PROVIDE WITH J.R. SMITH TRAP INSERT.
OS-1	OIL/WATER SEPARATOR	4"	2"	-	J.R. SMITH #6599-50-100 COMPLETE WITH ANCHOR FLANGE. INSTALLATION SHALL COMPLY WITH REQUIREMENTS OF AUTHORITY HAVING JURISDICTION. PROVIDE 12" EXTENSION IF REQUIRED FOR INSTALLATION. PROVIDE CLEAN-OUT ACCESS. PROVIDE HIGH LEVEL SENSOR AND CONTROL PANEL.
P-1	WATER CLOSET - ADA COMPLIANT	4"	1"	-	FLOOR MOUNTED - KOHLER K-96057-SS-0 COMPLETE SLOAN ROYAL #111 FLUSH VALVE WITH YJ BRACKET AND CHURCH "DURA GUARD" MODEL # 2155 SSC SEAT.
P-2	LAVATORY - ADA COMPLIANT	1 1/4"	1/2"	1/2"	WALL HUNG - KOHLER K-2032 (20" X 18") COMPLETE, SYMMONS S-20-0 FAUCET, K7715 OUTLET WITH TAILPIECE, J.R. SMITH #700-M31-2 FIXTURE SUPPORT, MCGUIRE #165 SUPPLIES WITH STOPS AND MCGUIRE #8872 P-TRAP. INSULATE P-TRAP, STOPS AND SUPPLIES WITH "PRO-WRAP" BY MCGUIRE. MOUNT WITH RIM MAXIMUM 34" AFF. PROVIDE LAWLER 570 THERMOSTATIC MIXING VALVE MOUNTED BELOW LAVATORY. RUN 100" F WATER TO FAUCET. MUST MEET A.D.A. GUIDELINES.
P-3	LAVATORY	1 1/4"	1/2"	1/2"	COUNTERTOP - KOHLER K-2196-4 COMPLETE, SYMMONS S-20-0 FAUCET, MCGUIRE #8872 P-TRAP, MCGUIRE 165 SUPPLIES WITH STOPS. INSULATE ALL WITH "PRO-WRAP" BY MCGUIRE.
P-4	SHOWER VALVE AND SHOWER- ADA COMPLIANT	-	1/2"	1/2"	SHOWER BASE, WALLS, GRAB BARS, AND SEAT. PROVIDE INPCO 30" X30" BASE WITH FRONT TRENCH. PROVIDE SOLID SURFACE WALL PACKAGE COMPLETE WITH TRIM COMPLETE WITH TWO 30" GRAB BARS AND FOLDING BENCH SEAT. PROVIDE WOOD BACKING IN WALL FOR SEAT AND GRAB BAR SUPPORT. SHOWER CONTROLS SHALL BE ZURN MODEL C-96-500-B30-V-X, COLOR SELECTION OF UNIT AND WALLS BY ARCHITECT.
P-5	DOUBLE BOWL UTILITY SINK	1 1/2"	1/2"	1/2"	PROVIDE ELKAY SS82422, 2 BOWL UTILITY SINK WITH LK BASKET STRAINERS COMPLETE WITH T AND S MPOWL-08-CR MINI-PRIME FAUCET. PROVIDE MCGUIRE 165 SUPPLIES WITH STOPS, MCGUIRE #812 P-TRAP, WITH CONTINUOUS WASTE AND TAILPIECE.
P-6	WASHING MACHINE BOX (COMMERCIAL)	1 1/2"	1/2"	1/2"	FURNISH AND SET IN PLACE UNDER ANOTHER SECTION, ROUGH AND CONNECT COMPLETE. PROVIDE BALL VALVE CUT OFF ON HOT AND COLD WATER SUPPLY INSTALL ABOVE CEILING A LINE SIZE RP2BP WITH STRAINER ON INLET SIDE OF BACKFLOW PREVENTER AND SHOCK ARRESTOR PDI SIZE "B" ON THE OUTLET SIDE. PIPE BACKFLOW PREVENTER WASTE THRU FACET. PROVIDE 1/2" TRENCH DRAIN.
P-7	STRETCHER HOSE DOWN	3"	1/2"	1/2"	STERN WILLIAMS CUSTOM, 48"X36" RECTANGULAR BASIN COMPLETE, T-35 HOSE WITH WALL HOOK, STAINLESS STEEL BACKSPLASH AND CHICAGO FAUCET #897 FAUCET.
P-8	WASHING MACHINE BOX (RESIDENTIAL)	1 1/2"	1/2"	1/2"	GUY GRAY #WB-207-1700 (24" X 24") COMPLETE, T-35 HOSE WITH WALL HOOK, STAINLESS STEEL BACKSPLASH AND CHICAGO FAUCET #897 FAUCET.
P-9	MOP SINK	3"	1/2"	1/2"	STERN WILLIAMS #58C-1700 (24" X 24") COMPLETE, T-35 HOSE WITH WALL HOOK, STAINLESS STEEL BACKSPLASH AND CHICAGO FAUCET #897 FAUCET.
P-10	WATER COOLER - ADA COMPLIANT	1 1/2"	1/2"	-	ELKAY #EZSTLWSSK B-LEVEL WATER COOLER WITH BOTTLE FILLER STATION. COMPLETE WITH STAINLESS STEEL CABINET AND WATERWAYS THAT ARE MANUFACTURED OF 100% LEAD FREE MATERIAL. J.R. SMITH #834 FIXTURE SUPPORT EBC T150 P-TRAP AND EBC L10 STOP WITH SUPPLY. FULLY INSULATE P-TRAP WITH EBC IK INSULATOR. INSTALL WITH LOWER SPOUT OUTLET MAXIMUM 36" AFF. MUST MEET A.D.A. INSTALL WITH BOTTLE FILLER. INSTALL COMPLETE. PROVIDE WITH ELKAY MODEL #LKAPREZL CANE APRON AS REQUIRED.
P-11	ICE MACHINE	-	1/2"	-	FURNISHED AND INSTALLED UNDER ANOTHER SECTION, ROUGH AND CONNECT COMPLETE. PROVIDE BALL VALVE STOP ON SUPPLY AND PIPE WASTE(S) TO FLOOR DRAIN. PROVIDE WATTS LFD ON COLD WATER SUPPLY IF REQUIRED BY LOCAL CODES. PIPE RELIEF FULL SIZE TO FS.
P-12	UTILITY SINK	1 1/2"	1/2"	1/2"	ADVANCE TABCO #4-41-36, K-1 FAUCET, K-5 DRAIN, MCGUIRE #8912 P-TRAP.
PT-1	PARTICLE INTERCEPTOR	4"	-	-	STRIEM PS-50-S.M. MEDIUM, SCREEN, CAST IRON LOCKABLE MANHOLE COVER.
SD	SHOWER DRAIN	2"	-	-	J.R. SMITH #2010 WITH 4" ROUND STRAINER. PROVIDE WITH J.R. SMITH TRAP INSERT.
TD-1	TRENCH DRAIN	4"	-	-	PROVIDE JR SMITH 9960-M HEAVY DUTY CLASS E TRENCH WITH DUCTILE IRON SLOTTED GRATE. TERMINATE TRENCH WITH CATCH BASIN.
TD-2	TRENCH DRAIN	4"	-	-	PROVIDE SLOTTED TRENCH AT ICEMAKER JR SMITH 9930 WITH GRATE. GRATE TO BE CUT FOR INDIRECT WASTE BELOW ICEMAKER.
WH	WALL HYDRANT	-	3/4"	-	J.R. SMITH #5509-QT, WITH INTEGRAL BACKFLOW PREVENTER, LATCHING COVER, FREEZE-PROOF AND OF PROPER LENGTH FOR WALL IN WHICH INSTALLED, ALL BRONZE BOX. VALVE SEAT MUST BE ON BUILDING SIDE OF EXTERIOR WALL INSULATION. INSTALL WITH CENTER LINE 24" ABOVE FINISH GRADE. PROVIDE OWNER WITH ONE (1) LOOSE KEY FOR EACH WALL HYDRANT.


**WATER HEATER SCHEDULE**

MARK	FIXTURE	GAS/ ELEC INFO.	MODEL	REMARKS
TWH-1	TANKLESS	208V, 1 PHASE	EEMAX MODEL AM007240T	PROVIDE WITH INTEGRAL ASSE 1070 MIXING VALVE. PROVIDES 68°F TEMP. RISE AT 0.5 GPM. MOUNT BELOW LAVATORY WHERE SHOWN ON DRAWINGS. PIPE TO HW INLET OF FAUCET.
WH-1	WATER HEATER	199 CFH	SWR200N	LOCHINVAR SWR200N, 90 GALLON STORAGE, 41 GALLON RECOVERY AT 100°F RISE. NEW P&T RELIEF VALVE. SET OUTLET TEMPERATURE AT 140°F. INSTALL AS DETAILED ON DRAWINGS. 199 CFH. VERIFY VOLTAGE WITH ELECTRICAL SECTION.
WH-2	WATER HEATER	199 CFH	SWR200N	LOCHINVAR SWR200N, 90 GALLON STORAGE, 41 GALLON RECOVERY AT 100°F RISE. NEW P&T RELIEF VALVE. SET OUTLET TEMPERATURE AT 140°F. INSTALL AS DETAILED ON DRAWINGS. 199 CFH. VERIFY VOLTAGE WITH ELECTRICAL SECTION.
WH-3	WATER HEATER	199 CFH	SWR200N	LOCHINVAR SWR200N, 90 GALLON STORAGE, 41 GALLON RECOVERY AT 100°F RISE. NEW P&T RELIEF VALVE. SET OUTLET TEMPERATURE AT 140°F. INSTALL AS DETAILED ON DRAWINGS. 199 CFH. VERIFY VOLTAGE WITH ELECTRICAL SECTION.


**GAS EQUIPMENT SCHEDULE**

EQUIPMENT NO.	DESCRIPTION	GAS PRESSURE REGULATOR		FLOW CFH	REMARKS
		INLET	OUTLET		
122	KITCHEN EQUIP, RANGE	2 PSI	7" WC	92	ROUGH AND CONNECT
GFH-1	HVAC EQUIPMENT	2 PSI	7" WC	150	ROUGH AND CONNECT
GFH-2	HVAC EQUIPMENT	2 PSI	7" WC	150	ROUGH AND CONNECT
GFH-3	HVAC EQUIPMENT	2 PSI	7" WC	150	ROUGH AND CONNECT
GENERATOR	HVAC EQUIPMENT	2 PSI	11" WC	2782	ROUGH AND CONNECT. 150 KW

SEE KITCHEN SCHEDULE FOR ADDITIONAL INFORMATION

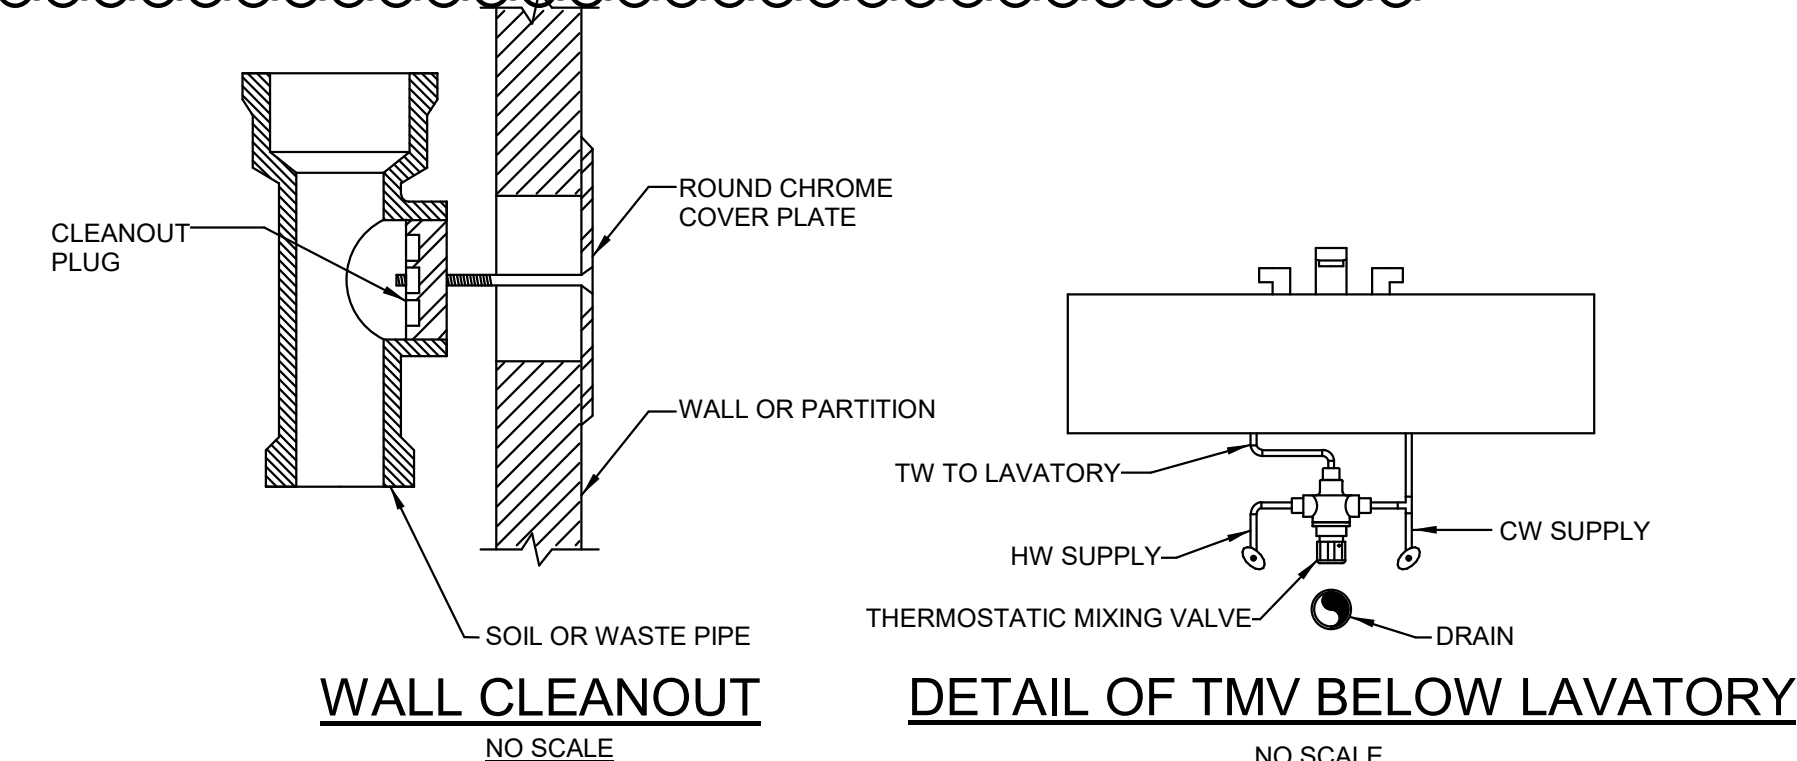

**WALL CLEANOUT** NO SCALE  
**DETAIL OF TMV BELOW LAVATORY** NO SCALE

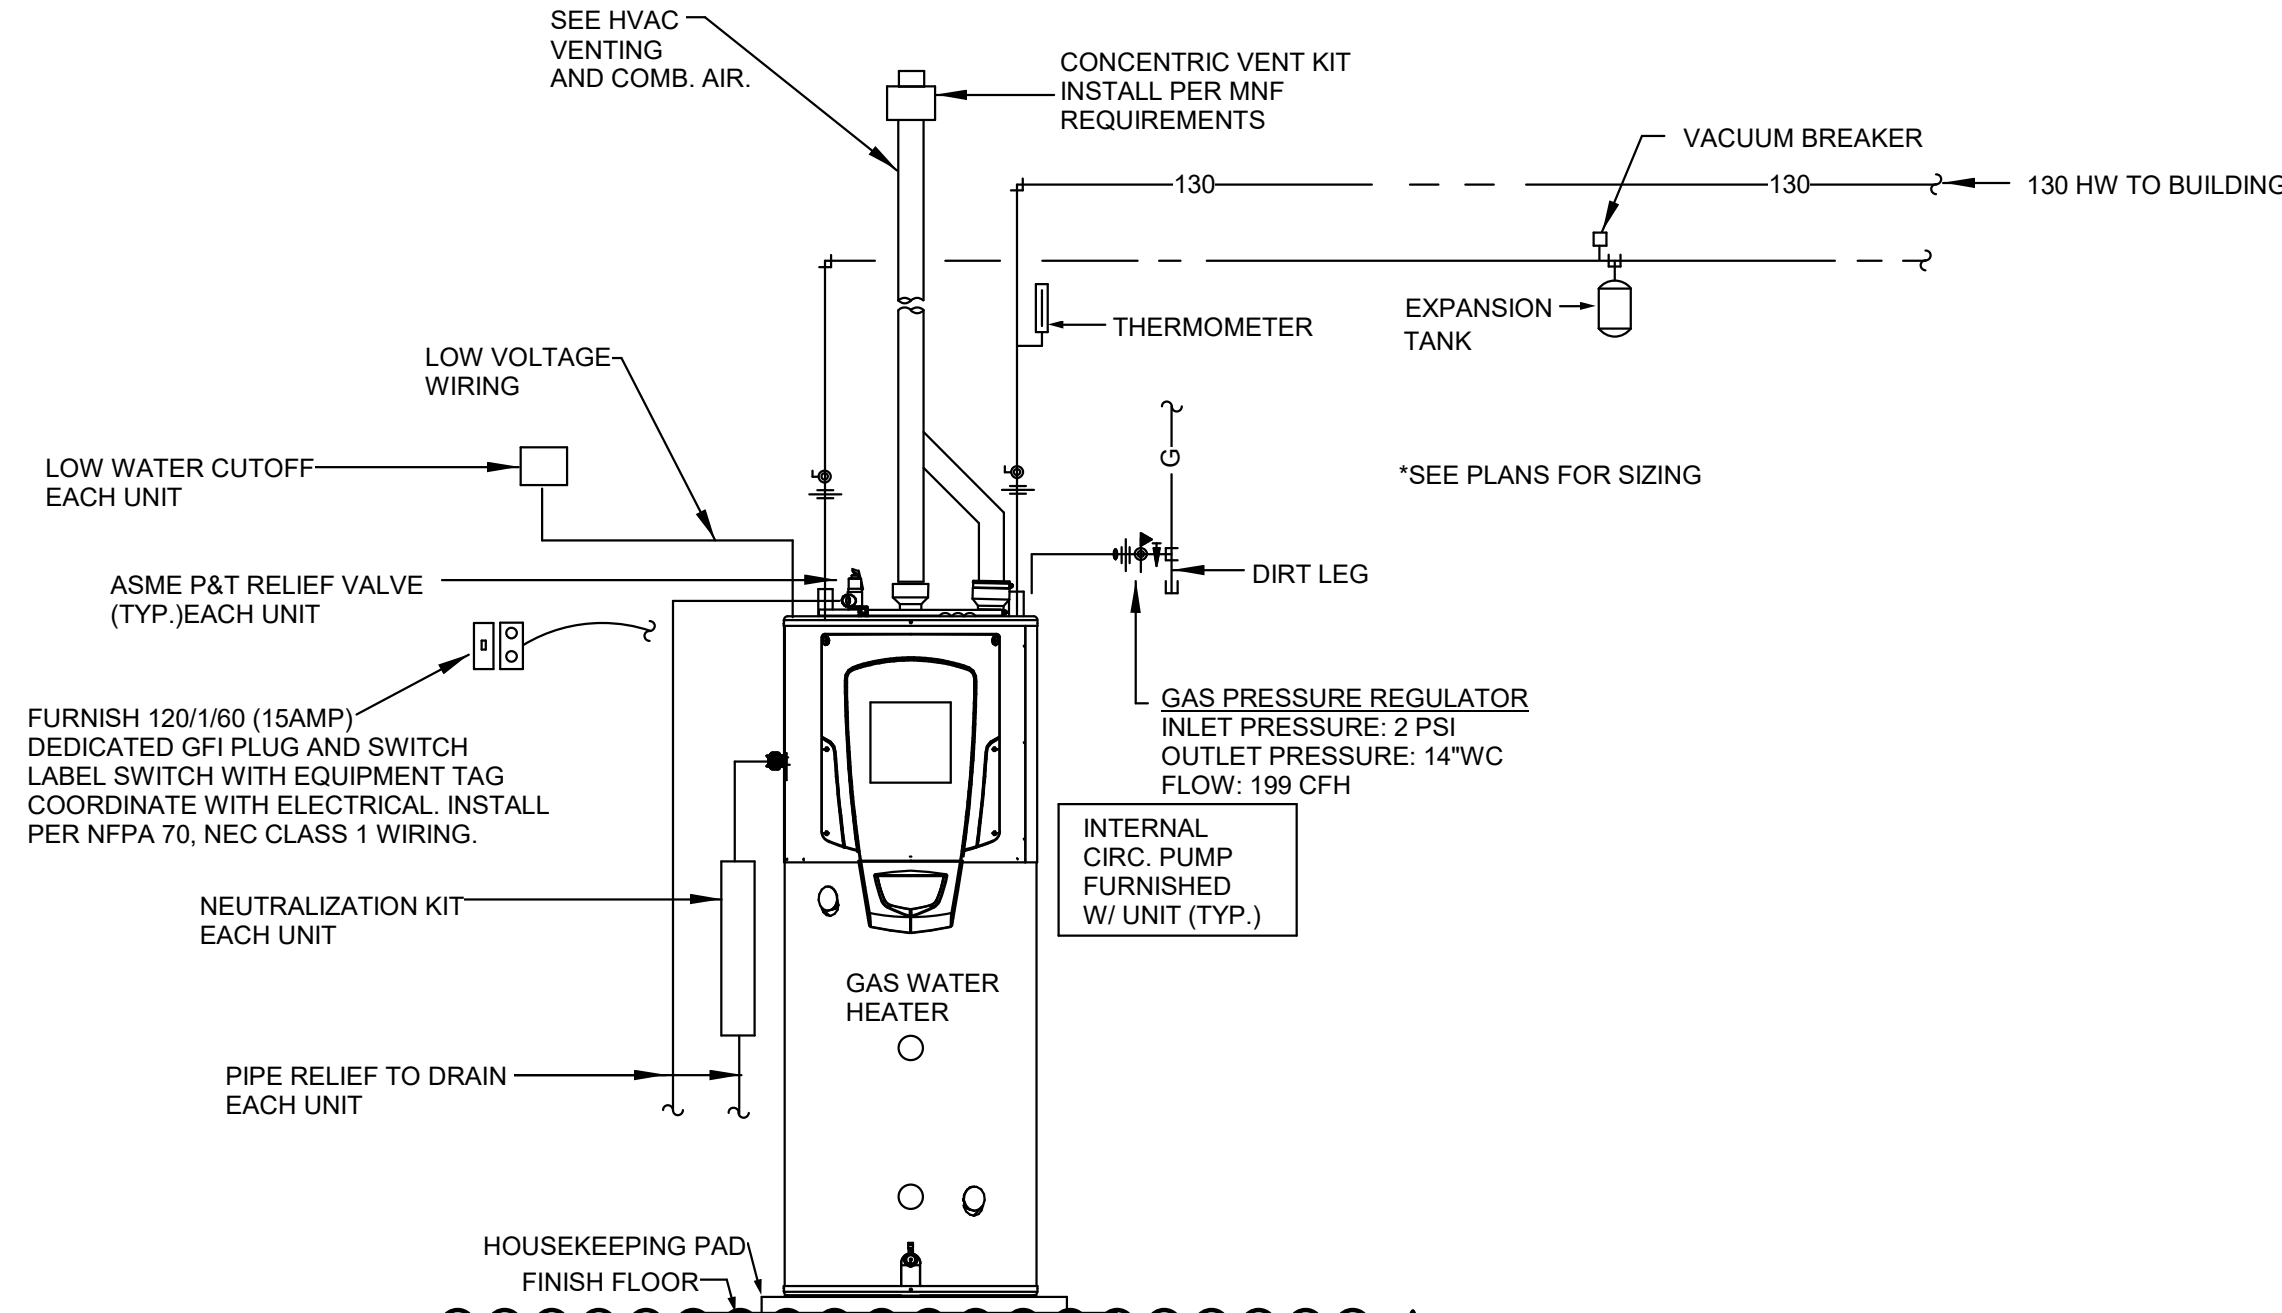


**DETAIL OF WATER HEATER - WH-3**  
NO SCALE

**Dewberry**  
2 Riverchase Office Plaza  
Suite 205  
Hoover, AL 35244  
(205) 988-2069  
www.dewberry.com  
Project Number :  
50171742

Revisions

No.	Date	Description
1	2/5/2025	Revision
2	2/21/2025	ADDENDUM 3

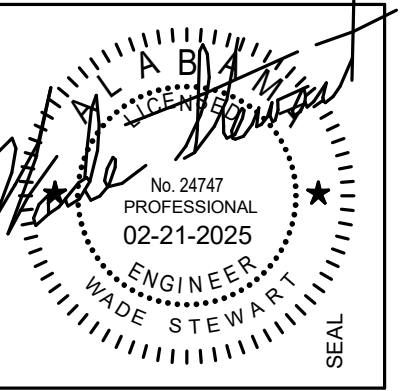

100% CDS

**IRONDALE FIRE STATION #3**  
INT. OF JOHN ROGERS DRIVE & ALTON ROAD  
Birmingham, Alabama  
CITY OF IRONDALE

CHARLES WILLIAMS & ASSOCIATES ARCHITECTS  
**CWA**  
3601 8TH AVE. SOUTH BIRMINGHAM, ALABAMA 35222  
PH: 205-250-0700  
FAX: 205-250-0515

SHEET TITLE:  
**PLUMBING SCHEDULES AND NOTES**

PROJECT NUMBER:  
**CWA No. 2023-01**


DATE:  
**08.30.24**

DRAWN BY: **JTR** CHECKED BY: **CLJ**

SHEET NUMBER  
**P0.1**




Revisions		
No.	Date	Description
1	2/5/2025	Revision 1
2	2/21/2025	ADDENDUM 3

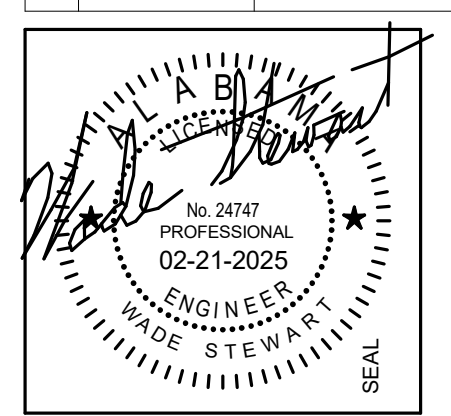


100% CDS


**IRONDALE FIRE STATION #3**  
 INT. OF JOHN ROGERS DRIVE & ALTON ROAD  
 Birmingham, Alabama  
 CITY OF IRONDALE

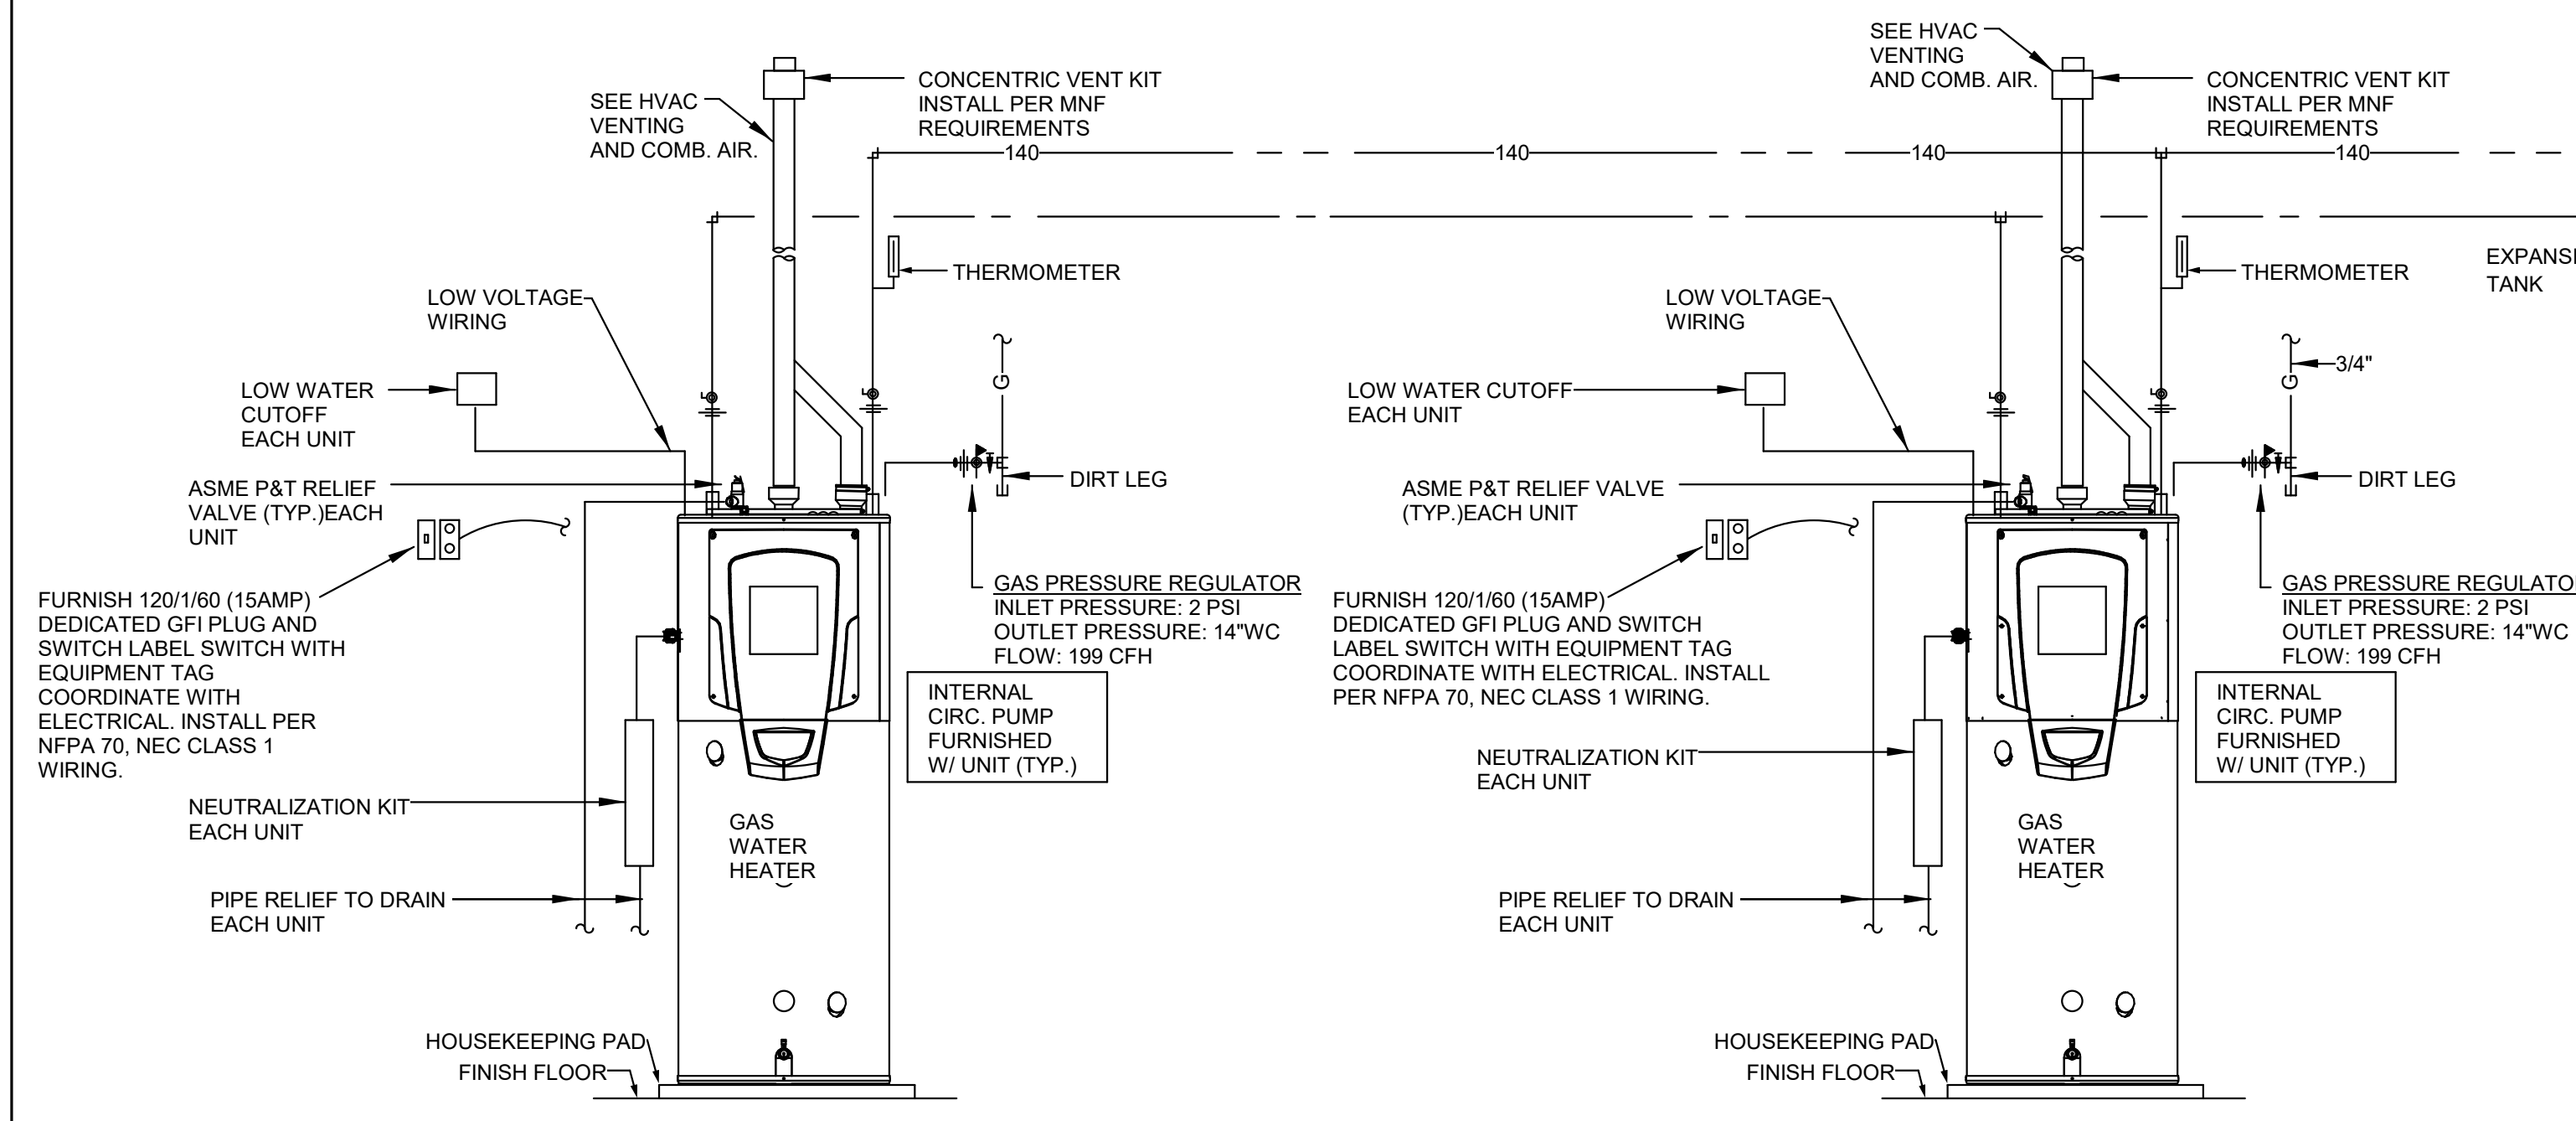


**DETAIL OF WATER HEATERS -WH-1 & 2**  
 NO SCALE

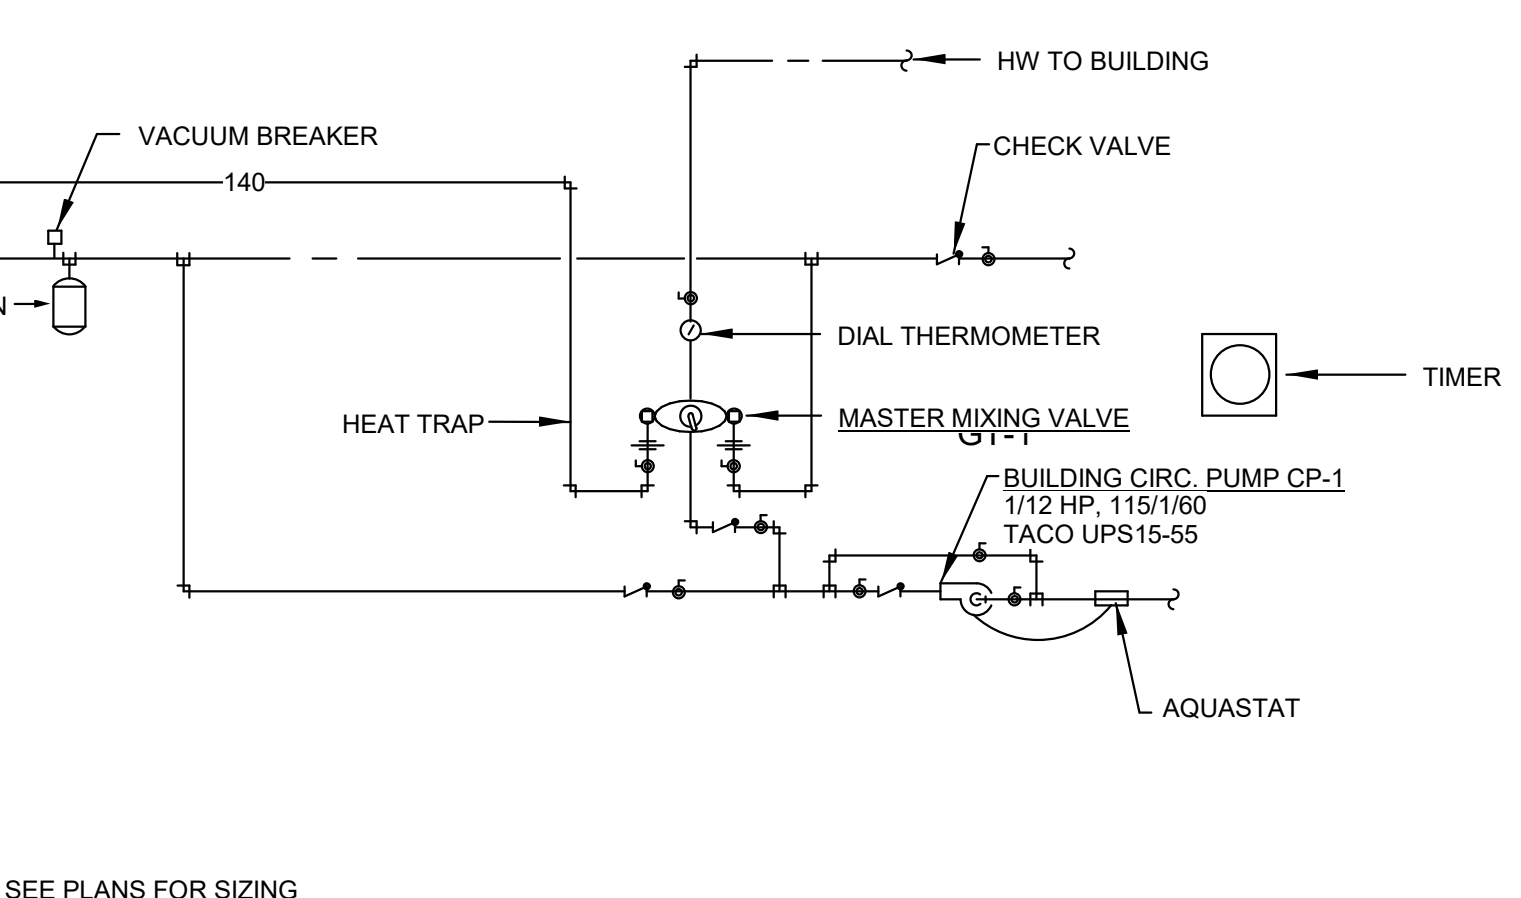

\* SEE PLANS FOR SIZING

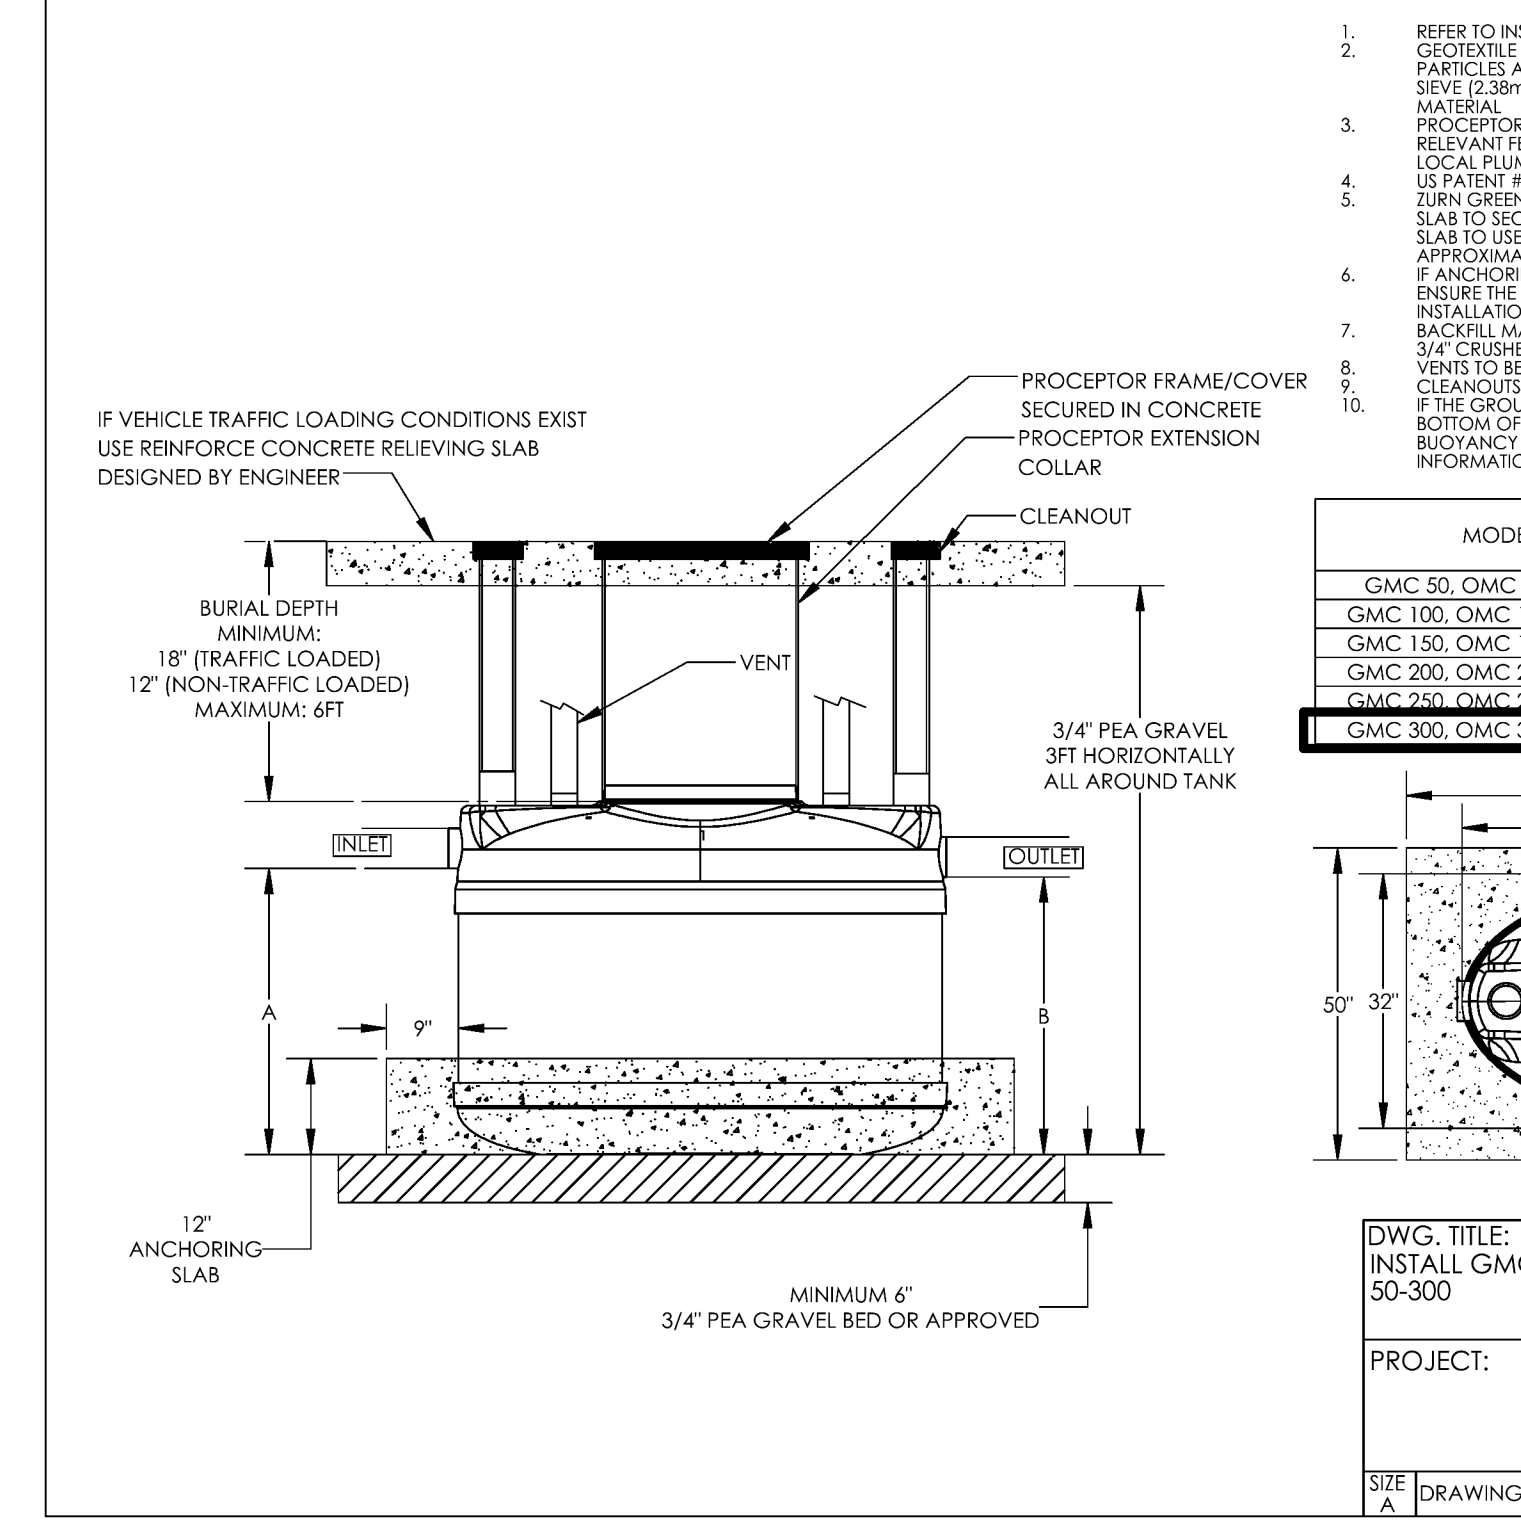

MODEL	VOLUME (US GALL)	INLET (A)	OUTLET (B)	WEIGHT (LBS)
GMC 50, OMC 50, SMC 50	50	12	11	130
GMC 100, OMC 100, SMC 100	100	20	19	150
GMC 150, OMC 150, SMC 150	150	33	32	175
GMC 200, OMC 200, SMC 200	200	36	35	205
GMC 250, OMC 250, SMC 250	250	44	43	230
GMC 300, OMC 300, SMC 300	300	59	51	255

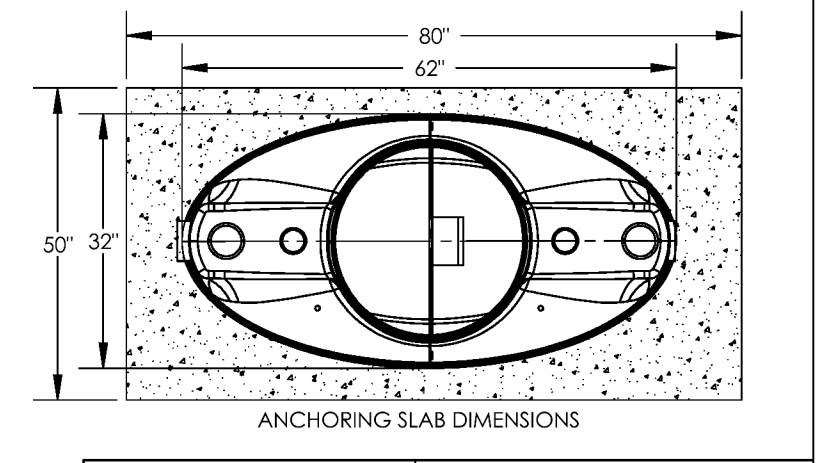

DWG. TITLE: INSTALL GMC-OMC-SMC  
 PROJECT: **Proceptor**  
**ZURN**  
 SITE A DRAWING NOT TO SCALE DWG #: 18-4716-S REV. 2

**SMITH JAY R. SMITH MFG. CO.**  
**9931-HDF SERIES ENVIRO-FLO® II EXTRA HEAVY DUTY DRAIN SYSTEM**

**REGULARLY FURNISHED:**  
 1 Meter (3.28') 100% Polypropylene U.V. Inhibitors Channel of Interlocking Design with a Built-in Slope of 0.6% with Radiused Bottom along with Black Painted Steel Frame System. Supplied with Secured Grate.

**EXTRA HEAVY RATED GRATING CLASS E**

**9931-HDF**

**SMITH JAY R. SMITH MFG. CO.**  
**9931-HDF SERIES ENVIRO-FLO® II EXTRA HEAVY DUTY DRAIN SYSTEM**

**HYDRAULIC CAPACITY AND DEEP END DEPTHS 9931 SYSTEM**

CHANNEL NUMBER	DEEP END DEPTH IN.	MM.	SLOPE	EST CFS	EST GPM	WEIGHT Lbs.
9931-1	5.50	140	0.6%	29	130	23.02
9931-1M	5.50	140	0.6%	29	130	23.02
9931-2	5.75	146	0.6%	31	139	23.12
9931-2M	5.75	146	0.6%	31	139	23.12
9931-3	6.00	152	0.6%	34	152	23.32
9931-3M	6.00	152	0.6%	34	152	23.32
9931-4	6.25	159	0.6%	36	162	23.42
9931-4M	6.25	159	0.6%	36	162	23.42
9931-5	6.50	165	0.6%	39	175	23.52
9931-5M	6.50	165	0.6%	39	175	23.52
9931-6	6.75	171	0.6%	42	189	23.72
9931-6M	6.75	171	0.6%	42	189	23.72
9931-7	7.00	178	0.6%	45	202	23.92
9931-7M	7.00	178	0.6%	45	202	23.92
9931-8	7.25	184	0.6%	47	211	24.32
9931-8M	7.25	184	0.6%	47	211	24.32
9931-9	7.50	191	0.6%	49	220	24.32
9931-9M	7.50	191	0.6%	49	220	24.32
9931-10	7.75	197	0.6%	53	238	24.32
9931-10M	7.75	197	0.6%	53	238	24.32
9931-11	8.00	203	0.6%	56	251	24.52
9931-11M	8.00	203	0.6%	56	251	24.52
9931-12	8.25	210	0.6%	58	261	24.52
9931-12M	8.25	210	0.6%	58	261	24.52
9931-13	8.50	216	0.6%	61	274	24.92
9931-13M	8.50	216	0.6%	61	274	24.92
9931-14	8.75	222	0.6%	64	287	24.92
9931-14M	8.75	222	0.6%	64	287	24.92
9931-15	9.00	229	0.6%	67	301	25.12
9931-15M	9.00	229	0.6%	67	301	25.12
9931-16N	9.25	235	0.6%	70	314	25.32
9931-16M	9.25	235	0.6%	70	314	25.32
9931-17	9.50	241	0.6%	73	328	25.32
9931-17M	9.50	241	0.6%	73	328	25.32
9931-18	9.75	248	0.6%	76	341	25.52
9931-18M	9.75	248	0.6%	76	341	25.52
9931-19	10.00	254	0.6%	79	355	25.72
9931-19M	10.00	254	0.6%	79	355	25.72
9931-20	10.25	260	0.6%	82	368	25.92
9931-20M	10.25	260	0.6%	82	368	25.92

**9931-HDF-BS**

**Lochinvar SHIELD™ WATER HEATER**  
 HIGH EFFICIENCY BOILERS & WATER HEATERS  
 Submittal Sheet SWH-Sub-08

**SHIELD™ COMMERCIAL GAS WATER HEATER**

Job Name: \_\_\_\_\_ Model No. \_\_\_\_\_  
 Location: \_\_\_\_\_ Type Gas: \_\_\_\_\_ BTU/HR Input \_\_\_\_\_  
 Engineer: \_\_\_\_\_ Recovery Rate in GPH \_\_\_\_\_ @ \_\_\_\_\_ °F Rise \_\_\_\_\_  
 Agent/Wholesaler: \_\_\_\_\_ Equipment Tag(s): \_\_\_\_\_  
 Contractor: \_\_\_\_\_

**Standard Features**

- Up to 96% Thermal Efficiency
- Modulating Burner with 3:1 Turn-down
- Operates at Temperatures up to 180°F for Sanitizing Applications
- Stainless Steel Heat Exchanger
- Glass-Lined Steel Tank
- Magnesium Anode Rods
- 150 PSI Working Pressure
- ASME Construction (SWSA-500)
- ASME Temperature & Pressure Relief Valve
- Zero Clearances to Combustible Floors
- Certified for Installation on Combustible Floors
- PVC, CPVC, Polypropylene and Stainless Steel Venting up to 150 Equivalent Feet
- Direct-Vent Sealed Combustion
- Rooftop and Sidewall Venting
- Advanced SMART CONTROL
- LCD Display
- Time Clock
- Night Setback
- Alarm Contacts
- Runtime Contacts
- Manual Reset High Limit
- Water Temperature Sensors
- Flue Temperature Sensors
- Contacts for Levers
- Adjustable Pump Delay
- Security Protection
- Enable/Disable Contacts

**Optional Equipment**

- Audible Alarm Kit
- Concentric Vent Kit
- Condensate Neutralization Kit
- CON X-US@ Remote Connectivity
- Flow Switch
- Low Water Cutoff Kit
- Sidewall Vent Termination Kit

**SHIELD COMMERCIAL WATER HEATER - DIMENSIONS AND SPECIFICATIONS**

**Model Number Guide**

Model Number	Flue/Vent Input (Gals.)	Capacity (GPM)	Thermal Eff. (%)	100" Rise Rate	10" Rise Rate	A	B	D	E	F	Gas Conn.	Water Conn.	Air Inlet Size (In.)	Vent Size (In.)	Ship Wgt. (Lbs.)
SWR125N	125,000	65	96%	145	197	42 1/2"	28"	20 1/2"	46 1/2"	66"	1 1/2"	1 1/2"	3"	3"	560
SWR150N	150,000	90	96%	175	247	70"	28"	44"	61"	79 1/2"	1 1/2"	1 1/2"	3"	3"	700
SWR200N	199,000	90	96%	232	304	76"	28"	44"	61"	79 1/2"	1 1/2"	1 1/2"	3"	3"	725
SWR250N	285,000	110	95%	328	416	77 1/2"	34"	30 1/2"	51 3/4"	79 1/2"	1 1/2"	1 1/2"	4"	4"	800
SWR300N	399,000	110	95%	459	547	77 1/2"	34"	30 1/2"	51 3/4"	79 1/2"	1 1/2"	1 1/2"	4"	4"	850
SWR400N	500,000	110	96%	592	712	77 1/2"	34"	30 1/2"	51 3/4"	79 1/2"	1 1/2"	1 1/2"	4"	4"	875

**Model Number Guide**

- SWR125N 125,000 65 96% 145 197 42 1/2" 28" 20 1/2" 46 1/2" 66" 1 1/2" 1 1/2" 3" 3" 560
- SWR150N 150,000 90 96% 175 247 70" 28" 44" 61" 79 1/2" 1 1/2" 1 1/2" 3" 3" 700
- SWR200N 199,000 90 96% 232 304 76" 28" 44" 61" 79 1/2" 1 1/2" 1 1/2" 3" 3" 725
- SWR250N 285,000 110 95% 328 416 77 1/2" 34" 30 1/2" 51 3/4" 79 1/2" 1 1/2" 1 1/2" 4" 4" 800
- SWR300N 399,000 110 95% 459 547 77 1/2" 34" 30 1/2" 51 3/4" 79 1/2" 1 1/2" 1 1/2" 4" 4" 850
- SWR400N 500,000 110 96% 592 712 77 1/2" 34" 30 1/2" 51 3/4" 79 1/2" 1 1/2" 1 1/2" 4" 4" 875

**Lochinvar**  
 HIGH EFFICIENCY BOILERS & WATER HEATERS

**CHARLES WILLIAMS & ASSOCIATES ARCHITECTS**  
 3601 8TH AVE. SOUTH BIRMINGHAM, ALABAMA 35222  
 PH: 205-250-0700 FAX: 205-250-0515

**CWA**

SHEET TITLE: **PLUMBING - DETAILS**

PROJECT NUMBER: **CWA No. 2023-01**


DATE: **08.30.24**

DRAWN BY: **JTR** CHECKED BY: **CLJ**

SHEET NUMBER: **P0.2**



Revisions		
No.	Date	Description
1	2/5/2025	Revision 1
2	2/21/2025	ADDENDUM 3

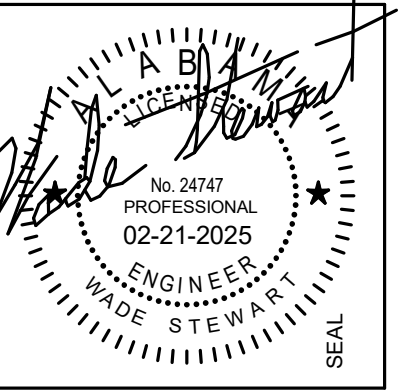

100% CDS

**IRONDALE FIRE STATION #3**  
 INT. OF JOHN ROGERS DRIVE & ALTON ROAD  
 Birmingham, Alabama  
 CITY OF IRONDALE

CHARLES WILLIAMS & ASSOCIATES ARCHITECTS  
**CWA**  
 3601 8TH AVE. SOUTH BIRMINGHAM, ALABAMA 35222  
 PH: 205-250-0700  
 FAX: 205-250-0515

SHEET TITLE:  
**PRESSURE PIPING - FLOOR PLAN**  
 PROJECT NUMBER:  
**CWA No. 2023-01**  
 DATE:  
**08.30.24**  
 DRAWN BY:  
**JTR**  
 CHECKED BY:  
**CLJ**






SHEET NUMBER  
**P2.1**

KITCHEN PLUMBING ROUGH-IN DATA						
ITEM	QTY	DESCRIPTION	HW (IN)	CW (IN)	WASTE (IN)	REMARKS
P107	1	PROVIDE 1/2" CW W/ FAUCET & MOP SINK	1/2	1/2	-	REFER TO MECHANICAL PLAN
P106	2	BUILT-IN HANDSINK W/ SPLASH & FAUCET	12	12	1 1/2	(S)(C)
P108	1	COFFEE BREWER	-	1/4	1 1/2	(S)
P107	1	MILLWORK BASE COUNTER W/ SINK	12	12	1 1/2	-
P112	1	MILLWORK BASE COUNTER W/ SINK	12	12	1 1/2	-
P115	1	BUILT-IN SINK W/ FAUCET	12	12	2"	(S)(C)
P116	5	DISPOSER	-	1/2	2"	(S)
P117	1	DEHWASHER	-	1/2	2"	(S)
P118	1	ICE MAKER W/ BIN	-	1/2	3/4"	(S)
P122	1	5 BITE RANGE W/ OVEN	12	34	-	(S)
P127	3	REFRIG /FRZR COMBO	12	-	-	(S)


(S) PROVIDE OFF. PIPR RELIEF TO DRAIN  
 (C) PROVIDE CHECK VALVE ON COLD WATER, HOT WATER BRANCHLINE TO FAUCET.  
 (S) PROVIDE MOPPING VALVE  
 (S) PROVIDE GAS CONNECTION

**PRESSURE KEY NOTES**

- 1/2" CW, 1/2" HW DN.
- 1/2" CW DN.
- 1" CW DN

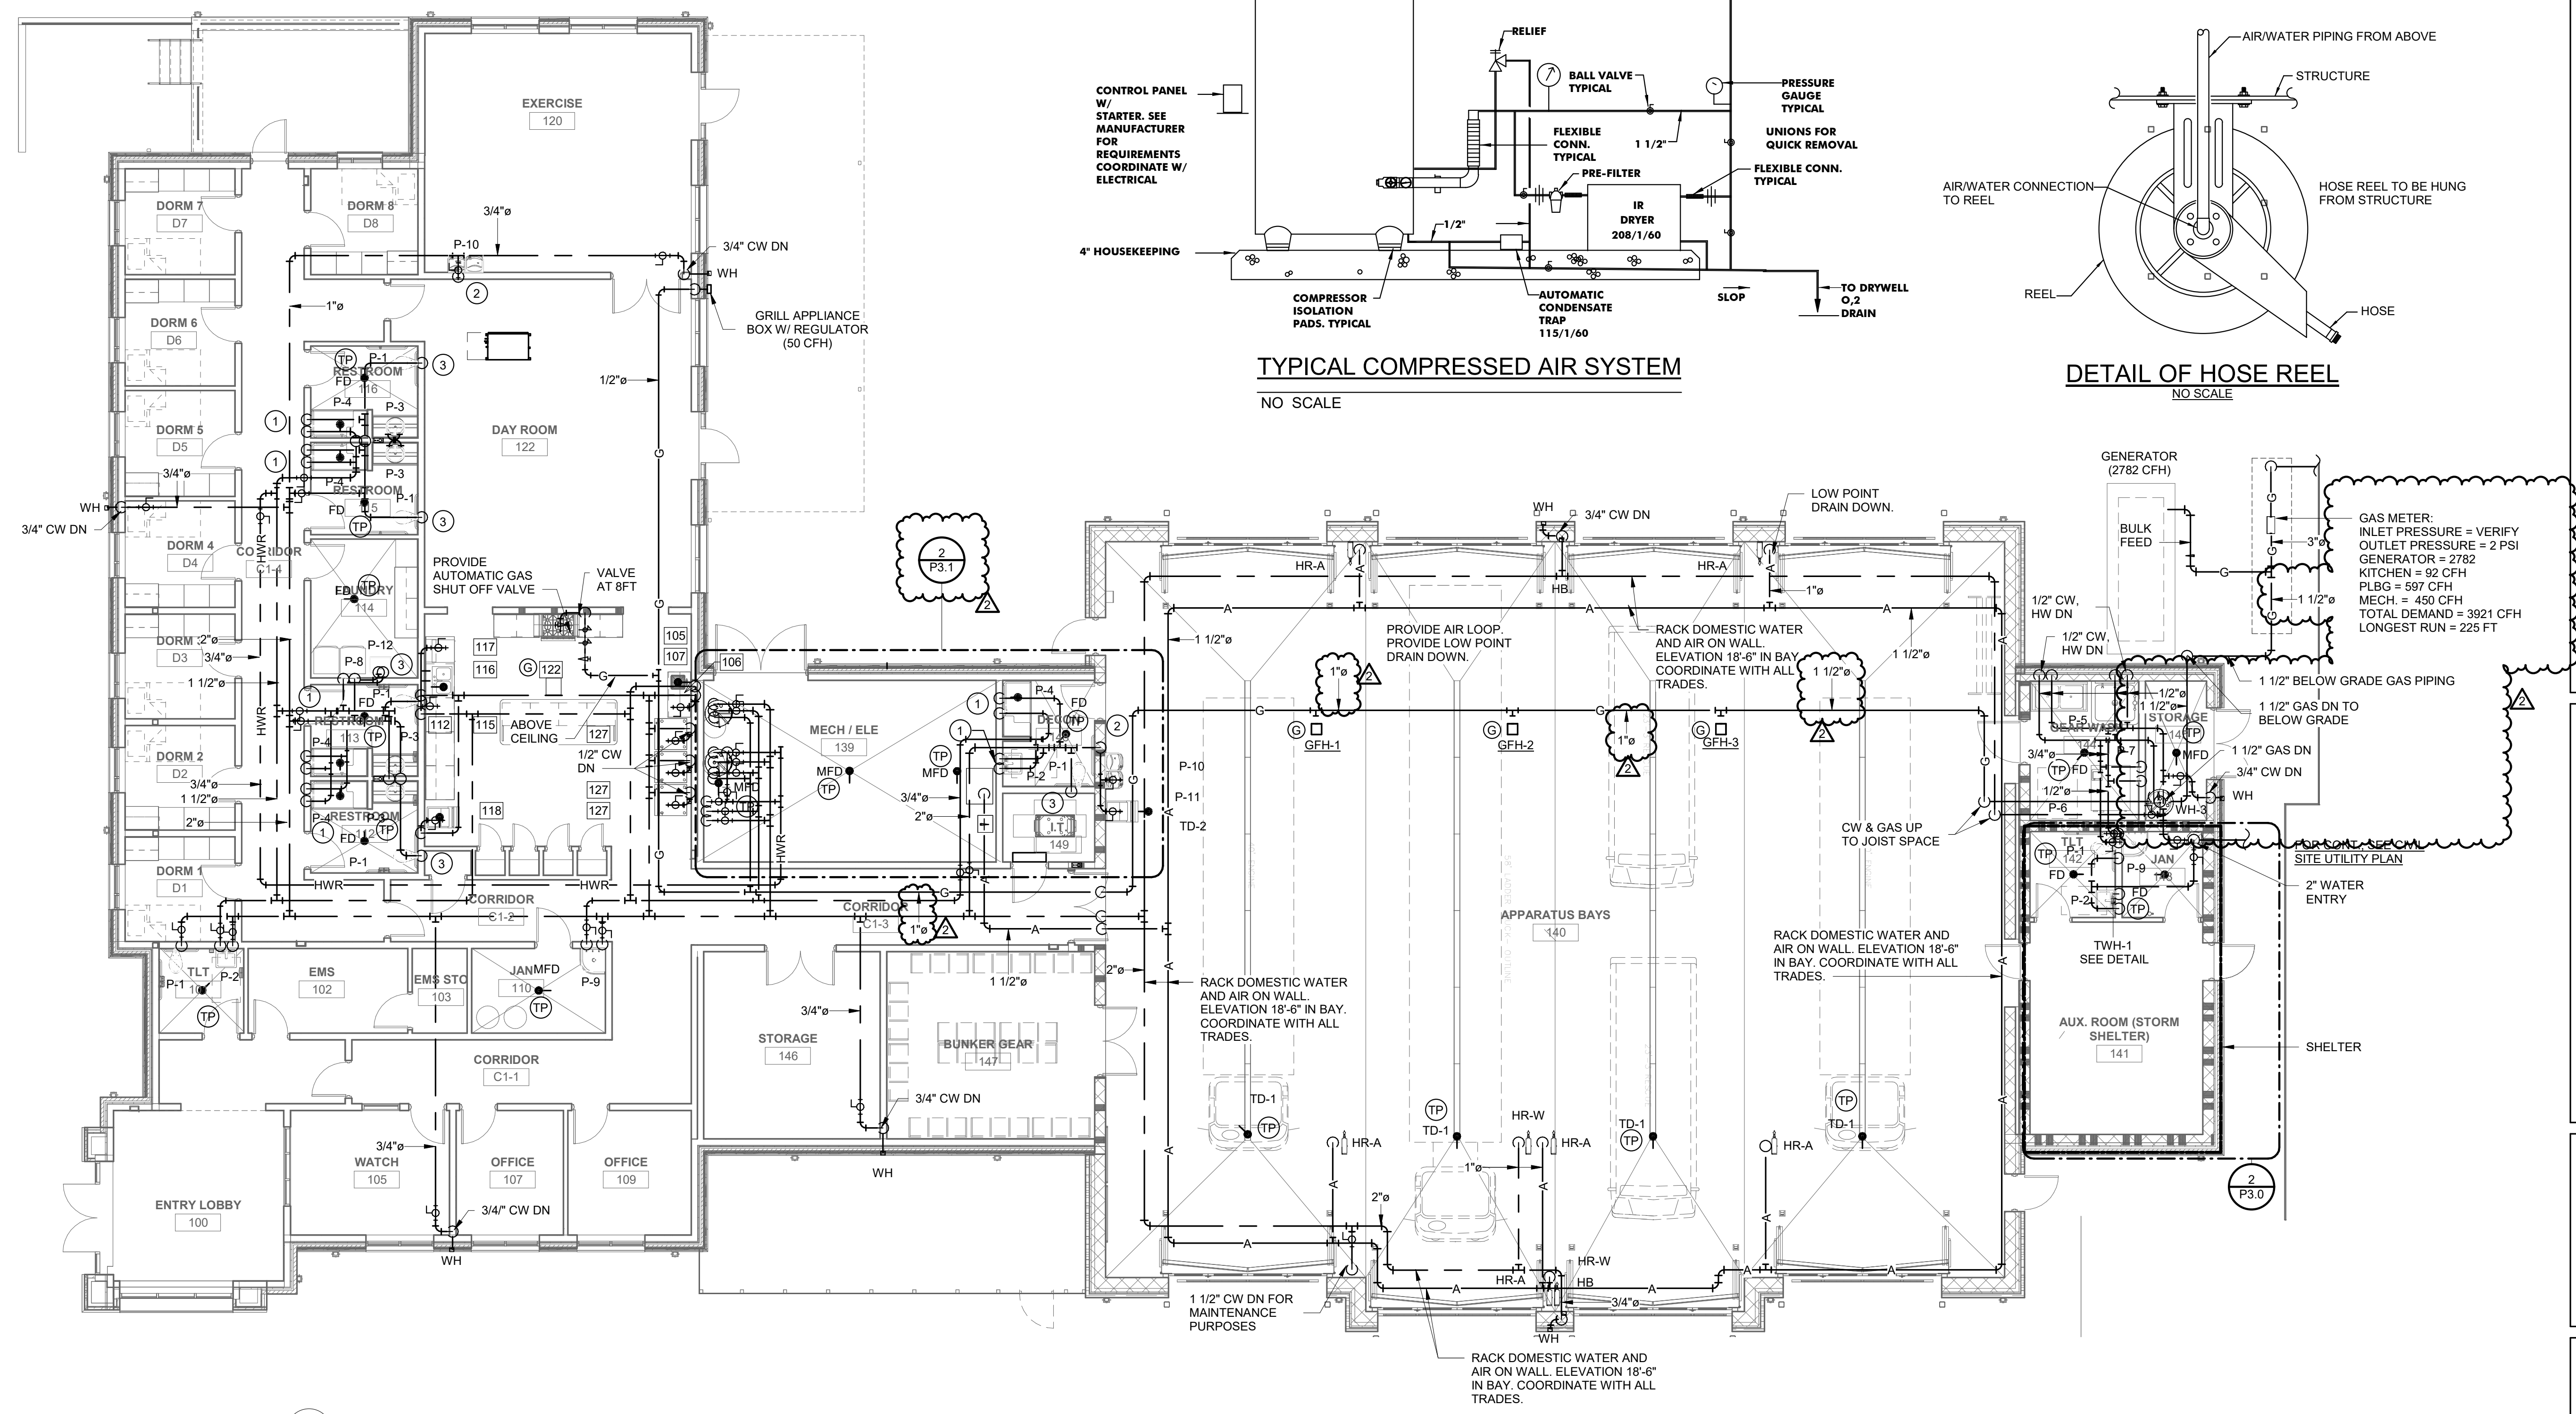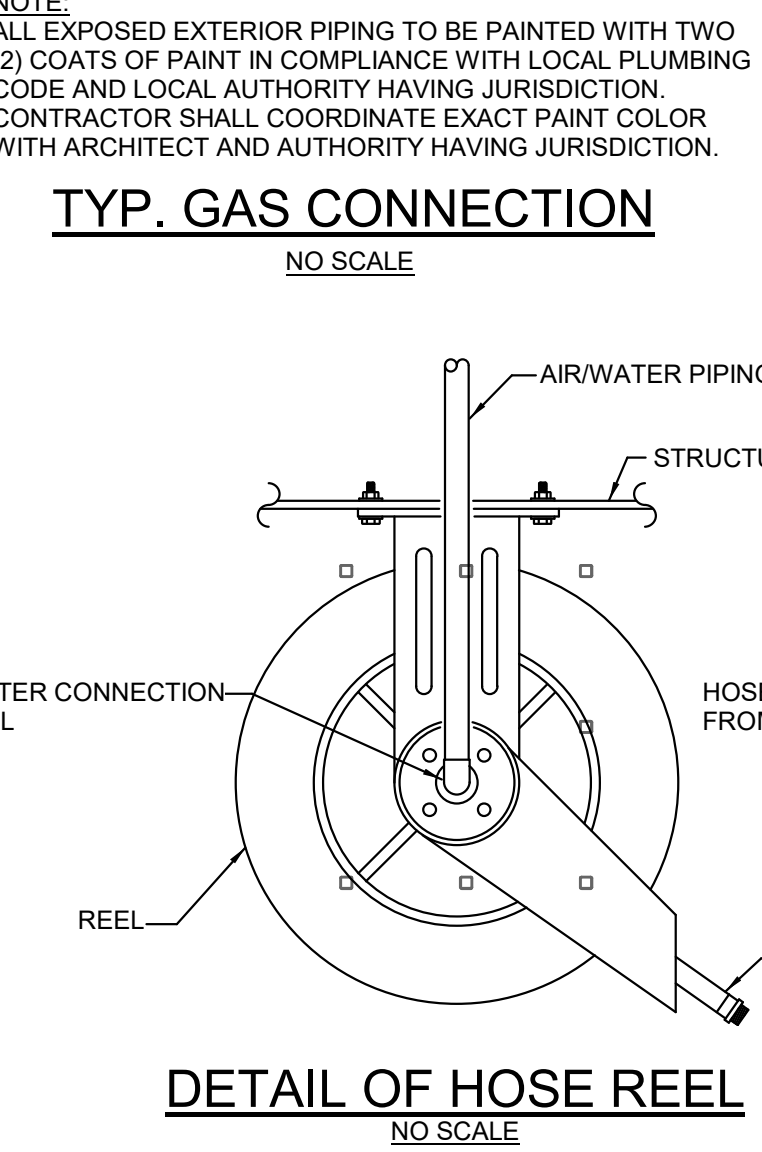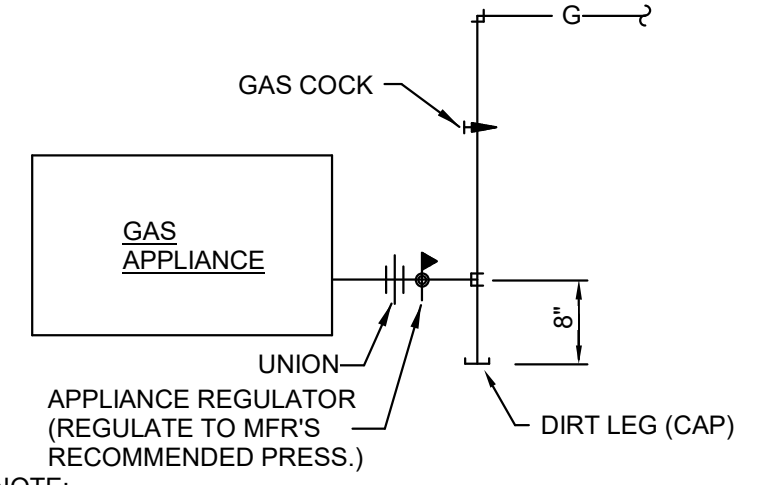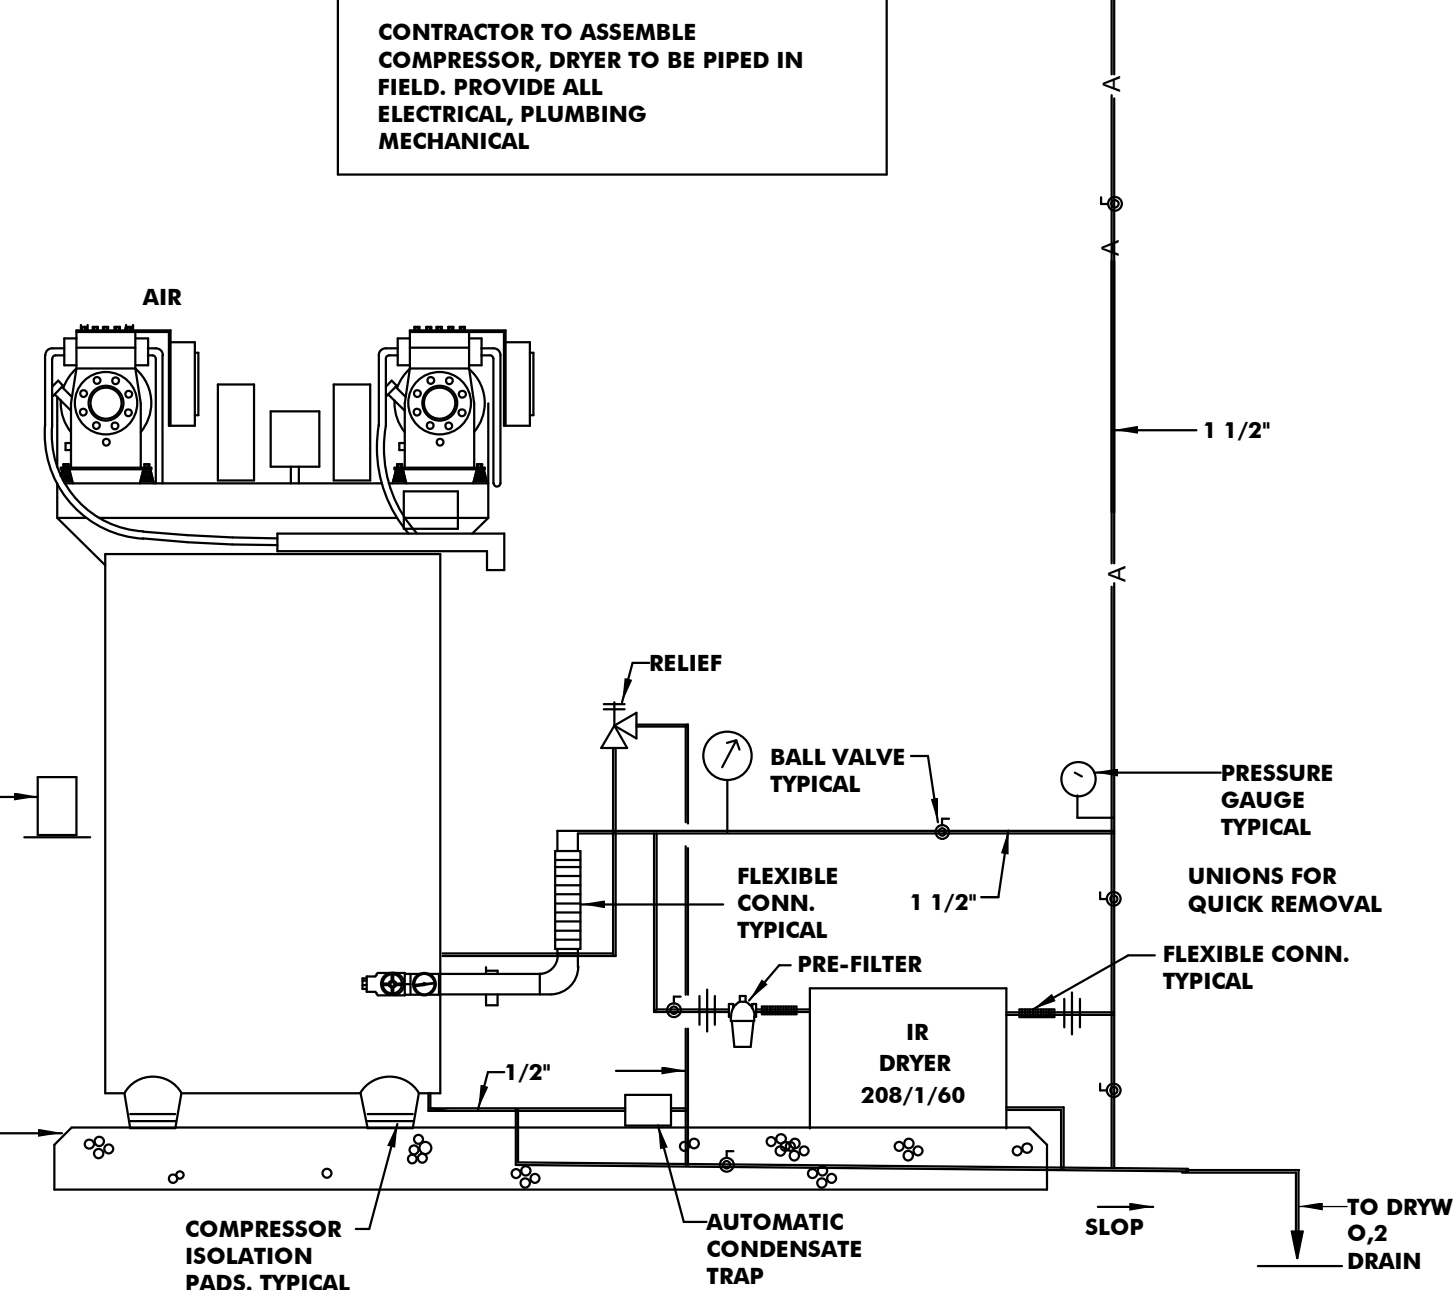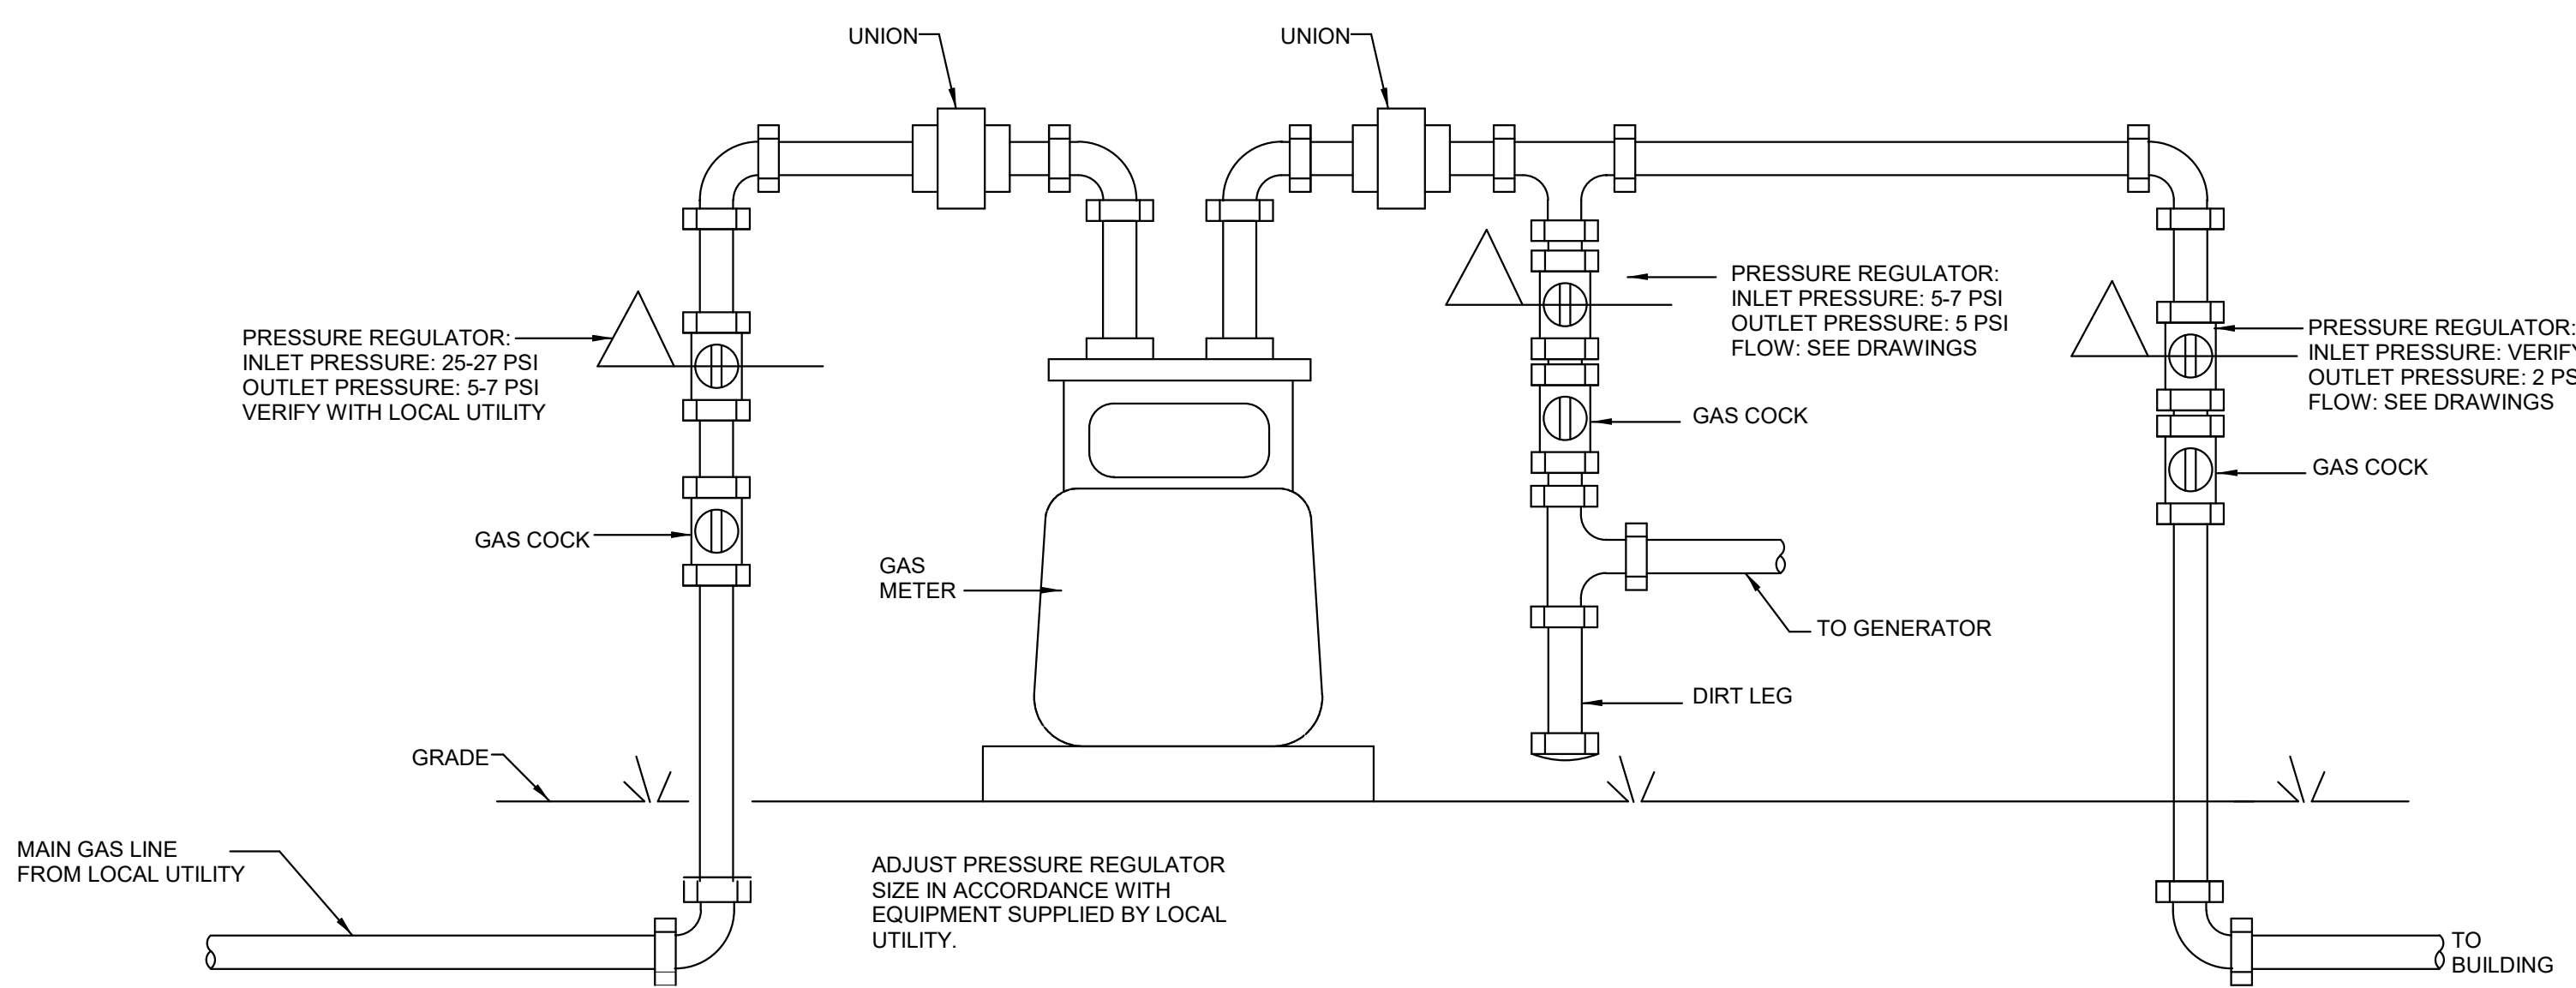

Revisions		
No.	Date	Description
1	2/5/2025	Revision 1
2	2/21/2025	ADDENDUM 3

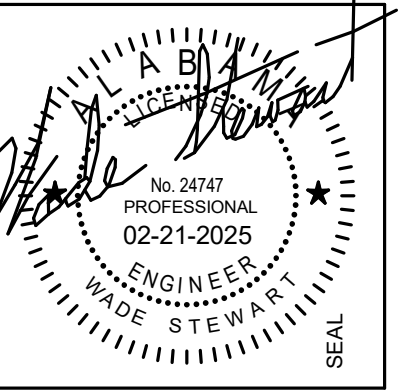



100% CDS

**IRONDALE FIRE STATION #3**  
 INT. OF JOHN ROGERS DRIVE & ALTON ROAD  
 Birmingham, Alabama  
 CITY OF IRONDALE

CHARLES WILLIAMS  
 & ASSOCIATES  
 ARCHITECTS  
**CWA**  
 3601 8TH AVE. SOUTH  
 BIRMINGHAM, ALABAMA 35222  
 PH: 205-250-0700  
 FAX: 205-250-0515


SHEET TITLE:  
**PLUMBING - ENLARGED PLANS**  
 PROJECT NUMBER:  
**CWA No. 2023-01**  
 DATE:  
**08.30.24**  
 DRAWN BY: JTR  
 CHECKED BY: CLJ

SHEET NUMBER  
**P3.1**

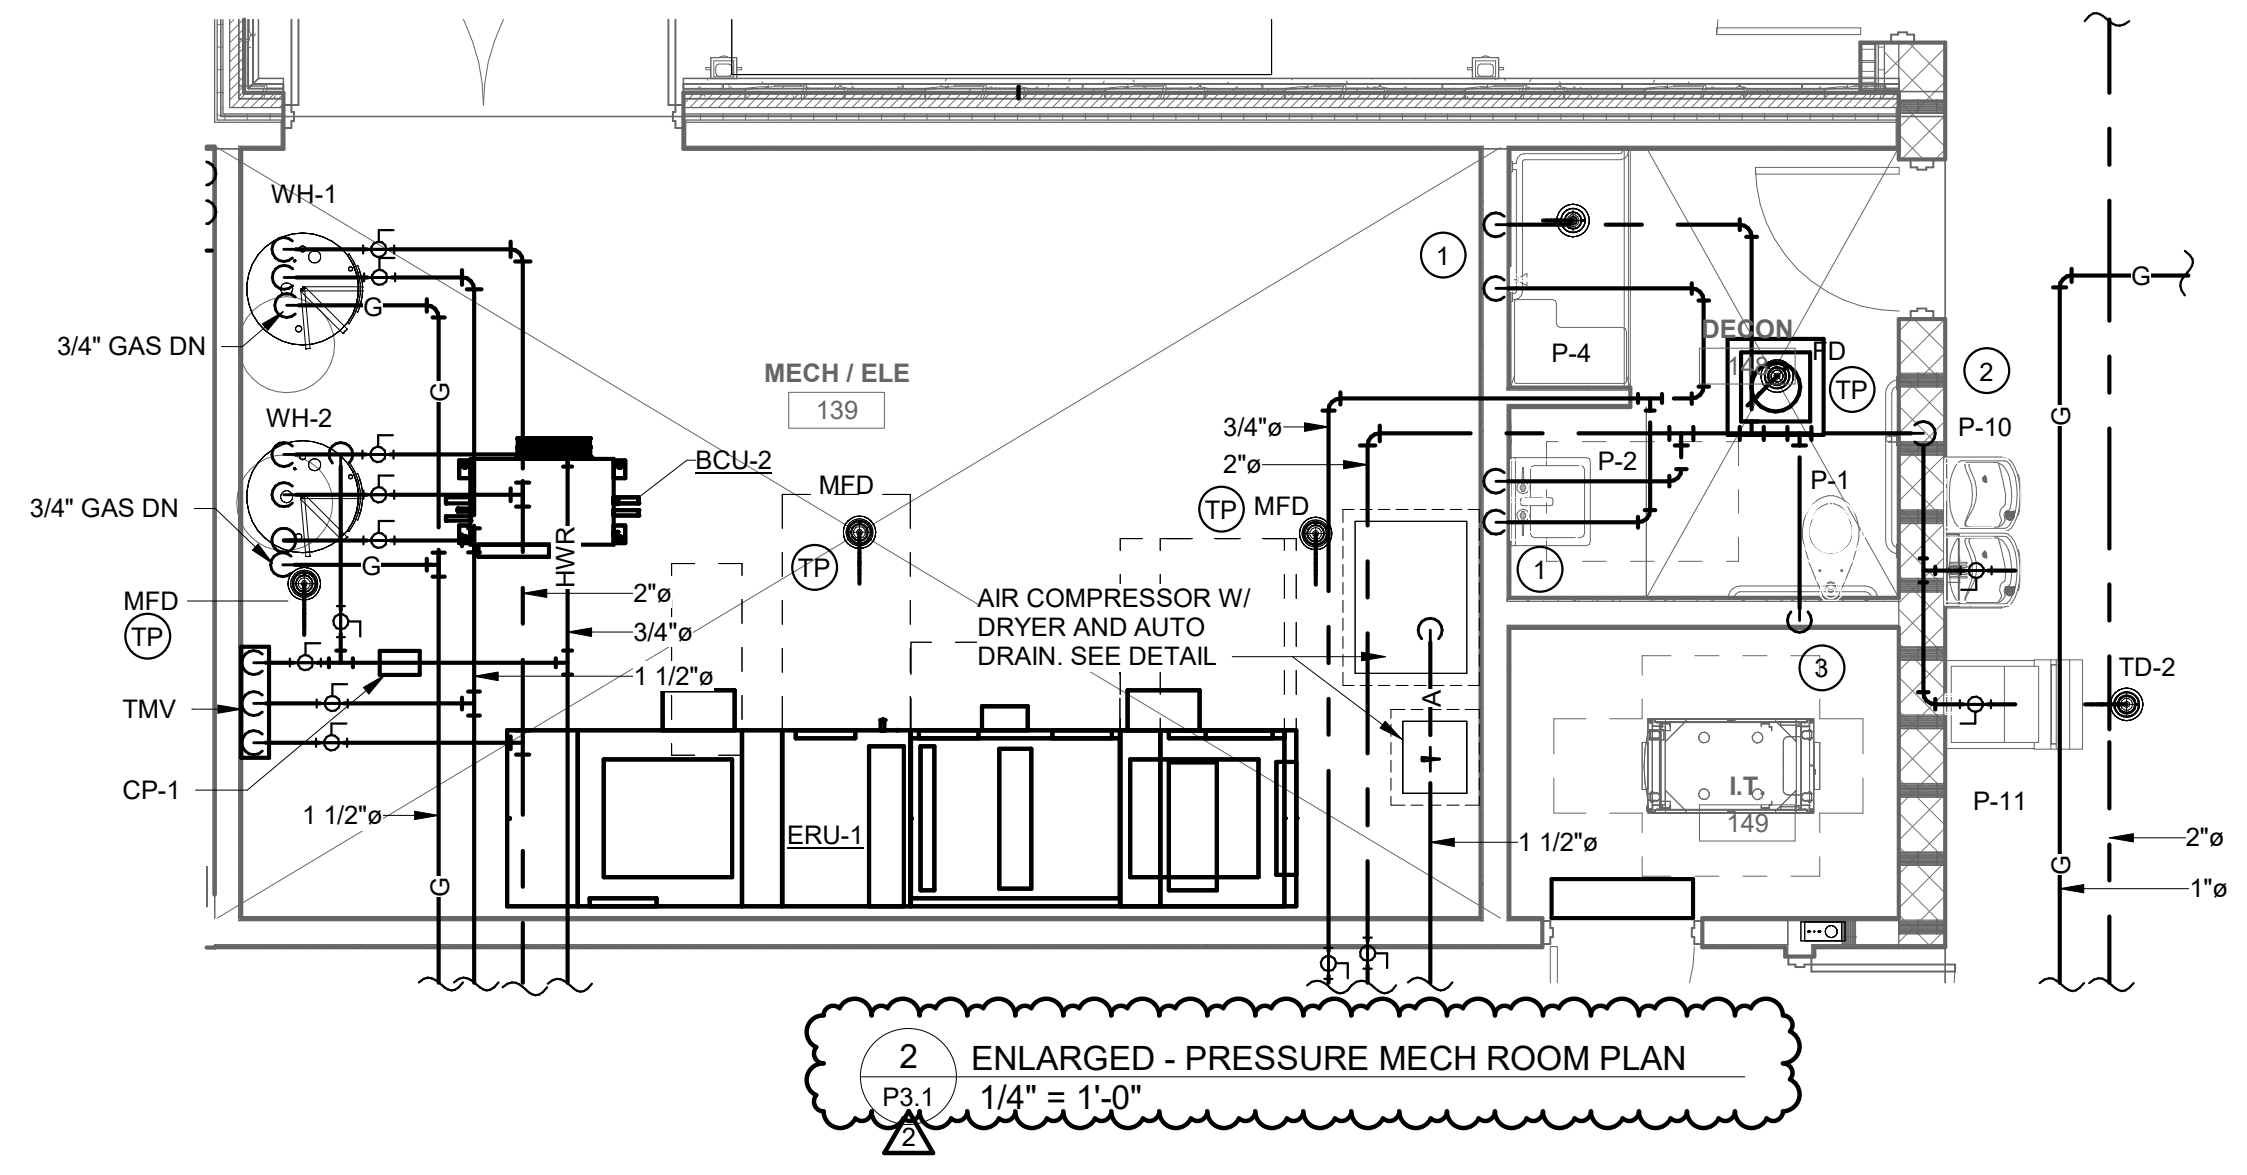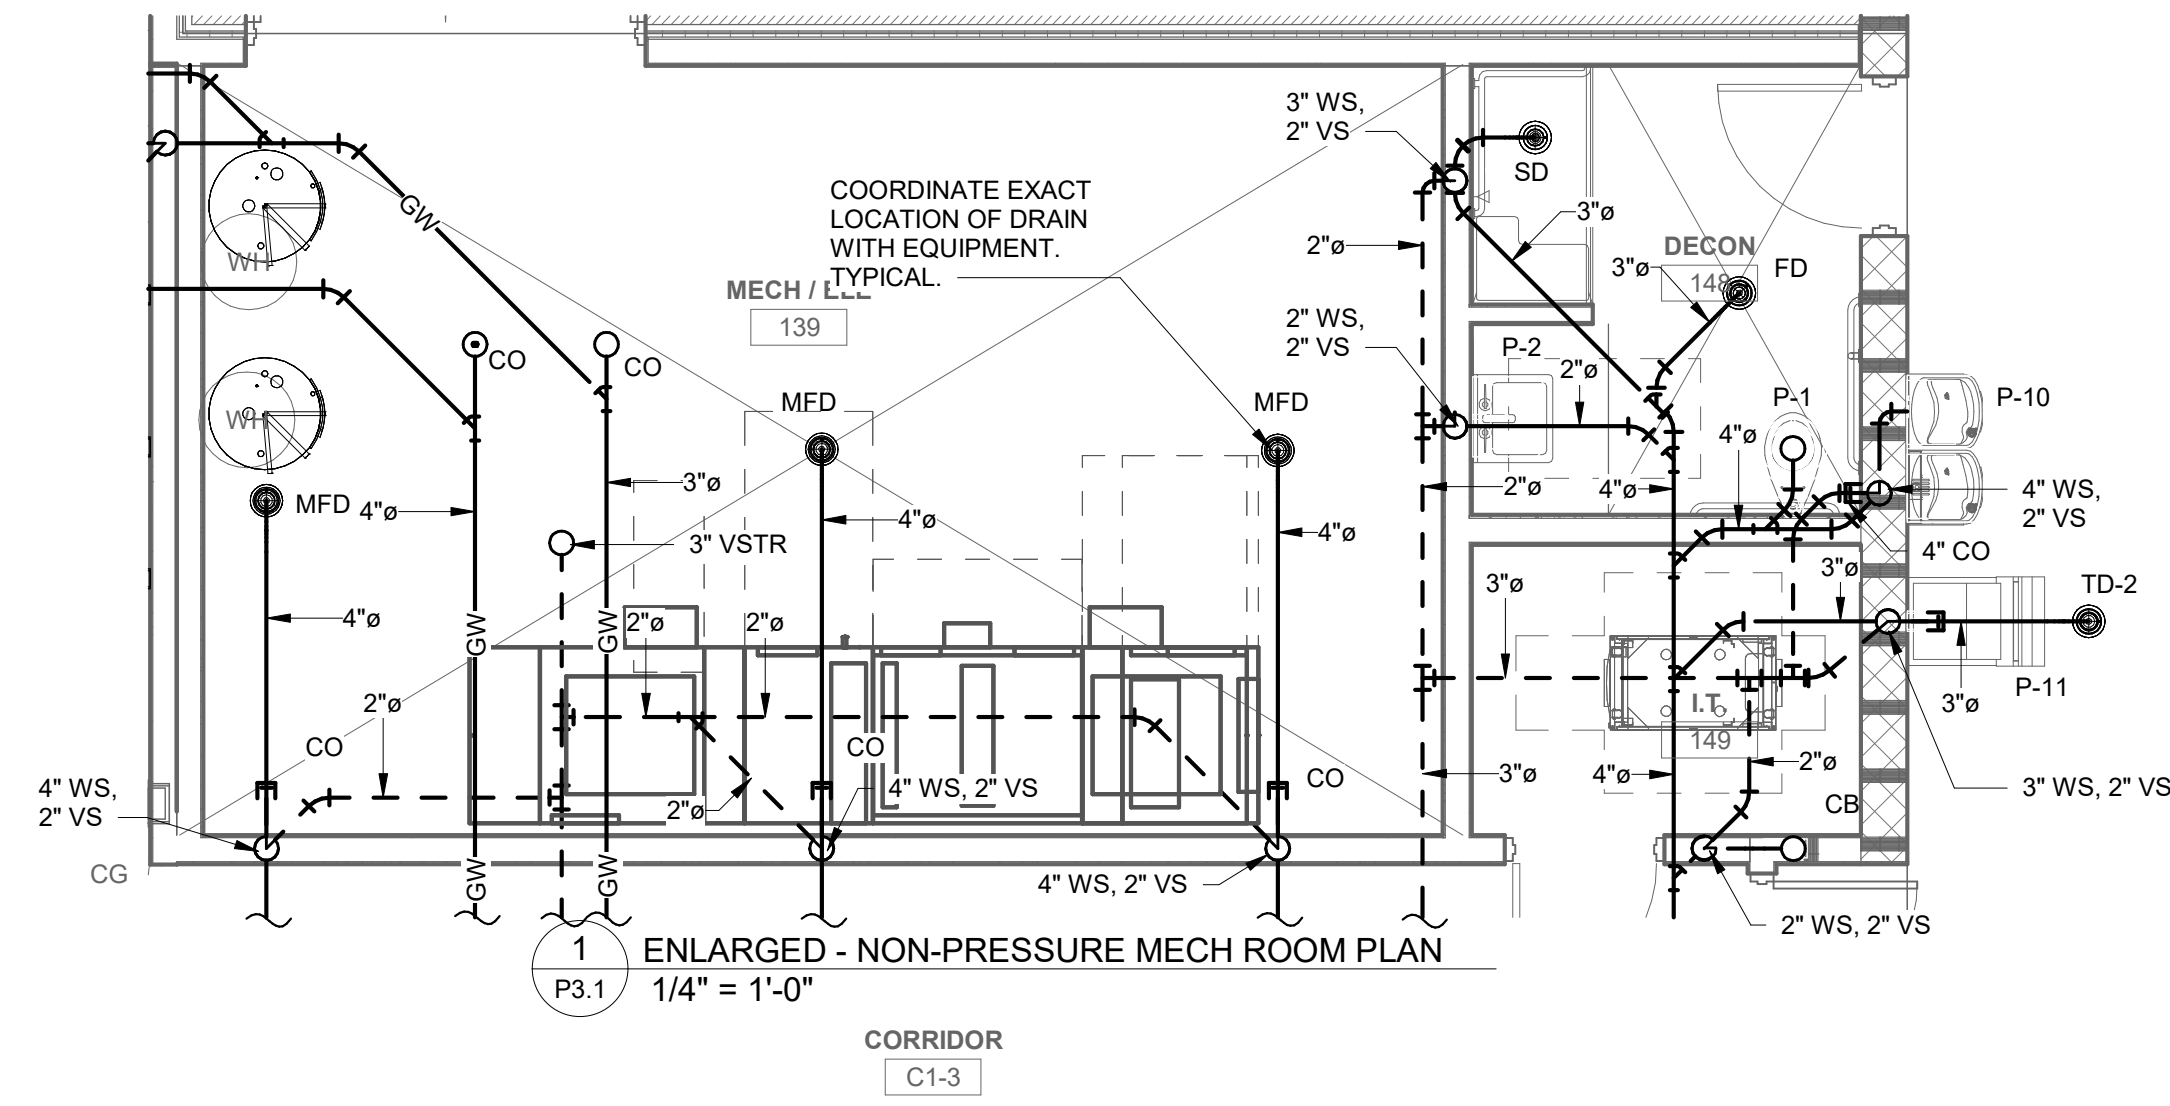



Revisions		
No.	Date	Description
1	02.12.25	Addendum #2
2	02.21.25	Addendum #3

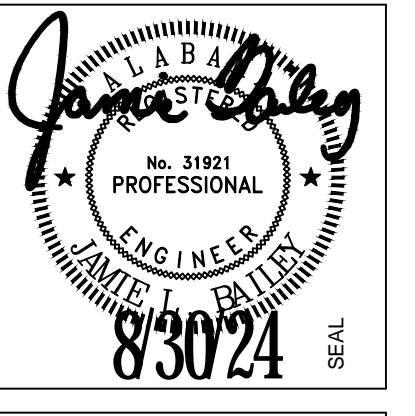

LIGHTING FIXTURE SCHEDULE										
TYPE	DESCRIPTION	MOUNTING		MANUFACTURER	CATALOG NUMBER	L.E.D.			VOLTS	TOTAL WATTS
		TYPE	HEIGHT			LUMENS	COLOR	DRIVER QTY / TYPE		
X1	SINGLE FACE EDGE LIT L.E.D. EXIT SIGN WITH RED LETTERS AND DIRECTIONAL CHEVRONS AS SHOWN	UNIVERSAL	UNIVERSAL	DUAL LITE EXITRONX CHLORIDE LITHONIA	LES-**-S-**-N-E-I-M APPROVED EQUAL APPROVED EQUAL APPROVED EQUAL	FURNISHED WITH UNIT			120	5
X2	DOUBLE FACE EDGE LIT L.E.D. EXIT SIGN WITH RED LETTERS AND DIRECTIONAL CHEVRONS AS SHOWN	UNIVERSAL	UNIVERSAL	DUAL LITE EXITRONX CHLORIDE LITHONIA	LES-**-D-**-N-E-I-M APPROVED EQUAL APPROVED EQUAL APPROVED EQUAL	FURNISHED WITH UNIT			120	5
XD	WALL MOUNTED EXIT DISCHARGE LIGHT WITH INTEGRAL HEATER AND BATTERY	WALL	8'-0" AFF	LITHONIA EXITRONX CHLORIDE LITHONIA	AFB-OLE-DOB7XD-UV-OLT-LTP-SORT-WT-CW APPROVED EQUAL APPROVED EQUAL APPROVED EQUAL	FURNISHED WITH UNIT	NA		120	15
PL3	SINGLE HEAD LED SITE LIGHTING FIXTURE WITH TYPE III DISTRIBUTION, MOUNTED ON A 30'-0" SQUARE STRAIGHT STEEL POLE. FINISH TO BE SELECTED BY ARCHITECT.	POLE	30'-0"	McGRAW-EDISON	FIXTURE: GLEON-SA4C-740-SL3**-FF POLE: SSS4A30SFM APPROVED EQUAL	24,564	4000K	1	208	225
PL4	SINGLE HEAD LED SITE LIGHTING FIXTURE WITH TYPE IV DISTRIBUTION MOUNTED ON A 30'-0" SQUARE STRAIGHT STEEL POLE. FINISH TO BE SELECTED BY ARCHITECT.	POLE	30'-0"	McGRAW-EDISON	FIXTURE: GLEON-SA4C-740-T4FT**-FF POLE: SSS4A30SFM APPROVED EQUAL	23,340	4000K	1	208	225
PW4	WALL MOUNTED L.E.D. FLOOD LIGHT WITH TYPE IV DISTRIBUTION AND INTEGRAL DRIVER. U.L. LISTED FOR WET LOCATION. COLOR TO BE SELECTED BY THE ARCHITECT	WALL	14'-0"	McGRAW-EDISON	GWC-SA1A-740-U-SL4**-F APPROVED EQUAL	4,729	4000K	1	120	40
FL1	STANCHION MOUNTED ADJUSTABLE L.E.D. FLOOD LIGHT WITH NARROW SPOT DISTRIBUTION. FIXTURE TO BE U.L. LISTED FOR WET LOCATION. COLOR TO BE SELECTED BY THE ARCHITECT.	GROUND	SEE DETAIL	LITHONIA HUBBELL EATON GARDCO	DSXF1-LED-P1-40K-NSP-MVOLT**-THK APPROVED EQUAL APPROVED EQUAL APPROVED EQUAL	2,876	4000K	120	1	21
<b>GENERAL NOTES:</b> A. MANUFACTURER CATALOG NUMBERS ARE SHOWN FOR GENERAL DESCRIPTIVE PURPOSES AND TO ESTABLISH A STANDARD OF QUALITY. MANUFACTURERS LISTED AS "EQUAL" DOES NOT ENSURE NOR GUARANTEE APPROVAL OF ANY PRODUCT BY THE LISTED MANUFACTURER. FOR APPROVAL, FIXTURES MUST PROVIDE EQUAL PERFORMANCE RELATIVE TO DELIVERY OF LIGHTING, ENERGY USE, AND BE OF SIMILAR DESIGN AND CONSTRUCTION. REQUESTS FOR PRIOR APPROVAL OF FIXTURES NOT LISTED IN THIS SCHEDULE <b>MUST</b> BE RECEIVED BY THE ENGINEER A MINIMUM OF 10 DAYS PRIOR TO BID (SEE SPECIFICATIONS) FOR REVIEW BY THE ARCHITECT/ENGINEER. MANUFACTURERS APPROVAL THROUGH THIS PROCESS WILL BE LISTED IN AN ADDENDUM PRIOR TO BID. FIXTURES NOT LISTED IN AN ADDENDUM ARE NOT APPROVED. B. CONTRACTOR SHALL PROVIDE LUMINAIRES COMPLETE WITH ALL OPTIONS AND ACCESSORIES REQUIRED FOR A COMPLETE INSTALLATION. ALL PRODUCTS SHALL BE U.L. LISTED. C. PROVIDE PROPER LAMP FOR REFLECTOR ASSEMBLY SPECIFIED AND AS RECOMMENDED BY LUMINAIRE MANUFACTURER. D. VERIFY CONSTRUCTION AND TYPE CEILINGS TO BE INSTALLED AND PROVIDE LUMINAIRES IN APPROPRIATE CONFIGURATION WITH ALL HARDWARE AND ACCESSORIES REQUIRED FOR A COMPLETE AND PROPER INSTALLATION. E. PROVIDE LUMINAIRES WITH JOINING PLATES, END CAPS, CANOPIES, MOUNTING HARDWARE, ETC., AS REQUIRED FOR COMPLETE INSTALLATION. F. EXIT LIGHTS SHALL BE PROVIDED WITH RED LETTERS REQUIRED BY LOCAL CODE AUTHORITY. FURNISH WITH CHEVRON DIRECTIONAL INDICATORS AS INDICATED AND/OR AS REQUIRED. G. PROVIDE DEVICES FOR SECURING LAY-IN TYPE LUMINAIRES TO CEILING GRID TO COMPLY WITH ARTICLE 410 OF THE NATIONAL ELECTRICAL CODE. H. FURNISH LINEAR LUMINAIRES IN CONTINUOUS ROWS OR PATTERNS AS INDICATED ON DRAWINGS. PROVIDE WITH CORNER, ANGLE, AND END PIECES AS REQUIRED FOR A COMPLETE FINISHED INSTALLATION. <b>SCHEDULE NOTES:</b>										

LIGHTING FIXTURE SCHEDULE										
TYPE	DESCRIPTION	MOUNTING		MANUFACTURER	CATALOG NUMBER	L.E.D.			VOLTS	TOTAL WATTS
		TYPE	HEIGHT			LUMENS	COLOR	DRIVER QTY / TYPE		
CF1	8'-0" PENDANT MOUNTED CEILING FAN WITH 6 BLADES. COLOR TO BE SELECTED BY THE ARCHITECT. FURNISHED WITH WALL MOUNTED CONTROLLER.	PENDANT	CEILING	BIG ASS FANS	FAN: MKI61-08-18-06**-100 WALL SWITCH: C-BTWC-03-04-00-US (FIXED WALL MOUNT)	---	---	NA	120	50
CF2	OUTDOOR RATED 60" ROUND 6 BLADE CEILING FAN WITH LIGHT KIT. COLOR TO BE SELECTED BY THE ARCHITECT. FURNISHED WITH WALL MOUNTED CONTROLLER.	PENDANT	CEILING	BIG ASS FANS	FAN: MK-TRB1-062306-A786-I20 WALL SWITCH: C-BTWC-03-04-00-US (FIXED WALL MOUNT)	---	---	NA	120	70
CF3	6'-0" PENDANT MOUNTED CEILING FAN WITH 6 BLADES. COLOR TO BE SELECTED BY THE ARCHITECT. FURNISHED WITH WALL MOUNTED CONTROLLER.	PENDANT	CEILING	BIG ASS FANS	FAN: MKI61-06-18-06**-100 WALL SWITCH: C-BTWC-03-04-00-US (FIXED WALL MOUNT)	---	---	NA	120	50
P1	8'-0" PENDANT MOUNTED STRIP WITH SQUARE LENS AND INTEGRAL DRIVER. PROVIDE ALL THREAD DOWN RODS SECURES TO STRUCTURE AS REQUIRED	SURFACE	CEILING	METALLX COLUMBIA H.E. WILLIAMS LITHONIA	8T-SNLED-LD5-SLN#4SL-SLN-UNV-L835-CD-1 APPROVED EQUAL APPROVED EQUAL APPROVED EQUAL	6,063	3500K	1	120	45
P1E	SAME AS FIXTURE 'P1' EXCEPT WITH AN EMERGENCY BATTERY TO OPERATE FIXTURE FOR 90 MINUTES UPON LOSS OF POWER.	SURFACE	CEILING	METALLX COLUMBIA H.E. WILLIAMS LITHONIA	8T-SNLED-LD5-SLN#4SL-SLN-UNV-EL14W-L835-CD-1 APPROVED EQUAL APPROVED EQUAL APPROVED EQUAL	6,063	3500K	1	120	45
P2E	10'-0" PENDANT MOUNTED LIGHT FIXTURE WITH UP AND DOWN LIGHT. COLOR TO BE SELECTED BY THE ARCHITECT	PENDANT	VERIFY WITH ARCH DRAWINGS	PEERLESS FINELITE LUMENWERX	VMM9-LLP-10FT-MSL4-80CRI-35K-ID1350LMF-60/40-DARK-ZT-120-SCT-E10W/CP-F2-XX**-DU APPROVED EQUAL APPROVED EQUAL	1350 PER FT	3500K	1	120	15 PER FT
P3	DECORATIVE PENDANT MOUNTED LUMINAIRE WITH 1 LAMP. PROVIDE AN ALLOWANCE OF \$300 FOR EACH.	PENDANT	SEE ARCH DRAWINGS		TO BE SELECTED					
P4	2' x 2' SQUARE PENDANT MOUNTED LUMINAIRE WITH INTEGRAL DRIVER. COLOR TO BE SELECTED BY THE ARCHITECT. COLORS TO BE SELECTED BY THE ARCHITECT	PENDANT	SEE ARCH DRAWINGS	PRUDENTIAL FINELITE LUMENWERX	BPR02-SQ-LIN-22-FLSH-LED35-SO-SAL**-**-SC-UNV-SPM**-X3-DM01- APPROVED EQUAL APPROVED EQUAL	6,300	3500K	1	120	63
P5	3' x 3' SQUARE PENDANT MOUNTED LUMINAIRE WITH INTEGRAL DRIVER. COLOR TO BE SELECTED BY THE ARCHITECT. COLORS TO BE SELECTED BY THE ARCHITECT	PENDANT	SEE ARCH DRAWINGS	PRUDENTIAL FINELITE LUMENWERX	BPR02-SQ-LIN-33-FLSH-LED35-SO-SAL**-**-SC-UNV-SPM**-X3-DM01- APPROVED EQUAL APPROVED EQUAL	9,400	3500K	1	120	94
P6	4' x 4' SQUARE PENDANT MOUNTED LUMINAIRE WITH INTEGRAL DRIVER. COLOR TO BE SELECTED BY THE ARCHITECT. COLORS TO BE SELECTED BY THE ARCHITECT	PENDANT	SEE ARCH DRAWINGS	PRUDENTIAL FINELITE LUMENWERX	BPR02-SQ-LIN-44-FLSH-LED35-SO-SAL**-**-SC-UNV-SPM**-X3-DM01- APPROVED EQUAL APPROVED EQUAL	12,600	3500K	1	120	125
R1	6" ROUND L.E.D. DOWNLIGHT WITH SWITCHABLE LUMEN OUTPUT, CLEAR SEMI-DIFFUSE REFLECTOR AND INTEGRAL 0-10 VOLT DIMMABLE DRIVER	RECESSED	CEILING	LITHONIA PRESCOLITE H.E. WILLIAMS HALO	LDN6-AL02-SWW1-L06-AR-LSS-WD-MVOLT-UGZ APPROVED EQUAL APPROVED EQUAL APPROVED EQUAL	1,500	3500K	1	120	20
R1E	SAME AS FIXTURE 'R1' EXCEPT WITH AN EMERGENCY BATTERY PACK TO OPERATE FIXTURE FOR 90 MINUTES UPON LOSS OF POWER	RECESSED	CEILING	LITHONIA PATHWAY H.E. WILLIAMS HALO	LDN6-AL02-SWW1-L06-AR-LSS-WD-MVOLT-UGZ-EL APPROVED EQUAL APPROVED EQUAL APPROVED EQUAL	1,500	3500K	1	120	20
R2	RECESSED 2x2 L.E.D. FIXTURE WITH 0-10 VOLT DIMMABLE DRIVER	RECESSED	CEILING	METALLX COLUMBIA H.E. WILLIAMS LITHONIA	22EN-LD2-39-UNV-L835-CD1-U APPROVED EQUAL APPROVED EQUAL APPROVED EQUAL	3,979	3500K	1	120	35
R2E	SAME AS FIXTURE 'R2' EXCEPT WITH AN EMERGENCY BATTERY PACK TO OPERATE FIXTURE FOR 90 MINUTES UPON LOSS OF POWER	RECESSED	CEILING	METALLX COLUMBIA H.E. WILLIAMS LITHONIA	22EN-LD2-39-UNV-EL14W-L835-CD1-U APPROVED EQUAL APPROVED EQUAL APPROVED EQUAL	3,979	3500K	1	120	35
R3	RECESSED 2x4 L.E.D. FIXTURE WITH 0-10 VOLT DIMMABLE DRIVER	RECESSED	CEILING	METALLX COLUMBIA H.E. WILLIAMS LITHONIA	24EN-LD2-54-UNV-L835-CD1-U APPROVED EQUAL APPROVED EQUAL APPROVED EQUAL	5,410	3500K	1	120	45
R3E	SAME AS FIXTURE 'R3' EXCEPT WITH AN EMERGENCY BATTERY PACK TO OPERATE FIXTURE FOR 90 MINUTES UPON LOSS OF POWER	RECESSED	CEILING	METALLX COLUMBIA H.E. WILLIAMS LITHONIA	24EN-LD2-54-UNV-EL14W-L835-CD1-U APPROVED EQUAL APPROVED EQUAL APPROVED EQUAL	5,410	3500K	1	120	45
S1	4'-0" SURFACE MOUNTED L.E.D. STRIP WITH LENS AND INTEGRAL DRIVER	SURFACE	CEILING	LITHONIA METALLX H.E. WILLIAMS COLUMBIA	ZL1N-L48-SMR-5000LM-FST-MVOLT-35K-80CRI-WH APPROVED EQUAL APPROVED EQUAL APPROVED EQUAL	4,585	3500K	1	120	35
S1E	SAME AS FIXTURE 'S1' EXCEPT WITH AN EMERGENCY BATTERY PACK TO OPERATE FIXTURE FOR 120 MINUTES UPON LOSS OF POWER.	SURFACE	CEILING	LITHONIA METALLX H.E. WILLIAMS COLUMBIA	ZL1N-L48-SMR-5000LM-FST-MVOLT-35K-80CRI-EM(2HR)-WH APPROVED EQUAL APPROVED EQUAL APPROVED EQUAL	4,585	3500K	1	120	35
SH	6" ROUND RECESSED SHOWER LIGHT WITH INTEGRAL DRIVER. U.L. LISTED FOR WET LOCATION	RECESSED	CEILING	H.E. WILLIAMS PRESCOLITE PORTFOLIO LITHONIA KICHLER	LSL60-L30C-8-35-DPL-DRV-120 APPROVED EQUAL APPROVED EQUAL APPROVED EQUAL	800	3500K	1	120	36
UC2	2'-0" UNDER CABINET LIGHT WITH INTEGRAL DRIVER	SURFACE	UNDER CABINET	KICHLER	6UCSK22NT	735	3000K	NA	120	10
UC1	30" UNDER CABINET LIGHT WITH INTEGRAL DRIVER	SURFACE	UNDER CABINET	KICHLER	6UCSK30NT	1,000	3000K	NA	120	10
W1	WALL MOUNTED 12" GOOSE NECK MOUNTED FIXTURE. U.L. LISTED FOR WET LOCATION. COLOR TO BE SELECTED BY THE ARCHITECT	WALL	SEE ARCH DRAWINGS	BOCK LIGHTING SPECTRUM	512**-LAC02**-GN17A-17** APPROVED EQUAL	1500 - 2400	4000K	1	120	25
W2	WALL MOUNTED VANITY SCONCE. COLOR TO BE SELECTED BY THE ARCHITECT	WALL	SEE ARCH DRAWINGS	TGS WAC LIGHTING	MVR-24-24-C3000-BN APPROVED EQUAL	1,700	3000K	NA	120	24
W3	WALL MOUNTED SCONCE WITH UP AND DOWNLIGHT. COLOR TO BE SELECTED BY THE ARCHITECT	WALL	SEE ARCH DRAWINGS	CONTECH BARRON LIGHTING	CY3T-3-40K-MVD2-AW-X-WF-BZ-RD APPROVED EQUAL	2,286	4000K	1	120	20
W4	WALL MOUNTED SCONCE WITH INTEGRAL DRIVER. U.L. LISTED FOR WET LOCATION. COLOR TO BE SELECTED BY THE ARCHITECT	WALL	SEE ARCH DRAWINGS	LITHONIA MCGRAW EDISON H.E. WILLIAMS	WST-LED-P2-40K-VW-120** APPROVED EQUAL APPROVED EQUAL APPROVED EQUAL	3,201	4000K	1	120	30
W5	WALL MOUNTED SCONCE WITH UP AND DOWNLIGHT. COLOR TO BE SELECTED BY THE ARCHITECT	WALL	SEE ARCH DRAWINGS	CONTECH BARRON LIGHTING	CY3S-3-40K-MVD2-AW-X-WF-BZ APPROVED EQUAL	2,286	4000K	1	120	20
W6	WALL MOUNTED 20" GOOSE NECK MOUNTED FIXTURE. U.L. LISTED FOR WET LOCATION. COLOR TO BE SELECTED BY THE ARCHITECT	WALL	SEE ARCH DRAWINGS	BOCK LIGHTING SPECTRUM	520**-LAH01**-GN2H-22** APPROVED EQUAL	3000 - 5000	4000K	1	120	45

**100% CD'S**

**IRONDALE FIRE STATION #3**  
 INT. OF JOHN ROGERS DRIVE & ALTON ROAD  
 Birmingham, Alabama  
 CITY OF IRONDALE

CHARLES WILLIAMS & ASSOCIATES ARCHITECTS  
  
 3601 8TH AVE. SOUTH BIRMINGHAM, ALABAMA 35222  
 PH: 205-250-0700 FAX: 205-250-0515

SHEET TITLE:  
 Lighting Fixture Schedule & Details  
 PROJECT NUMBER:  
 CWA No. 2023-01  
 DATE:  
 08/30/24  
 DRAWN BY: JLB CHECKED BY: JLB

SHEET NUMBER  
**E002**



Revisions		
No.	Date	Description
1	02/12/25	ADDENDUM #2
2	02/21/25	ADDENDUM #3



100% CD'S


**IRONDALE FIRE STATION #3**  
 INT. OF JOHN ROGERS DRIVE & ALTON ROAD  
 Birmingham, Alabama  
 CITY OF IRONDALE

CHARLES WILLIAMS & ASSOCIATES ARCHITECTS  
 PH: 205-250-0700  
 BIRMINGHAM, ALABAMA 35222




SHEET TITLE: <b>Level 1 Plan - Lighting</b>	
PROJECT NUMBER: <b>CWA No. 2023-01</b>	
DATE: <b>08.30.24</b>	
DRAWN BY: <b>JLB</b>	CHECKED BY: <b>JLB</b>

SHEET NUMBER  
**E201**

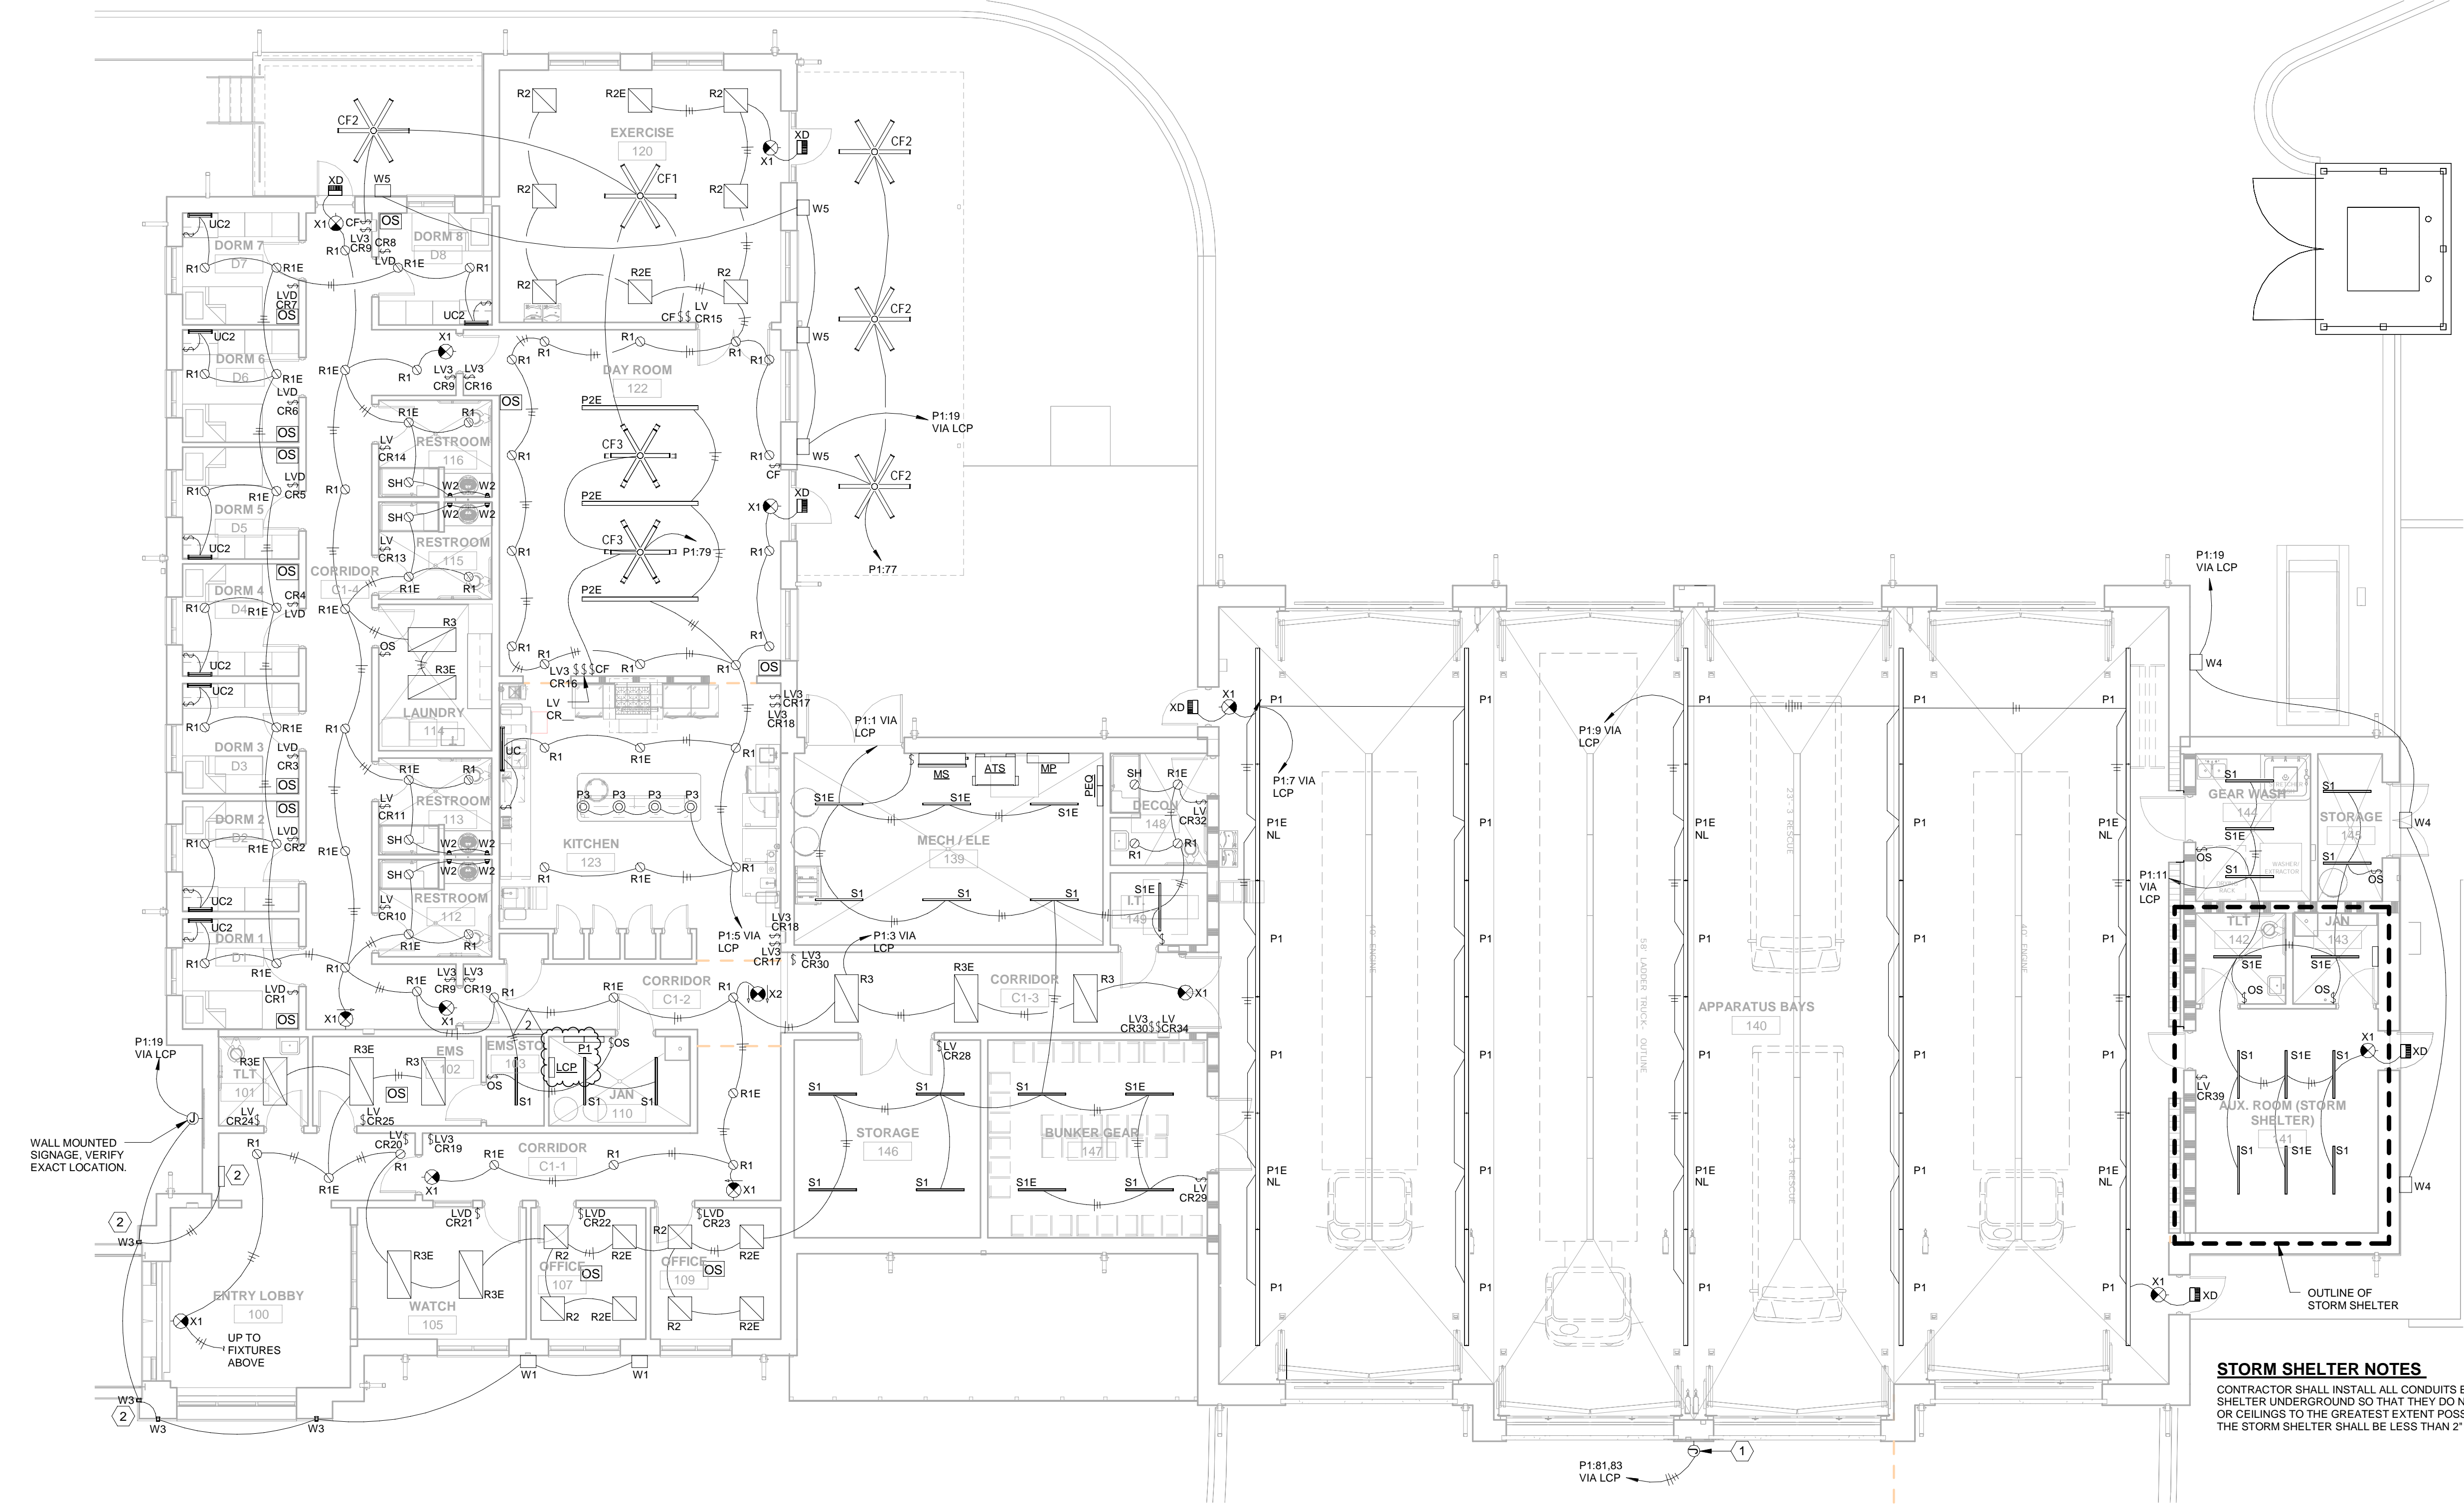

**STORM SHELTER NOTES:**  
 CONTRACTOR SHALL INSTALL ALL CONDUITS ENTERING OR EXITING THE STORM SHELTER UNDERGROUND SO THAT THEY DO NOT PENETRATE STORM SHELTER WALLS OR CEILINGS TO THE GREATEST EXTENT POSSIBLE. ANY PENETRATIONS REQUIRED IN THE STORM SHELTER SHALL BE LESS THAN 2" AND SHALL CONFORM TO ICC 500.

Level 1 Plan - Lighting  
 1/8" = 1'-0"

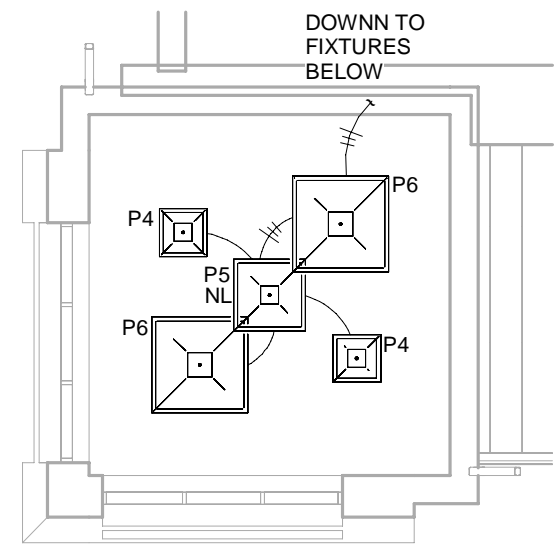

Cupola Plan - Lighting  
 1/8" = 1'-0"

- PLAN NOTES THIS SHEET:**
- JUNCTION BOX WITH (2) 120V. CIRCUITS FOR BUILDING MOUNTED SIGNAGE. HOMERUN THROUGH LCP, AS REQUIRED.
  - 120 VOLT, 500 WATT INVERTER MOUNTED ABOVE THE CEILING TO POWER SELECTED W3 LIGHTS UPON LOSS OF POWER. BATTERY TO BE CONNECTED AHEAD OF THE SWITCHLEG FOR CONTINUOUS POWER. PROVIDE ALL RELAYS AND ADDITIONAL HARDWARE REQUIRED.

- GENERAL NOTES THIS SHEET:**
- CONNECT ALL EXIT SIGNS AND FIXTURES DESIGNATED 'NL' TO THE LOCAL LIGHTING CIRCUIT SHOWN AHEAD OF THE SWITCHLEG FOR CONTINUOUS OPERATION.
  - FIXTURES WITH AN INTEGRAL BATTERY PACK SHALL HAVE THE BATTERY CONNECTED AHEAD OF THE SWITCHLEG FOR CONTINUOUS POWER. BATTERY SHALL OPERATE FIXTURE UPON LOSS OF POWER.
  - REFER TO LIGHTING CONTROL SCHEDULE AND WIRING DIAGRAMS. LOW VOLTAGE WIRING AND AUXILIARY CABLING NOT SHOWN FOR CLARITY.
  - HOMERUNS FOR EACH LIGHTING CIRCUIT SHALL BE ROUTED THROUGH THE LIGHTING CONTROL PANEL AS REQUIRED FOR EACH AREA BEING SERVED BY A RELAY IN THE LCP.


WALL MOUNTED SIGNAGE, VERIFY EXACT LOCATION.

UP TO FIXTURES ABOVE

DOWN TO FIXTURES BELOW



Revisions		
No.	Date	Description
1	02/12/25	ADDENDUM #2
2	02/21/25	ADDENDUM #3

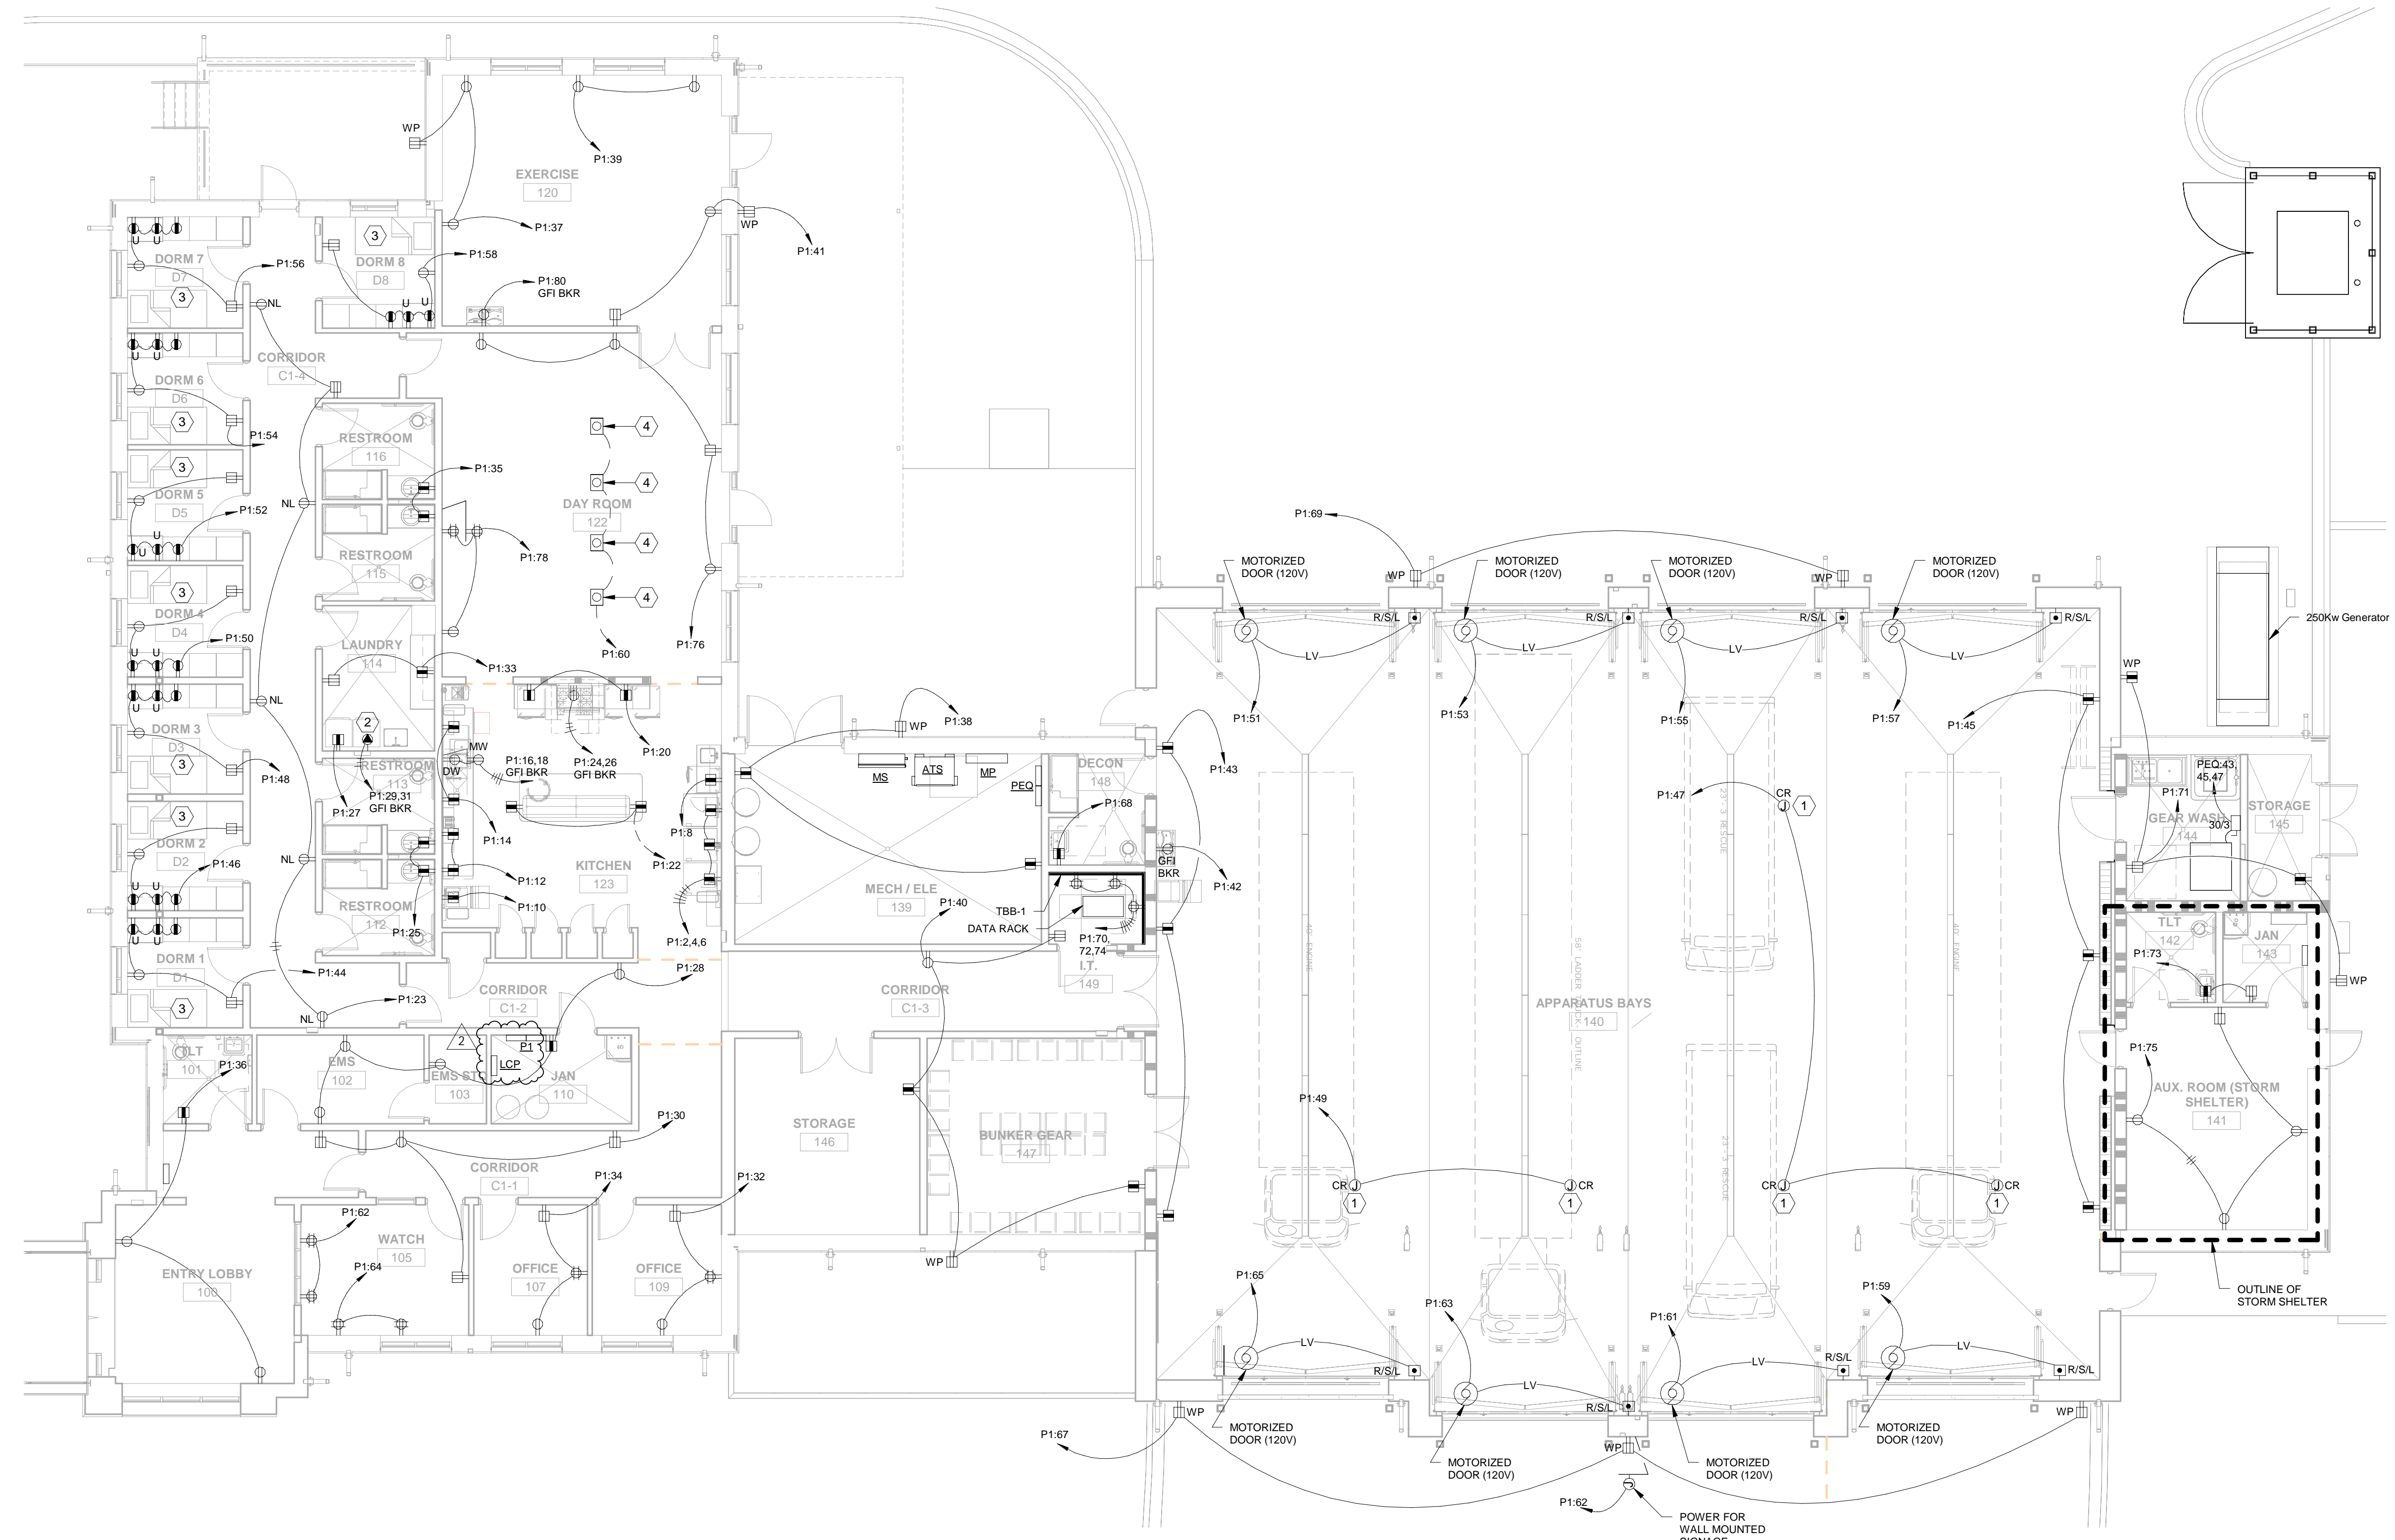

Level 1 Plan - Power  
 1/8" = 1'-0"

- PLAN NOTES THIS SHEET:**
- CORD REEL MOUNTED TO STRUCTURE. VERIFY EXACT LOCATION WITH OWNER AND ARCHITECT PRIOR TO ROUGH-IN. REEL CRAFT #H-7122 OR APPROVED EQUAL.
  - VERIFY NEMA CONFIGURATION PRIOR TO PURCHASE.
  - ALL RECEPTACLES IN THIS ROOM SHALL BE TAMPER RESISTANT PER NEC 210.12(B).
  - SINGLE GANG FLOOR OUTLET WITH (1) DUPLEX RECEPTACLE. WIREMOLD 880 SERIES OR APPROVED EQUAL.

**STORM SHELTER NOTES**  
 CONTRACTOR SHALL INSTALL ALL CONDUITS ENTERING OR EXITING THE STORM SHELTER UNDERGROUND SO THAT THEY DO NOT PENETRATE STORM SHELTER WALLS OR CEILINGS TO THE GREATEST EXTENT POSSIBLE. ANY PENETRATION(S) REQUIRED IN THE STORM SHELTER SHALL BE LESS THAN 2" AND SHALL CONFORM TO ICC 500.

100% CD'S

**IRONDALE FIRE STATION #3**  
 INT. OF JOHN ROGERS DRIVE & ALTON ROAD  
 Birmingham, Alabama  
 CITY OF IRONDALE

CHARLES WILLIAMS & ASSOCIATES ARCHITECTS  
**CWA**  
 3601 8TH AVE. SOUTH BIRMINGHAM, ALABAMA 35222  
 PH: 205-250-0700 FAX: 205-250-0515

SHEET TITLE: Level 1 Plan - Power	
PROJECT NUMBER: CWA No. 2023-01	
DATE: 08.30.24	
DRAWN BY: JLB	CHECKED BY: JLB

SHEET NUMBER  
**E202**

Revisions		
No.	Date	Description
1	02/12/25	ADDENDUM #2
2	02/21/25	ADDENDUM #3




**100% CD'S**

**IRONDALE FIRE STATION #3**  
 INT. OF JOHN RODGERS DRIVE & ALTON ROAD  
 Birmingham, Alabama  
 CITY OF IRONDALE

CHARLES WILLIAMS & ASSOCIATES ARCHITECTS  
 PH: 205-250-0700  
 BIRMINGHAM, ALABAMA 35222  
 FAX: 205-250-0515

SHEET TITLE: <b>Level 1 Plan - Auxiliary</b>	
PROJECT NUMBER: <b>CWA No. 2023-01</b>	
DATE: <b>08.30.24</b>	
DRAWN BY: <b>JLB</b>	CHECKED BY: <b>JLB</b>

SHEET NUMBER  
**E203**

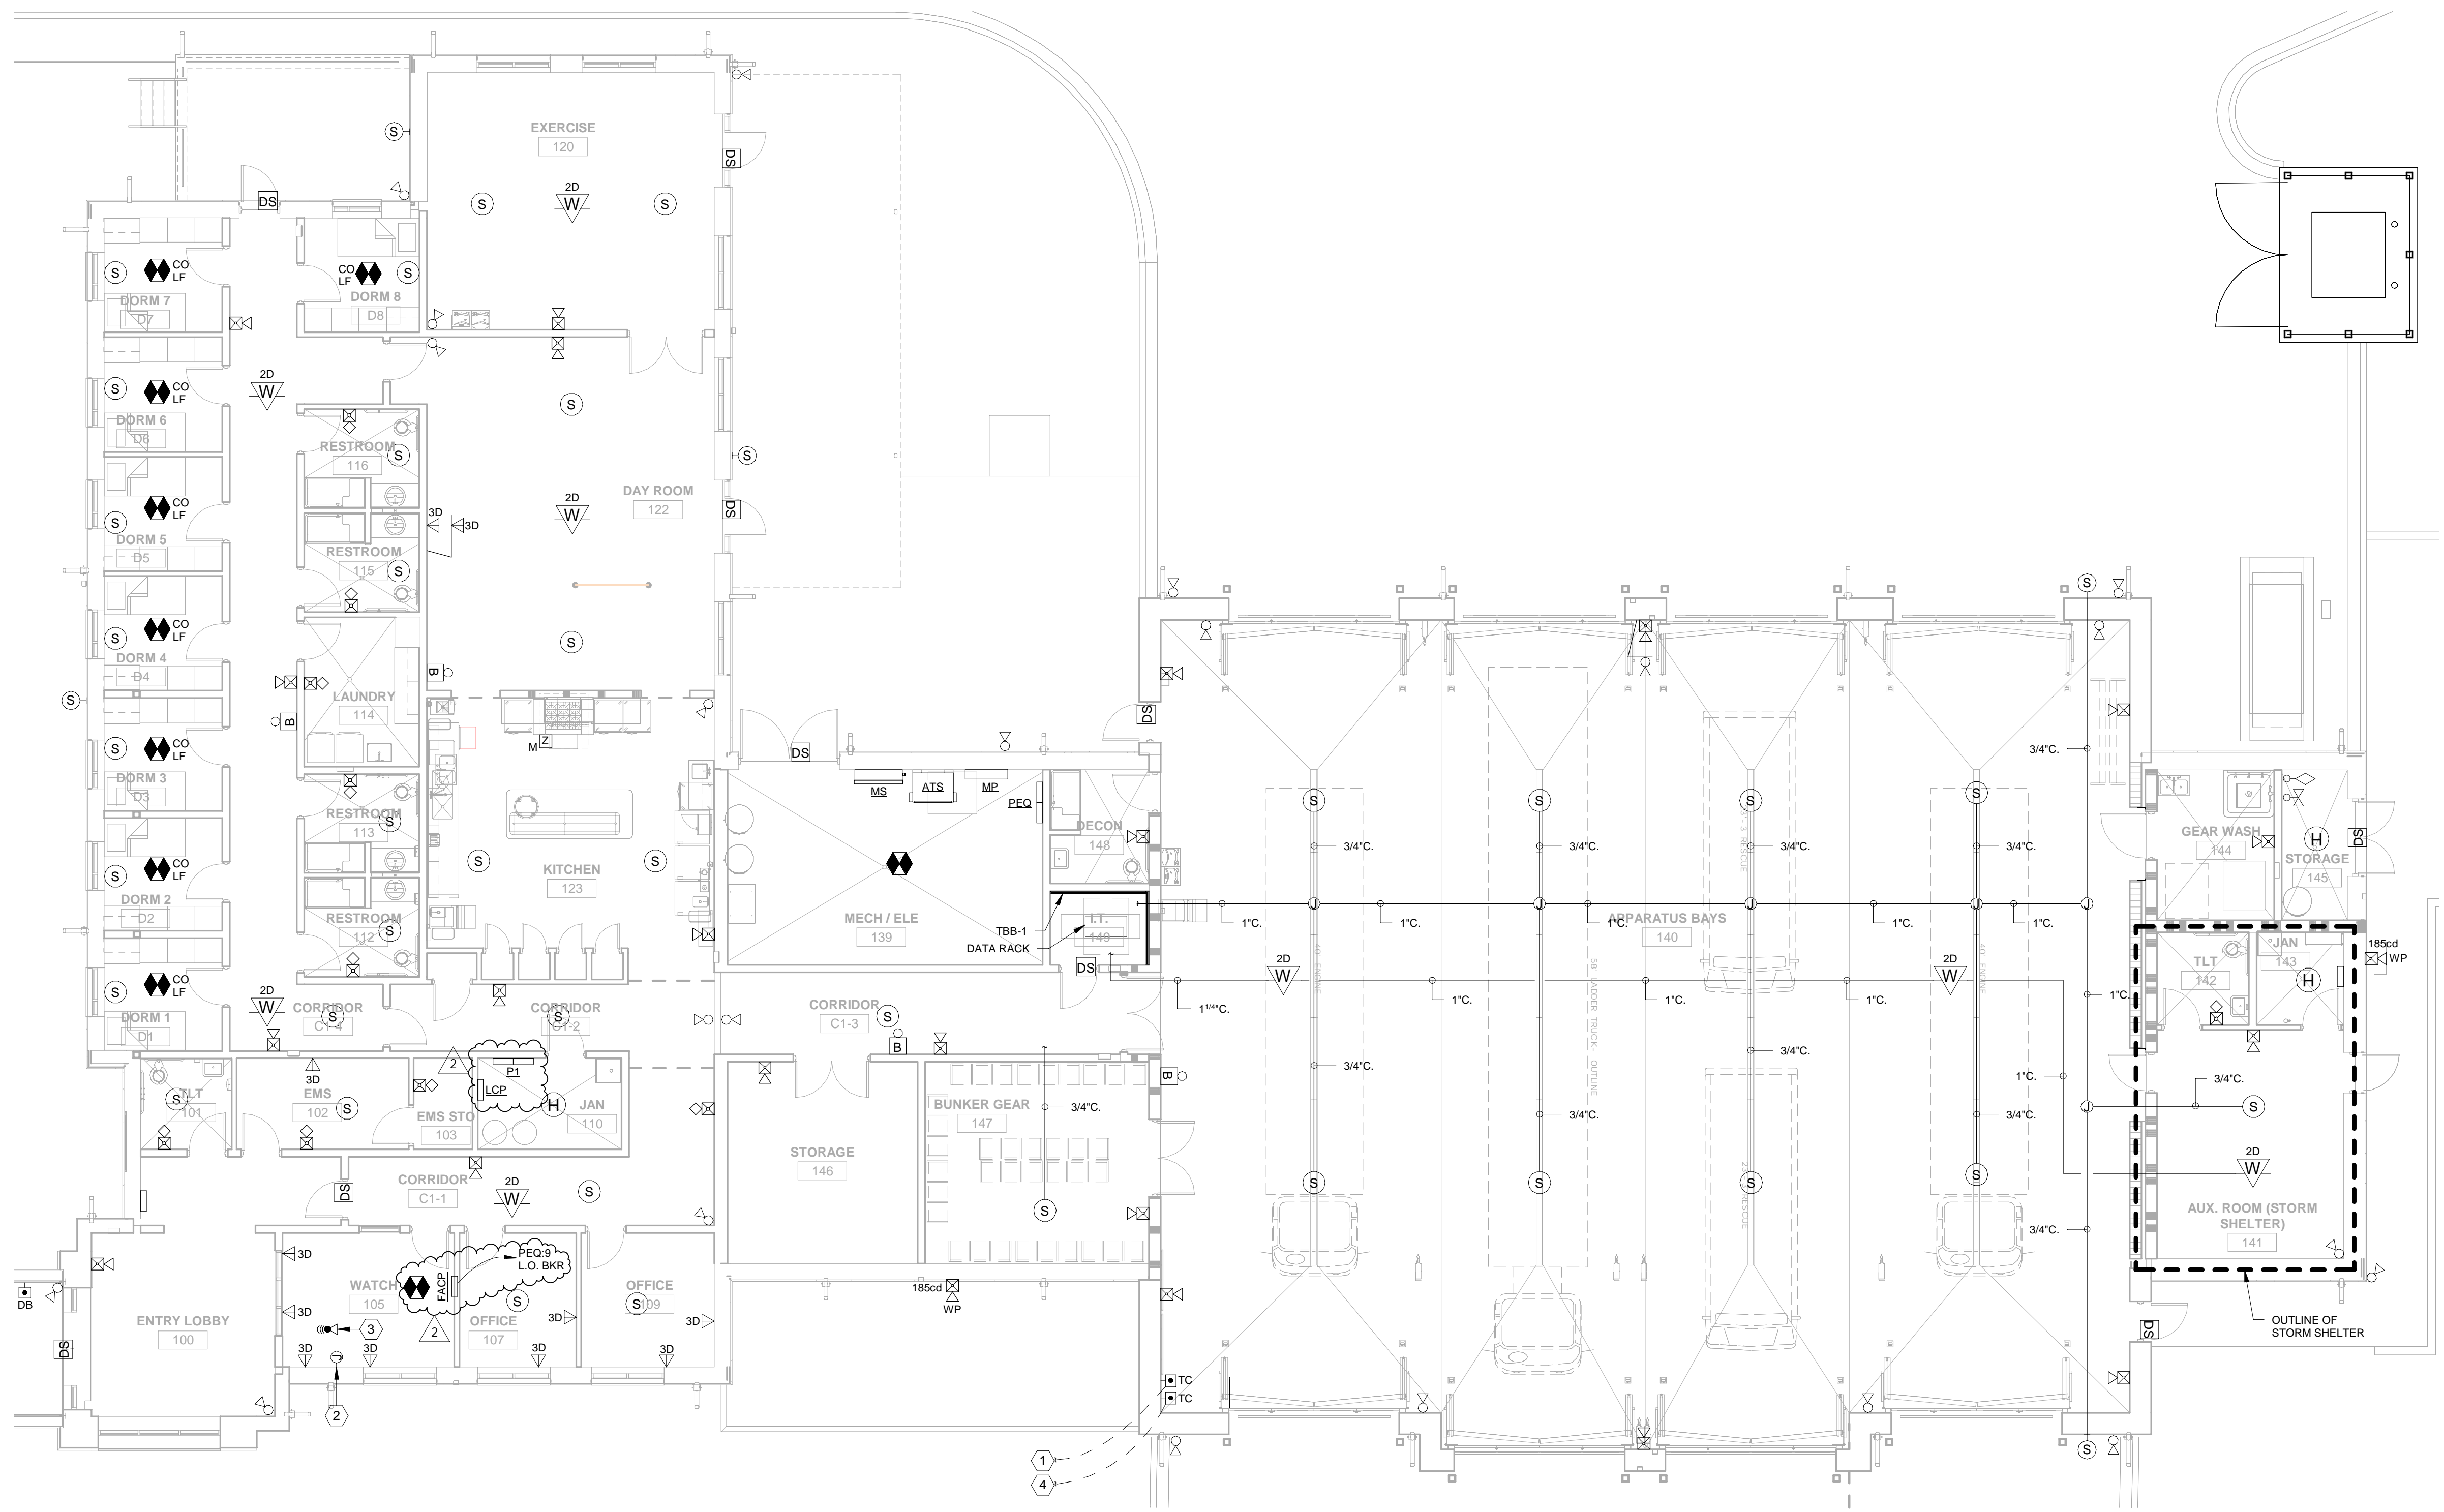

Level 1 Plan - Auxiliary  
 1/8" = 1'-0"

**PLAN NOTES THIS SHEET:**

1. TRAFFIC CONTROL PUSH BUTTON - PROVIDE A 1". STUBBED FROM BUILDING TO TRAFFIC CONTROLLER LOCATED ON SITE. VERIFY EXACT LOCATION PRIOR TO ROUGH-IN.
2. JUNCTION BOX WITH 1". STUBBED UP TO ABOVE CEILING FOR PAGING RADIO. TERMINATE WITH SMOOTH BUSING AND PROVIDE PULLWIRE. VERIFY EXACT LOCATION PRIOR TO ROUGH-IN.
3. PROVIDE 1" CONDUIT PENETRATION THROUGH ROOF FOR ANTENNA. VERIFY EXACT LOCATION AND TERMINATE AS DIRECTED BY RADIO INSTALLER. WEATHER PROOF AND SEAL AS REQUIRED.
4. TRAFFIC CONTROL PUSH-BUTTON FOR SOLAR POWERED BEACON LIGHTS AT ROADWAY. PROVIDE A 1". STUBBED FROM BUILDING TO SOLAR POWERED LIGHTS AT JOHN RODGERS DRIVE (SEE SHEET C1.0). CONTRACTOR SHALL BORE UNDER JOHN RODGERS DRIVE AS REQUIRED. COORDINATE WITH CIVIL SITE CONTRACTOR AS REQUIRED.

**STORM SHELTER NOTES**

CONTRACTOR SHALL INSTALL ALL CONDUITS ENTERING OR EXITING THE STORM SHELTER UNDERGROUND SO THAT THEY DO NOT PENETRATE STORM SHELTER WALLS OR CEILINGS TO THE GREATEST EXTENT POSSIBLE. ANY PENETRATION(S) REQUIRED IN THE STORM SHELTER SHALL BE LESS THAN 2" AND SHALL CONFORM TO ICC 500.




PANEL: PEQ		PANEL AMPS: 400		VOLTAGE: 120 / 208, 3 PHASE, 4 WIRE, 60 HZ		MOUNTING: SURFACE						
TYPE: BQL		M.L.O. N/A		AIC RATING: 22,000		NEMA RATING: NEMA 1						
MAIN BREAKER RATING: 100%		LOCATION: ELECTRICAL ROOM		CALC FAULT CURRENT: 100%		FED FROM: PANEL MP - 2503 BKR						
SOLID NEUTRAL		GROUND BUS: 100%		BREAKER FEATURES: GFI = GROUND FAULT CIRCUIT INTERRUPTER; ST = SHUNT TRIP; TH = TIE HANDLE		AF = ARC FAULT CIRCUIT INTERRUPTER; LO = LOCK-ON DEVICE						
CKT NO	BREAKER	LOAD TYPE	DESCRIPTION	WIRE SIZE	CKT LOAD	PHASE			DESCRIPTION	LOAD TYPE	BREAKER	CKT NO
						A	B	C				
1		EQUIP	VEHICLE EXHAUST SYSTEM	#10	2100	2528			426	#12	HP-1,2,3,4,5,6,7,8,9	2
3	3003	EQUIP			2100		2526		426	A/C		4
5		EQUIP			2100			2807	707	A/C		6
7	201	EQUIP	FIRE ALARM CONTROL PANEL	#12	1000	1707			626	#12	HP-2,3,4,5	8
9	201	LD			500		1126		626	A/C		10
13	201		SPARE			666			666	A/C		12
15	302	MTR	SEPTIC TANK CONTROL PANEL	#10	2400		3066		666	#12	HP-3,1,2,3,4,5	14
17		MTR			2400			4150	1750	A/C		16
19	202	A/C	HP-1		749	2499			1750	#12	ECH-1	18
21		A/C			749		3249		2500	HTG		20
23	202	A/C	HP-2		1414			3914	2500	#10	ECH-2	22
25		A/C			1414	3184			1750	HTG		24
27	202	A/C	HP-3		915		2885		1750	#12	ECH-3	26
29		A/C			915			2067	1152	HTG		28
31		A/C			3936	5088			1152	#12	DEH-1	30
33	503	A/C	CU-1		3936		4119		183	EQUIP		32
35		A/C			3936			4119	183	#12	BCU-1,2,3	34
37	201	EQUIP	GFI-1,2,3,4,5		864	2400			1536	#12	VF-1	36
39		SPACE					1536		1536	#12	VF-2	38
41		SPACE					557		557	#12	VF-3	40
43		MISC			1000	1250			500	#12	WTR HTR	42
45	203	MISC	DECON WASHER		1000		1500		500	#12	WTR HTR	44
47		MISC			1000			3500	2500	#10	TWH-1	46
49	201	MTR	CONDENSATE TRAP PUMP		200	2700			2500	#10	WTR HTR	48
51	202	MISC	IR DRYER		1200	1200						50
53		MTR			1200		1200					52
55		MTR			2100	2100						54
57	303	MTR	AR COMPRESSOR AC-1		2100		2100					56
59		MTR			2100			2100				58
61		SPACE			0			2100				60
63		SPACE			0							62
65		SPACE			0							64
67		SPACE			0							66
69		SPACE			0							68
71		SPACE			0							70
73		SPACE			0							72
75		SPACE			0							74
77		SPACE			0							76
79		SPACE			0							78
81		SPACE			0							80
83		SPACE			0							82
												84
PHASE TOTALS						24100	23087	25040				

PANEL: P1		PANEL AMPS: 300		VOLTAGE: 120 / 208, 3 PHASE, 4 WIRE, 60 HZ		MOUNTING: SURFACE						
TYPE: BQL		M.L.O. N/A		AIC RATING: 18,000		NEMA RATING: NEMA 1						
MAIN BREAKER RATING: 100%		LOCATION: ELECTRICAL ROOM		CALC FAULT CURRENT: 100%		FED FROM: PANEL MP - 2503 BKR						
SOLID NEUTRAL		GROUND BUS: 100%		BREAKER FEATURES: GFI = GROUND FAULT CIRCUIT INTERRUPTER; ST = SHUNT TRIP; TH = TIE HANDLE		AF = ARC FAULT CIRCUIT INTERRUPTER; LO = LOCK-ON DEVICE						
CKT NO	BREAKER	LOAD TYPE	DESCRIPTION	WIRE SIZE	CKT LOAD	PHASE			DESCRIPTION	LOAD TYPE	BREAKER	CKT NO
						A	B	C				
1	201	LTG	LIGHTS	#12	1200	2200			1000	#12	REFRIGERATOR	2
3	201	LTG	LIGHTS	#12	1200		2200		1000	#12	REFRIGERATOR	4
5	201	LTG	LIGHTS	#12	1200			2200	1000	#12	REFRIGERATOR	6
7	201	LTG	LIGHTS	#12	1200	2800			1600	#12	COFFEE BREWER	8
9	201	LTG	LIGHTS	#12	1200		1950		750	#12	ICE MACHINE	10
11	201	LTG	BUILDING MOUNTED LIGHTS	#12	600		2100	1500	1500	#12	KITCHEN APPLIANCE	12
13	202	LTG	PARKING LOT LIGHTS	#8	1000	2500			1500	#12	KITCHEN APPLIANCE	14
15		LTG			1000		2500		1500	#12	MICROWAVE	16
17	201	LTG	FLAG POLE LIGHTS	#12	360			1560	1200	#12	DISHWASHER	18
19	201	LTG	BUILDING MOUNTED LIGHTS	#12	1000	2500			1500	#12	KITCHEN APPLIANCE	20
21	201		SPARE				1500		1500	#12	KITCHEN APPLIANCE	22
23	201	RCPT	CORRIDOR C1-4 RECEP	#12	900			2400	1500	#10	RANGE	24
25	201	RCPT	RESTROOM RECEP	#12	360	1860			1500	#12	RCPT	26
27	201	RCPT	WASHER	#12	500		1040		540	#12	CORRIDOR C1-2 RECEP	28
29	302	GFI	RCPT DRYER	#10	1500			2220	720	#12	CORR. WATCH, EMS RECEP	30
31					1500	2220			720	#12	OFFICE 109 RECEP	32
33	201	RCPT	LAVNDRY RECEP	#12	540		1260		720	#12	OFFICE 110 RECEP	34
35	201	RCPT	RESTROOM RECEP	#12	360			900	540	#12	ENTRY, TOILET RECEP	36
37	201	RCPT	EXERCISE RECEP	#12	540	1080			540	#12	MCH/ELEC RECEP	38
39	201	RCPT	EXERCISE RECEP	#12	360		1080		720	#12	CORR. STOR. BUNKER RECEP	40
41	201	RCPT	EXERCISE RECEP	#12	540			1040	500	#12	APP. BAY WATER COOLER	42
43	201	RCPT	APP. BAY RECEP	#12	540	1440			900	#12	DORM 1 RECEP	44
45	201	RCPT	APP. BAY RECEP	#12	540		1440		900	#12	DORM 2 RECEP	46
47	201	RCPT	COR REELS	#12	900			1800	900	#12	DORM 3 RECEP	48
49	201	RCPT	COR REELS	#12	600	1500			900	#12	DORM 4 RECEP	50
51	201	RCPT	MOTORIZED DOOR	#12	500		1400		900	#12	DORM 5 RECEP	52
53	201	RCPT	MOTORIZED DOOR	#12	500			1400	900	#12	DORM 6 RECEP	54
55	201	RCPT	MOTORIZED DOOR	#12	500	1400			900	#12	DORM 7 RECEP	56
57	201	RCPT	MOTORIZED DOOR	#12	500		1400		900	#12	DORM 8 RECEP	58
59	201	RCPT	MOTORIZED DOOR	#12	500			1220	720	#12	DAY ROOM FLOOR RECEP	60
61	201	RCPT	MOTORIZED DOOR	#12	500	1500			1000	#12	WALL MOUNTED SIGNAGE	62
63	201	RCPT	MOTORIZED DOOR	#12	500		1220		720	#12	WATCH RECEP	64
65	201	RCPT	MOTORIZED DOOR	#12	500			1220	720	#12	WATCH RECEP	66
67	201	RCPT	EXTERIOR RECEP	#12	540	720			180	#12	DECON RECPT	68
69	201	RCPT	EXTERIOR RECEP	#12	360		720		360	#12	TBB RECPT	70
71	201	RCPT	GEAR, STOR., EXT. RECEP	#12	720			1080	360	#12	TBB RECPT	72
73	201	RCPT	TOILET, JAN. RECEP	#12	360	720			360	#12	TBB RECPT	74
75	201	RCPT	STORM SHELTER RECEP	#12	720		1440		720	#12	DAY ROOM RECEP	76
77	201	MTR	CEILING FANS	#12	600			1500	900	#12	DAY ROOM RECEP	78
79	201	MTR	CEILING FANS	#12	800	1300			500	#12	WATER COOLER	80
81	201	LTG	BLDG MOUNTED SIGNAGE	#12	1000			1000			SPACE	82
83	201	LTG	BLDG MOUNTED SIGNAGE	#12	1000				1000		SPACE	84
PHASE TOTALS						23740	20150	21640				

PANEL: MP		PANEL AMPS: 800		VOLTAGE: 120 / 208, 3 PHASE, 4 WIRE, 60 HZ		MOUNTING: SURFACE							
TYPE: CCB		M.L.O. N/A		AIC RATING: 42,000		NEMA RATING: NEMA 1							
MAIN BREAKER RATING: 100%		LOCATION: ELECTRICAL ROOM		CALC FAULT CURRENT: 100%		FED FROM: MAIN SWITCH MS							
SOLID NEUTRAL		GROUND BUS: 100%		BREAKER FEATURES: GFI = GROUND FAULT CIRCUIT INTERRUPTER; ST = SHUNT TRIP; TH = TIE HANDLE		AF = ARC FAULT CIRCUIT INTERRUPTER; LO = LOCK-ON DEVICE							
CKT NO	BREAKER	LOAD TYPE	DESCRIPTION	WIRE SIZE	CKT LOAD	PHASE			DESCRIPTION	LOAD TYPE	BREAKER	CKT NO	
						A	B	C					
1	250/3	PANEL	PANEL P1	#250MCM	23740	27964			4224	#4-	OHP-1	2	
		PANEL		#184G-3/C	20150		24574		4224	#4-		70/3	
		PANEL			21640			25864	4224	#4-			
3	400/3	PANEL	PANEL PEQ	#500MCM	24100	29476			5376	#3-	OHP-2	4	
		PANEL		#184G-3 1/2"C	23087		28463		5376	#4-			
		PANEL			25040			30416	5376	#4-			
5		SPACE							4224	#4-	OHP-3	6	
									4224	#4-			
									4224	#4-			
7		SPACE							5597	#6-	ERU-1	8	
									5597	#10G-1"C			
									5597				
9		SPACE							0				10
11		SPACE							0				12
13		SPACE							0				14
PHASE TOTALS						67261	62658	66101					



Revisions		
No.	Date	Description
1	02.12.25	Addendum #2
2	02.21.25	Addendum #3

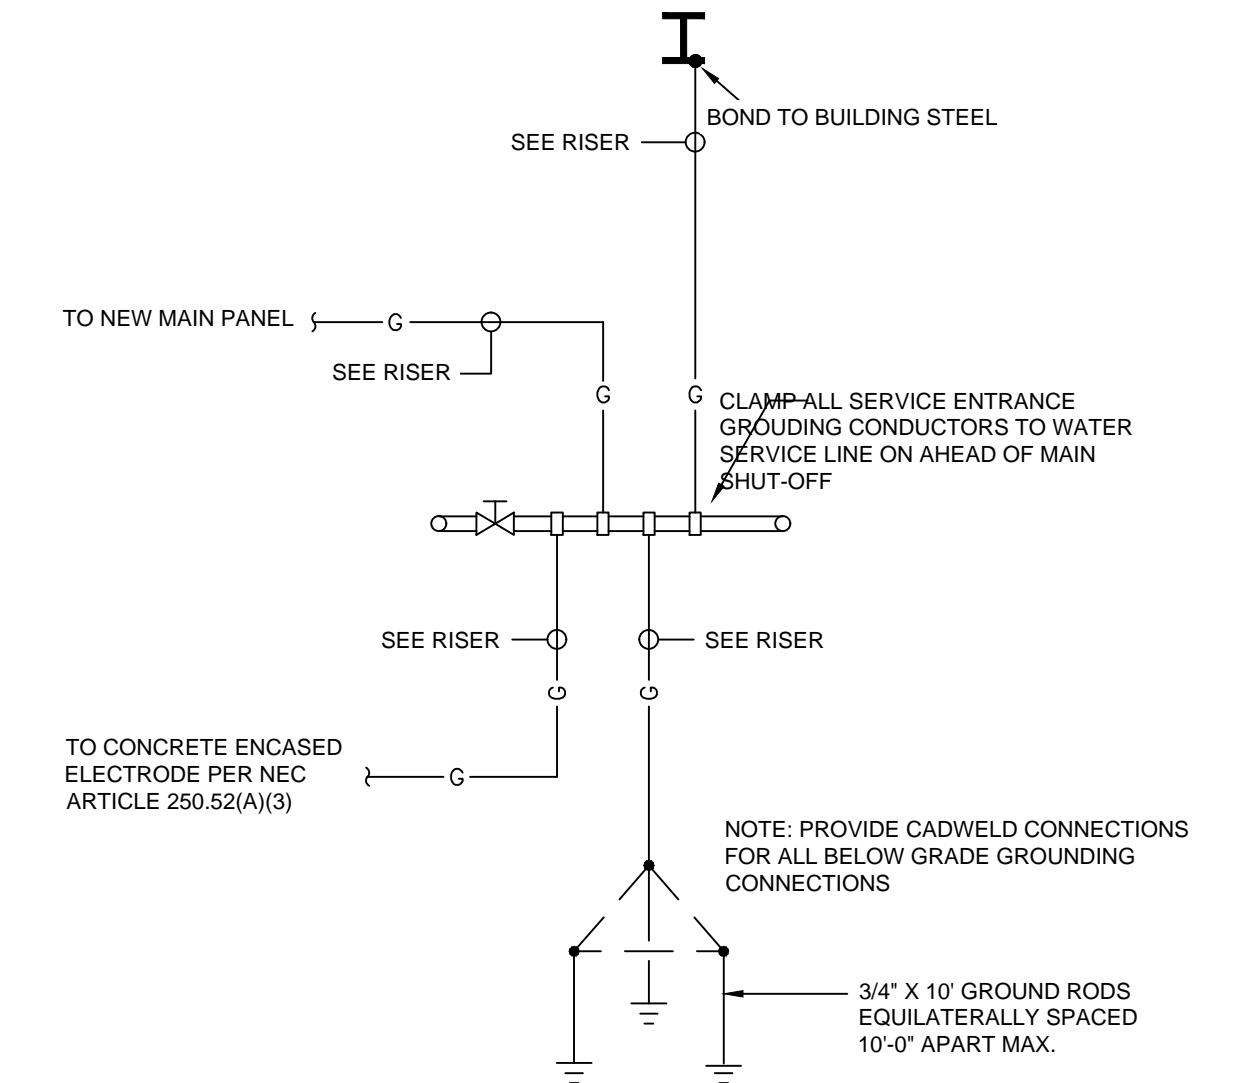

**SERVICE ENTRANCE GROUND DETAIL**  
NOT TO SCALE


100% CD'S

**IRONDALE FIRE STATION #3**  
INT. OF JOHN ROGERS DRIVE & ALTON ROAD  
Birmingham, Alabama  
CITY OF IRONDALE

CHARLES WILLIAMS & ASSOCIATES ARCHITECTS  
PH: 205-250-0700  
3601 8TH AVE. SOUTH BIRMINGHAM, ALABAMA 35222  
FAX: 205-250-0515

SHEET TITLE:  
**Electrical Riser Diagram & Panel Schedules**  
PROJECT NUMBER:  
CWA No. 2023-01  
DATE:  
08/30/24  
DRAWN BY:  
JLB  
CHECKED BY:  
JLB

SHEET NUMBER  
**E301**

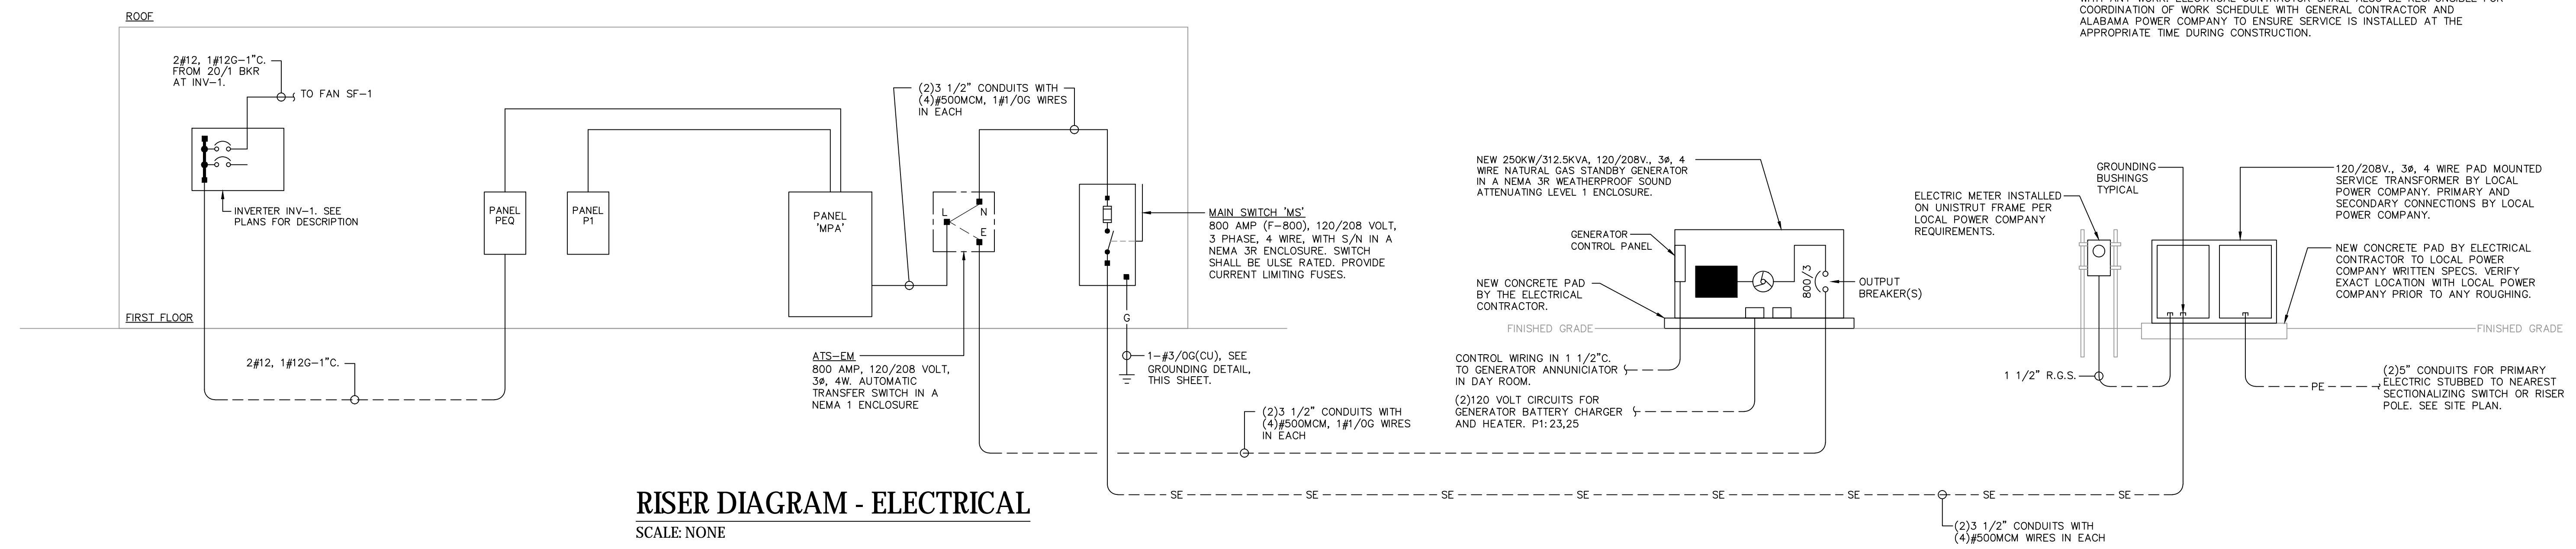

**RISER DIAGRAM - ELECTRICAL**  
SCALE: NONE