

ADDENDUM NO. 2



www.billwarch.com

To: ALL PLAN HOLDERS

April 16th, 2025

Re: Arch Job Number 24001, DCM #2025238, – Plans Dated: 3/31/25

New Lincoln Police Department

Lincoln, Alabama

bill@billwarch.com

256.689.0238

236 Martin Street

Anniston, Alabama 36206

BID DATE: May 8th, 2025

TIME: 2:00 p.m. CDT, Local Time

**LOCATION: Lincoln City Hall
150 Magnolia Street
Lincoln, AL 35096**

The Addendum shall be considered part of the Contract Documents for the above referenced project and shall be incorporated integrally therewith. Where provisions of the following supplementary data differ from those of the original Contract Documents, this addendum shall govern and take precedence. It will be construed that each Proposal is submitted with full knowledge of all modifications and supplemental data specified herein.

ADDENDUM ITEMS:

Item 1. GENERAL

1. Owner requested some modifications: Below is a limited summary of these requests. Contractors to refer to revised drawings issued in this addendum for full scope of work modifications.
 - a. Room A160 Court Magistrate has been divided into two rooms. Conference room 163 is now a fire rated room with fire rated door and frame along with a fire rated ceiling assembly at the trusses. This will be part of the court room shell build out alternate.
 - b. Owner requested additional data outlets and television locations.
 - c. Civil has revised drainage and utility information and clarified other items.
 - d. Pole lighting base bid clarification on the electrical site plan along with conduit locations.
 - e. Door schedule modifications, showing type changes, add doors, add view lites to some doors, and show access controls, and bullet resistant doors.

Item 2. SPECIFICATIONS

1. Following specifications are issued as part of and attached to this addendum:
 - a. **DIVISION 08 - OPENINGS**
087100 DOOR HARDWARE

Item 3. DRAWINGS

1. List of revised sheets issued to replace existing sheets in bid documents. The revised sheets are part of and attached to this addendum

Revised Sheet C3.1 PAVING, SIGNING, STRIPING PLAN

Revised Sheet C4.1 SITE GRADING PLAN

Revised Sheet C5.1 STORM DRAINAGE PLAN


Revised Sheet C6.1 UTILITY PLAN

Revised Sheet A2.4 COURT RM. SHELL PLAN AND RCP & BUILD OUT & 6 OFFICE BUILD OUT

Revised Sheet A7.1 DOOR AND FRAME TYPES

Revised Sheet M3.1 HVAC
Revised Sheet E00.1 ELECTRICAL LEGEND AND NOTES
Revised Sheet E00.2 ELECTRICAL DETAILS
Revised Sheet E00.3 ELECTRICAL DETAILS
Revised Sheet E00.4 LUMINAIRE SCHEDULE & LIGHTING CONTROLS
Revised Sheet E00.5 RISER DIAGRAM
Revised Sheet E10.0 FLOOR PLAN – LIGHTING
Revised Sheet E10.1 FLOOR PLAN – POWER
Revised Sheet E10.2 FLOOR PLAN AUXILIARY
Revised Sheet E10.3 ATTIC PLAN – ELECTRICAL
Revised Sheet E11.0 PARTIAL ALTERNATE FLOOR PLANS – ELECTRICAL
Revised Sheet E20.0 SITE PLAN – ELECTRICAL
Revised Sheet E20.1 SITE PLAN – ALTERNATE ELECTRICAL

Sincerely,

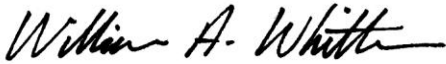

Bill Whittaker, AIA
Cc: Project File



ADDENDUM

To: Bill Whittaker
From: Heather Page, PE
Subject: New City of Lincoln Police Department - A/E# 24001
(Whorton Project #23222)
Date: April 16, 2025


Please include the following in your next addendum:

PLUMBING:

1. **Reference Sheets P2.1 / P3.1:** Reference revised architectural plans for location of new fire rated walls and ceilings.

HVAC:


1. **Reference Sheet M3.1:** Revise HVAC as per attached revised plan.
2. **Reference Sheet M1.2:** Reference Heat Pump Equipment Electrical Data. Change HP-13 indoor unit voltage to 208/230-1-60.

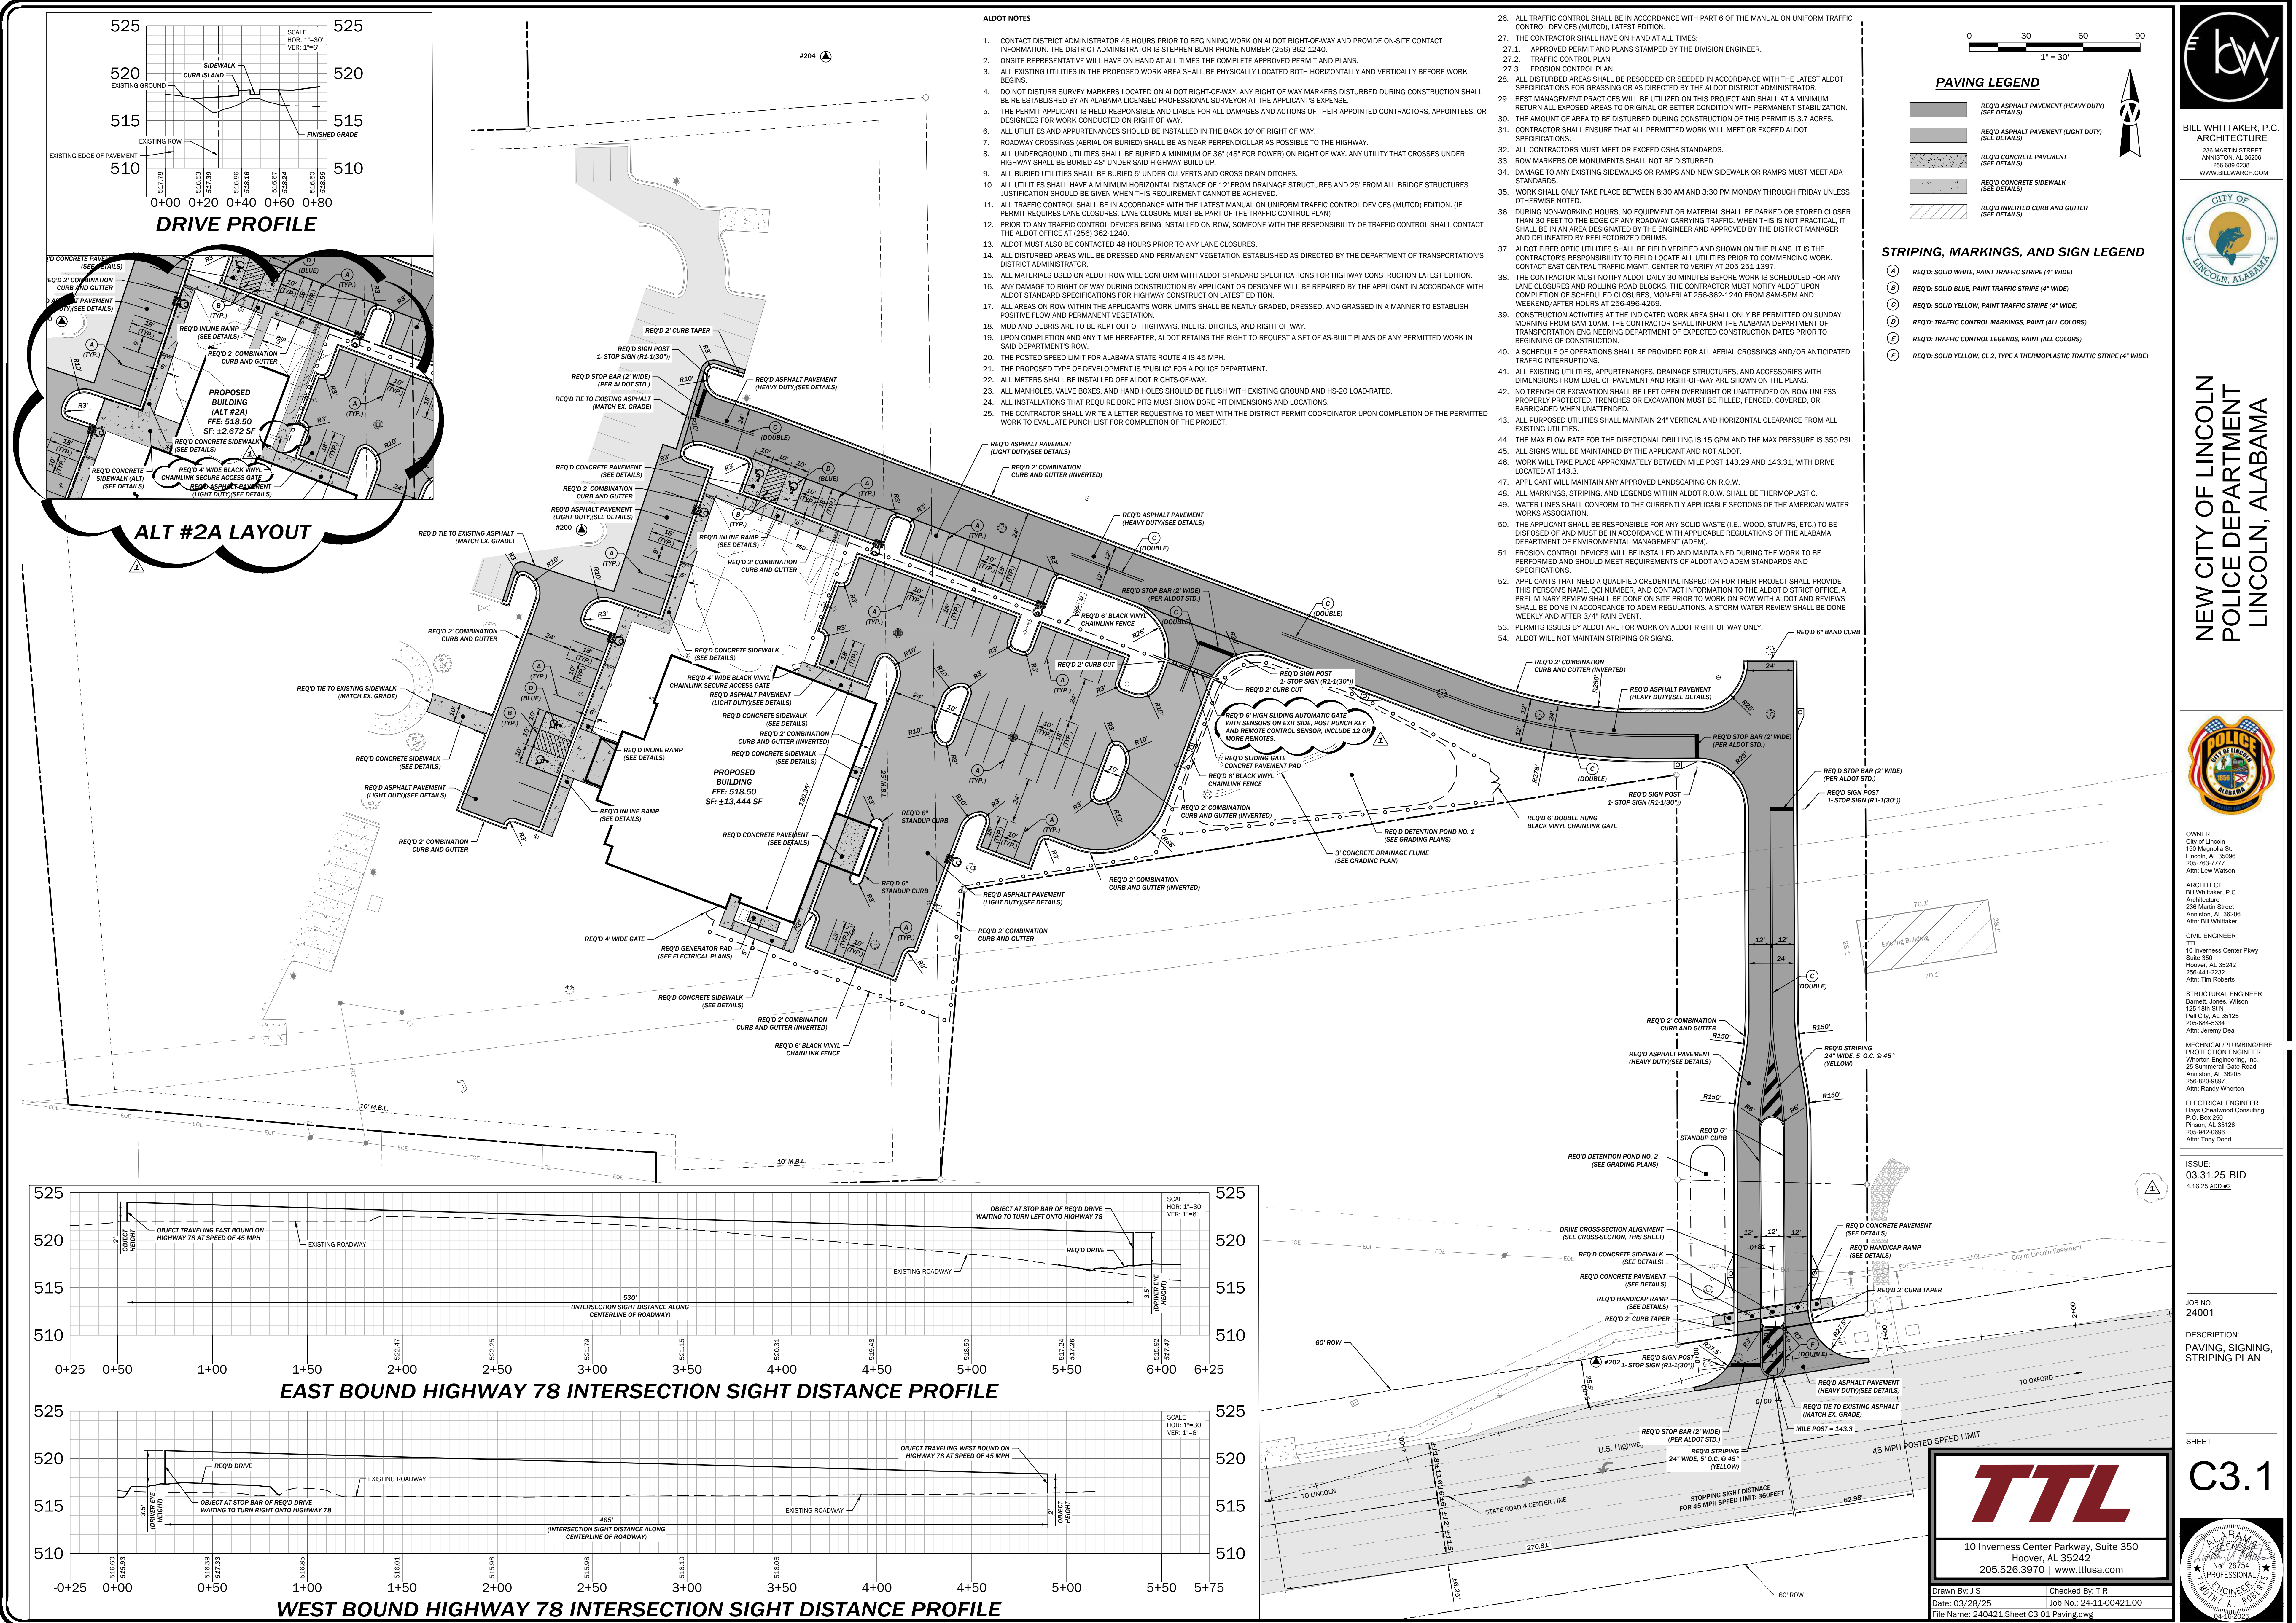

ALDOT NOTES

1. CONTACT DISTRICT ADMINISTRATOR 48 HOURS PRIOR TO BEGINNING WORK ON ALDOT RIGHT-OF-WAY AND PROVIDE ON-SITE CONTACT INFORMATION. THE DISTRICT ADMINISTRATOR IS STEPHEN BLAIR PHONE NUMBER (256) 362-1240.
2. ON-SITE REPRESENTATIVE WILL HAVE ON HAND AT ALL TIMES THE COMPLETE APPROVED PERMIT AND PLANS.
3. ALL EXISTING UTILITIES IN THE PROPOSED WORK AREA SHALL BE PHYSICALLY LOCATED BOTH HORIZONTALLY AND VERTICALLY BEFORE WORK BEGINS.
4. DO NOT DISTURB SURVEY MARKERS LOCATED ON ALDOT RIGHT-OF-WAY. ANY RIGHT-OF-WAY MARKERS DISTURBED DURING CONSTRUCTION SHALL BE RE-ESTABLISHED BY AN ALABAMA LICENSED PROFESSIONAL SURVEYOR AT THE APPLICANT'S EXPENSE.
5. THE PERMIT APPLICANT IS HELD RESPONSIBLE AND LIABLE FOR ALL DAMAGES AND ACTIONS OF THEIR APPOINTED CONTRACTORS, APPOINTEES, OR DESIGNEES FOR WORK CONDUCTED ON RIGHT-OF-WAY.
6. ALL UTILITIES AND APPURTENANCES SHOULD BE INSTALLED IN THE BACK 10' OF RIGHT-OF-WAY.
7. ROADWAY CROSSINGS (AERIAL OR BURIED) SHALL BE AS NEAR PERPENDICULAR AS POSSIBLE TO THE HIGHWAY.
8. ALL UNDERGROUND UTILITIES SHALL BE BURIED A MINIMUM OF 36" (48" FOR POWER) ON RIGHT-OF-WAY. ANY UTILITY THAT CROSSES UNDER HIGHWAY SHALL BE BURIED 48" UNDER SAID HIGHWAY BUILD-UP.
9. ALL BURIED UTILITIES SHALL BE BURIED 5' UNDER CULVERTS AND CROSS DRAIN DITCHES.
10. ALL UTILITIES SHALL HAVE A MINIMUM HORIZONTAL DISTANCE OF 12' FROM DRAINAGE STRUCTURES AND 25' FROM ALL BRIDGE STRUCTURES. JUSTIFICATION SHOULD BE GIVEN WHEN THIS REQUIREMENT CANNOT BE ACHIEVED.
11. ALL TRAFFIC CONTROL SHALL BE IN ACCORDANCE WITH THE LATEST MANUAL ON UNIFORM TRAFFIC CONTROL DEVICES (MUTCD), EDITION, (IF PERMIT REQUIRES LANE CLOSURES, LANE CLOSURE MUST BE PART OF THE TRAFFIC CONTROL PLAN).
12. PRIOR TO ANY TRAFFIC CONTROL DEVICES BEING INSTALLED ON ROW, SOMEONE WITH THE RESPONSIBILITY OF TRAFFIC CONTROL SHALL CONTACT THE ALDOT OFFICE AT (256) 362-1240.
13. ALDOT MUST ALSO BE CONTACTED 48 HOURS PRIOR TO ANY LANE CLOSURES.
14. ALL DISTURBED AREAS WILL BE DRESSED AND PERMANENT VEGETATION ESTABLISHED AS DIRECTED BY THE DEPARTMENT OF TRANSPORTATION'S DISTRICT ADMINISTRATOR.
15. ALL MATERIALS USED ON ALDOT ROW WILL CONFORM WITH ALDOT STANDARD SPECIFICATIONS FOR HIGHWAY CONSTRUCTION LATEST EDITION.
16. ANY DAMAGE TO RIGHT-OF-WAY DURING CONSTRUCTION BY APPLICANT OR DESIGNEE WILL BE REPAIRED BY THE APPLICANT IN ACCORDANCE WITH ALDOT STANDARD SPECIFICATIONS FOR HIGHWAY CONSTRUCTION LATEST EDITION.
17. ALL AREAS ON ROW WITHIN THE APPLICANT'S WORK LIMITS SHALL BE NEATLY GRADED, DRESSED, AND GRASSED IN A MANNER TO ESTABLISH POSITIVE FLOW AND PERMANENT VEGETATION.
18. MUD AND DEBRIS ARE TO BE KEPT OUT OF HIGHWAYS, INLETS, DITCHES, AND RIGHT-OF-WAY.
19. UPON COMPLETION AND ANY TIME HEREFTER, ALDOT RETAINS THE RIGHT TO REQUEST A SET OF AS-BUILT PLANS OF ANY PERMITTED WORK IN SAID DEPARTMENT'S ROW.
20. THE POSTED SPEED LIMIT FOR ALABAMA STATE ROUTE 4 IS 45 MPH.
21. THE PROPOSED TYPE OF DEVELOPMENT IS "PUBLIC" FOR A POLICE DEPARTMENT.
22. ALL METERS SHALL BE INSTALLED OFF ALDOT RIGHTS-OF-WAY.
23. ALL MANHOLES, VALVE BOXES, AND HAND HOLES SHOULD BE FLUSH WITH EXISTING GROUND AND HS-20 LOAD-RATED.
24. ALL INSTALLATIONS THAT REQUIRE BORE PITS MUST SHOW BORE PIT DIMENSIONS AND LOCATIONS.
25. THE CONTRACTOR SHALL WRITE A LETTER REQUESTING TO MEET WITH THE DISTRICT PERMIT COORDINATOR UPON COMPLETION OF THE PERMITTED WORK TO EVALUATE PUNCH LIST FOR COMPLETION OF THE PROJECT.

26. ALL TRAFFIC CONTROL SHALL BE IN ACCORDANCE WITH PART 6 OF THE MANUAL ON UNIFORM TRAFFIC CONTROL DEVICES (MUTCD), LATEST EDITION.
27. THE CONTRACTOR SHALL HAVE ON HAND AT ALL TIMES:
 - 27.1. APPROVED PERMIT AND PLANS STAMPED BY THE DIVISION ENGINEER.
 - 27.2. TRAFFIC CONTROL PLAN.
 - 27.3. EROSION CONTROL PLAN.
28. ALL DISTURBED AREAS SHALL BE RESODDED OR SEEDED IN ACCORDANCE WITH THE LATEST ALDOT SPECIFICATIONS FOR GRASSING OR AS DIRECTED BY THE ALDOT DISTRICT ADMINISTRATOR.
29. BEST MANAGEMENT PRACTICES WILL BE UTILIZED ON THIS PROJECT AND SHALL AT A MINIMUM RETURN ALL EXPOSED AREAS TO ORIGINAL OR BETTER CONDITION WITH PERMANENT STABILIZATION.
30. THE AMOUNT OF AREA TO BE DISTURBED DURING CONSTRUCTION OF THIS PERMIT IS 3.7 ACRES.
31. CONTRACTOR SHALL ENSURE THAT ALL PERMITTED WORK WILL MEET OR EXCEED ALDOT SPECIFICATIONS.
32. ALL CONTRACTORS MUST MEET OR EXCEED OSHA STANDARDS.
33. ROW MARKERS OR MONUMENTS SHALL NOT BE DISTURBED.
34. DAMAGE TO ANY EXISTING SIDEWALKS OR RAMPS AND NEW SIDEWALK OR RAMPS MUST MEET ADA STANDARDS.
35. WORK SHALL ONLY TAKE PLACE BETWEEN 8:30 AM AND 3:30 PM MONDAY THROUGH FRIDAY UNLESS OTHERWISE NOTED.
36. DURING NON-WORKING HOURS, NO EQUIPMENT OR MATERIAL SHALL BE PARKED OR STORED CLOSER THAN 30 FEET TO THE EDGE OF ANY ROADWAY CARRYING TRAFFIC. WHEN THIS IS NOT PRACTICAL, IT SHALL BE IN AN AREA DESIGNATED BY THE ENGINEER AND APPROVED BY THE DISTRICT MANAGER AND DELINEATED BY REFLECTORIZED DRUMS.
37. ALDOT FIBER OPTIC UTILITIES SHALL BE FIELD VERIFIED AND SHOWN ON THE PLANS. IT IS THE CONTRACTOR'S RESPONSIBILITY TO FIELD LOCATE ALL UTILITIES PRIOR TO COMMENCING WORK. CONTACT EAST CENTRAL TRAFFIC MGMT. CENTER TO VERIFY AT 205-251-1387.
38. THE CONTRACTOR MUST NOTIFY ALDOT DAILY 30 MINUTES BEFORE WORK IS SCHEDULED FOR ANY LANE CLOSURES AND ROLLING ROAD BLOCKS. THE CONTRACTOR MUST NOTIFY ALDOT UPON COMPLETION OF SCHEDULED CLOSURES, MON-FRI AT 256-362-1240 FROM 8AM-5PM AND WEEKEND/AFTER HOURS AT 256-496-4269.
39. CONSTRUCTION ACTIVITIES AT THE INDICATED WORK AREA SHALL ONLY BE PERMITTED ON SUNDAY MORNING FROM 6AM-10AM. THE CONTRACTOR SHALL INFORM THE ALABAMA DEPARTMENT OF TRANSPORTATION ENGINEERING DEPARTMENT OF EXPECTED CONSTRUCTION DATES PRIOR TO BEGINNING OF CONSTRUCTION.
40. A SCHEDULE OF OPERATIONS SHALL BE PROVIDED FOR ALL AERIAL CROSSINGS AND/OR ANTICIPATED TRAFFIC INTERRUPTIONS.
41. ALL EXISTING UTILITIES, APPURTENANCES, DRAINAGE STRUCTURES, AND ACCESSORIES WITH DIMENSIONS FROM EDGE OF PAVEMENT AND RIGHT-OF-WAY ARE SHOWN ON THE PLANS.
42. NO TRENCH OR EXCAVATION SHALL BE LEFT OPEN OVERNIGHT OR UNATTENDED ON ROW UNLESS PROPERLY PROTECTED. TRENCHES OR EXCAVATION MUST BE FILLED, FENCED, COVERED, OR BARRICADED WHEN UNATTENDED.
43. ALL PURPOSED UTILITIES SHALL MAINTAIN 24" VERTICAL AND HORIZONTAL CLEARANCE FROM ALL EXISTING UTILITIES.
44. THE MAX FLOW RATE FOR THE DIRECTIONAL DRILLING IS 15 GPM AND THE MAX PRESSURE IS 350 PSI.
45. ALL SIGNS WILL BE MAINTAINED BY THE APPLICANT AND NOT ALDOT.
46. WORK WILL TAKE PLACE APPROXIMATELY BETWEEN MILE POST 143.29 AND 143.31, WITH DRIVE LOCATED AT 143.3.
47. APPLICANT WILL MAINTAIN ANY APPROVED LANDSCAPING ON R.O.W.
48. ALL MARKINGS, STRIPING, AND LEGENDS WITHIN ALDOT R.O.W. SHALL BE THERMOPLASTIC.
49. WATER LINES SHALL CONFORM TO THE CURRENTLY APPLICABLE SECTIONS OF THE AMERICAN WATER WORKS ASSOCIATION.
50. THE APPLICANT SHALL BE RESPONSIBLE FOR ANY SOLID WASTE (I.E., WOOD, STUMPS, ETC.) TO BE DISPOSED OF AND MUST BE IN ACCORDANCE WITH APPLICABLE REGULATIONS OF THE ALABAMA DEPARTMENT OF ENVIRONMENTAL MANAGEMENT (ADEM).
51. EROSION CONTROL DEVICES WILL BE INSTALLED AND MAINTAINED DURING THE WORK TO BE PERFORMED AND SHOULD MEET REQUIREMENTS OF ALDOT AND ADEM STANDARDS AND SPECIFICATIONS.
52. APPLICANTS THAT NEED A QUALIFIED CREDENTIAL INSPECTOR FOR THEIR PROJECT SHALL PROVIDE THIS PERSON'S NAME, QQ NUMBER, AND CONTACT INFORMATION TO THE ALDOT DISTRICT OFFICE. A PRELIMINARY REVIEW SHALL BE DONE ON SITE PRIOR TO WORK ON ROW WITH ALDOT AND REVIEWS SHALL BE DONE IN ACCORDANCE TO ADEM REGULATIONS. A STORM WATER REVIEW SHALL BE DONE WEEKLY AND AFTER 31/41 RAIN EVENT.
53. PERMITS ISSUED BY ALDOT ARE FOR WORK ON ALDOT RIGHT-OF-WAY ONLY.
54. ALDOT WILL NOT MAINTAIN STRIPING OR SIGNS.

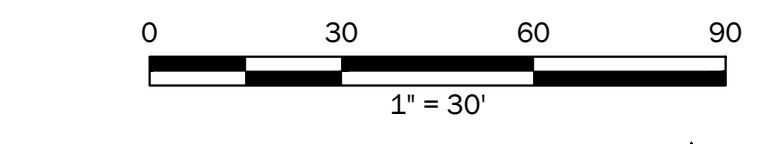

PAVING LEGEND

- REQ'D ASPHALT PAVEMENT (HEAVY DUTY) (SEE DETAILS)
- REQ'D ASPHALT PAVEMENT (LIGHT DUTY) (SEE DETAILS)
- REQ'D CONCRETE PAVEMENT (SEE DETAILS)
- REQ'D CONCRETE SIDEWALK (SEE DETAILS)
- REQ'D INVERTED CURB AND GUTTER (SEE DETAILS)

STRIPING, MARKINGS, AND SIGN LEGEND

- A REQ'D: SOLID WHITE, PAINT TRAFFIC STRIPE (4" WIDE)
- B REQ'D: SOLID BLUE, PAINT TRAFFIC STRIPE (4" WIDE)
- C REQ'D: SOLID YELLOW, PAINT TRAFFIC STRIPE (4" WIDE)
- D REQ'D: TRAFFIC CONTROL MARKINGS, PAINT (ALL COLORS)
- E REQ'D: TRAFFIC CONTROL LEGENDS, PAINT (ALL COLORS)
- F REQ'D: SOLID YELLOW, CL 2, TYPE A THERMOPLASTIC TRAFFIC STRIPE (4" WIDE)

BILL WHITTAKER, P.C. ARCHITECTURE
236 MARTIN STREET
ANNISTON, AL 36206
WWW.BILLWARCH.COM

CITY OF LINCOLN, ALABAMA

**NEW CITY OF LINCOLN
POLICE DEPARTMENT
LINCOLN, ALABAMA**

OWNER
City of Lincoln
150 Magnolia St.
Lincoln, AL 35596
256-763-7777
Attn: Lew Watson

ARCHITECT
Bill Whittaker, P.C. Architecture
236 Martin Street
Anniston, AL 36206
Attn: Bill Whittaker

CIVIL ENGINEER
TTL
10 Inverness Center Pkwy
Suite 350
Hoover, AL 35242
256-441-2232
Attn: Tim Roberts

STRUCTURAL ENGINEER
Barnett, Jones, Wilson
125 18th St N
Palm City, AL 35125
205-884-5334
Attn: Jeremy Deal

MECHANICAL/PLUMBING/FIRE PROTECTION ENGINEER
Whorton Engineering, Inc.
25 Summerall Gate Road
Anniston, AL 36205
256-820-9897
Attn: Randy Whorton

ELECTRICAL ENGINEER
Hays Chathamwood Consulting
P.O. Box 250
Prison, AL 35126
256-842-2096
Attn: Tony Dodd

ISSUE:
03.31.25 BID
4.16.25 ADD #2

JOB NO.
24001

DESCRIPTION:
PAVING, SIGNING, STRIPING PLAN

SHEET
C3.1

TTL
10 Inverness Center Parkway, Suite 350
Hoover, AL 35242
205.526.3970 | www.ttlusa.com

Drawn By: J S Checked By: T R
Date: 03/28/25 Job No.: 24-11-00421.00
File Name: 240421.Sheet C3 01 Paving.dwg



1



1



NOTES:

1. ALL CONCRETE PAVEMENT SHALL BE BEDDED ON STONE AS REQUIRED FOR 2" COMBINATION CURB AND GUTTER.
2. ALL REQUIREMENTS FOR COMPACTION, BEDDING, STONE, CONCRETE, ETC. SET FORTH IN THE 2" COMBINATION CURB AND CUTTER SHALL APPLY TO THE CONCRETE FLUME.

NOTES:

1. ALL CONCRETE PAVEMENT SHALL BE BEDDED ON STONE AS REQUIRED FOR 2" COMBINATION CURB AND GUTTER.
2. ALL REQUIREMENTS FOR COMPACTION, BEDDING, STONE, CONCRETE, ETC. SET FORTH IN THE 2" COMBINATION CURB AND CUTTER SHALL APPLY TO THE CONCRETE FLUME.

3/21/2024 11:29:03 AM

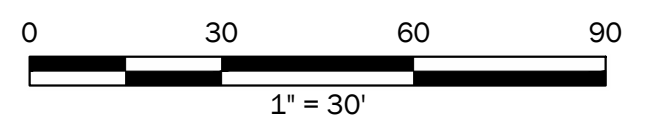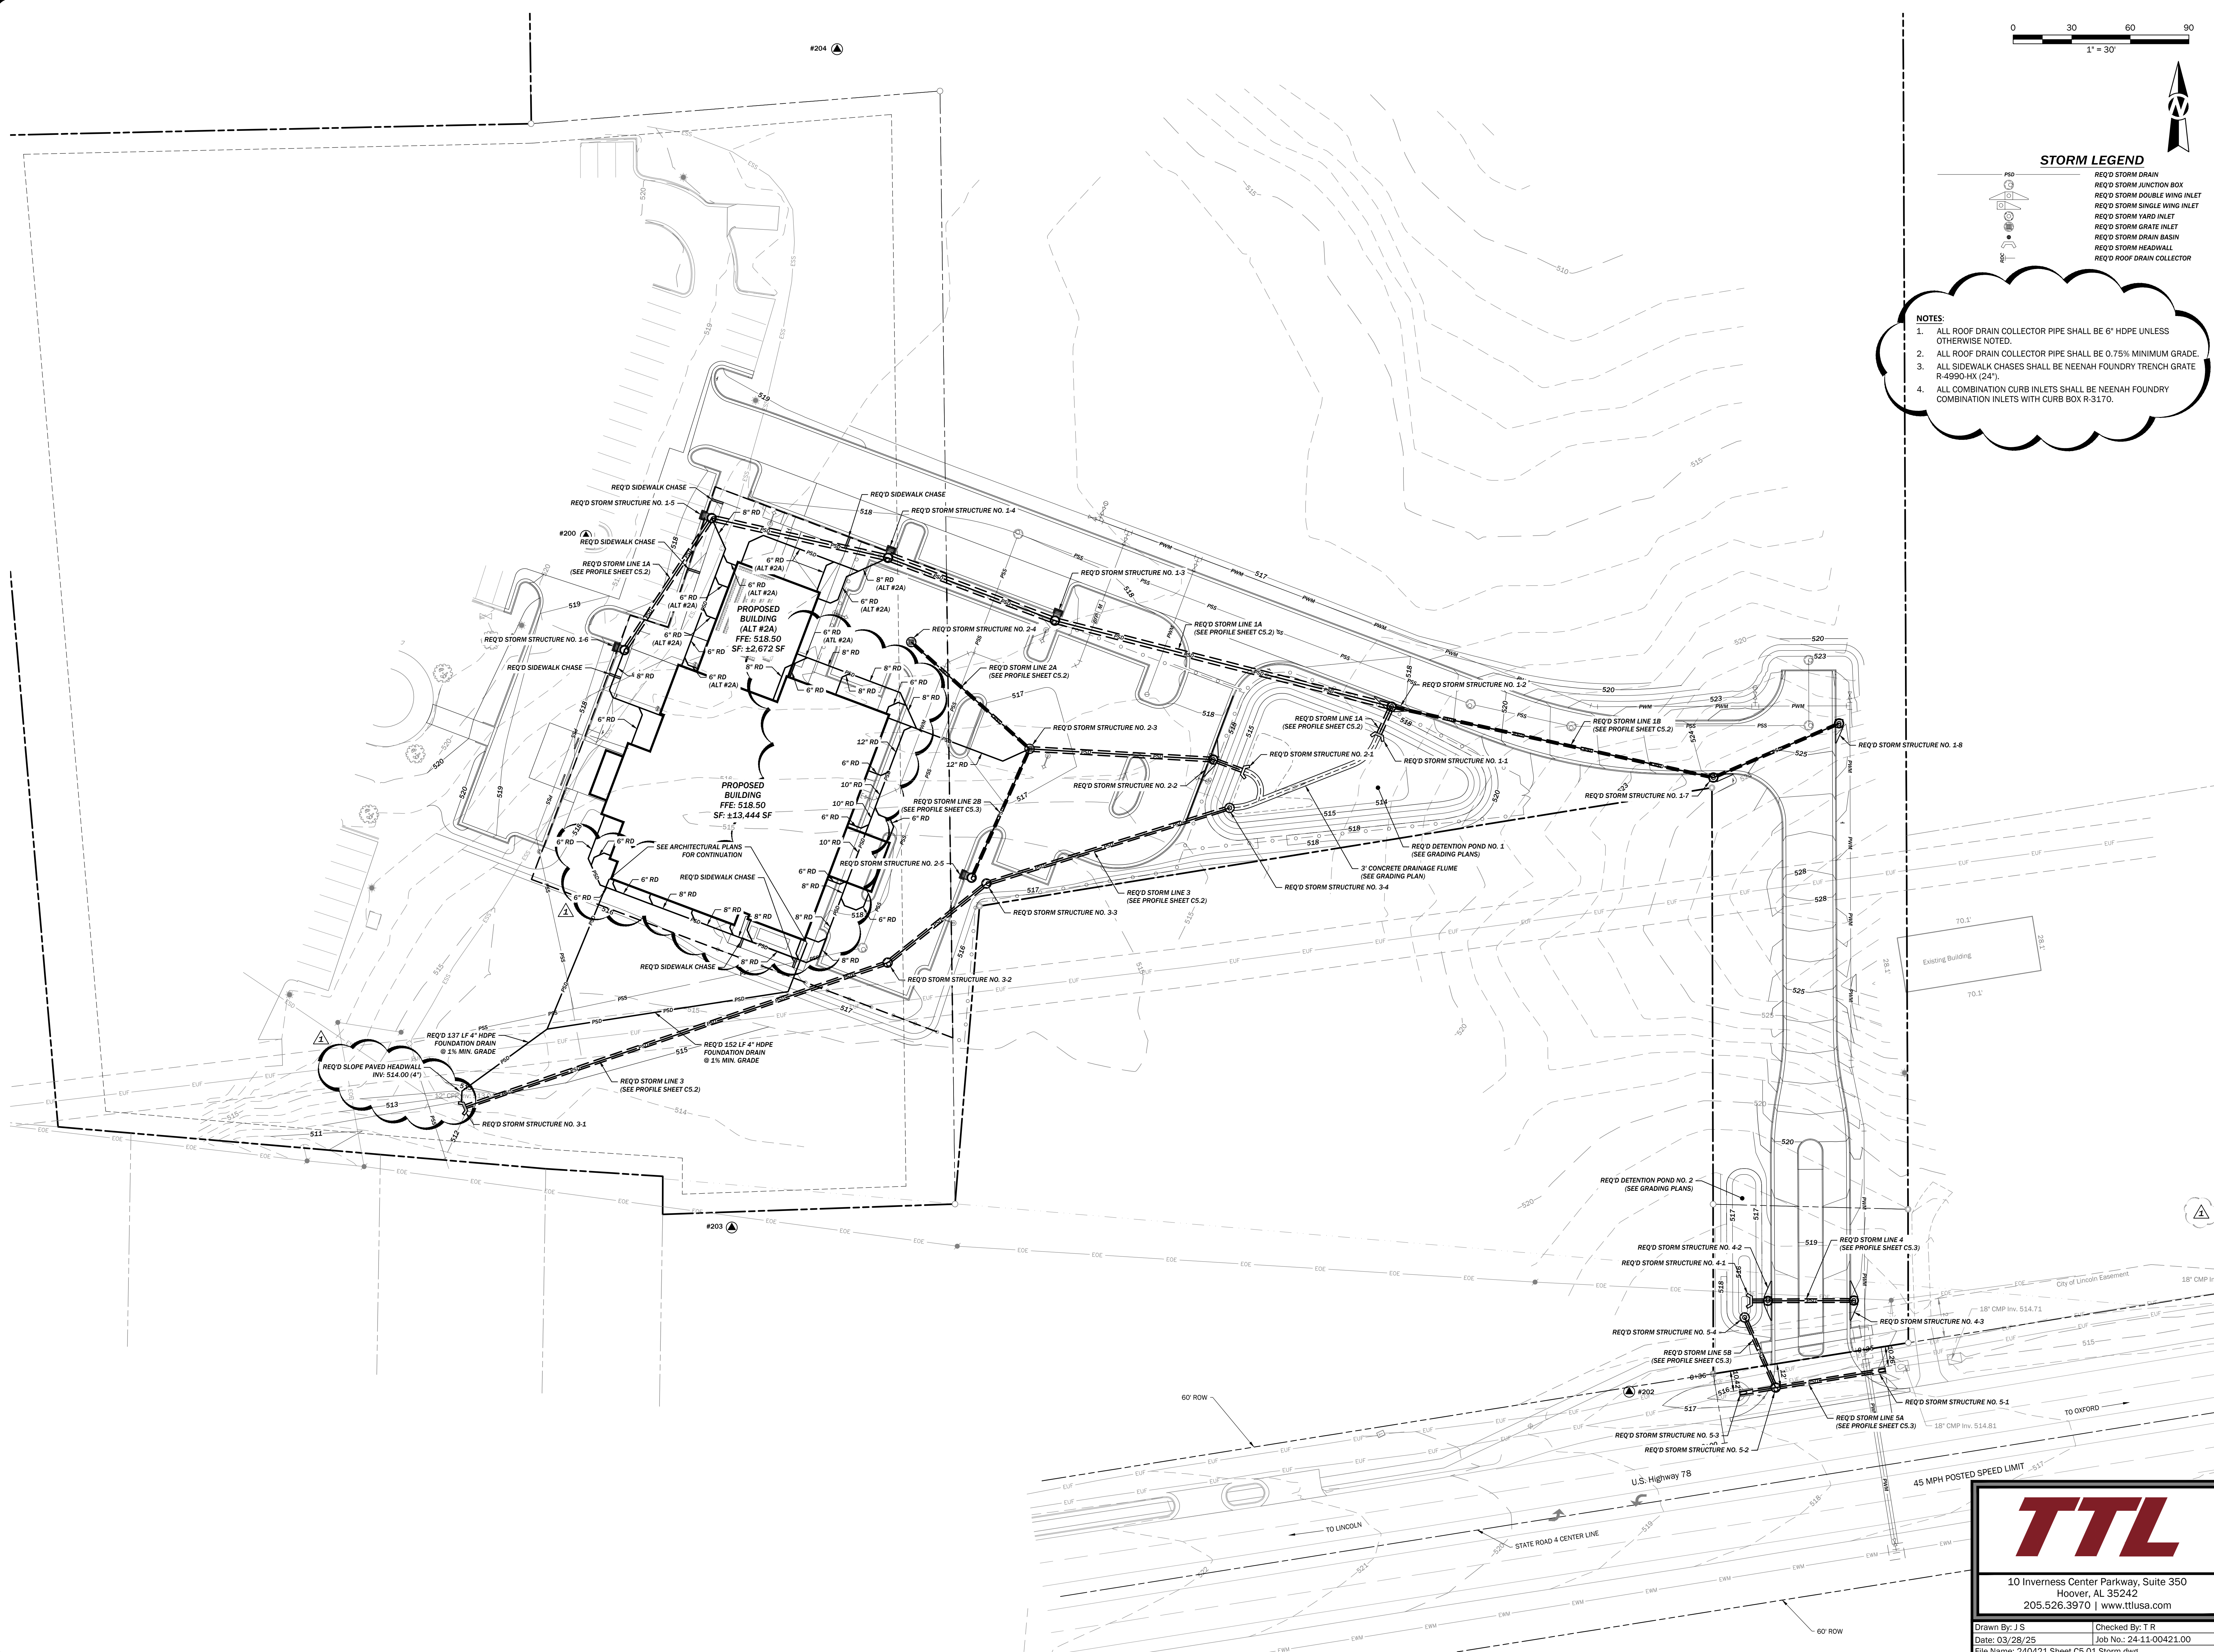

STORM LEGEND

- REQ'D STORM DRAIN
- REQ'D STORM JUNCTION BOX
- REQ'D STORM DOUBLE WING INLET
- REQ'D STORM SINGLE WING INLET
- REQ'D STORM YARD INLET
- REQ'D STORM GRATE INLET
- REQ'D STORM DRAIN BASIN
- REQ'D STORM HEADWALL
- REQ'D ROOF DRAIN COLLECTOR

- NOTES:**
1. ALL ROOF DRAIN COLLECTOR PIPE SHALL BE 6" HDPE UNLESS OTHERWISE NOTED.
 2. ALL ROOF DRAIN COLLECTOR PIPE SHALL BE 0.75% MINIMUM GRADE.
 3. ALL SIDEWALK CHASES SHALL BE NEENAH FOUNDRY TRENCH GRATE R-4990-HX (24").
 4. ALL COMBINATION CURB INLETS SHALL BE NEENAH FOUNDRY COMBINATION INLETS WITH CURB BOX R-5170.

BILL WHITTAKER, P.C.
ARCHITECTURE
236 MARTIN STREET
ANNISTON, AL 36206
256.689.0338
WWW.BILLWARCH.COM

CITY OF LINCOLN, ALABAMA

**NEW CITY OF LINCOLN
POLICE DEPARTMENT
LINCOLN, ALABAMA**

OWNER
City of Lincoln
150 Magnolia St.
Lincoln, AL 35096
256-763-7777
Attn: Lew Watson

ARCHITECT
Bill Whittaker, P.C.
Architecture
236 Martin Street
Anniston, AL 36206
Attn: Bill Whittaker

CIVIL ENGINEER
TTL
10 Inverness Center Pkwy
Suite 350
Hoover, AL 35242
256-441-2232
Attn: Tim Roberts

STRUCTURAL ENGINEER
Barnett, Jones, Wilson
125 18th St N
Palm City, AL 35125
205-884-5334
Attn: Jeremy Deal

MECHANICAL/PLUMBING/FIRE PROTECTION ENGINEER
Whorton Engineering, Inc.
25 Sunnyside Gate Road
Anniston, AL 36205
256-820-9897
Attn: Randy Whorton

ELECTRICAL ENGINEER
Hays Chalkwood Consulting
P.O. Box 250
Prison, AL 35126
256-842-2096
Attn: Tony Dodd

ISSUE:
03.31.25 BID
4.16.25 ADD #2



JOB NO:
24001

DESCRIPTION:
STORM DRAINAGE PLAN

SHEET
C5.1

TTL
10 Inverness Center Parkway, Suite 350
Hoover, AL 35242
205.526.3970 | www.ttlusa.com


Drawn By: J S Checked By: T R
Date: 03/28/25 Job No.: 24-11-00421.00
File Name: 240421.Sheet C5 01 Storm.dwg

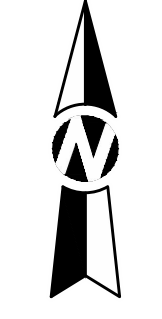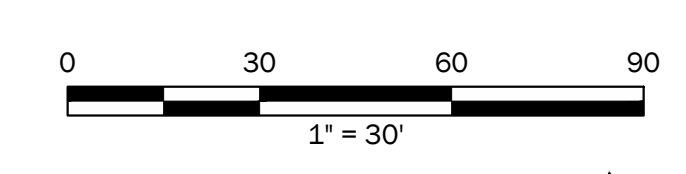

SANITARY LEGEND	
PSD	REQ'D SANITARY SEWER MAIN
PWM	REQ'D SANITARY SEWER FORCE MAIN
PSD	REQ'D SANITARY SEWER MANHOLE
PSD	REQ'D SANITARY SEWER CLEANOUT

WATER LEGEND	
PWM	REQ'D WATER MAIN
PWL	REQ'D FIRE LINE
WV	REQ'D WATER VALVE
W	REQ'D FIRE HYDRANT
W	REQ'D WATER METER
DC	REQ'D DOUBLE DETECTOR CHECK & VAULT
IR	REQ'D IRRIGATION METER
PRV	REQ'D PRESSURE REDUCING VALVE
BP	REQ'D BACKFLOW PREVENTER
Y	REQ'D POST MOUNTED SIAMESE CONNECTION

- NOTES:
- EXISTING 12" WATER MAIN WAS NOT FIELD LOCATED. CONTRACTOR SHALL FIELD VERIFY EXACT LOCATION AND DEPTH OF WATER MAIN IN FIELD PRIOR TO INSTALLATION OF PROPOSED WATER MAIN.
 - ALL BENDS SHALL UTILIZE THRUST BLOCKS. SEE DETAILS FOR THRUST BLOCK DETAIL.
 - THE DEPTH OF THE EXISTING FORCE MAIN TYPING TO THE PUMP STATION FROM THE SOUTH MAY CONFLICT WITH GRADING IMPROVEMENTS. CONTRACTOR SHALL FIELD LOCATE EXISTING FORCE MAIN AND REMOVE/REPLACE FORCE MAIN AS NECESSARY TO ACCOMMODATE GRADING IMPROVEMENTS. CONTRACTOR SHALL NOTIFY THE CITY OF LINCOLN, THE OWNER'S REPRESENTATIVE, AND ANY OTHER INVOLVED PARTIES PRIOR TO THE RELOCATION OF THIS LINE. THIS RELOCATION SHALL BE COORDINATED WITH THE CITY OF LINCOLN AND THE AFFECTED BUSINESS AS FORCE MAIN WILL BE OUT OF OPERATION. ALL WORK ON EXISTING FORCE MAIN SHALL BE COMPLETED AS QUICKLY AS POSSIBLE AND BE OPERATIONAL BY THE END OF THE WORKING DAY.
 - LOWEST INFLUENT OF EXISTING LIFT STATION IS +510.7 AS FIELD MEASURED. BOTTOM OF EXISTING LIFT STATION IS +507.3 AS FIELD MEASURED.
 - GAS MAIN TO BE DESIGNED AND INSTALLED BY SPIRE. CONTRACTOR SHALL COORDINATE GAS MAIN DESIGN AND INSTALLATION WITH SPIRE TO ENSURE NO CONFLICTS WITH CIVIL PLANS. SEE MECHANICAL DRAWINGS FOR GAS TIE TO BUILDING.
 - UTILITIES REQUIRE SEPARATE PERMIT, MB-01.

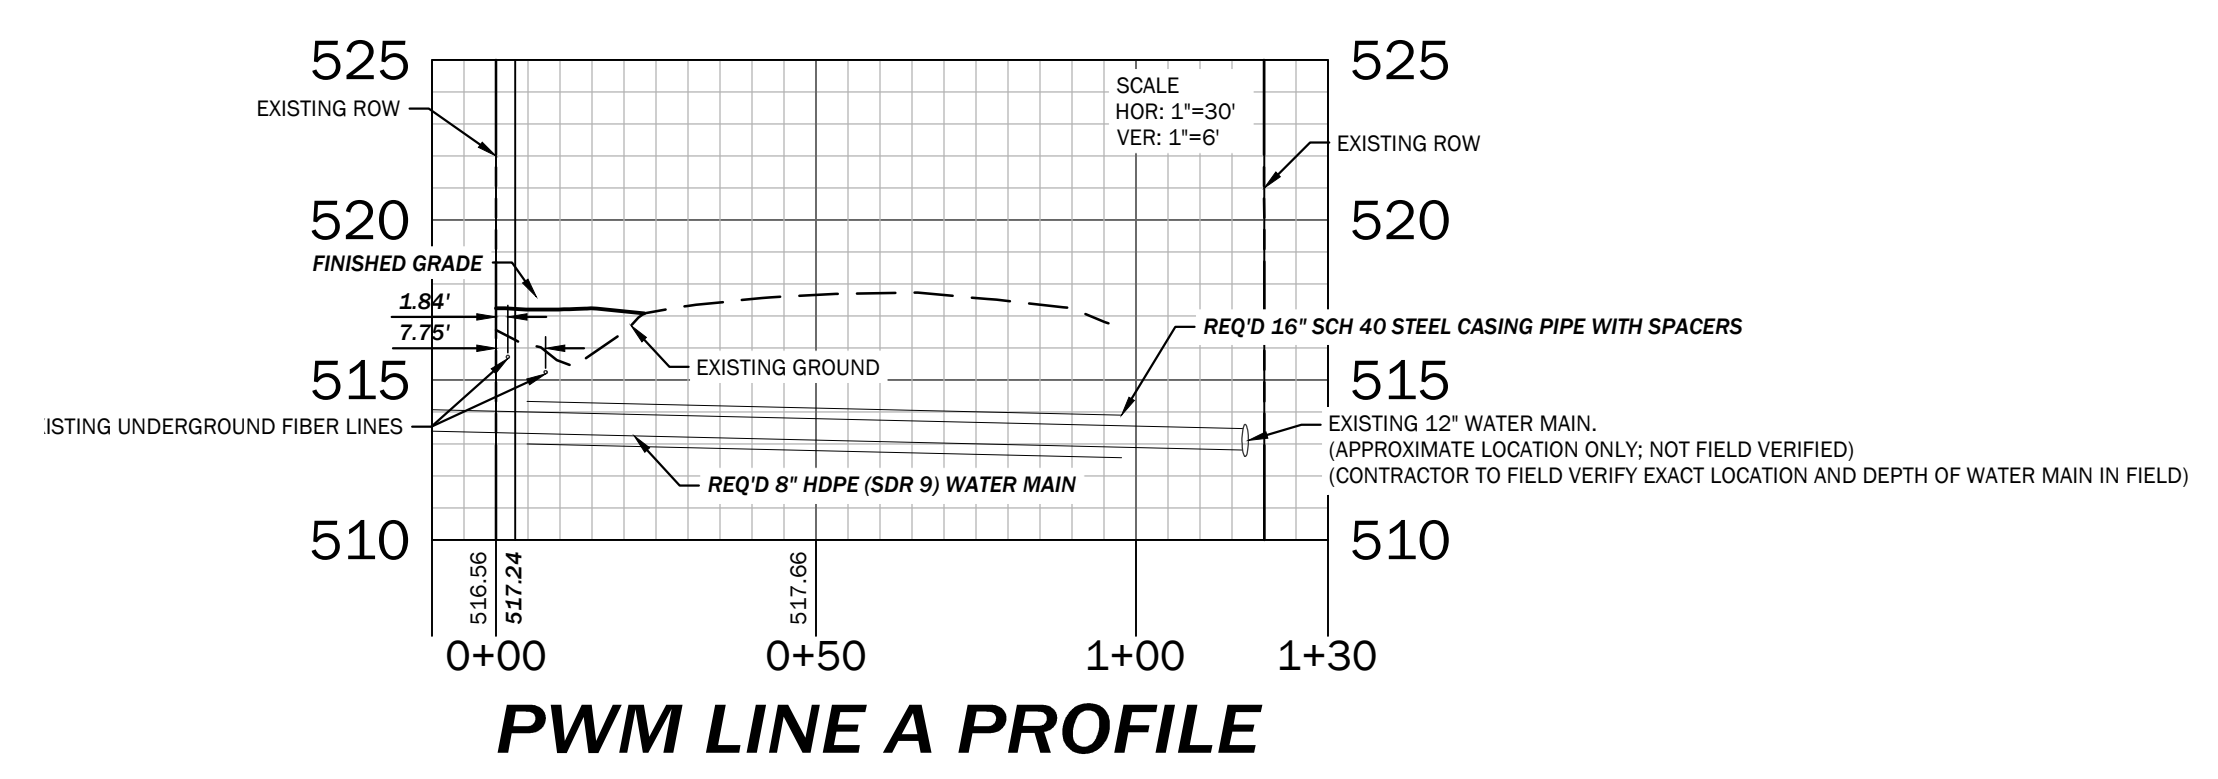

BILL WHITTAKER, P.C.
ARCHITECTURE
236 MARTIN STREET
ANNISTON, AL 36206
256.689.0338
WWW.BILLWHITTAKER.COM

CITY OF LINCOLN, ALABAMA

**NEW CITY OF LINCOLN
POLICE DEPARTMENT
LINCOLN, ALABAMA**

OWNER
City of Lincoln
150 Magnolia St.
Lincoln, AL 35506
256-763-7777
Attn: Lew Watson

ARCHITECT
Bill Whittaker, P.C.
Architecture
236 Martin Street
Anniston, AL 36206
Attn: Bill Whittaker

CIVIL ENGINEER
TTL
10 Inverness Center Pkwy
Suite 350
Hoover, AL 35242
256-441-2232
Attn: Tim Roberts

STRUCTURAL ENGINEER
Barnett, Jones, Wilson
125 18th St N
Palm City, AL 35125
205-884-5334
Attn: Jeremy Deal

MECHANICAL/PLUMBING/FIRE PROTECTION ENGINEER
Whorton Engineering, Inc.
25 Summerfield Gate Road
Anniston, AL 36205
256-820-9897
Attn: Randy Whorton

ELECTRICAL ENGINEER
Hays Charwood Consulting
P.O. Box 250
Prison, AL 35126
256-842-2096
Attn: Tony Dodd

ISSUE:
03.31.25 BID
4.16.25 ADD #2


JOB NO:
24001

DESCRIPTION:
UTILITY PLAN


SHEET
C6.1

10 Inverness Center Parkway, Suite 350
Hoover, AL 35242
205.526.3970 | www.ttlusa.com


Drawn By: J.S. Checked By: T.R.
Date: 03/28/25 Job No.: 24-11-00421.00
File Name: 240421.Sheet C6.01 Utility.dwg

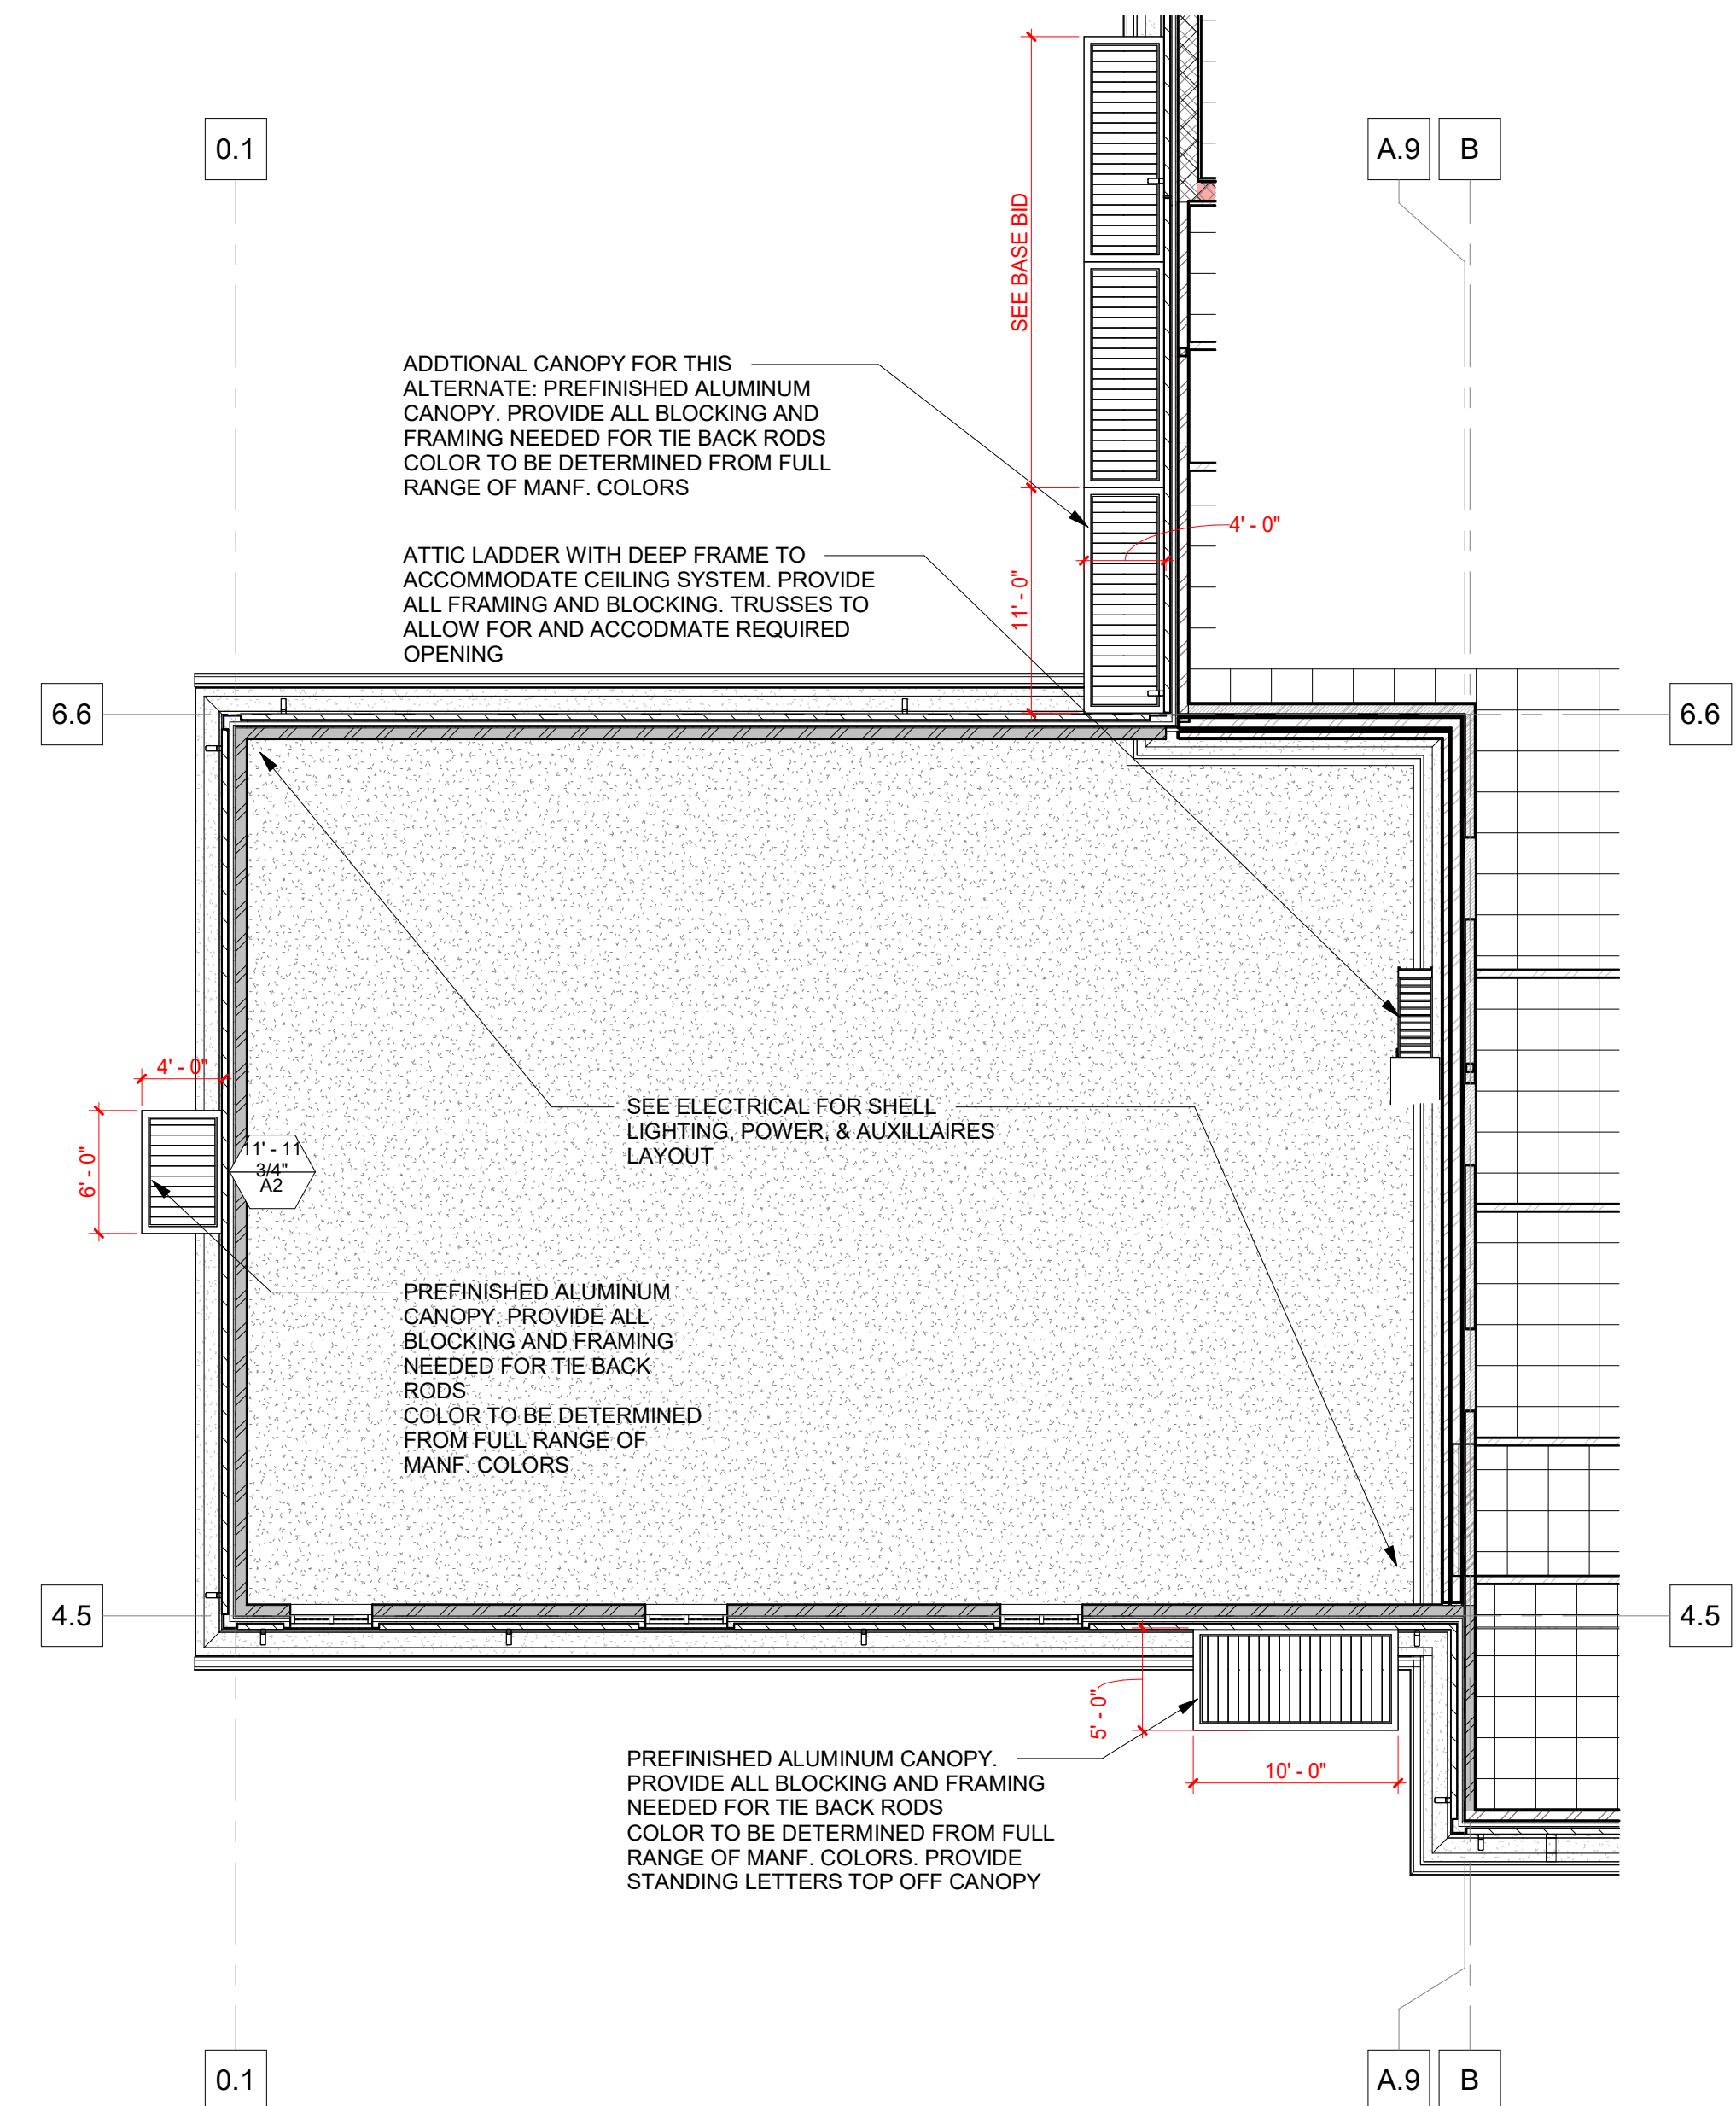


5 REFLECTED CEILING PLAN - ALTERNATE COURT ROOM SHELL
A2.4 1/8" = 1'-0"

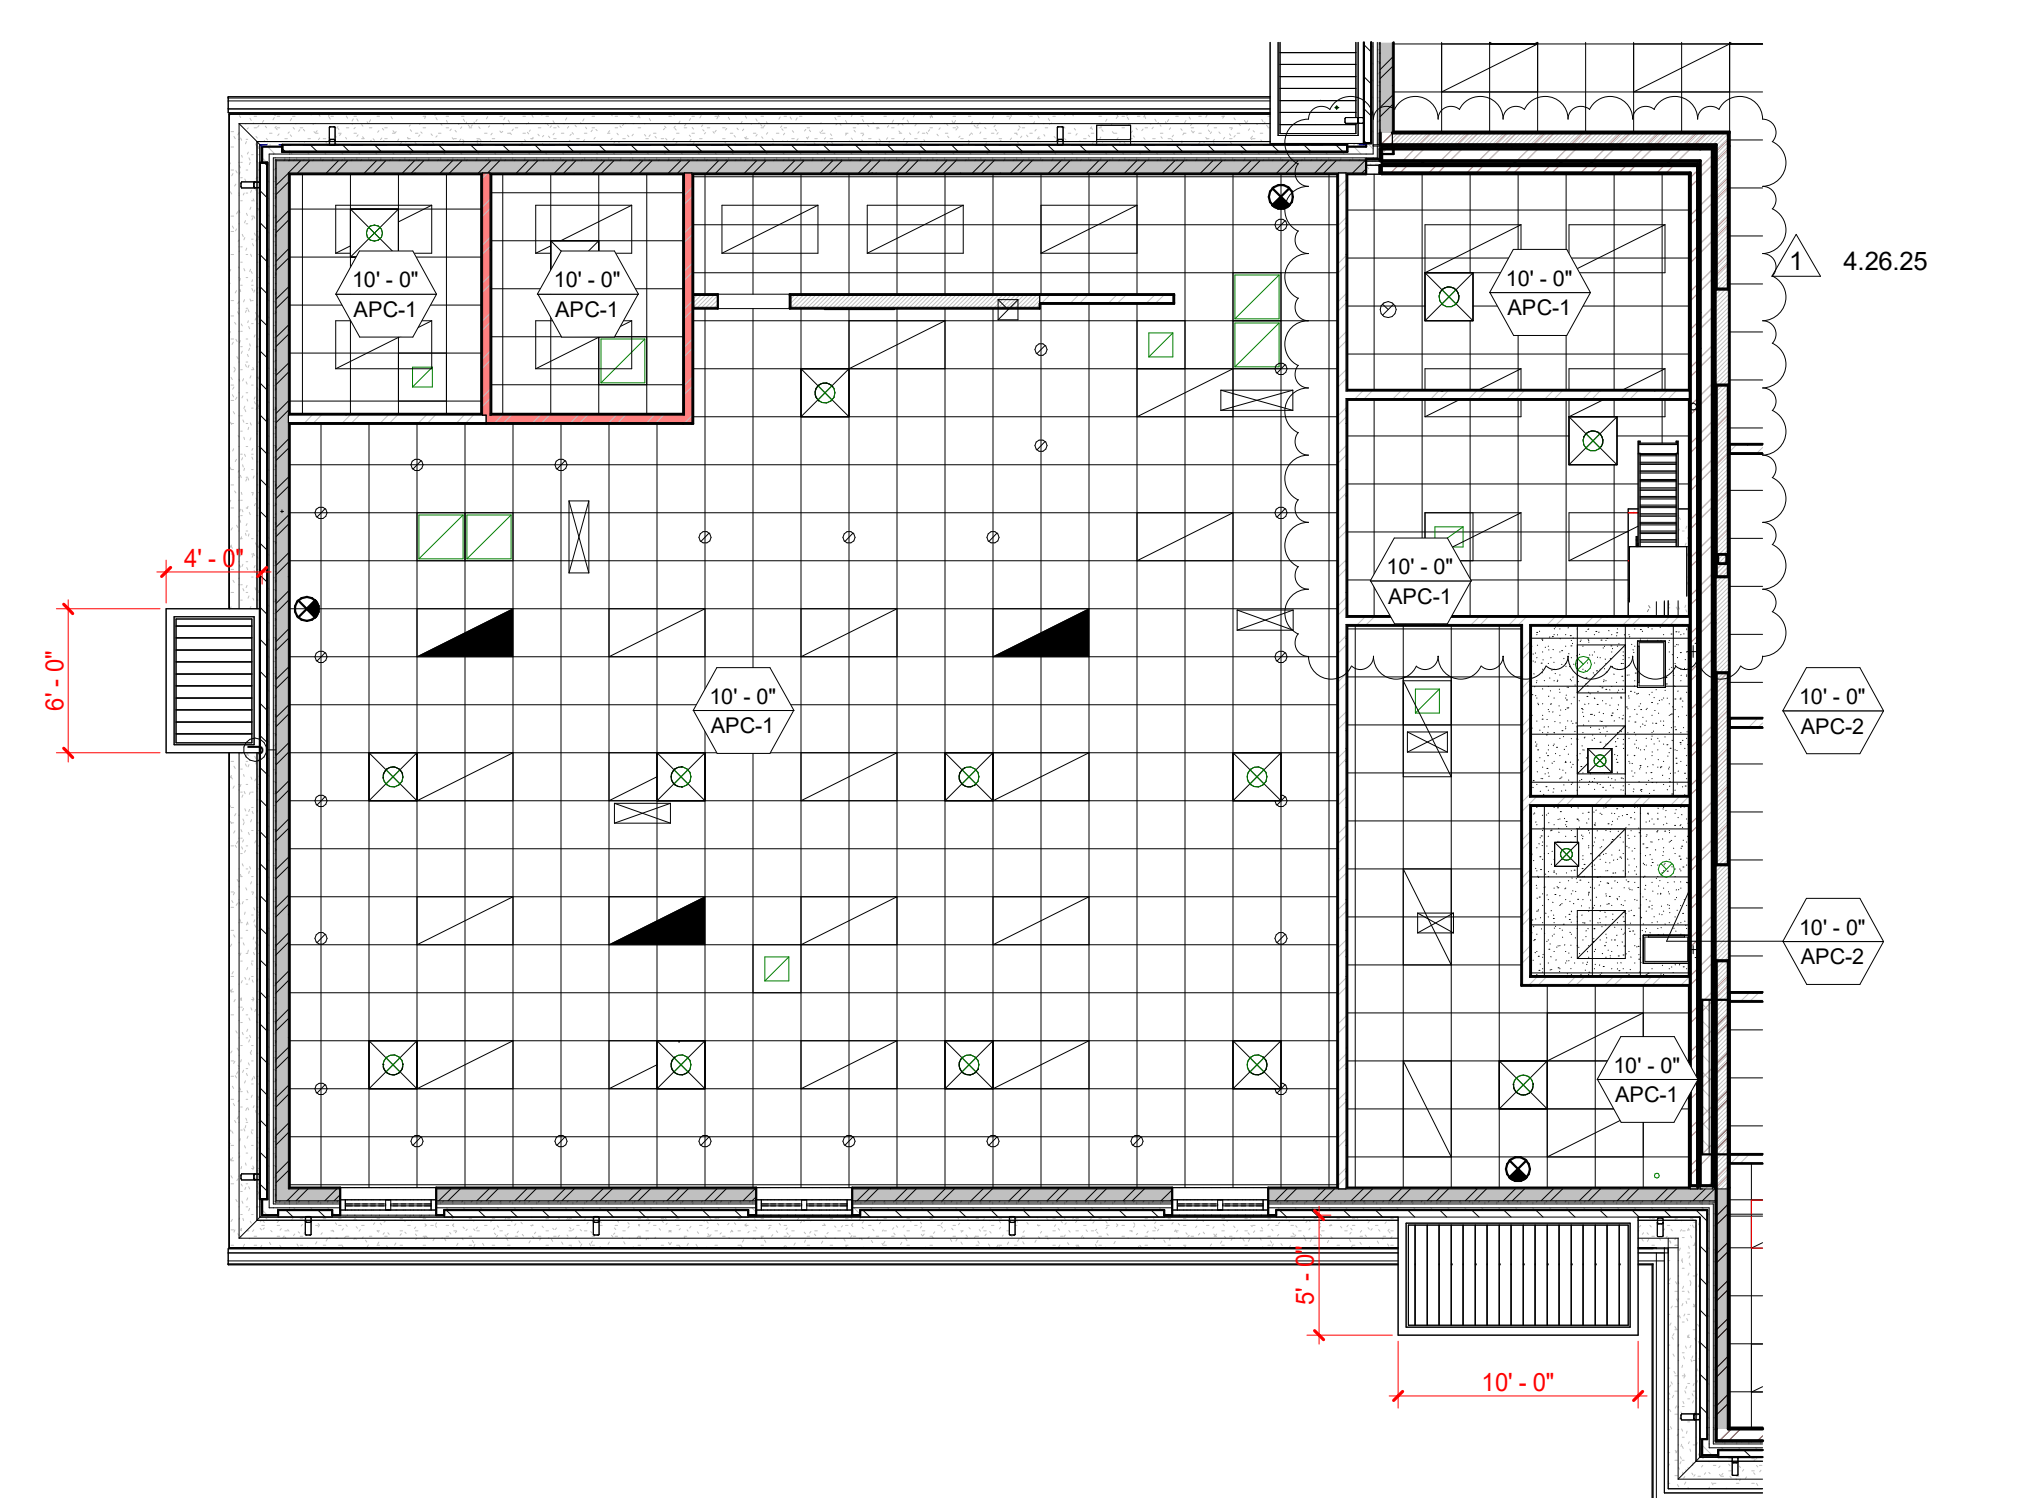


2 REFLECTED CEILING PLAN - ALTERNATE COURT ROOM BUILD OUT
A2.4 1/8" = 1'-0"

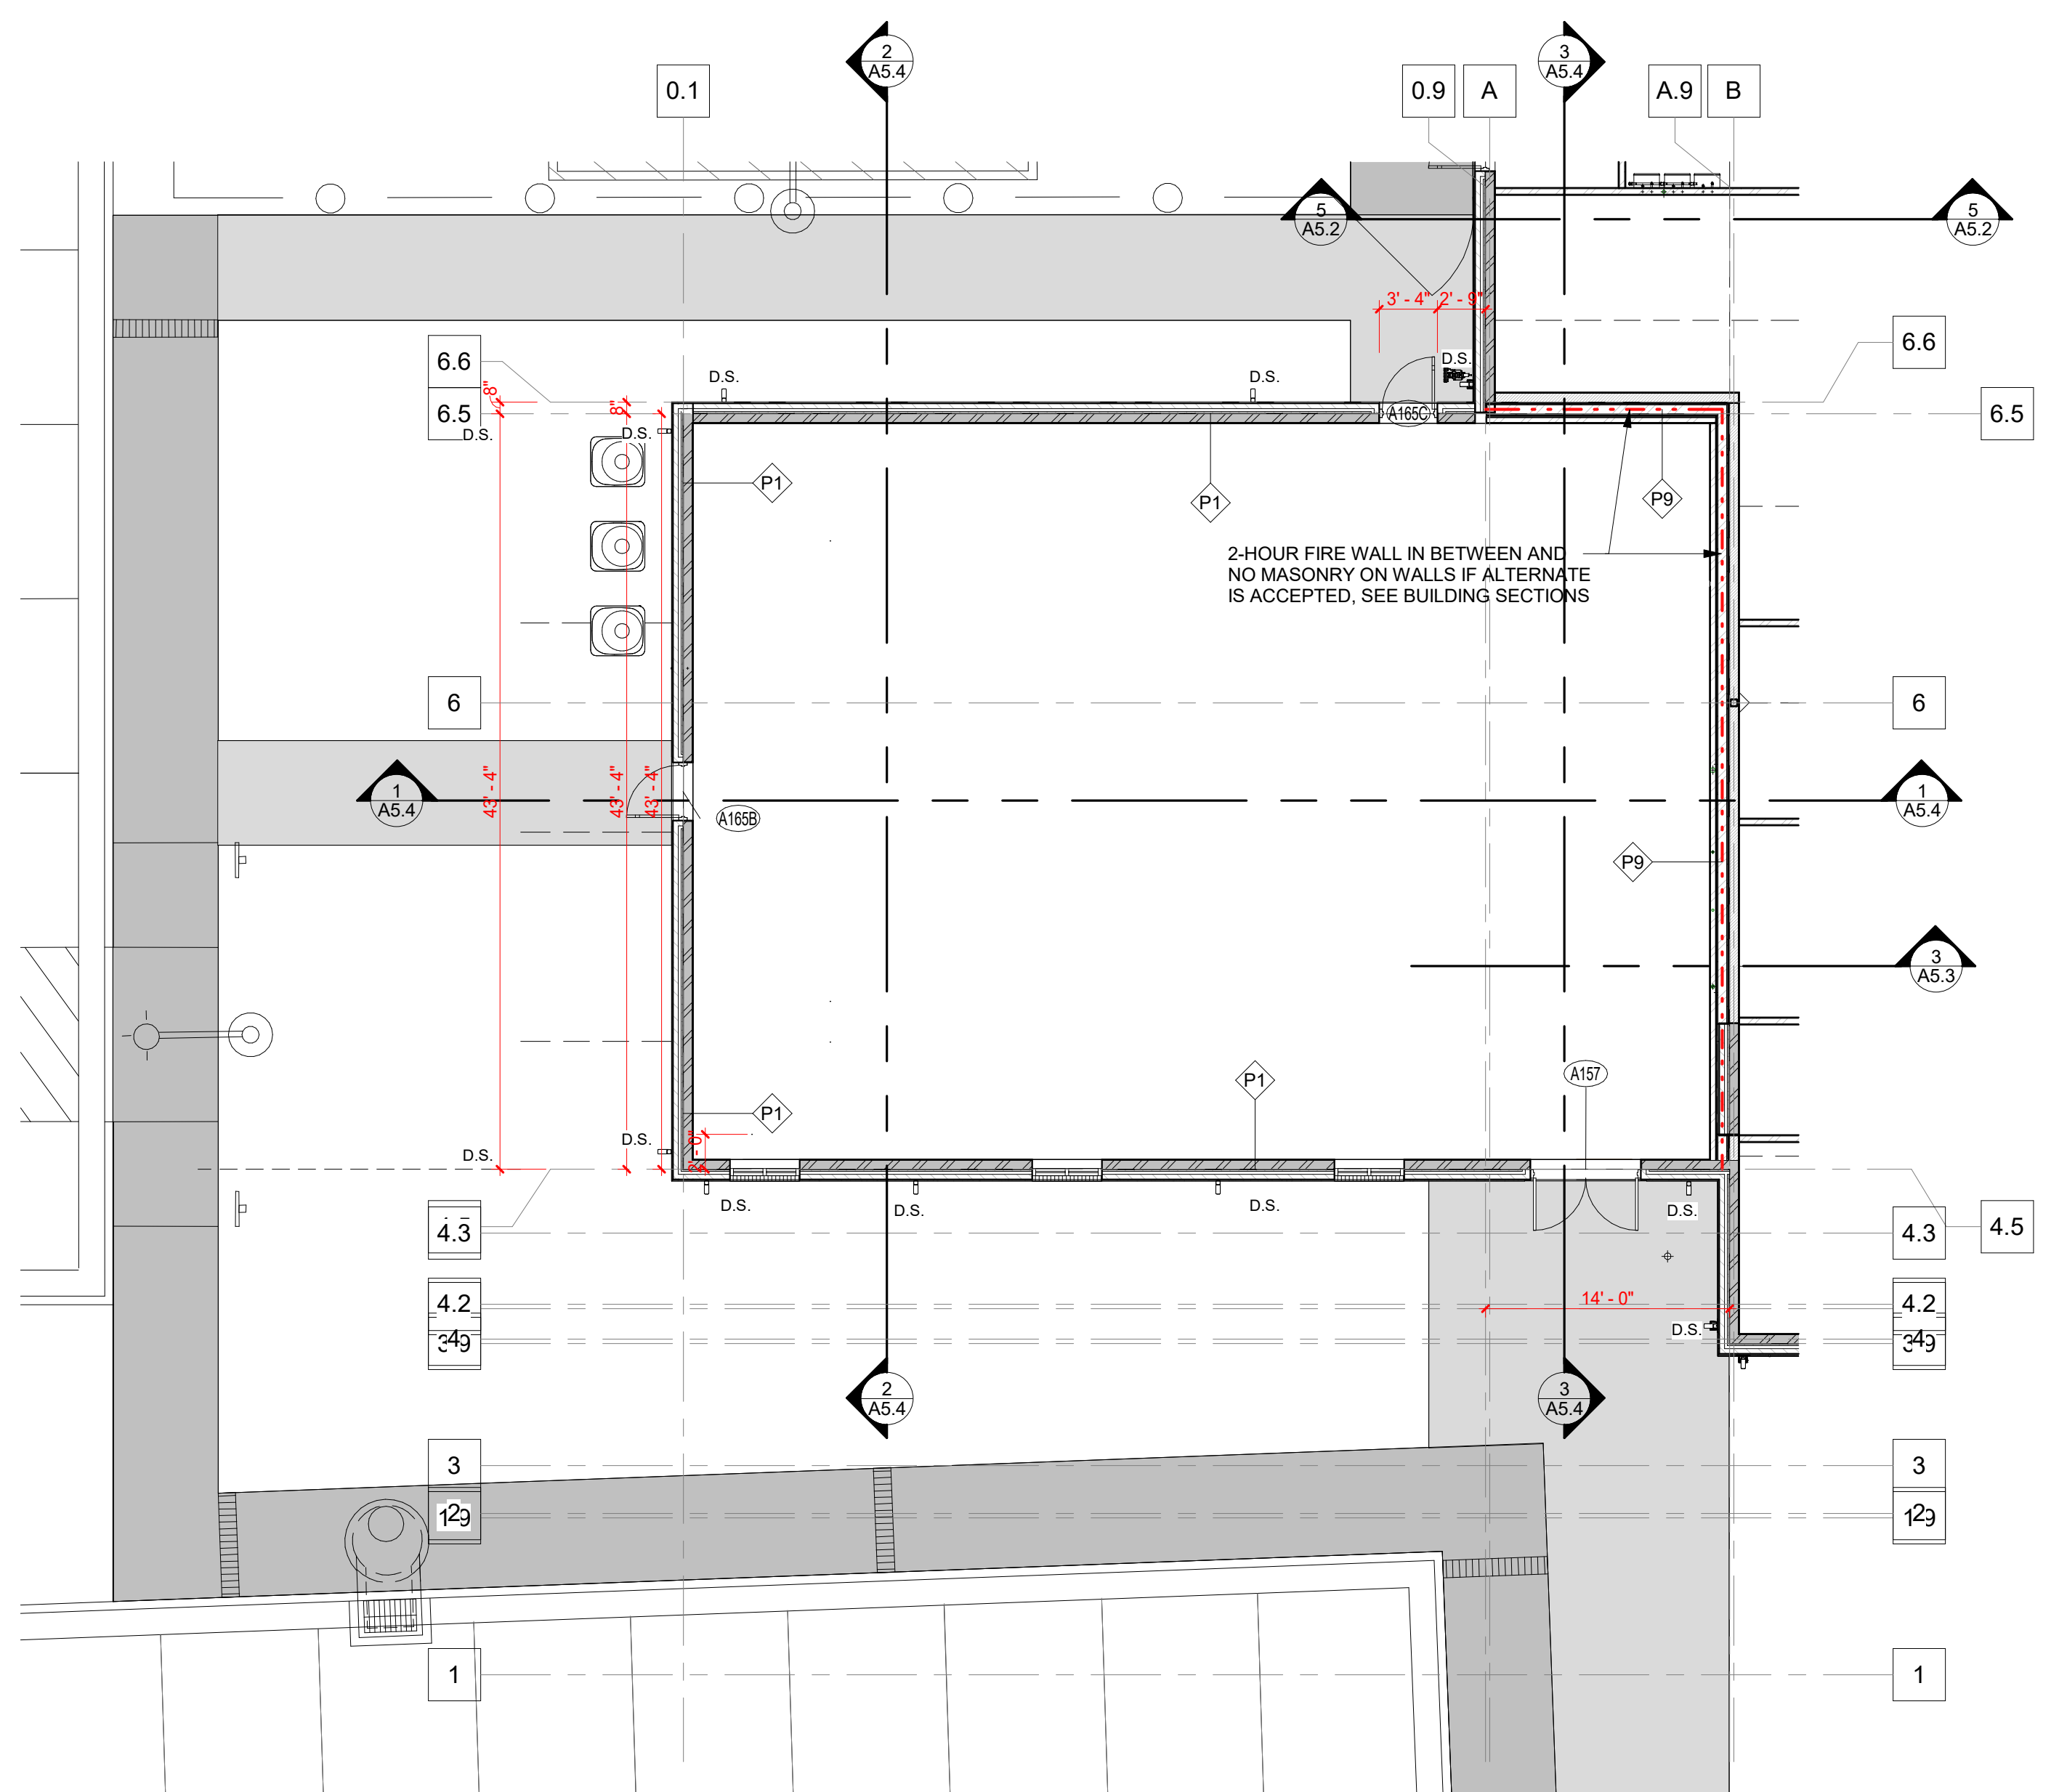


4 FLOOR PLAN - ALTERNATE COURTROOM SHELL
A2.4 1/8" = 1'-0"

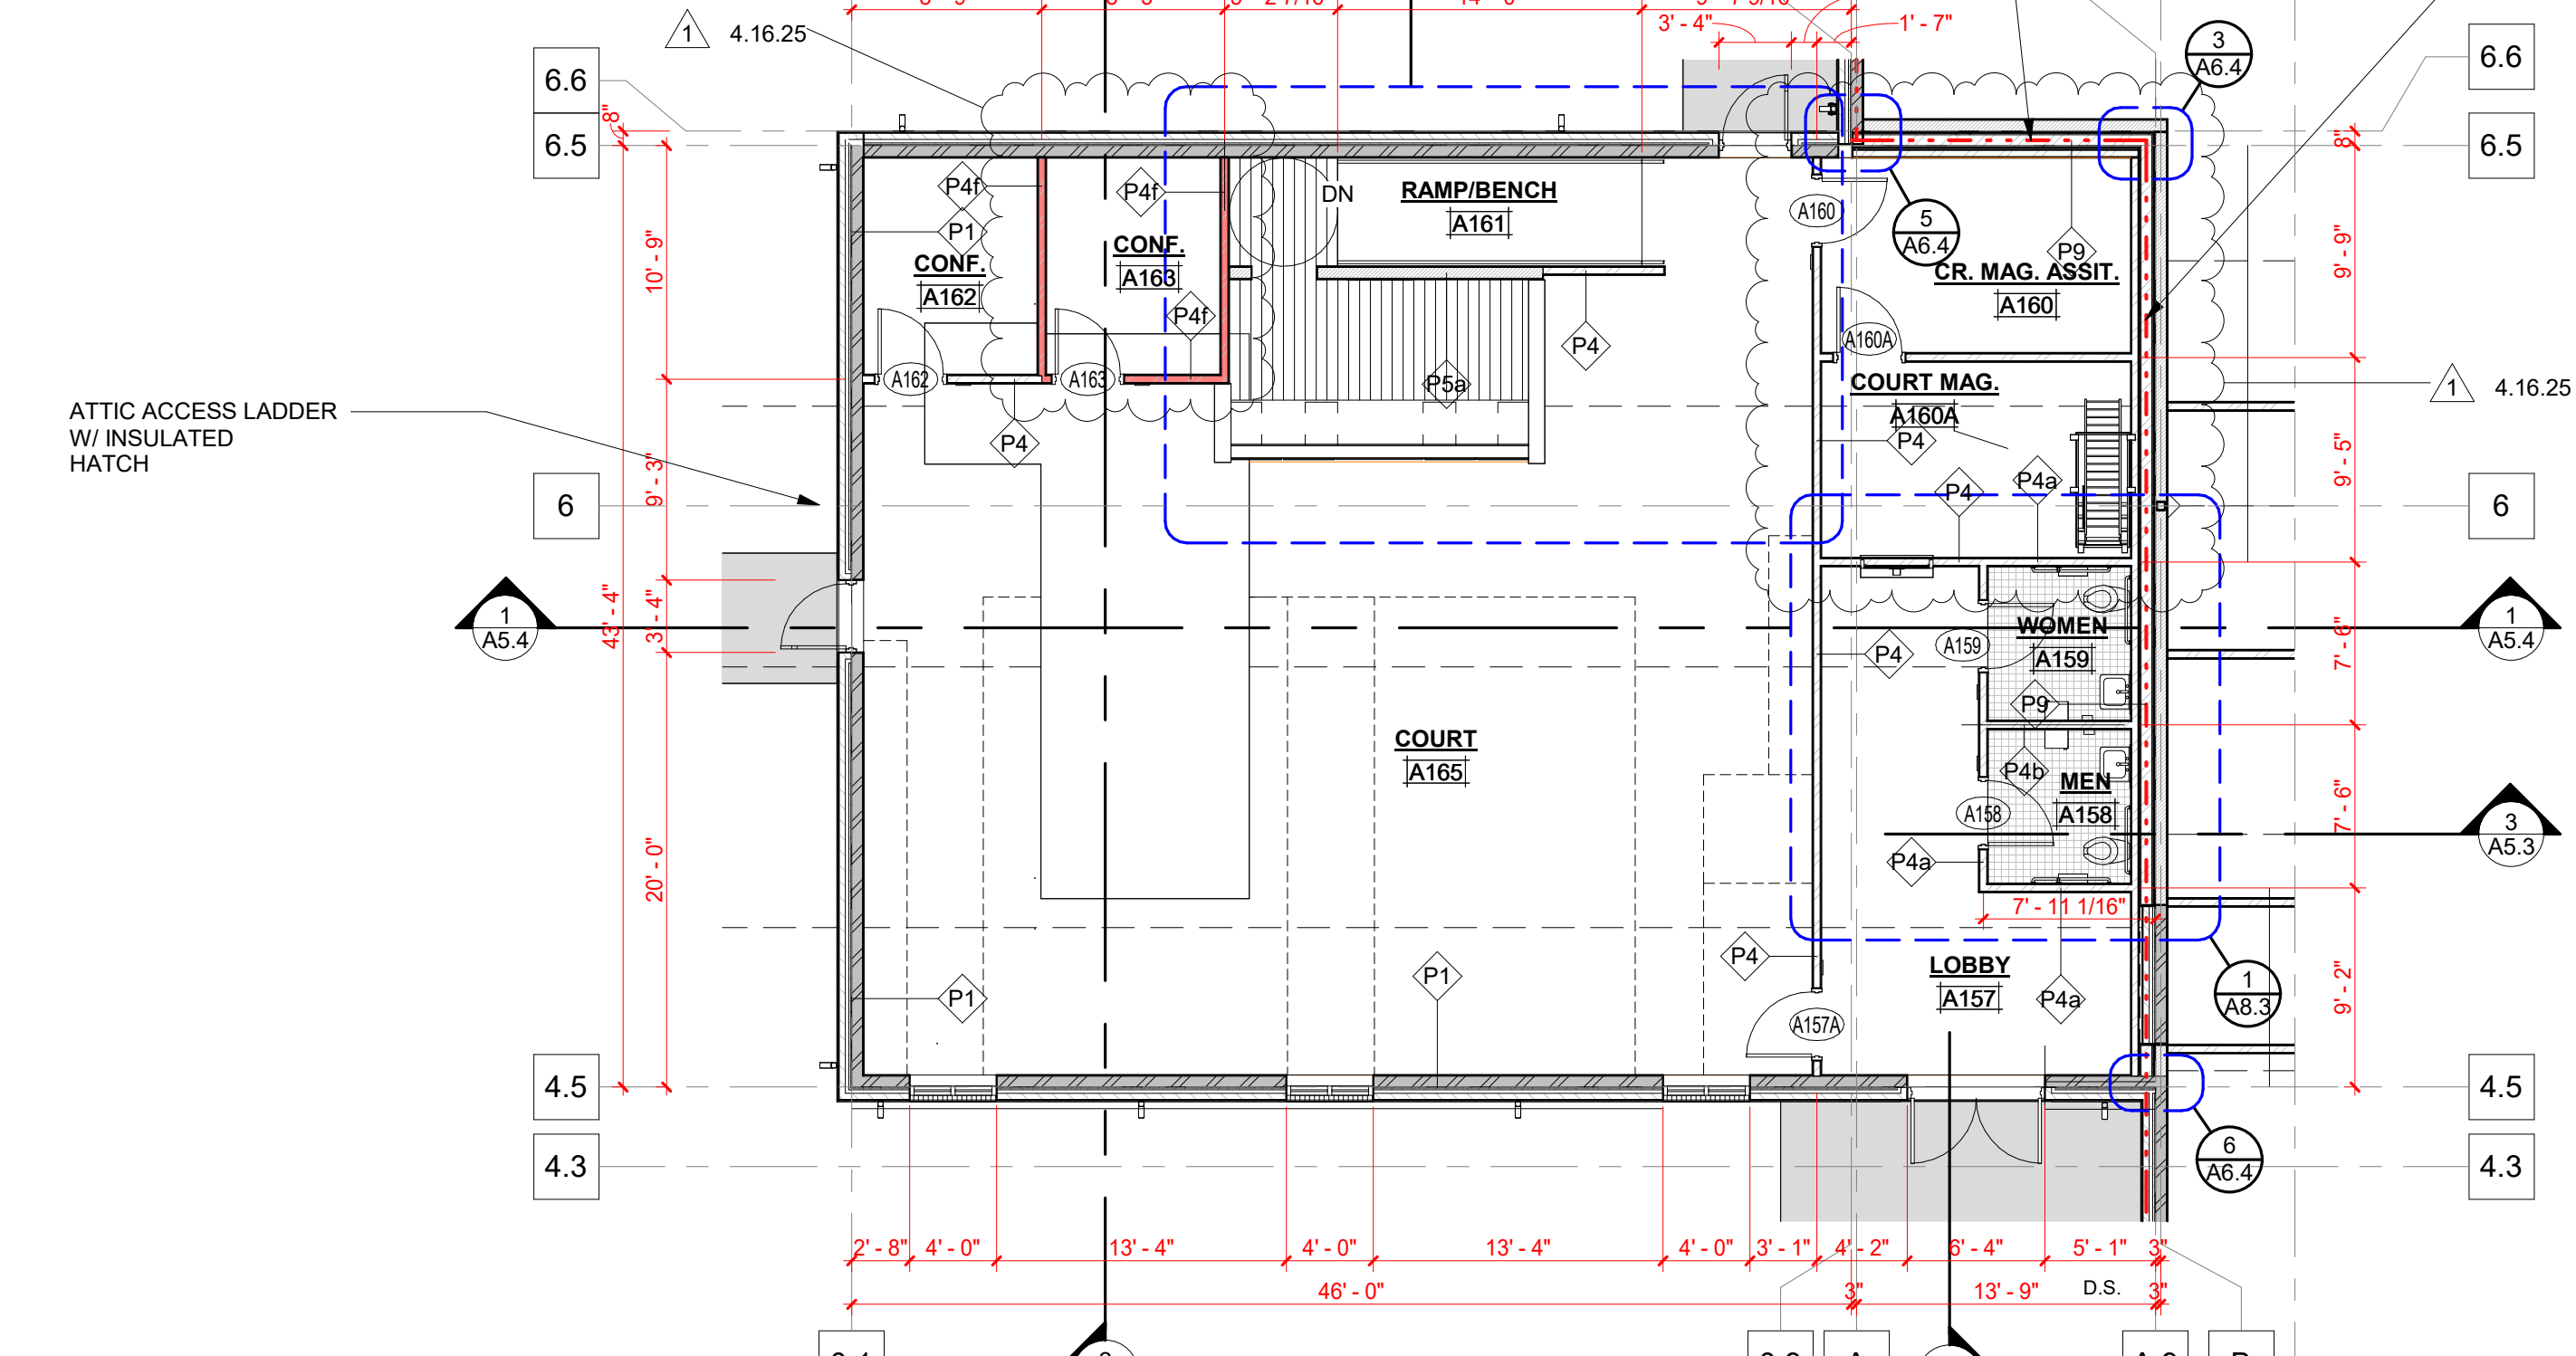

1 FLOOR PLAN - ALTERNATE COURTROOM BUILD OUT
A2.4 1/8" = 1'-0"

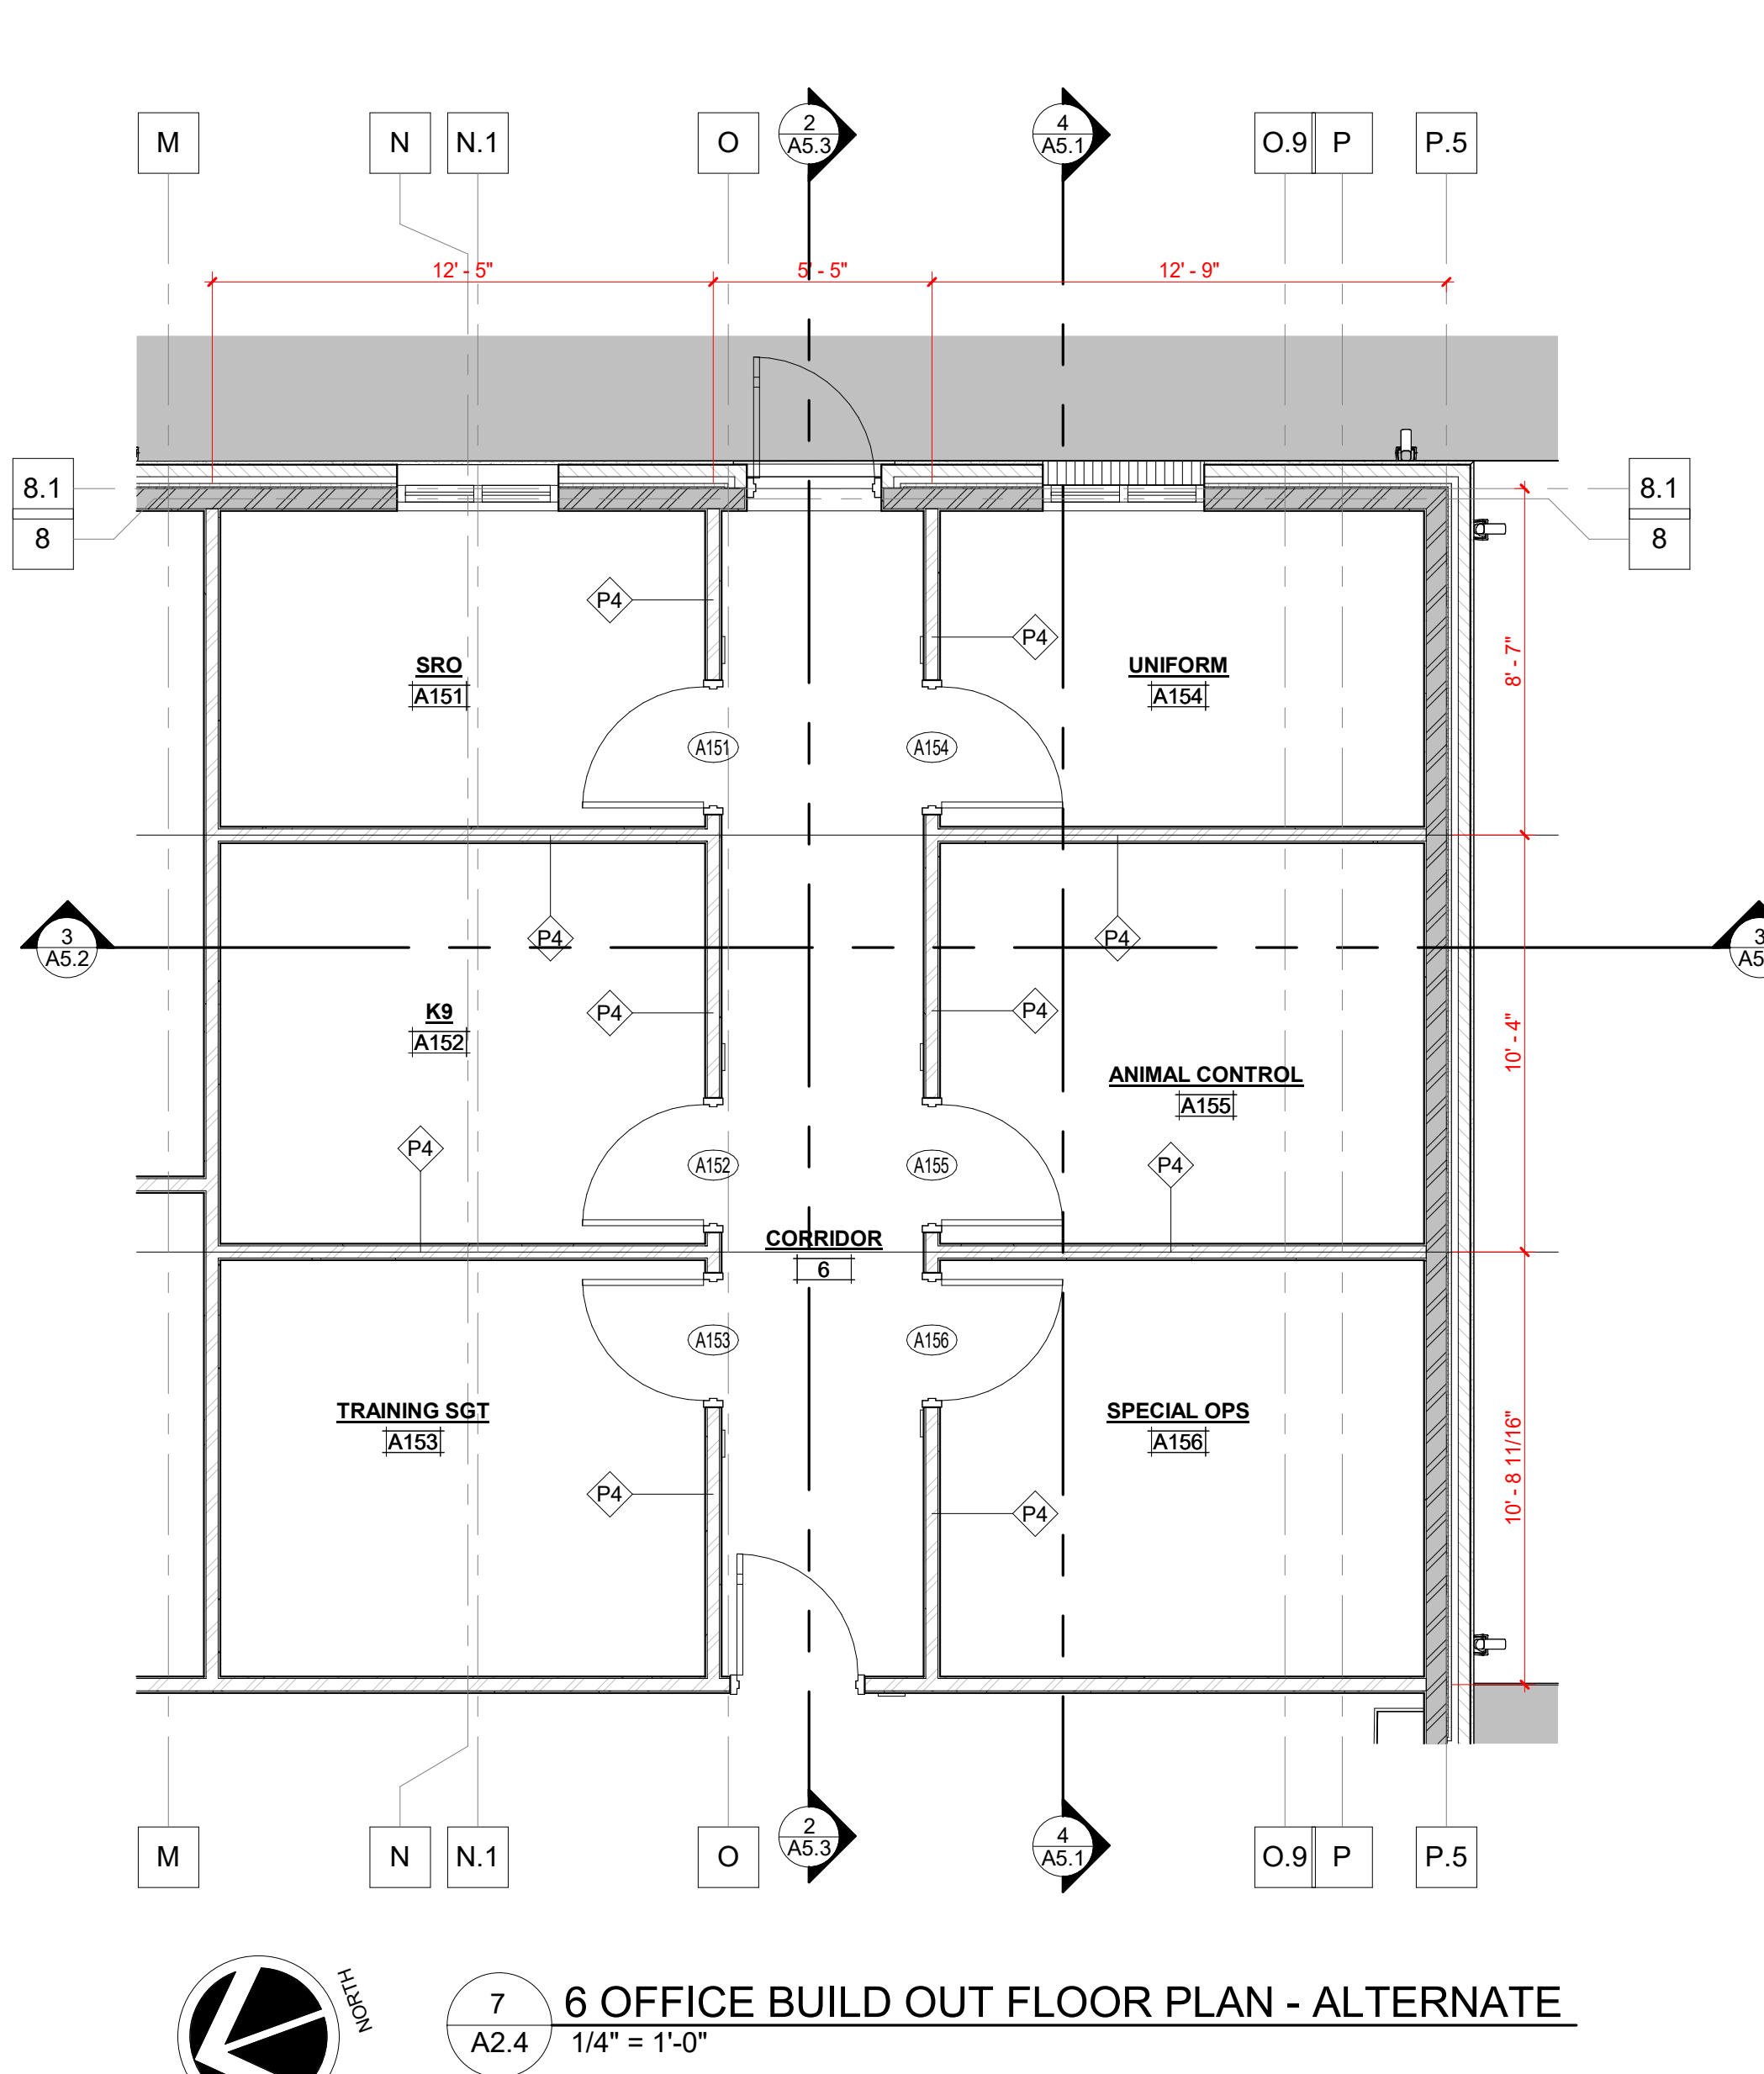

7 6 OFFICE BUILD OUT FLOOR PLAN - ALTERNATE
A2.4 1/4" = 1'-0"

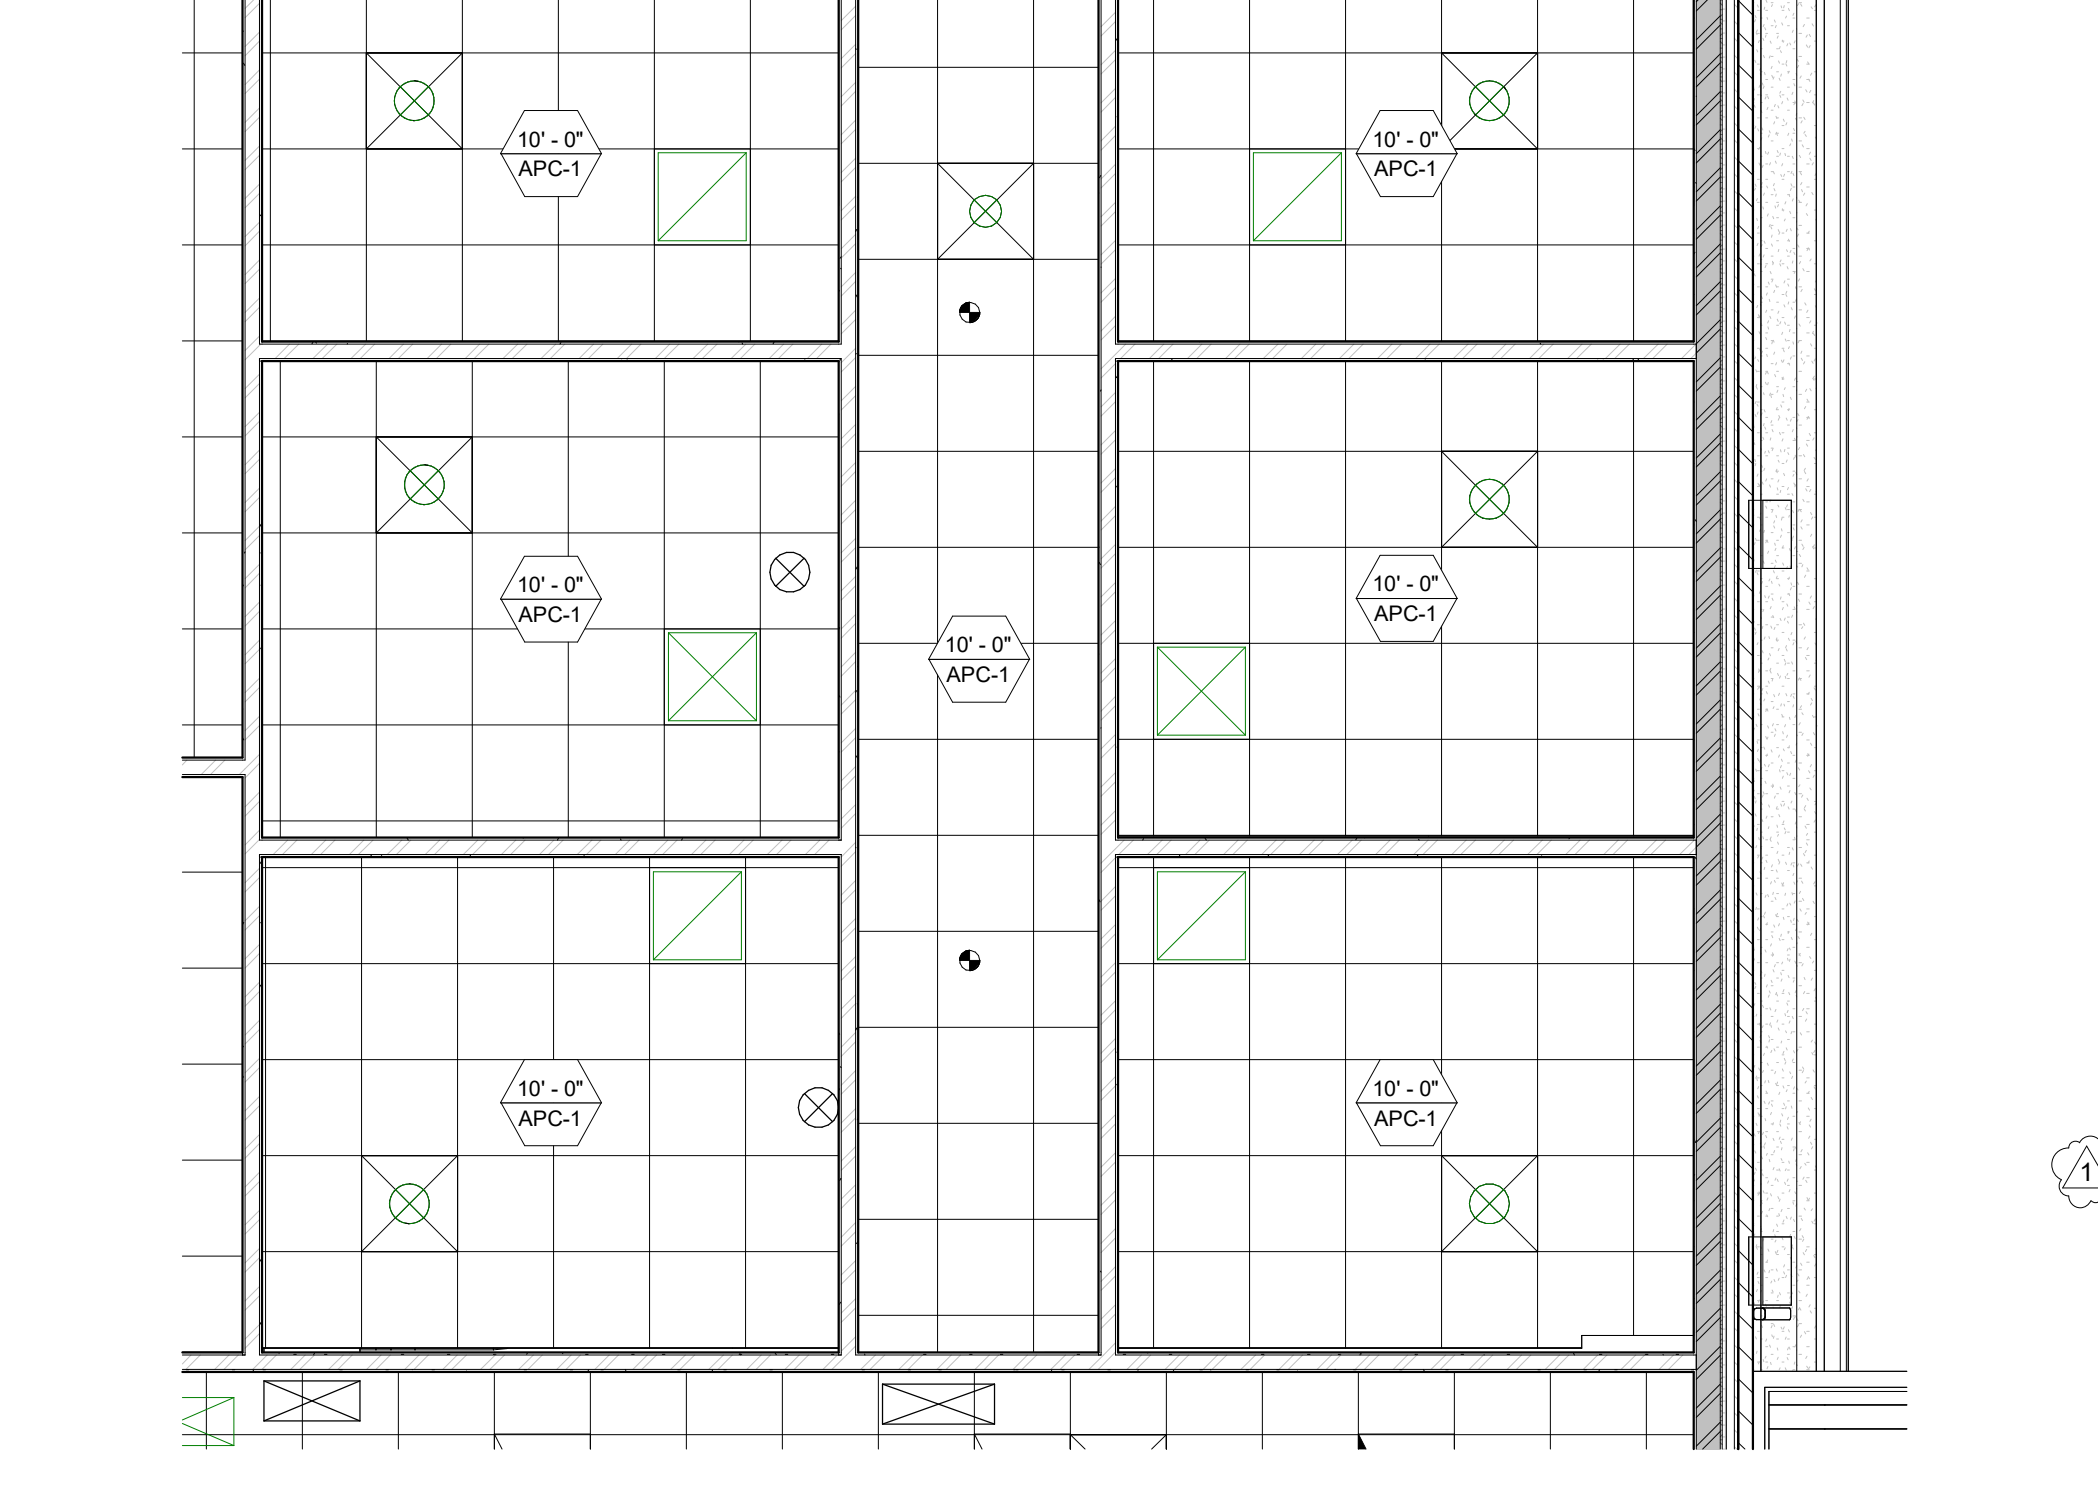

6 6 OFFICE BUILD OUT RCP - ALTERNATE
A2.4 1/4" = 1'-0"

MARK	SYMBOL	DESCRIPTION	RATING	MARK	SYMBOL	DESCRIPTION	RATING	MARK	SYMBOL	DESCRIPTION	RATING	MARK	SYMBOL	DESCRIPTION	RATING
P1		MASONRY VENEER, 2" AIR SPACE, 1" RIGID INSULATION, 1/2" GYPSUM SHEATHING WITH FAMAB, 6" METAL STUD, R-19 BATT INSULATION, 5/8" GYPSUM BOARD TO AIR BARRIER ON BOTTOM OF TRUSSES	2 HOUR	P4		3/8" METAL STUDS @ 16" O.C. WITH 5/8" GYP. BD. BOTH SIDES WITH SAFB (SOUND BATT). ALL STUDS TO BOTTOM OF TRUSS CHORD. EXTEND GYP. BD. TO AIR BARRIER ON BOTTOM OF TRUSSES. WALL TILE ON ONE SIDE UP TO 10'-0"	2 HOUR	P5		PLUMBING WALL, 6" METAL STUDS WITH MOISTURE RESISTANT GYP BOARD ON RESTROOM SIDE ALONG WITH WALL TILE UP TO 10'-0" AND SAFB (SOUND BATT)	2 HOUR	P6		8" CMU, 1.5" METAL FURRING, 5/8" GYPSUM BOARD ON BOTH SIDES. EXTEND GYP. BD. TO AIR BARRIER AND ON BOTTOM OF TRUSSES. WALL TILE ON ONE SIDE UP TO 10'-0"	2 HOUR
P2		MASONRY VENEER, 2" AIR SPACE, 1.5" RIGID INSULATION, FAMAB, 12" CMU, 1.5" METAL FURRING, 5/8" GYPSUM BOARD, EXTEND GYP. BOARD TO AIR BARRIER ON BOTTOM OF TRUSSES	2 HOUR	P4		3/8" METAL STUDS @ 16" O.C. WITH 5/8" GYP. BD. BOTH SIDES WITH SAFB (SOUND BATT). ALL STUDS TO BOTTOM OF TRUSS CHORD. EXTEND GYP. BD. TO AIR BARRIER ON BOTTOM OF TRUSSES. WALL TILE ON ONE SIDE UP TO 10'-0"	2 HOUR	P5		PLUMBING WALL, 6" METAL STUDS WITH MOISTURE RESISTANT GYP BOARD ON RESTROOM SIDE ALONG WITH WALL TILE UP TO 10'-0" AND SAFB (SOUND BATT)	2 HOUR	P6		8" CMU, 1.5" METAL FURRING, 5/8" GYPSUM BOARD ON BOTH SIDES. EXTEND GYP. BD. TO AIR BARRIER AND ON BOTTOM OF TRUSSES. WALL TILE ON ONE SIDE UP TO 10'-0"	2 HOUR
P3		12" CMU, 1.5" METAL FURRING, 5/8" GYPSUM BOARD ON BOTH SIDES. EXTEND GYP. BD. TO AIR BARRIER AND ON BOTTOM OF TRUSSES AND TO CONCRETE ROOF DECK	2 HOUR	P4		3/8" METAL STUDS @ 16" O.C. WITH 5/8" GYP. BD. BOTH SIDES WITH SAFB (SOUND BATT). ALL STUDS TO BOTTOM OF TRUSS CHORD. EXTEND GYP. BD. TO AIR BARRIER ON BOTTOM OF TRUSSES. WALL TILE ON ONE SIDE UP TO 10'-0"	2 HOUR	P5		PLUMBING WALL, 6" METAL STUDS WITH MOISTURE RESISTANT GYP BOARD ON RESTROOM SIDE ALONG WITH WALL TILE UP TO 10'-0" AND SAFB (SOUND BATT)	2 HOUR	P6		8" CMU, 1.5" METAL FURRING, 5/8" GYPSUM BOARD ON BOTH SIDES. EXTEND GYP. BD. TO AIR BARRIER AND ON BOTTOM OF TRUSSES. WALL TILE ON ONE SIDE UP TO 10'-0"	2 HOUR
P4		3/8" METAL STUDS @ 16" O.C. WITH 5/8" GYP. BD. BOTH SIDES WITH SAFB (SOUND BATT). ALL STUDS TO BOTTOM OF TRUSS CHORD. EXTEND GYP. BD. TO AIR BARRIER ON BOTTOM OF TRUSSES	2 HOUR	P4		3/8" METAL STUDS @ 16" O.C. WITH 5/8" GYP. BD. BOTH SIDES WITH SAFB (SOUND BATT). ALL STUDS TO BOTTOM OF TRUSS CHORD. EXTEND GYP. BD. TO AIR BARRIER ON BOTTOM OF TRUSSES	2 HOUR	P5		PLUMBING WALL, 6" METAL STUDS WITH MOISTURE RESISTANT GYP BOARD ON RESTROOM SIDE ALONG WITH WALL TILE UP TO 10'-0" AND SAFB (SOUND BATT)	2 HOUR	P6		8" CMU, 1.5" METAL FURRING, 5/8" GYPSUM BOARD ON BOTH SIDES. EXTEND GYP. BD. TO AIR BARRIER AND ON BOTTOM OF TRUSSES. WALL TILE ON ONE SIDE UP TO 10'-0"	2 HOUR

BILL WHITTAKER, P.C.
ARCHITECTURE
236 MARTIN STREET
ANNISTON, AL 36206
256-680-0238
WWW.BILLWARCH.COM

CITY OF LINCOLN
LINCOLN, ALABAMA

**NEW CITY OF LINCOLN
POLICE DEPARTMENT
LINCOLN, ALABAMA**

POLICE
CITY OF LINCOLN
ALABAMA

OWNER:
City of Lincoln
150 Magnolia St.
Lincoln, AL 35096
256-753-7777
Attn: Lew Watson

ARCHITECT:
Bill Whittaker, P.C.
Architecture
236 Martin Street
Anniston, AL 36206
Attn: Bill Whittaker

CIVIL ENGINEER:
TTL
10 Inverness Center Parkway
Suite 350
Hoover, AL 35242
256-441-2232
Attn: Tim Roberts

STRUCTURAL ENGINEER:
Barnett, Jones, Wilson
125 18th St N
Pell City, AL 35125
205-894-5334
Attn: Jeremy Deal

MECHANICAL/PLUMBING/FIRE PROTECTION ENGINEER:
Whorton Engineering, Inc.
25 Summerfield Gate Road
Anniston, AL 36205
256-820-8987
Attn: Randy Whorton

ELECTRICAL ENGINEER:
Hays Checkwood Consulting
P.O. Box 250
Prison, AL 35126
205-842-8586
Attn: Tony Dodd

ISSUE:
3.31.25 BID
4.16.25 ADD #2

JOB NO:
24001

DESCRIPTION:
COURT RM.
SHELL PLAN AND
RCP & BUILD OUT
OFFICE BUILD
OUT ALTERNATES


SHEET
A2.4

WILLIAM WHITTAKER
6524


HEAD DETAIL @ EXTERIOR STORM SHELTER DOOR

JAMB DETAIL @ EXTERIOR STORM SHELTER DOOR

STORM SHELTER DOOR DETAILS

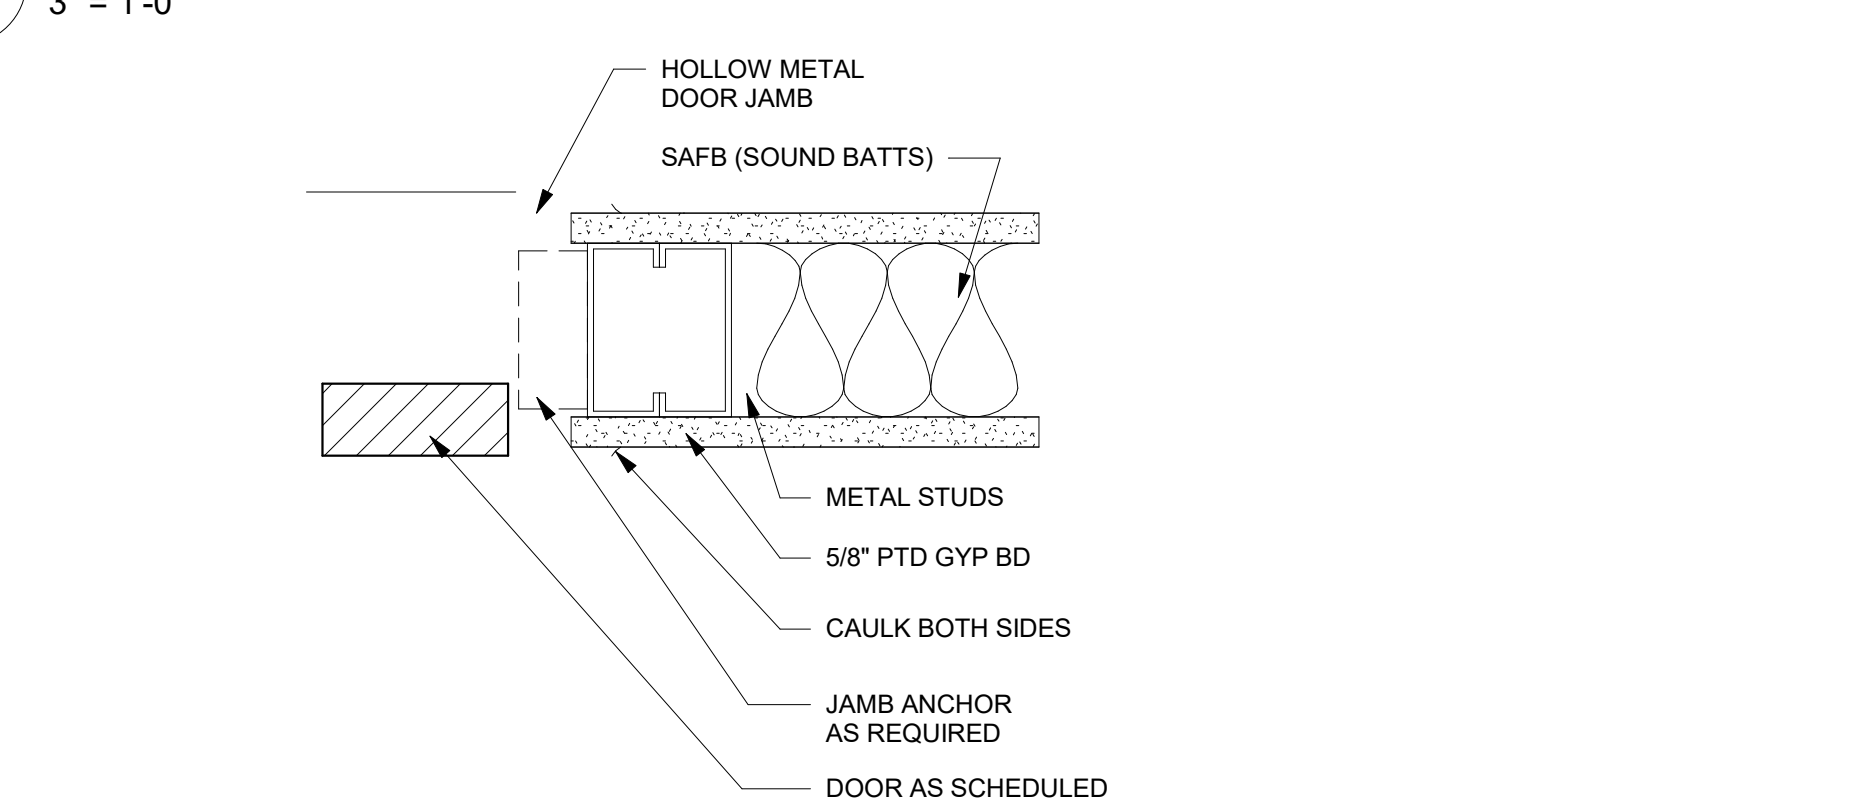


4 HM FRAME JAMB DETAIL - TYPICAL (INTERIOR)

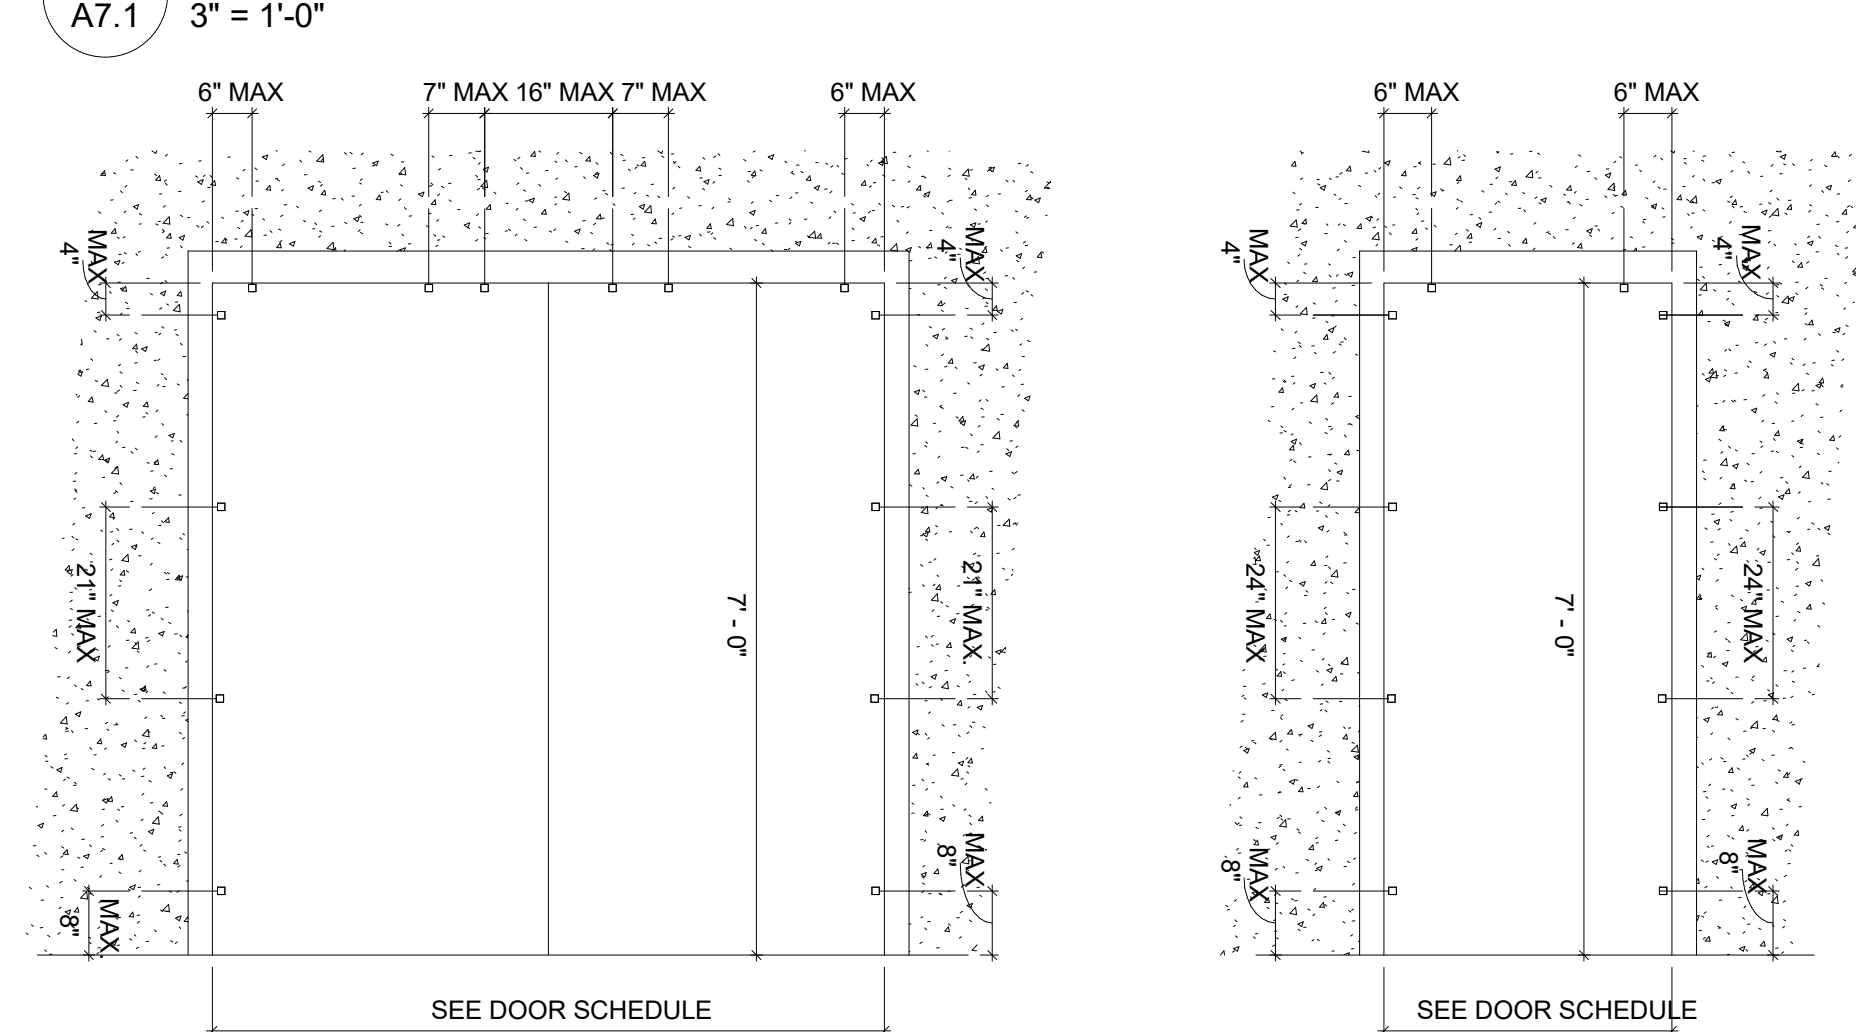


DOOR ANCHORING @ STORM SHELTER


DOOR SCHEDULE																	
ROOM NAME	ROOM #	DOOR	HDW. SET #	DOOR				GLASS	MAT.	FRAME			FIRE LABEL	SIGNAGE		COMMENTS	
				TYPE	WIDTH	HEIGHT	THICKNESS			MATERIAL	HEAD	JAMB					SILL
CORRIDOR	1	2A	03	3	3'-0"	7'-0"	1 3/4"	SOLID CORE WOOD	3X33	H.M.	F-1					ACCESS CONTROLLED	
CORRIDOR	3	2B	03	2	3'-0"	7'-0"	1 3/4"	SOLID CORE WOOD		H.M.	F-1					ACCESS CONTROLLED	
CORRIDOR	3	3A	02.1	5	3'-0"	7'-0"	1 3/4"	FRP	3X33	H.M.	F-2					ACCESS CONTROLLED	
CORRIDOR	3	3B	02.1	5	3'-0"	7'-0"	1 3/4"	FRP	3X33	H.M.	F-2					ACCESS CONTROLLED	
CORRIDOR	4	03	2	2	3'-0"	7'-0"	1 3/4"	SOLID CORE WOOD		H.M.	F-1					ACCESS CONTROLLED	
CORRIDOR	3	6A	03	3	3'-0"	7'-0"	1 3/4"	SOLID CORE WOOD	3X33	H.M.	F-1						
CORRIDOR	6	6B	02.1	5	3'-0"	7'-0"	1 3/4"	FRP	3X33	H.M.	F-2					ACCESS CONTROLLED	
MAIN LOBBY	101	101A	01	1	6'-0"	7'-0"	1 3/4"	ALUM./GLASS	INSUL./LOW-E/ TINTED	ALUM. S.F.		4"					
LOBBY	101	101B	03	4	3'-0"	7'-0"	1 3/4"	SOLID CORE WOOD		H.M.	F-1					ACCESS CONTROLLED - LEVEL 3 BULLET RESISTANT	
MAIN LOBBY	101	101C	03	4	3'-0"	7'-0"	1 3/4"	SOLID CORE WOOD		H.M.	F-2					ACCESS CONTROLLED - LEVEL 3 BULLET RESISTANT	
ADA RR	102	102	04	2	3'-0"	7'-0"	1 3/4"	SOLID CORE WOOD		H.M.	F-1						
ADA RR	103	103	04	2	3'-0"	7'-0"	1 3/4"	SOLID CORE WOOD		H.M.	F-1						
REPORT	104	104	05	2	3'-0"	7'-0"	1 3/4"	SOLID CORE WOOD		H.M.	F-1						
104D	104	05	4	2	3'-0"	7'-0"	1 3/4"	SOLID CORE WOOD		H.M.	F-2					ACCESS CONTROLLED - LEVEL 3 BULLET RESISTANT	
RECORDS	106	106	06	2	3'-0"	7'-0"	1 3/4"	SOLID CORE WOOD		H.M.	F-1						
CONF	107	107	07	3	3'-0"	7'-0"	1 3/4"	SOLID CORE WOOD	3X33	H.M.	F-1						
OFFICE B	108	108	08	3	3'-0"	7'-0"	1 3/4"	SOLID CORE WOOD	3X33	H.M.	F-1						
OFFICE A	110	110	08	3	3'-0"	7'-0"	1 3/4"	SOLID CORE WOOD	3X33	H.M.	F-1						
RECORDS CLERK	111	06	3	3	3'-0"	7'-0"	1 3/4"	SOLID CORE WOOD	3X33	H.M.	F-1						
FILES	112	112	06	2	3'-0"	7'-0"	1 3/4"	SOLID CORE WOOD		H.M.	F-1						
OFFICE C	113	113	09	3	3'-0"	7'-0"	1 3/4"	SOLID CORE WOOD	3X33	H.M.	F-1						
CHIEF	114	114	09	3	3'-0"	7'-0"	1 3/4"	SOLID CORE WOOD	3X33	H.M.	F-1						
CHIEF	114	115	04	2	3'-0"	7'-0"	1 3/4"	SOLID CORE WOOD		H.M.	F-1						
CHIEF	114	116	10	2	3'-0"	7'-0"	1 3/4"	SOLID CORE WOOD		H.M.	F-1						
DEPUTY CHIEF	118	117	10	2	3'-0"	7'-0"	1 3/4"	SOLID CORE WOOD		H.M.	F-1						
DEPUTY CHIEF	118	118	09	3	3'-0"	7'-0"	1 3/4"	SOLID CORE WOOD	3X33	H.M.	F-1						
ADMIN. ASST.	120	120	09	3	3'-0"	7'-0"	1 3/4"	SOLID CORE WOOD	3X33	H.M.	F-1						
EVIDENCE	121	09	9R	3	3'-0"	7'-0"	1 3/4"	SOLID CORE WOOD		H.M.	F-2					ACCESS CONTROLLED	
EVD LOCKER	122	122	11	9R	3'-0"	7'-0"	1 3/4"	SOLID CORE WOOD		H.M.	F-2					90 MIN.	
WOMENS	123	123A	12	2	3'-0"	7'-0"	1 3/4"	SOLID CORE WOOD		H.M.	F-1					90 MIN.	
WOMENS	123	123B	12	2	3'-0"	7'-0"	1 3/4"	SOLID CORE WOOD		H.M.	F-1						
W LOCKER	124	124	11	2	3'-0"	7'-0"	1 3/4"	SOLID CORE WOOD		H.M.	F-1						
CORRIDOR	125	06	2	2	3'-0"	7'-0"	1 3/4"	SOLID CORE WOOD		H.M.	F-1						
ELEC.	126	126	13	5	3'-0"	7'-0"	1 3/4"	FRP	3X33	H.M.	F-2						
MENS	128	128A	12	2	3'-0"	7'-0"	1 3/4"	SOLID CORE WOOD		H.M.	F-1						
CORRIDOR	1	128B	12	2	3'-0"	7'-0"	1 3/4"	SOLID CORE WOOD		H.M.	F-1						
M LOCKER	129	129	11	2	3'-0"	7'-0"	1 3/4"	SOLID CORE WOOD		H.M.	F-1						
ARMORY	131	06	9R	3	3'-0"	7'-0"	1 3/4"	SOLID CORE WOOD		H.M.	F-1					90 MIN.	
INVEST. OFFICE	132	132	09	2	3'-0"	7'-0"	1 3/4"	SOLID CORE WOOD		H.M.	F-1						
INVESTIGATIONS	133	133	03	3	3'-0"	7'-0"	1 3/4"	SOLID CORE WOOD	3X33	H.M.	F-1					ACCESS CONTROLLED	
INVEST. CAPT.	134	134	09	3	3'-0"	7'-0"	1 3/4"	SOLID CORE WOOD	3X33	H.M.	F-1						
INVEST. OFFICE A	135	09	3	3	3'-0"	7'-0"	1 3/4"	SOLID CORE WOOD	3X33	H.M.	F-1						
FILES	136	136	06	2	3'-0"	7'-0"	1 3/4"	SOLID CORE WOOD		H.M.	F-1						
INVEST. OFFICE C	137	137	09	3	3'-0"	7'-0"	1 3/4"	SOLID CORE WOOD	3X33	H.M.	F-1						
INTERVIEW 1	138	138	11	3	3'-0"	7'-0"	1 3/4"	SOLID CORE WOOD	3X33	H.M.	F-1						
INTERVIEW 2	139	139	11	3	3'-0"	7'-0"	1 3/4"	SOLID CORE WOOD	3X33	H.M.	F-1						
SECURE	140	03	3	3	3'-0"	7'-0"	1 3/4"	SOLID CORE WOOD	3X33	H.M.	F-1					ACCESS CONTROLLED	
GYM	127	141	07	2	3'-0"	7'-0"	1 3/4"	SOLID CORE WOOD		H.M.	F-1						
BREAK/STORM SHELTER	141	141B	14	8	3'-0"	7'-0"	1 3/4"	INSUL. STEEL		H.M.	F-3					90 MIN.	
BREAK/STORM SHELTER	141	141C	14	8	3'-0"	7'-0"	1 3/4"	INSUL. STEEL		H.M.	F-3					90 MIN.	
MECH. ELEC.	142	142	06	2	3'-0"	7'-0"	1 3/4"	SOLID CORE WOOD		H.M.	F-1					ACCESS CONTROLS, ICC 500 RATED	
ADA RR	144	04	2	2	3'-0"	7'-0"	1 3/4"	SOLID CORE WOOD		H.M.	F-1					ACCESS CONTROLS, ICC 500 RATED	
BOOKING	149	145	06	2	3'-0"	7'-0"	1 3/4"	SOLID CORE WOOD		H.M.	F-1						
PATROL WORK AREA	148	146	06	3	3'-0"	7'-0"	1 3/4"	SOLID CORE WOOD	3X33	H.M.	F-1						
ADA RR	147	147A	04	2	3'-0"	7'-0"	1 3/4"	SOLID CORE WOOD		H.M.	F-1						
IT	130	147B	06	2	3'-0"	7'-0"	1 3/4"	SOLID CORE WOOD		H.M.	F-1						
CORRIDOR	148	14	6	3	3'-0"	7'-0"	1 3/4"	INSUL. STEEL		H.M.	F-3					90 MIN.	
BOOKING	149	149A	09	3	3'-0"	7'-0"	1 3/4"	SOLID CORE WOOD	3X33	H.M.	F-1					ICC 500 RATED	
BOOKING	149	149B	02.2	7	3'-6"	7'-0"	1 3/4"	ALUM./GLASS	INSUL./LOW-E/ TINTED	ALUM. S.F.		4"				ACCESS CONTROLLED	
CORRIDOR	3	150A	09	3	3'-0"	7'-0"	1 3/4"	SOLID CORE WOOD	3X33	H.M.	F-1						
PATROL CAPT.	150	09	3	3	3'-0"	7'-0"	1 3/4"	SOLID CORE WOOD	3X33	H.M.	F-1						
SRO	A151	A151	07	2	3'-0"	7'-0"	1 3/4"	SOLID CORE WOOD		H.M.	F-1						
K9	A152	A152	07	2	3'-0"	7'-0"	1 3/4"	SOLID CORE WOOD		H.M.	F-1						
TRAINING SGT	A153	A153	07	2	3'-0"	7'-0"	1 3/4"	SOLID CORE WOOD		H.M.	F-1						
UNIFORM	A154	A154	07	2	3'-0"	7'-0"	1 3/4"	SOLID CORE WOOD		H.M.	F-1						
ANIMAL CONTROL	A155	07	2	2	3'-0"	7'-0"	1 3/4"	SOLID CORE WOOD		H.M.	F-1						
SPECIAL OPS	A156	07	2	2	3'-0"	7'-0"	1 3/4"	SOLID CORE WOOD		H.M.	F-1						
LOBBY	A157	A157	15	1	6'-0"	7'-0"	1 3/4"	ALUM./GLASS	INSUL./LOW-E/ TINTED	ALUM. S.F.		4"				PAIR DOORS	
COURT	A165	A157A	07	2	3'-0"	7'-0"	1 3/4"	SOLID CORE WOOD		H.M.	F-1						
MEN	A158	A158	04	2	3'-0"	7'-0"	1 3/4"	SOLID CORE WOOD		H.M.	F-1						
WOMEN	A159	04	2	2	3'-0"	7'-0"	1 3/4"	SOLID CORE WOOD		H.M.	F-1						
CR. MAG. ASSIT.	A160	A160	07	2	3'-0"	7'-0"	1 3/4"	SOLID CORE WOOD		H.M.	F-1						
CR. MAG. ASSIT.	A160	A160A	07	2	3'-0"	7'-0"	1 3/4"	SOLID CORE WOOD		H.M.	F-1						
CONF	A162	A162	04	2	3'-0"	7'-0"	1 3/4"	SOLID CORE WOOD		H.M.	F-1						
CONF	A163	A163	04	10R	3'-0"	7'-0"	1 3/4"	SOLID CORE WOOD		H.M.	F-1						
COURT	A165	A165B	16	5	3'-0"	7'-0"	1 3/4"	SOLID CORE WOOD	3X33	H.M.	F-2					45 MIN.	
COURT	A165	A165C	02.1	5	3'-0"	7'-0"	1 3/4"	FRP	3X33	H.M.	F-2					ACCESS CONTROLLED	

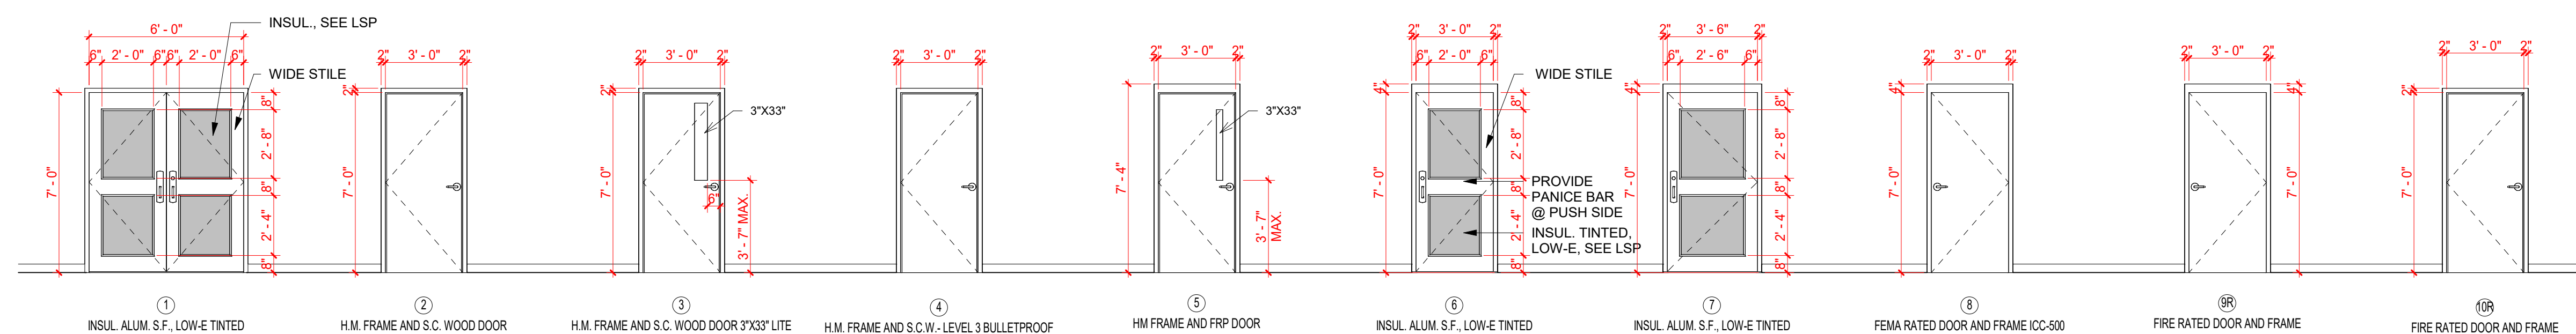


DOOR TYPES

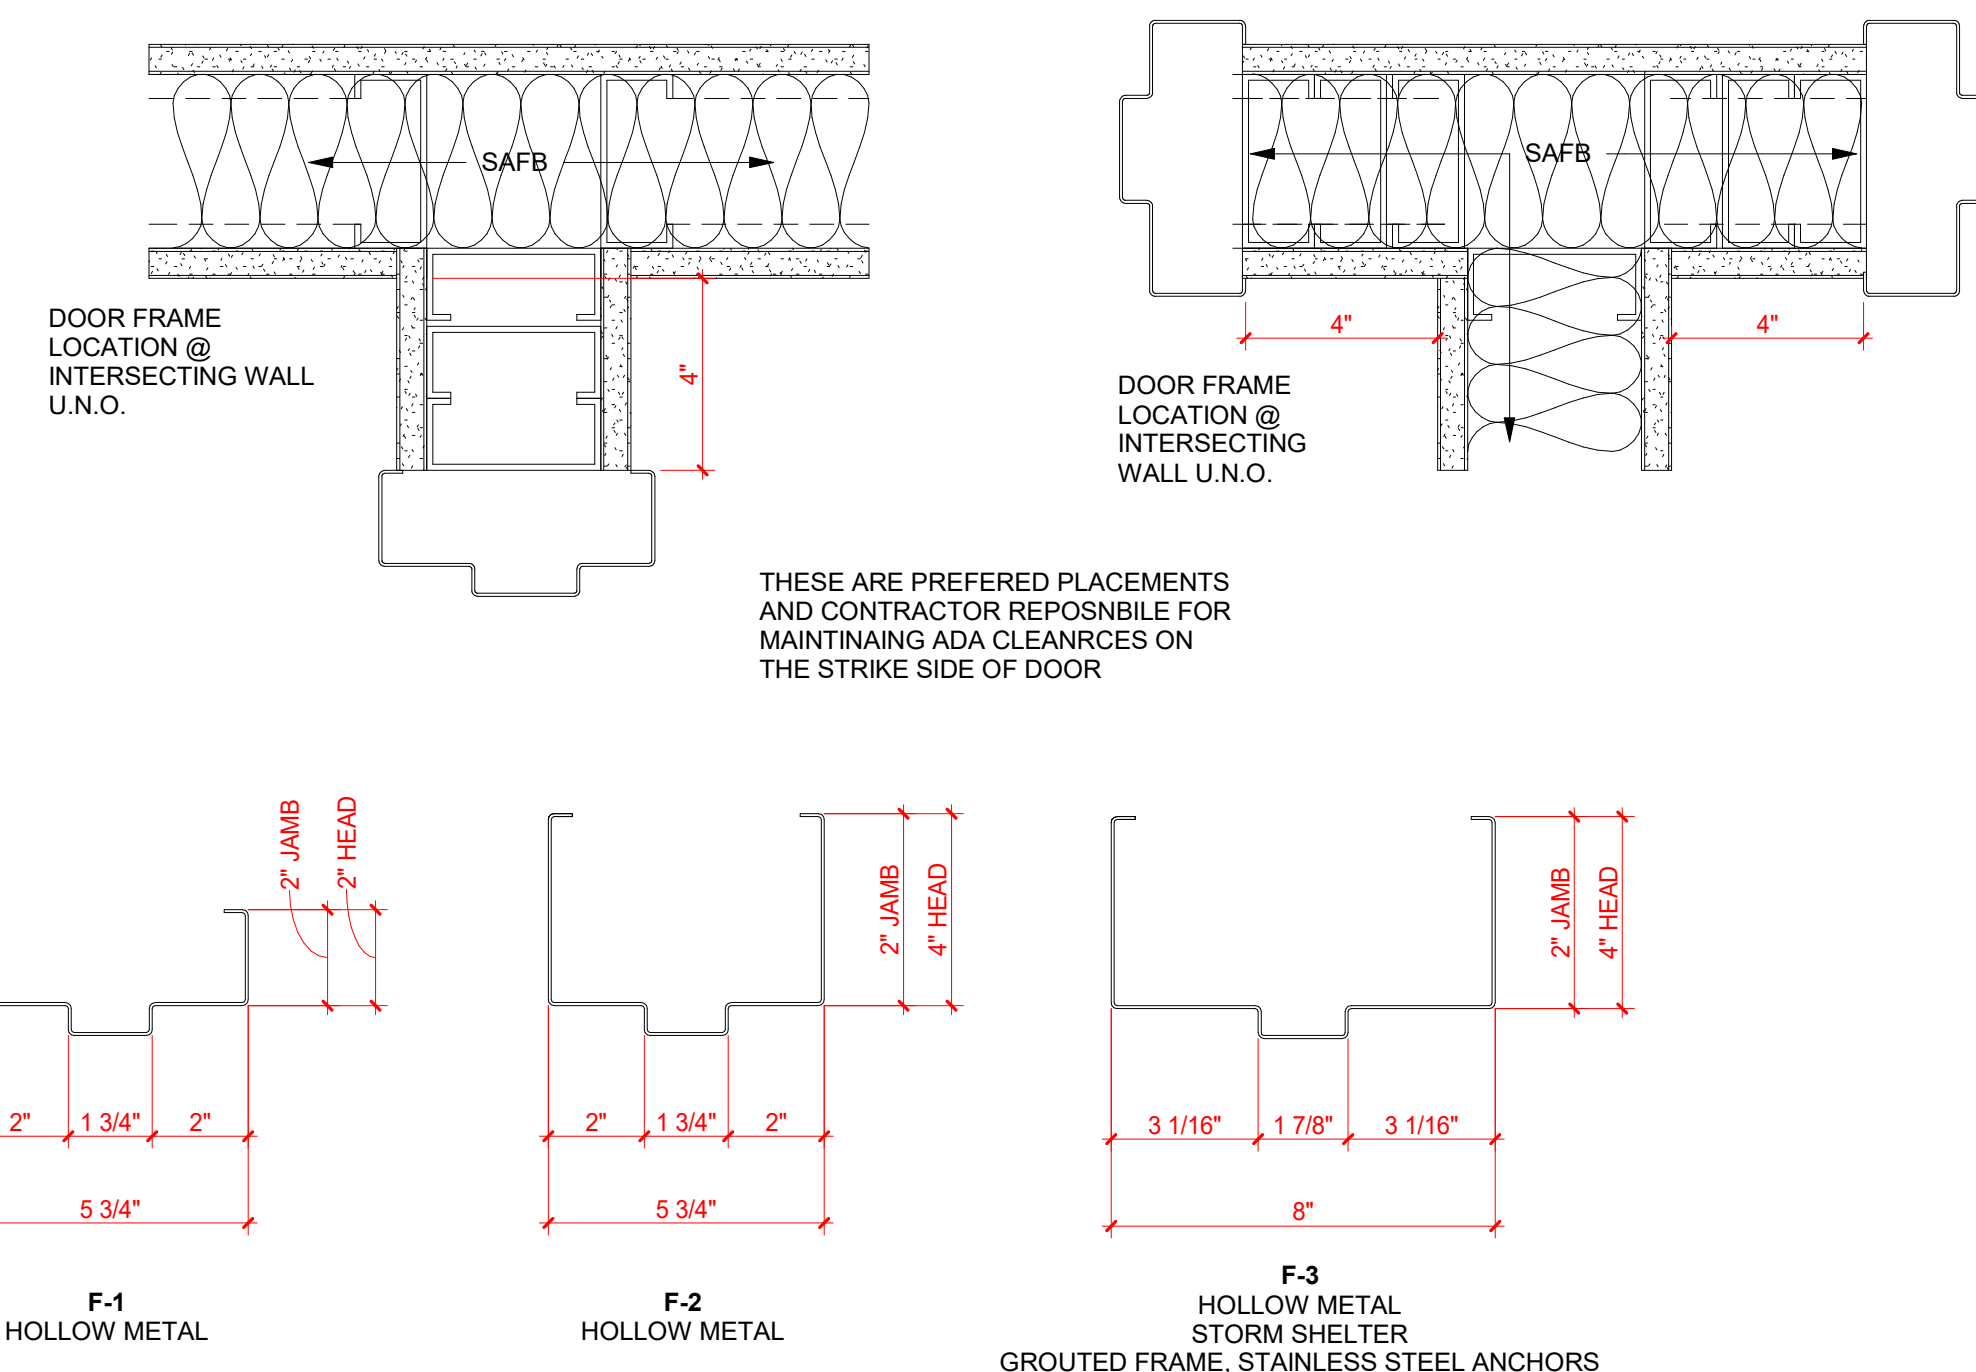

9 HOLLOW METAL FRAME TYPES

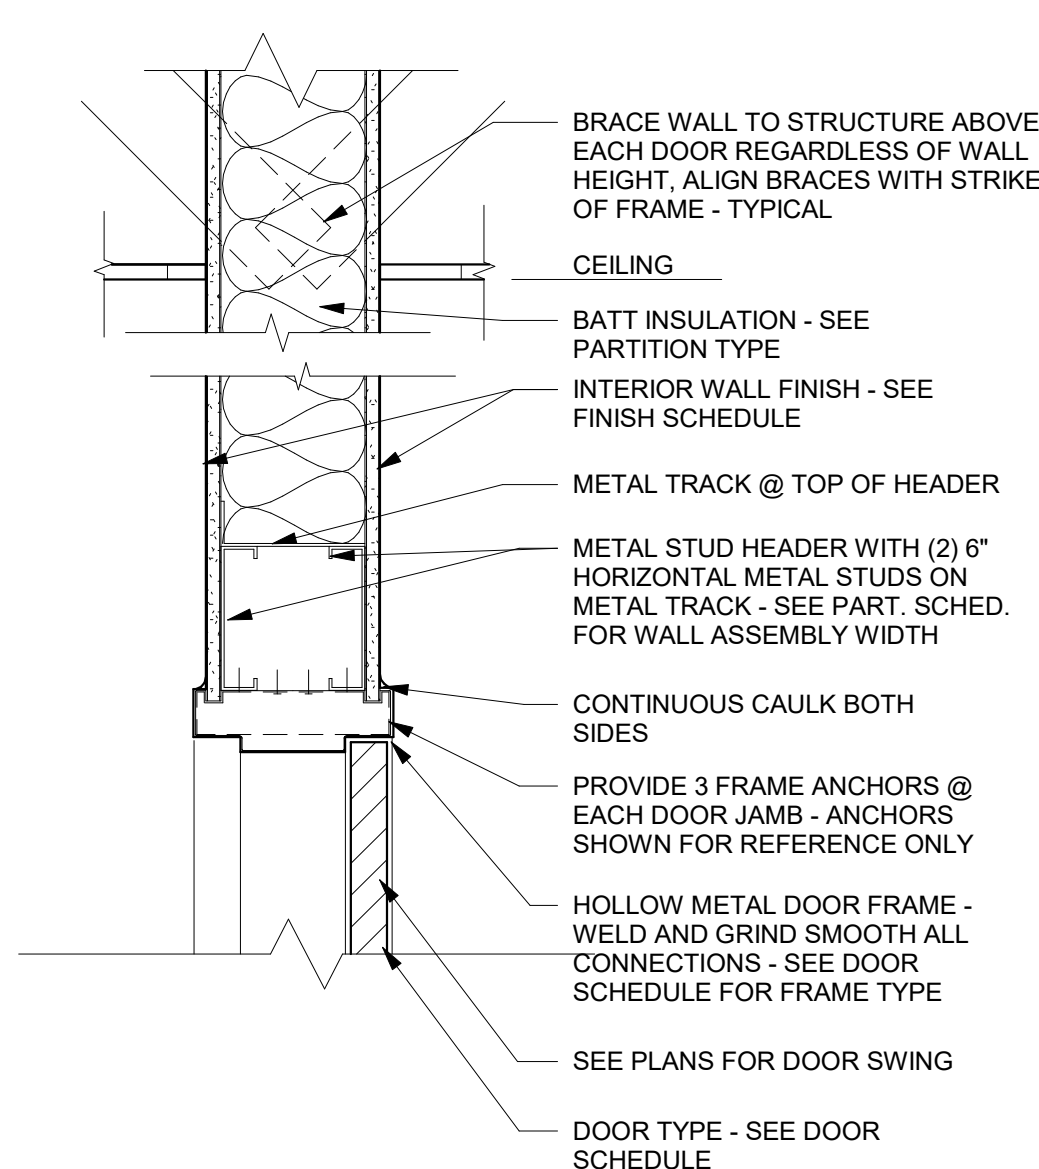

HEAD/JAMB DETAIL - GYP ON STUD (INTERIOR)

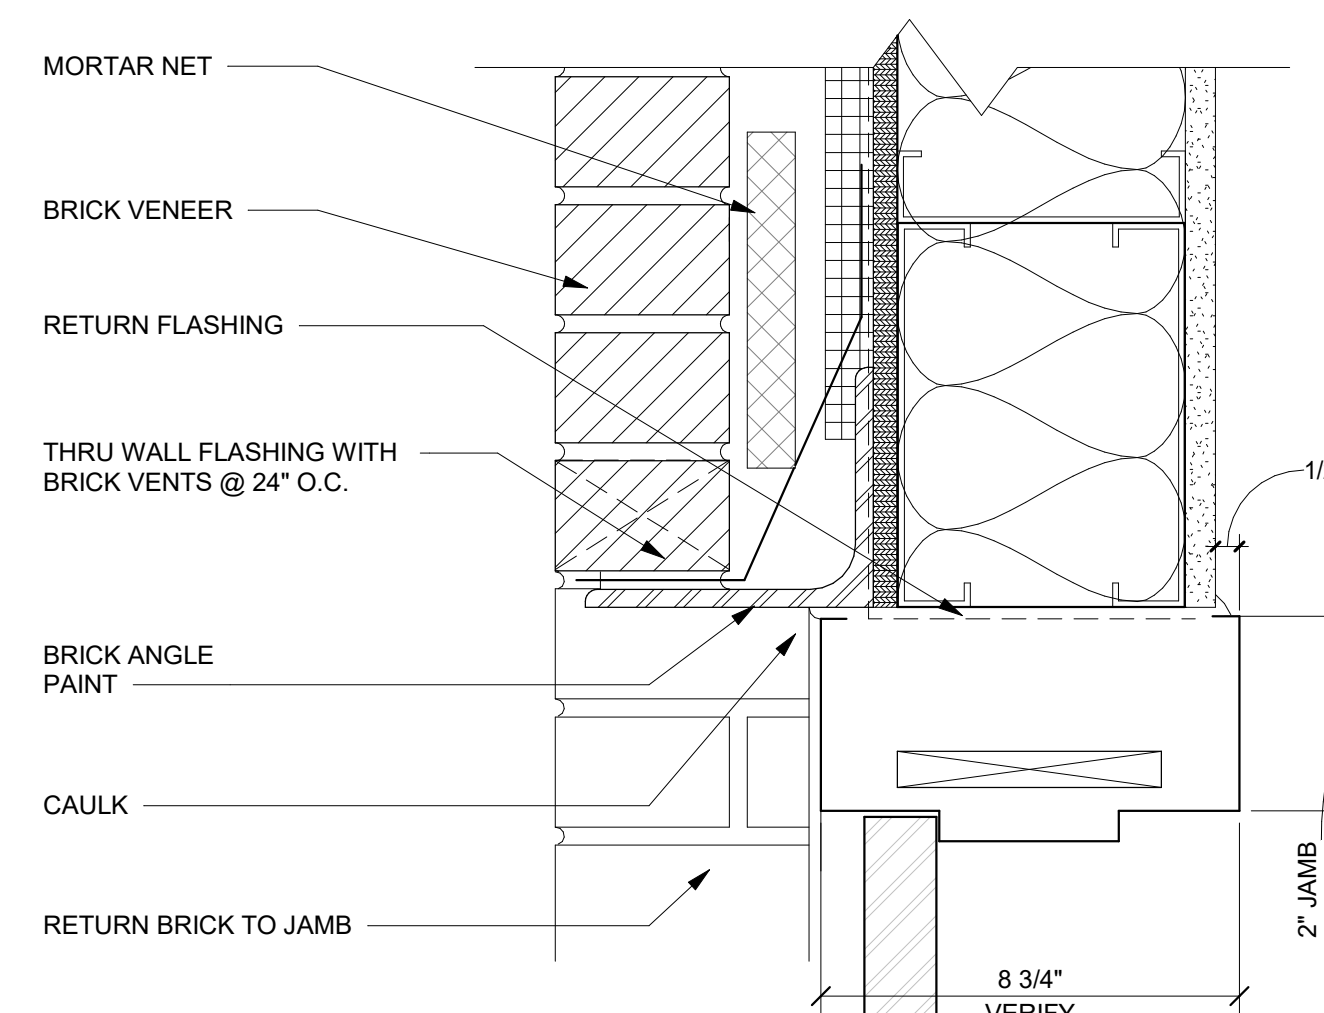

TYPICAL HM HEAD- EXTERIOR



**BILL WHITTAKER, P.C.
ARCHITECTURE**
236 MARTIN STREET
ANNISTON, AL 36206
256.689.0238
WWW.BILLWARCH.COM



NEW CITY OF LINCOLN
POLICE DEPARTMENT
LINCOLN, ALABAMA



OWNER
City of Lincoln
150 Magnolia St.
Lincoln, AL 35096
205-763-7777
Attn: Lew Watson

ARCHITECT
Bill Whittaker, P.C.
Architecture
236 Martin Street
Anniston, AL 36201
Attn: Bill Whittaker

CIVIL ENGINEER
TTL
10 Inverness Center Pkwy
Suite 350
Hoover, AL 35242
256-441-2232
Attn: Tim Roberts

STRUCTURAL ENGINEER
Barnett, Jones, Wilson
125 18th St N
Pell City, AL 35125
205-884-5334

Attn: Jeremy Deal

**MECHANICAL/PLUMBING
PROTECTION ENGINEER**
Whorton Engineering, Inc.
25 Summerall Gate Road
Anniston, AL 36205
256-820-9897
Attn: Randy Whorton

ELECTRICAL ENGINEER
Hays Cheatwood Consulti
P.O. Box 250
Pinson, AL 35126
205-942-0696
Attn: Tony Dodd


ISSUE:
3.31.25 BID
4.16.25 ADD #2

JOB NO.
24001

DESCRIPTION:
DOOR AND
FRAME TYPES

SHEE


A7.1

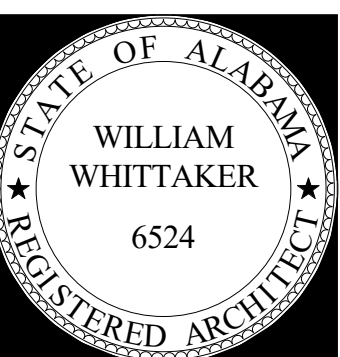


DIFFUSER SCHEDULE

Tag	Size	Type	Neck Size	Model Number	Manufacturer	Notes
ASD-6	12"x12"	SUPPLY	6" DIA	TDC-AA	TITUS	ALUMINUM
ASD-8	24"x24"	SUPPLY	8" DIA	TDC-AA	TITUS	ALUMINUM
ASD-10	24"x24"	SUPPLY	10" DIA	TDC-AA	TITUS	ALUMINUM
SED-8	24"x24"	SUPPLY	8" DIA	SG-TDC	TITUS	SECURITY GRILLE
TG-24	24"x24"	TRANSFER	22"x22"	8F	TITUS	ALUMINUM
SDD-8	12"x12"	SUPPLY	8" DIA	TDC	TITUS	
SD-6	24"x24"	SUPPLY	6" DIA	TDC	TITUS	
SD-8	24"x24"	SUPPLY	8" DIA	TDC	TITUS	
SD-10	24"x24"	SUPPLY	10" DIA	TDC	TITUS	
OA-24	24"x24"	SUPPLY	22"x22"	8R	TITUS	
RG-24	24"x24"	RETURN	22"x22"	8RF	TITUS	TO INCLUDE 1" FILTER
DG-1616	16"x16"	TRANSFER	---	T700	TITUS	



1. FURNISH AND INSTALL AN INSULATION BLANKET ON THE BACK OF ALL DIFFUSERS AND GRILLES.
2. CONTRACTOR SHALL VERIFY FINAL COLOR/FINISH OF ALL DIFFUSERS/GRILLES WITH ARCHITECT PRIOR TO ORDERING.

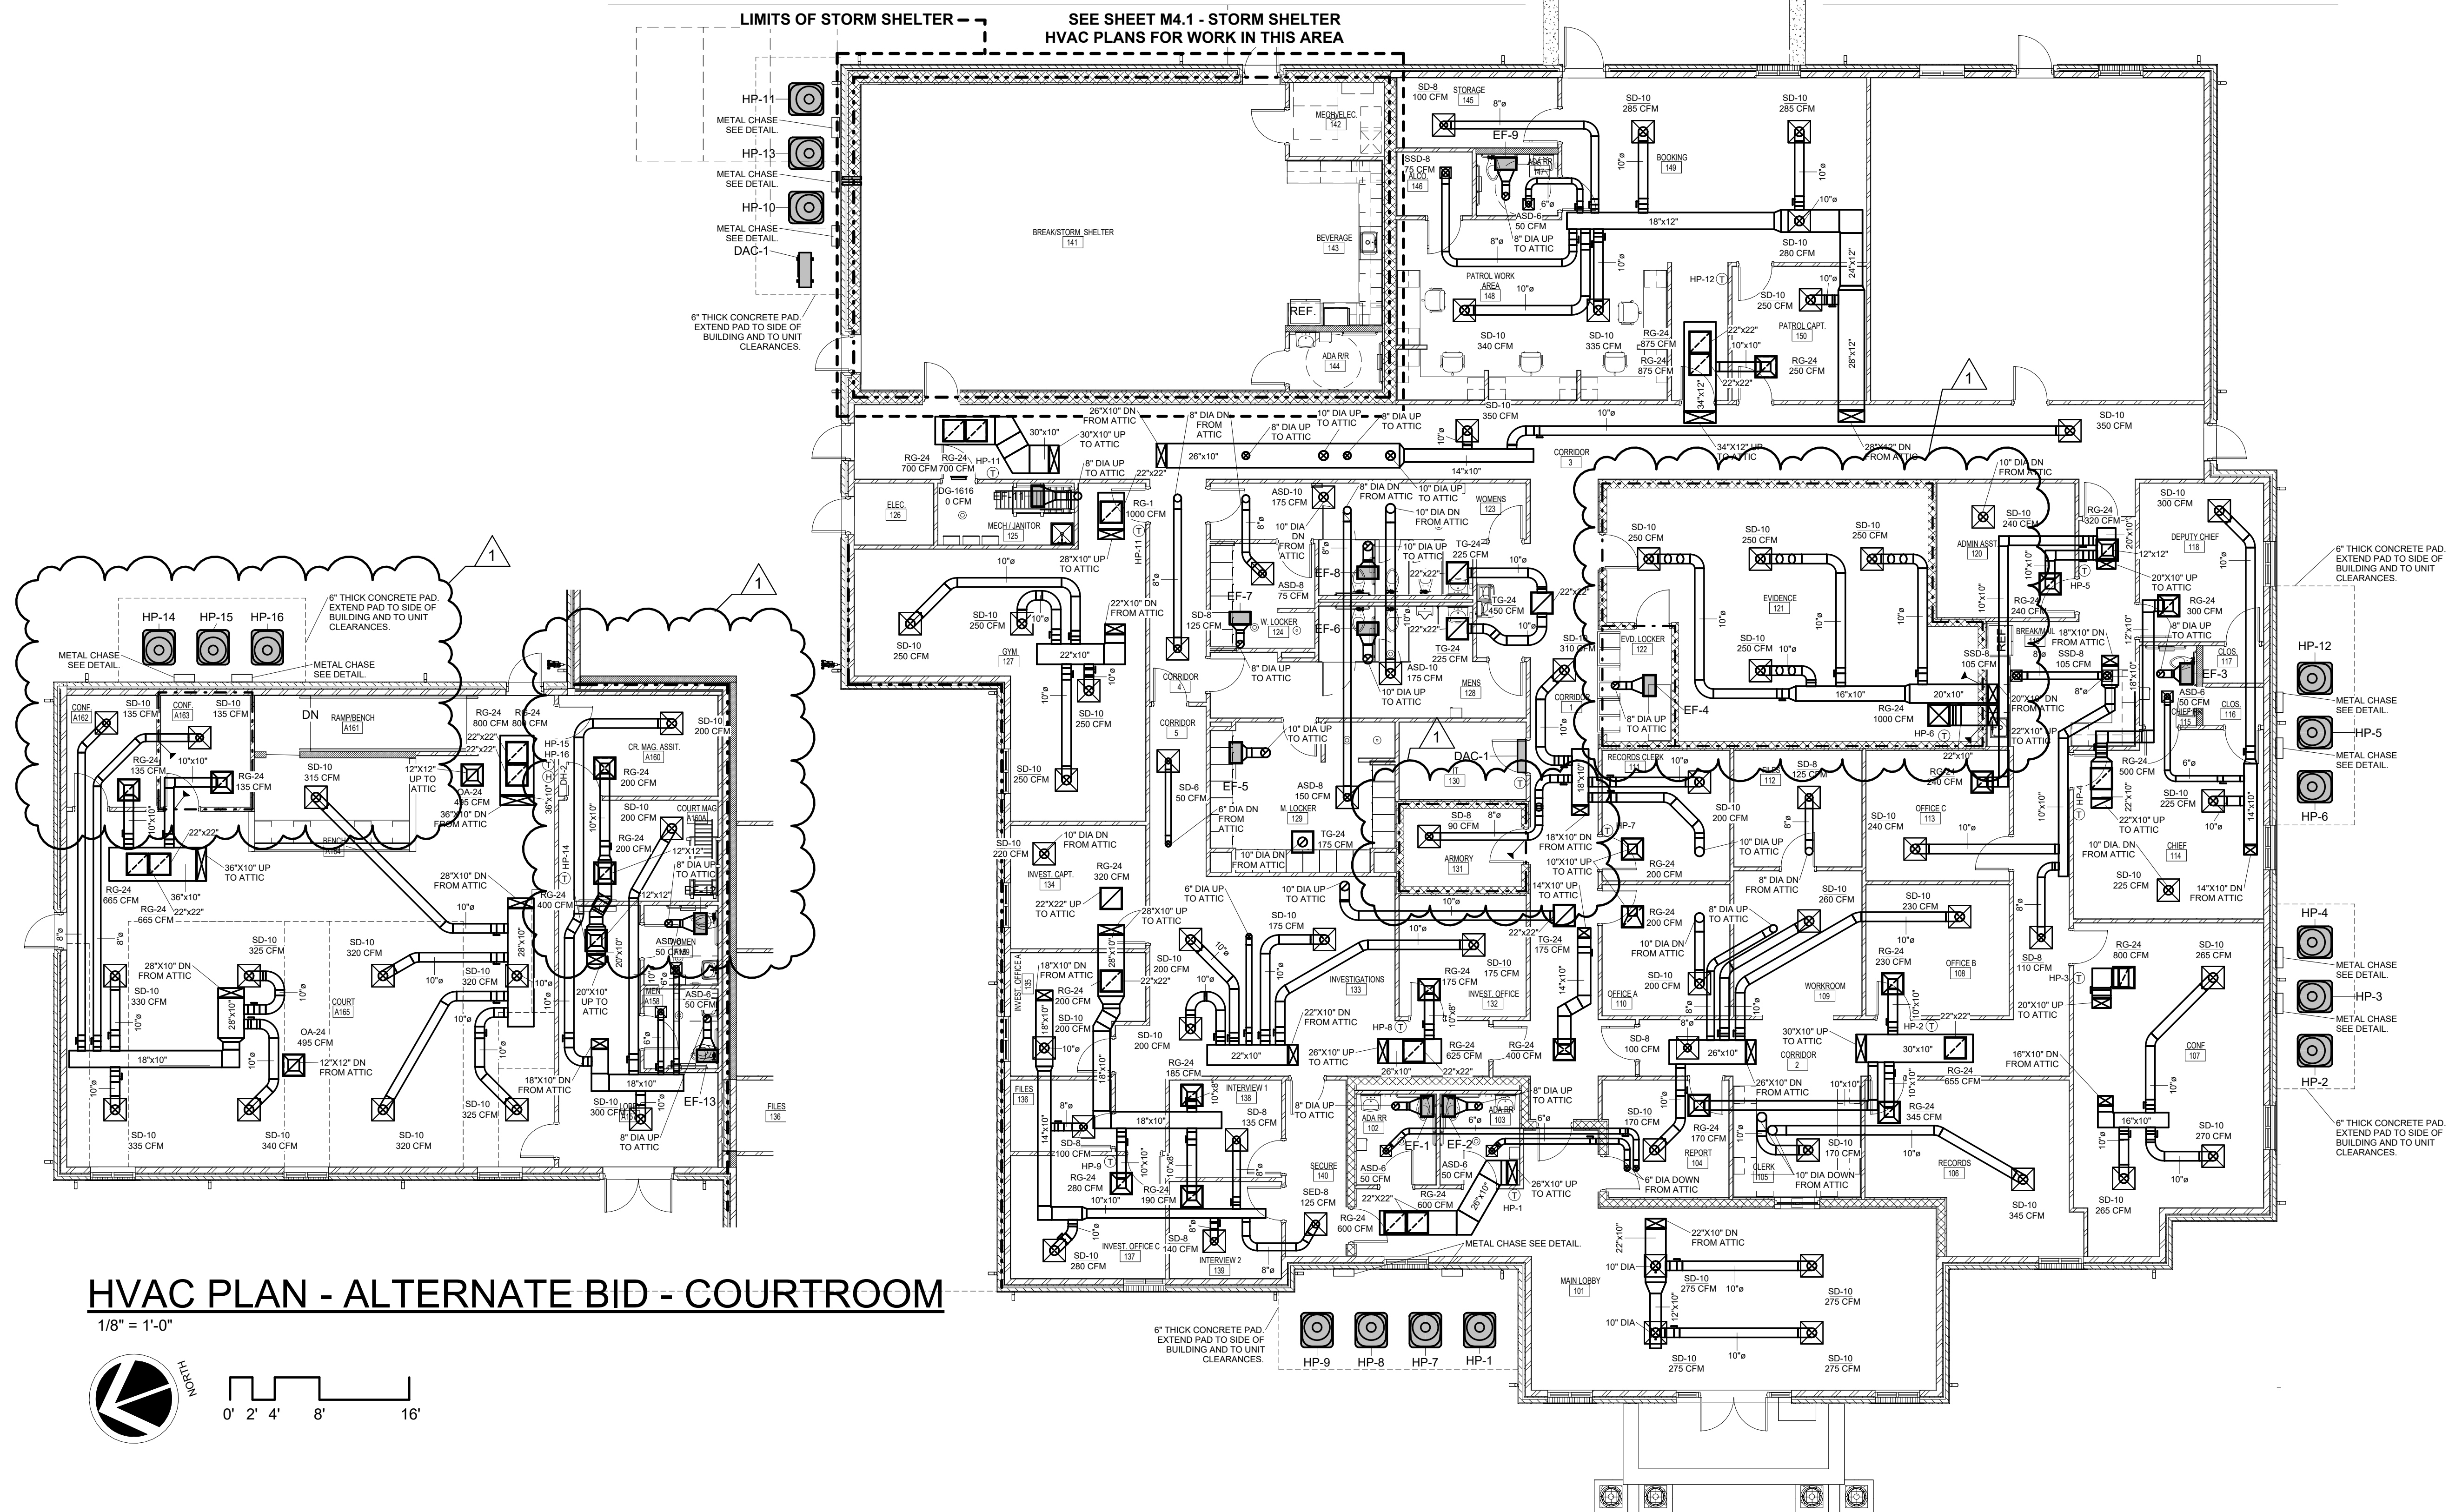


HVAC PLAN - ALTERNATE BID - COURTROOM

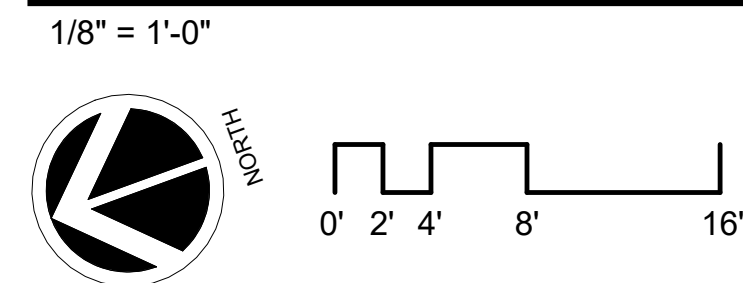

HVAC PLAN - BASE BID

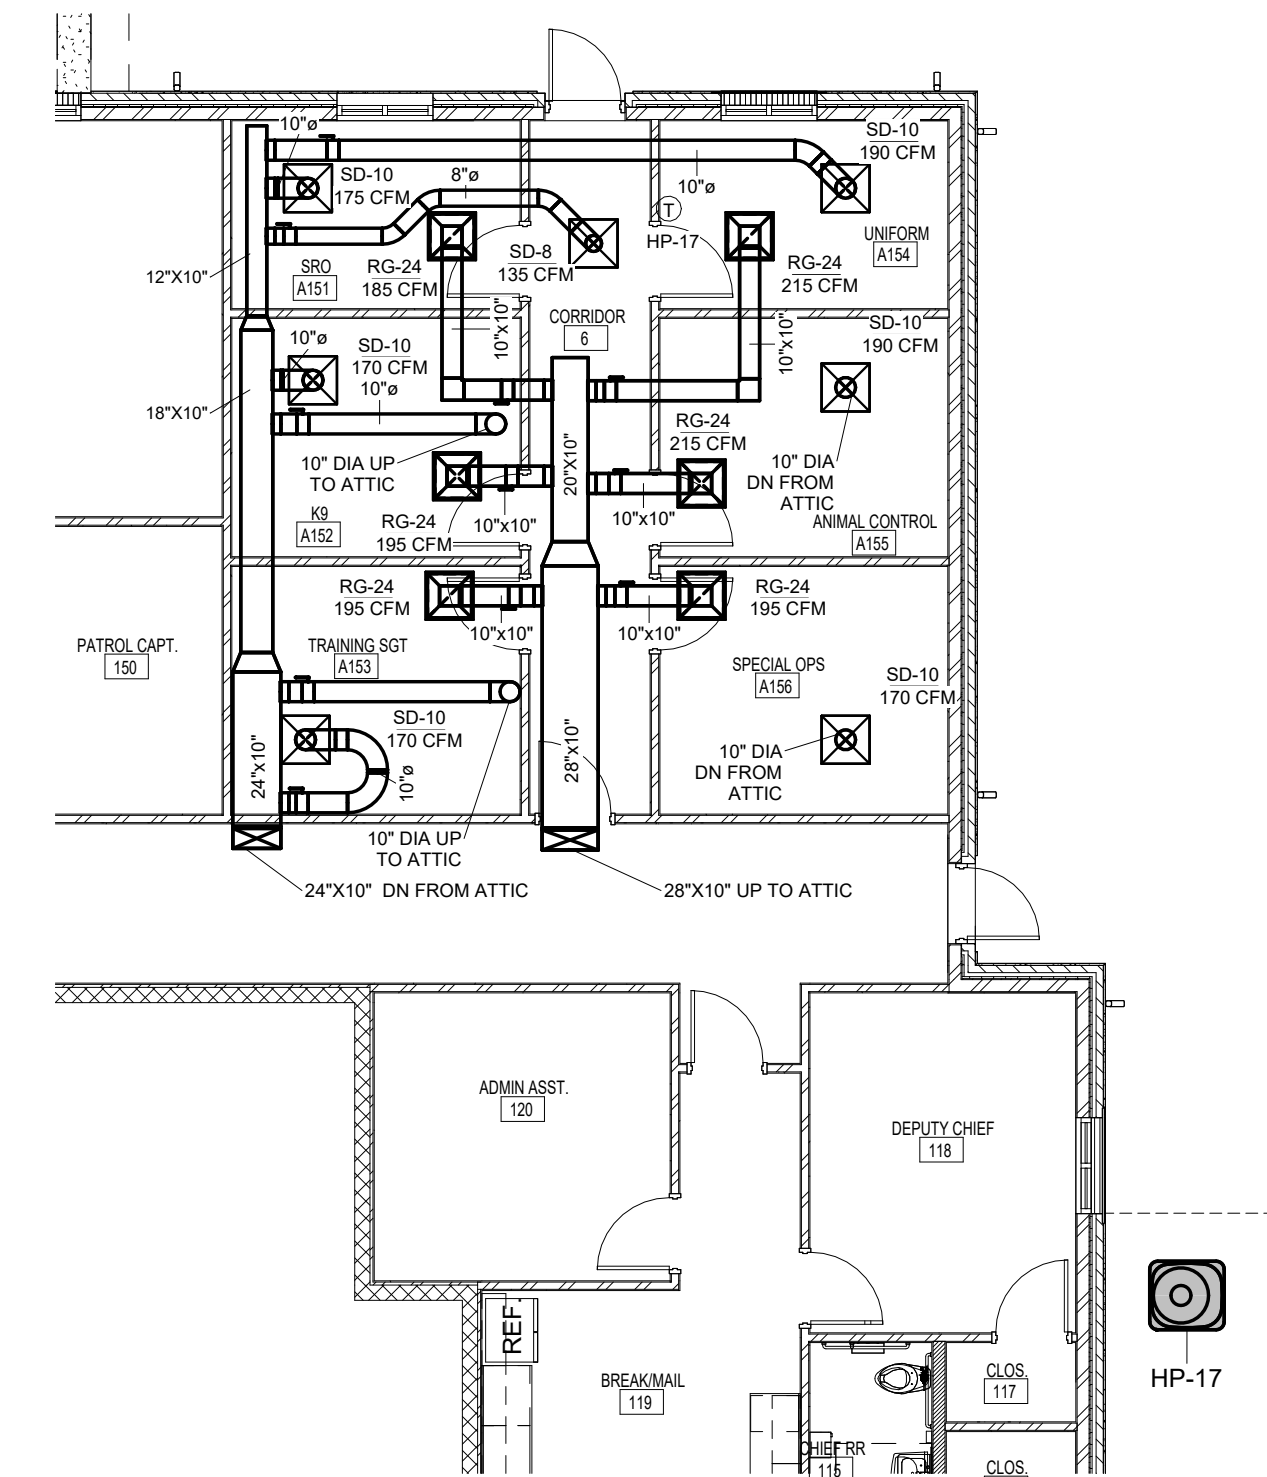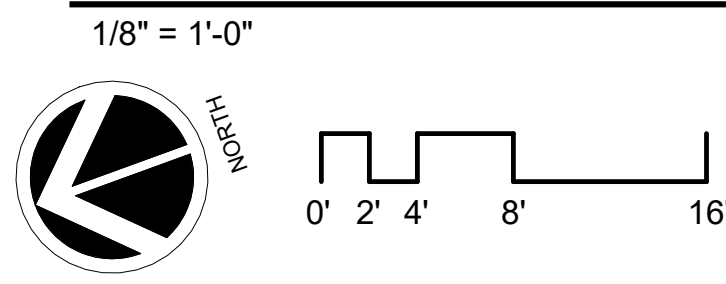

HVAC PLAN - ALTERNATE BID - OFFICE

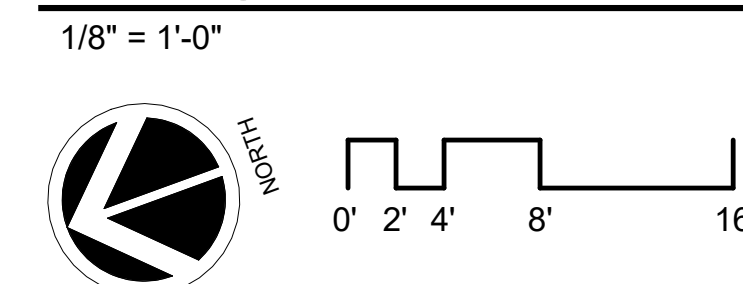

FIREWALL LEGEND

- ONE HOUR RATED FIRE BARRIER
--- TWO HOUR RATED FIRE BARRIER

GENERAL NOTES:

- ALL DIFFUSERS/GRILLE RUNOUTS SHALL INCLUDE SPIN-IN WITH DAMPER.
- ALL OUTSIDE AIR RUNOUTS, EXHAUST, ETC. AND BRANCH DUCTS SHALL INCLUDE SPIN-IN WITH DAMPER.
- REFERENCE PLUMBING PLANS FOR CONDENSATE PIPING.
- TEST AND BALANCE IS REQUIRED FOR ALL UNITS, DUCT, GRILLES, ETC. SHOWN ON PLANS. REFERENCE SPECIFICATIONS FOR ADDITIONAL INFORMATION.
- ALL LOUVERS SHALL HAVE A PLENUM BOX. PLENUM BOX SHALL BE SIZED TO MATCH LOUVER DIMENSIONS. PLENUM BOX SHALL BE 18" DEEP.
- FRESH AIR DAMPERS TO BE 120VAC, NORMALLY CLOSED. THE DAMPER SHALL BE WIRED TO OPEN WHEN ROOM LIGHTS ARE ON AND THE UNIT FAN IS RUNNING. TYPICAL UNLESS OTHERWISE NOTED.
- MECHANICAL CONTRACTOR SHALL COORDINATE ROUTING OF REFRIGERANT LINES AND DUCTWORK WITH ALL OTHER TRADES.

WHORTON ENGINEERING, INC.


HVAC - PLUMBING - PROCESS CONTROL

Randall Whorton

RANDALL WHORTON, P.E.
PHONE: (256) 820-9897

DATE 04-16-2025
25 SUMMERALL GATE ROAD
ANNISTON, ALABAMA 36205

WHORTON ENGINEERING PROJECT NO. 23222

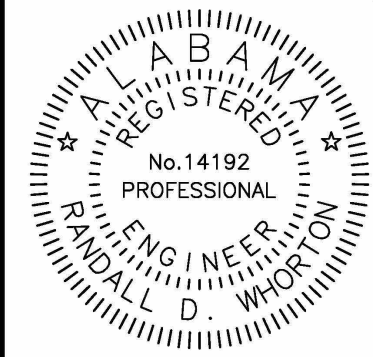

BILL WHITTAKER, P.C.
ARCHITECTURE
236 MARTIN STREET
ANNISTON, AL 36206
256-899-0238
WWW.BILLWHITTAKER.COM



NEW CITY OF LINCOLN
POLICE DEPARTMENT
LINCOLN, ALABAMA



OWNER:
City of Lincoln
150 Magnolia St.
Lincoln, AL 35096
256-753-7777
Attn: Lew Watson

ARCHITECT
Bill Whittaker, P.C.
Architecture
236 Martin Street
Anniston, AL 36206
Attn: Bill Whittaker

CIVIL ENGINEER
TTL
10 Inverness Center Pkwy
Suite 350
Hoover, AL 35242
256-441-2232
Attn: Tim Roberts

STRUCTURAL ENGINEER
Barnett Jones, Wilson
125 18th St N
Pell City, AL 35125
205-894-5334
Attn: Jeremy Deal

MECHANICAL PLUMBING/FIRE
PROTECTION ENGINEER
Whorton Engineering, Inc.
25 Summerall Gate Road
Anniston, AL 36205
256-820-9897
Attn: Randy Whorton

ELECTRICAL ENGINEER
Hays Chadwood Consulting
P.O. Box 250
Prison, AL 35126
256-842-0986
Attn: Tony Dodd


ISSUE:
03.31.25 BID
04.16.25 ADD #2

JOB NO.
24001
DESCRIPTION:
HVAC PLANS


SHEET

M3.1


RISER DIAGRAM SYMBOLS

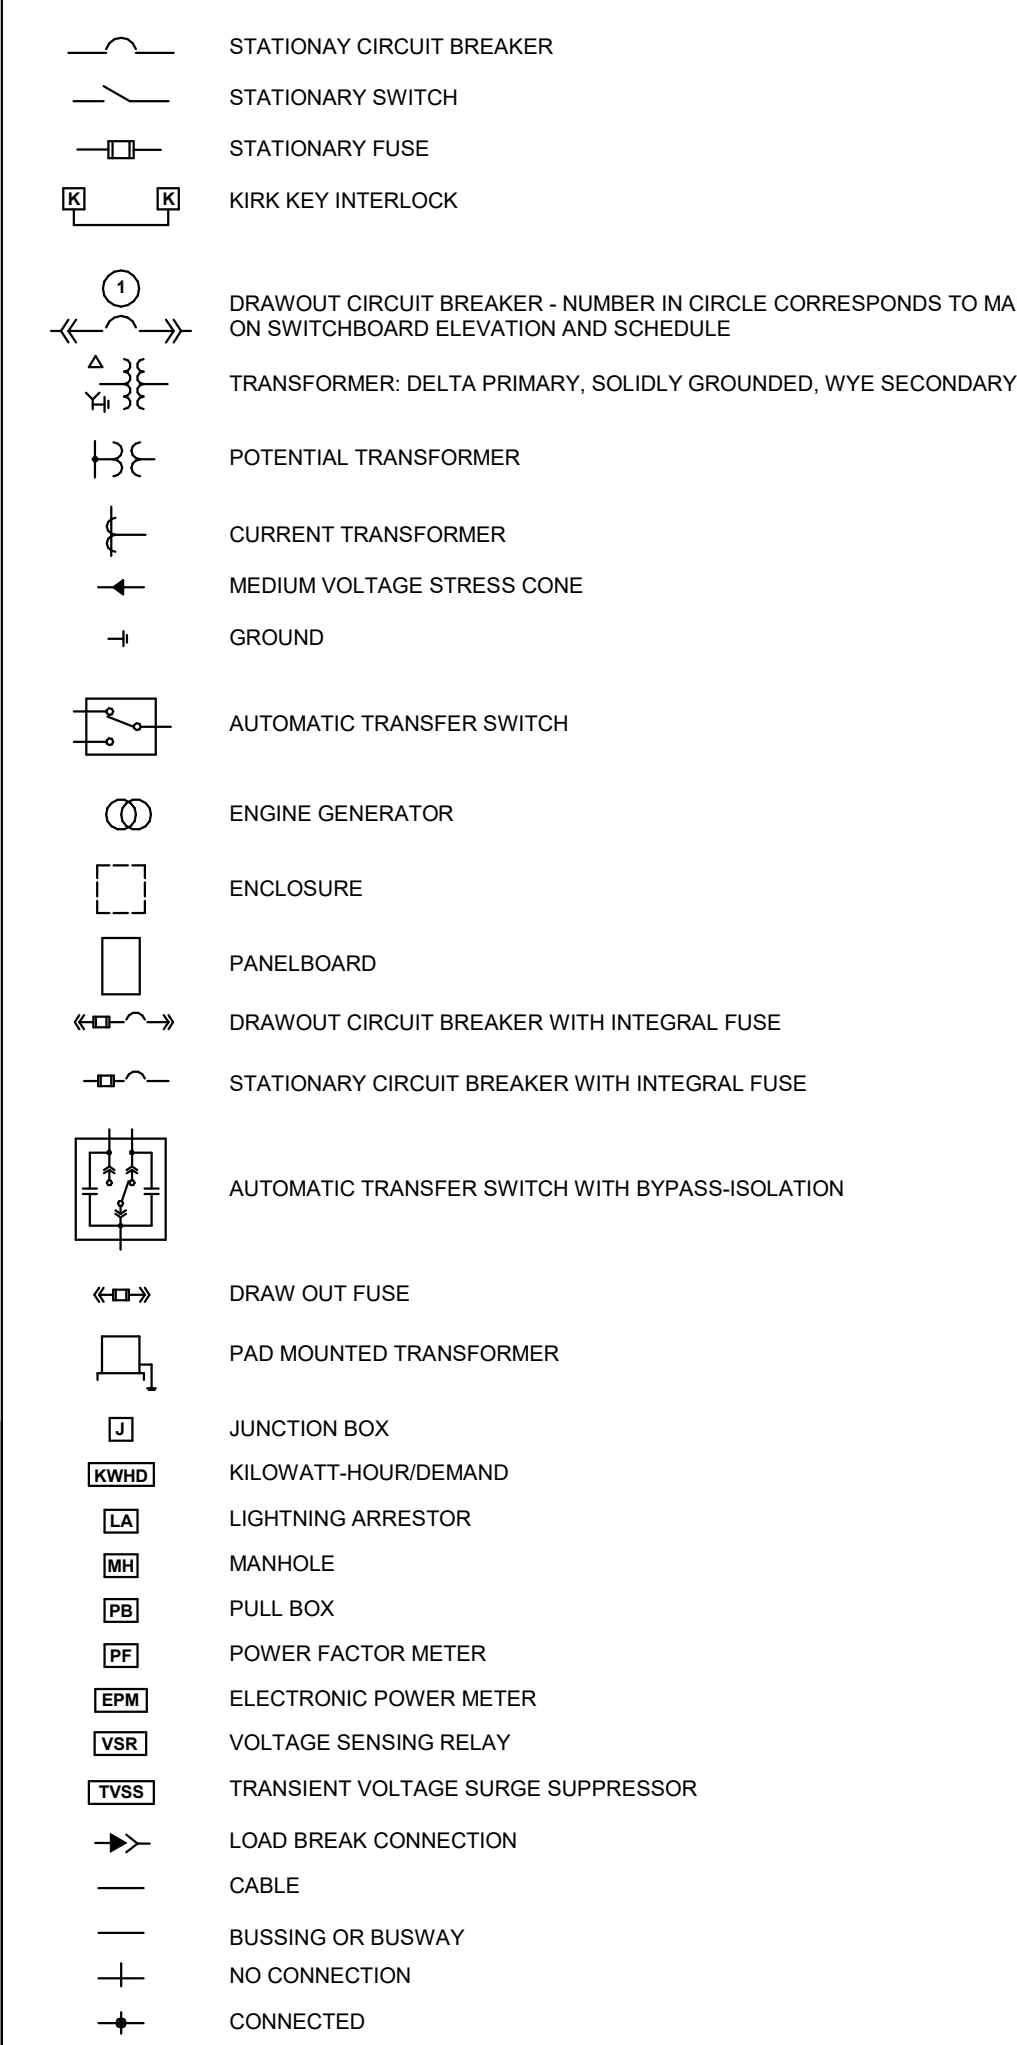


SITE ELECTRICAL

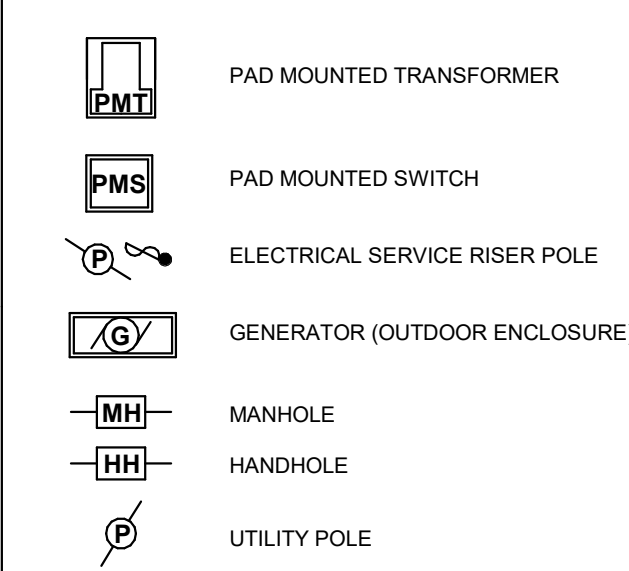


LIGHTNING PROTECTION & GROUNDING

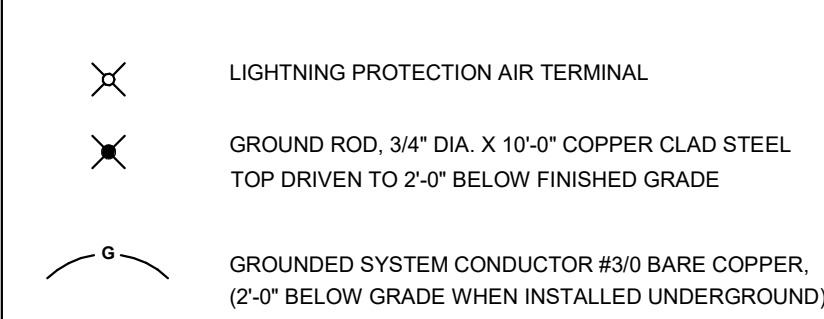


SECURITY

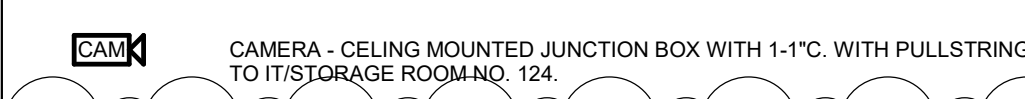

DOOR CONTROLS

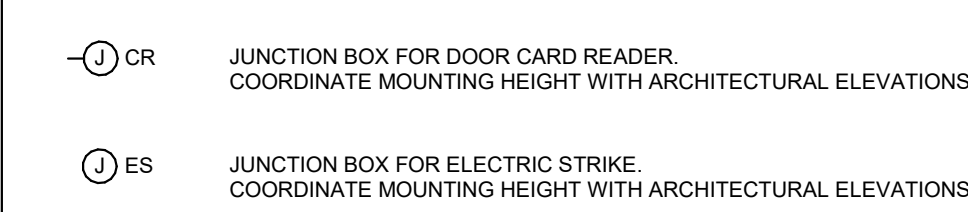


POWER AND AUXILIARY - FLOOR OUTLETS

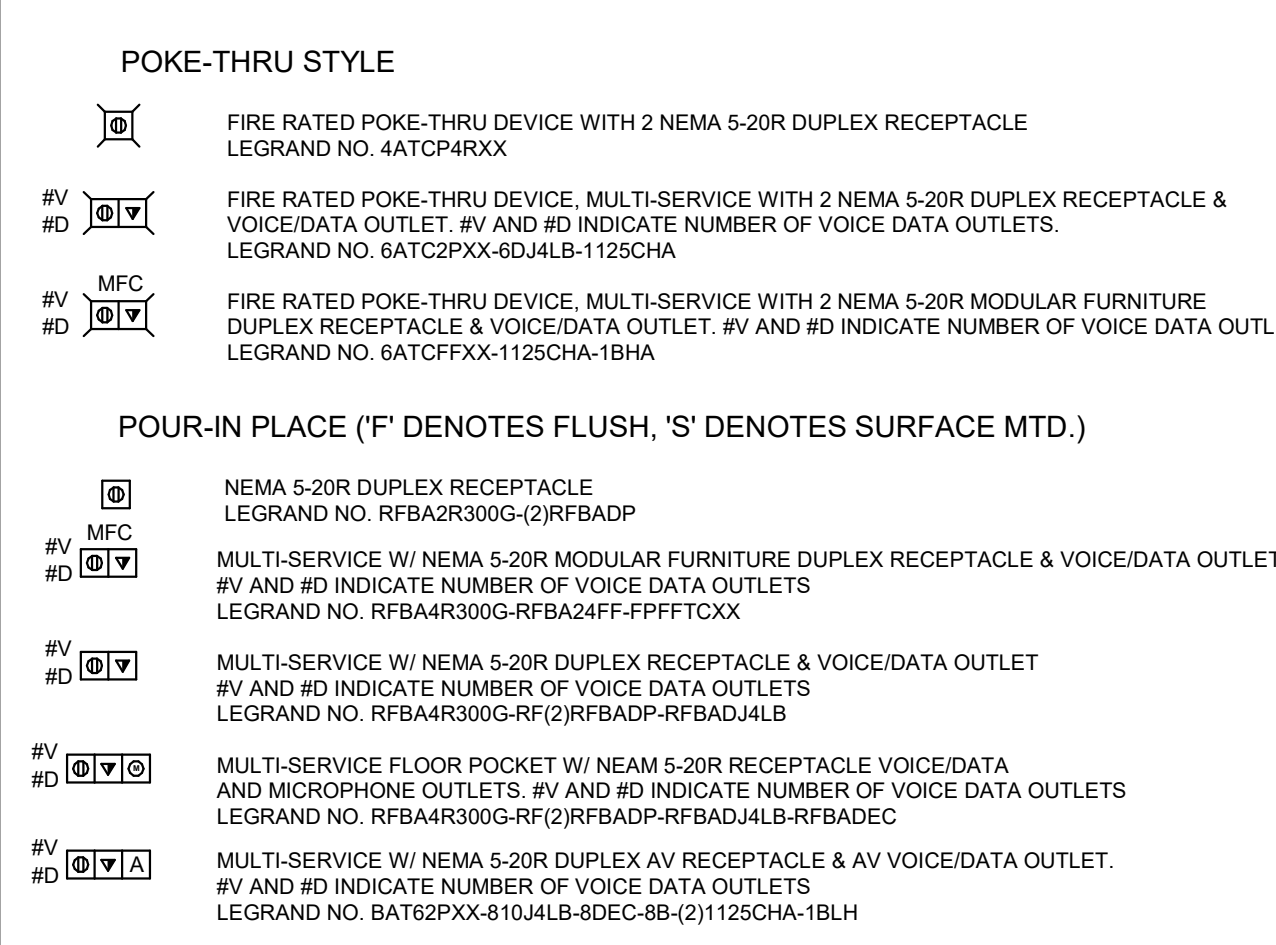

NOTE: VERIFY LOCATION OF EQUIPMENT, FLOOR FINISH, COVER STYLE & FINISH PRIOR TO ROUGH-IN



TELE/DATA

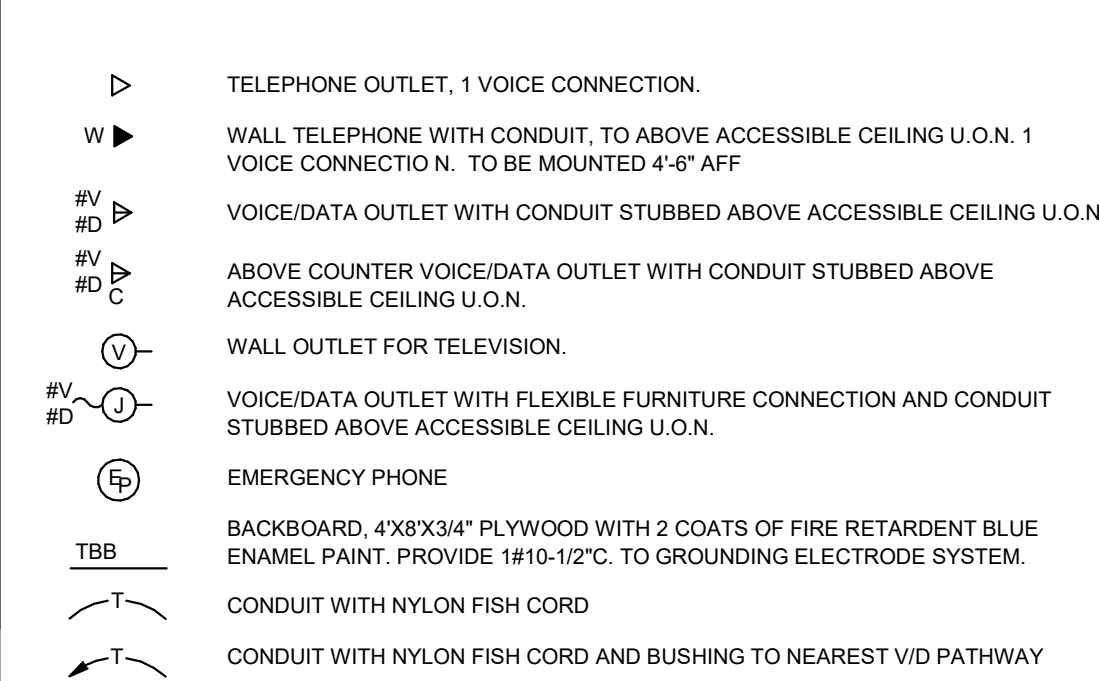

TELE/DATA CONDUIT SIZING CHART		
TOTAL NUMBER OF CABLES	CONDUIT SIZE	
1-2	1/2\"	
3-4	3/4\"	
5-7	1\"	
8-12	1 1/4\"	

- NOTES:
- CONDUIT SIZES ARE BASED ON NEC 40% FILL CAPACITY WITH ALL CABLES HAVING AN OUTSIDE DIAMETER OF 0.25\"
 - #V AND #D DENOTE THE NUMBER OF VOICE AND DATA CABLES RESPECTIVELY.
 - PROVIDE 2 GANG BOX WITH GANG PLASTER RING FOR ALL OUTLETS.
 - ALL OUTLETS ARE TO HAVE TWO(2) VOICE AND TWO(2) DATA CONNECTIONS U.O.N.


FIRE ALARM

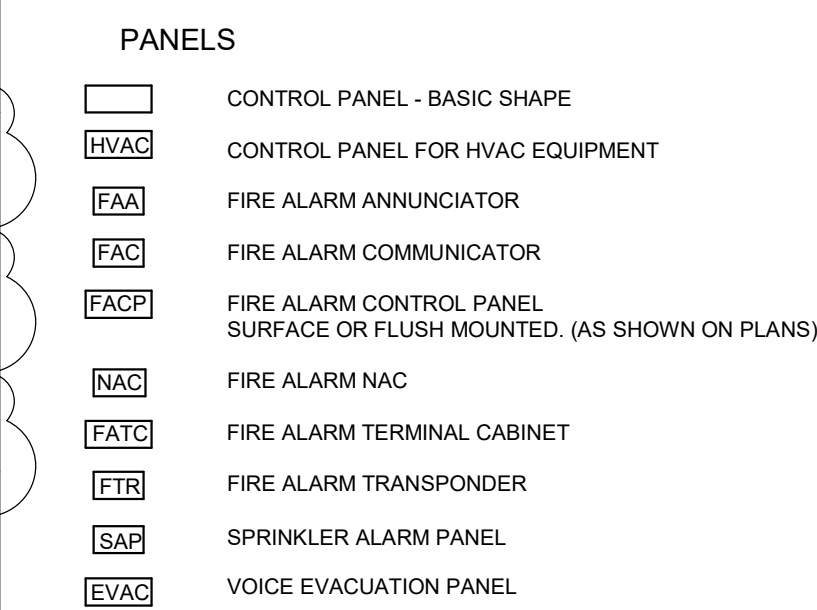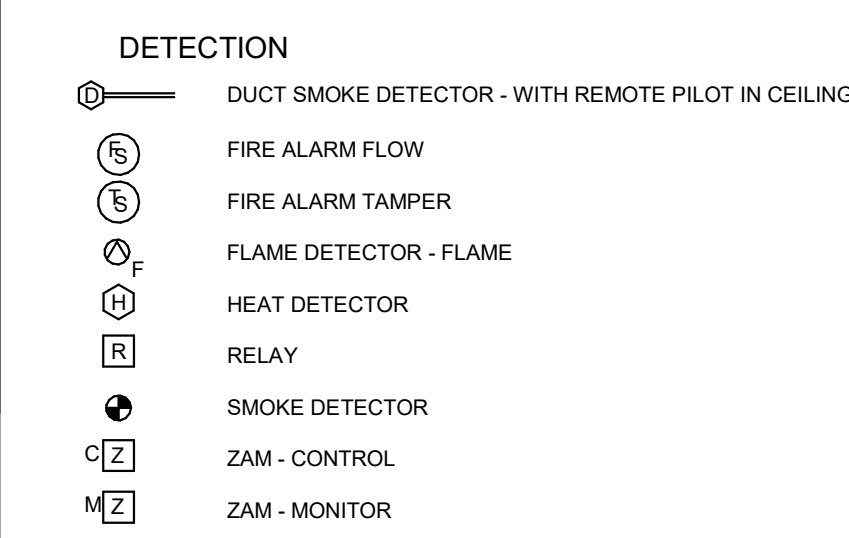


RECEPTACLES




POWER

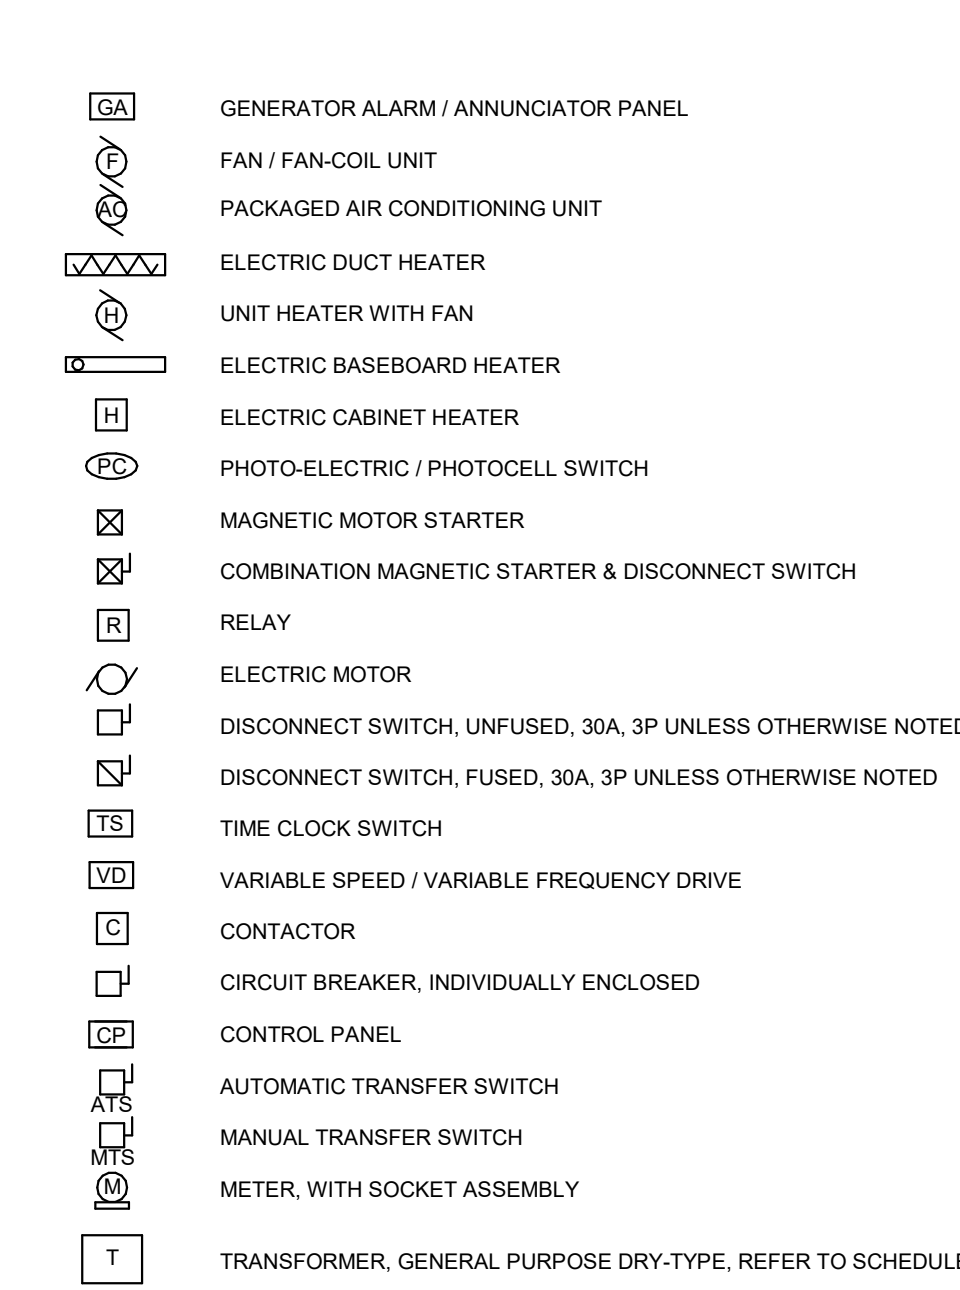


LIGHTING - EXTERIOR (SEE LUMINAIRE SCHEDULE)

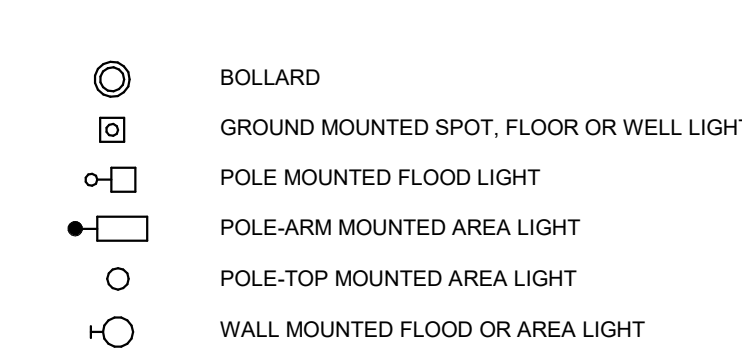


JUNCTION & OUTLET BOXES

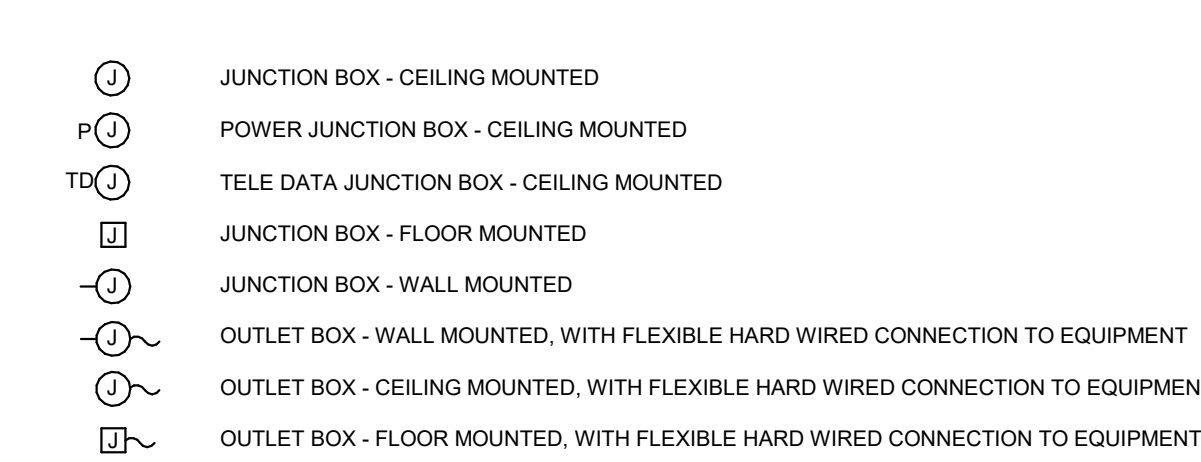

LIGHTING (SEE LUMINAIRE SCHEDULE)

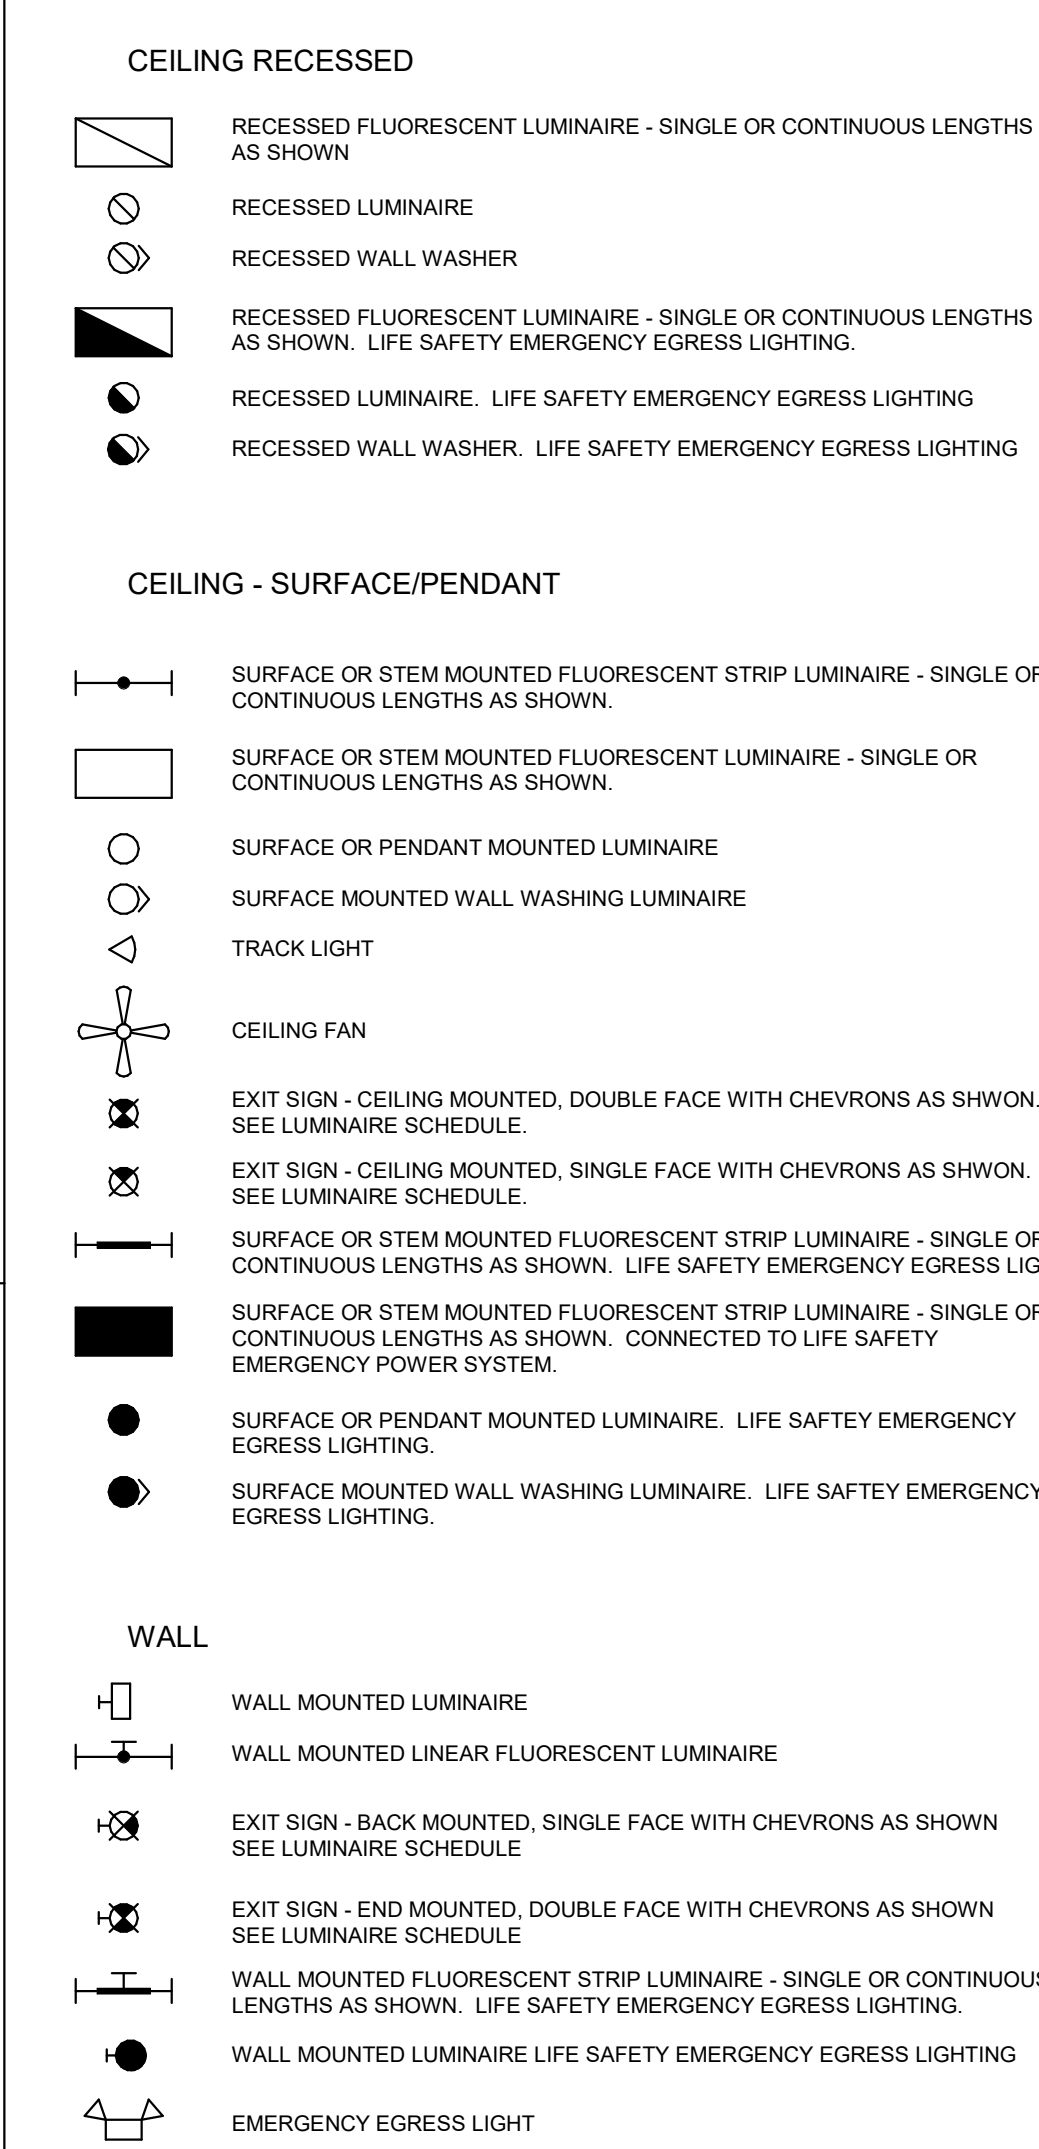


SWITCHES

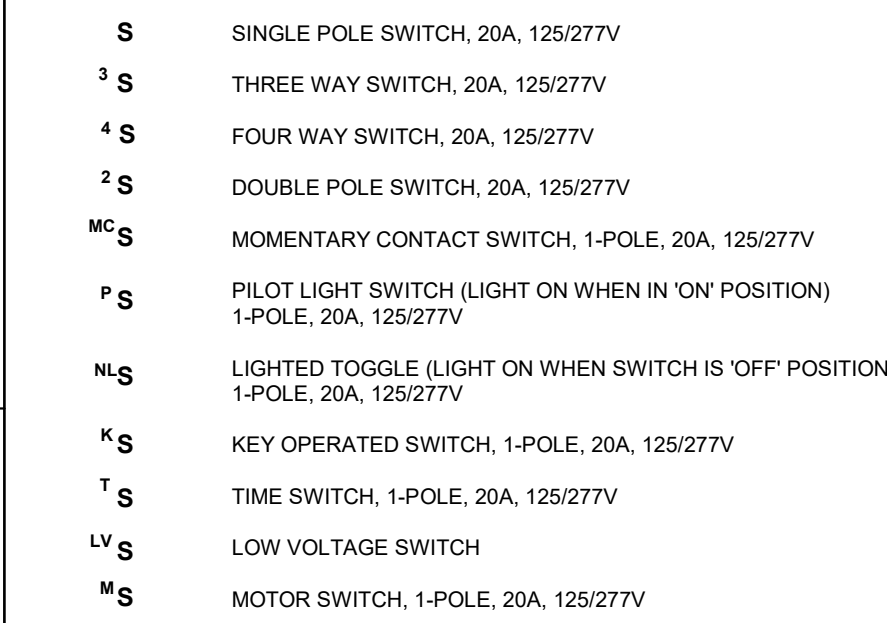


NOTES: SEE LIGHTING CONTROL LEGEND FOR ADDITIONAL CONTROLS


BRANCH CIRCUITS

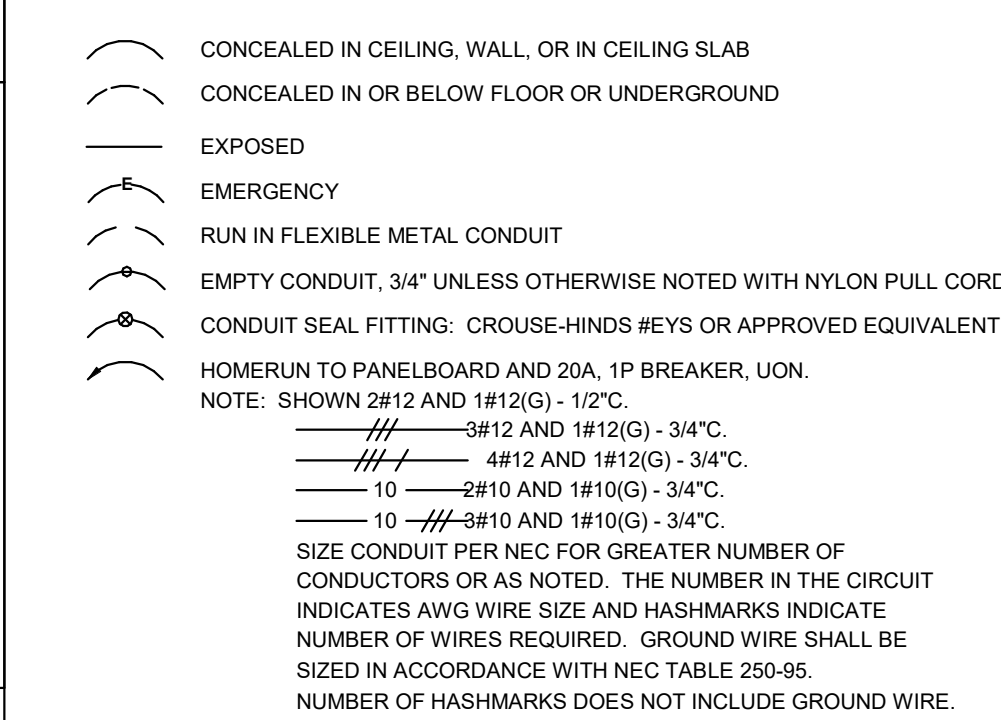

BRANCH CIRCUIT WIRING FOR LIGHTING IS SHOWN SCHEMATICALLY. EACH LUMINAIRE IS TO BE INSTALLED WITH AN ADDITIONAL FLEXIBLE CONNECTION. FOR EXAMPLE:

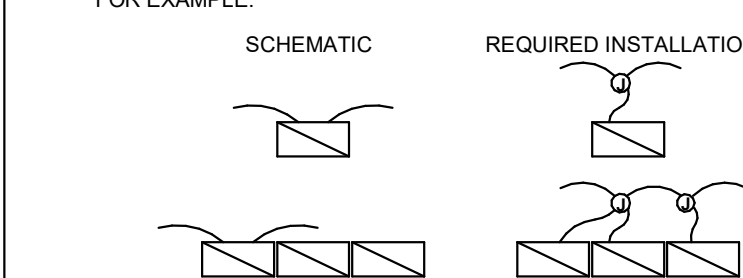

PANELBOARDS

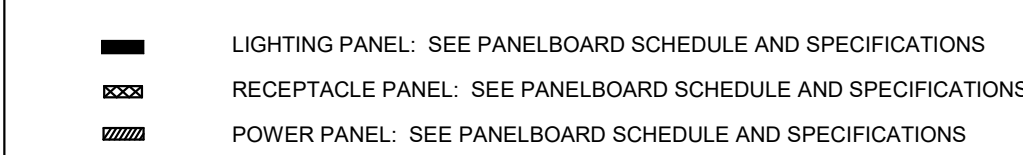

NEW CITY OF LINCOLN
POLICE DEPARTMENT
LINCOLN, ALABAMA



OWNER
City of Lincoln
150 Magnolia St.
Lincoln, AL 35096
205-753-7777
Attn: Lew Watson

ARCHITECT
Bill Whittaker, P.C.
Architecture
236 Martin Street
Anniston, AL 36206
Attn: Bill Whittaker

CIVIL ENGINEER
TTL
10 Inverness Center Pkwy
Suite 350
Hoover, AL 35242
256-441-2232
Attn: Tim Roberts

STRUCTURAL ENGINEER
Barnett, Jones, Wilson
125 18th St N
Pell City, AL 35242
205-894-5334
Attn: Jeremy Deal

MECHANICAL/PLUMBING/FIRE
PROTECTION ENGINEER
Whorton Engineering, Inc.
25 Summerhill Gate Road
Anniston, AL 36205
256-820-8987
Attn: Randy Whorton

ELECTRICAL ENGINEER
Hays Cheatwood Consulting
P.O. Box 250
Prank, AL 35126
205-842-0686
Attn: Tony Dodd


ISSUE:
03.31.25 BID
04.16.25 ADD #2


JOB NO.
24001

DESCRIPTION:
ELECTRICAL
LEGEND & NOTES

SHEET


E00.1

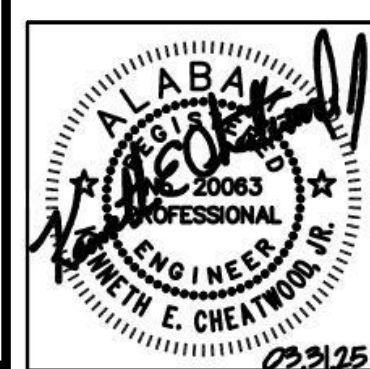

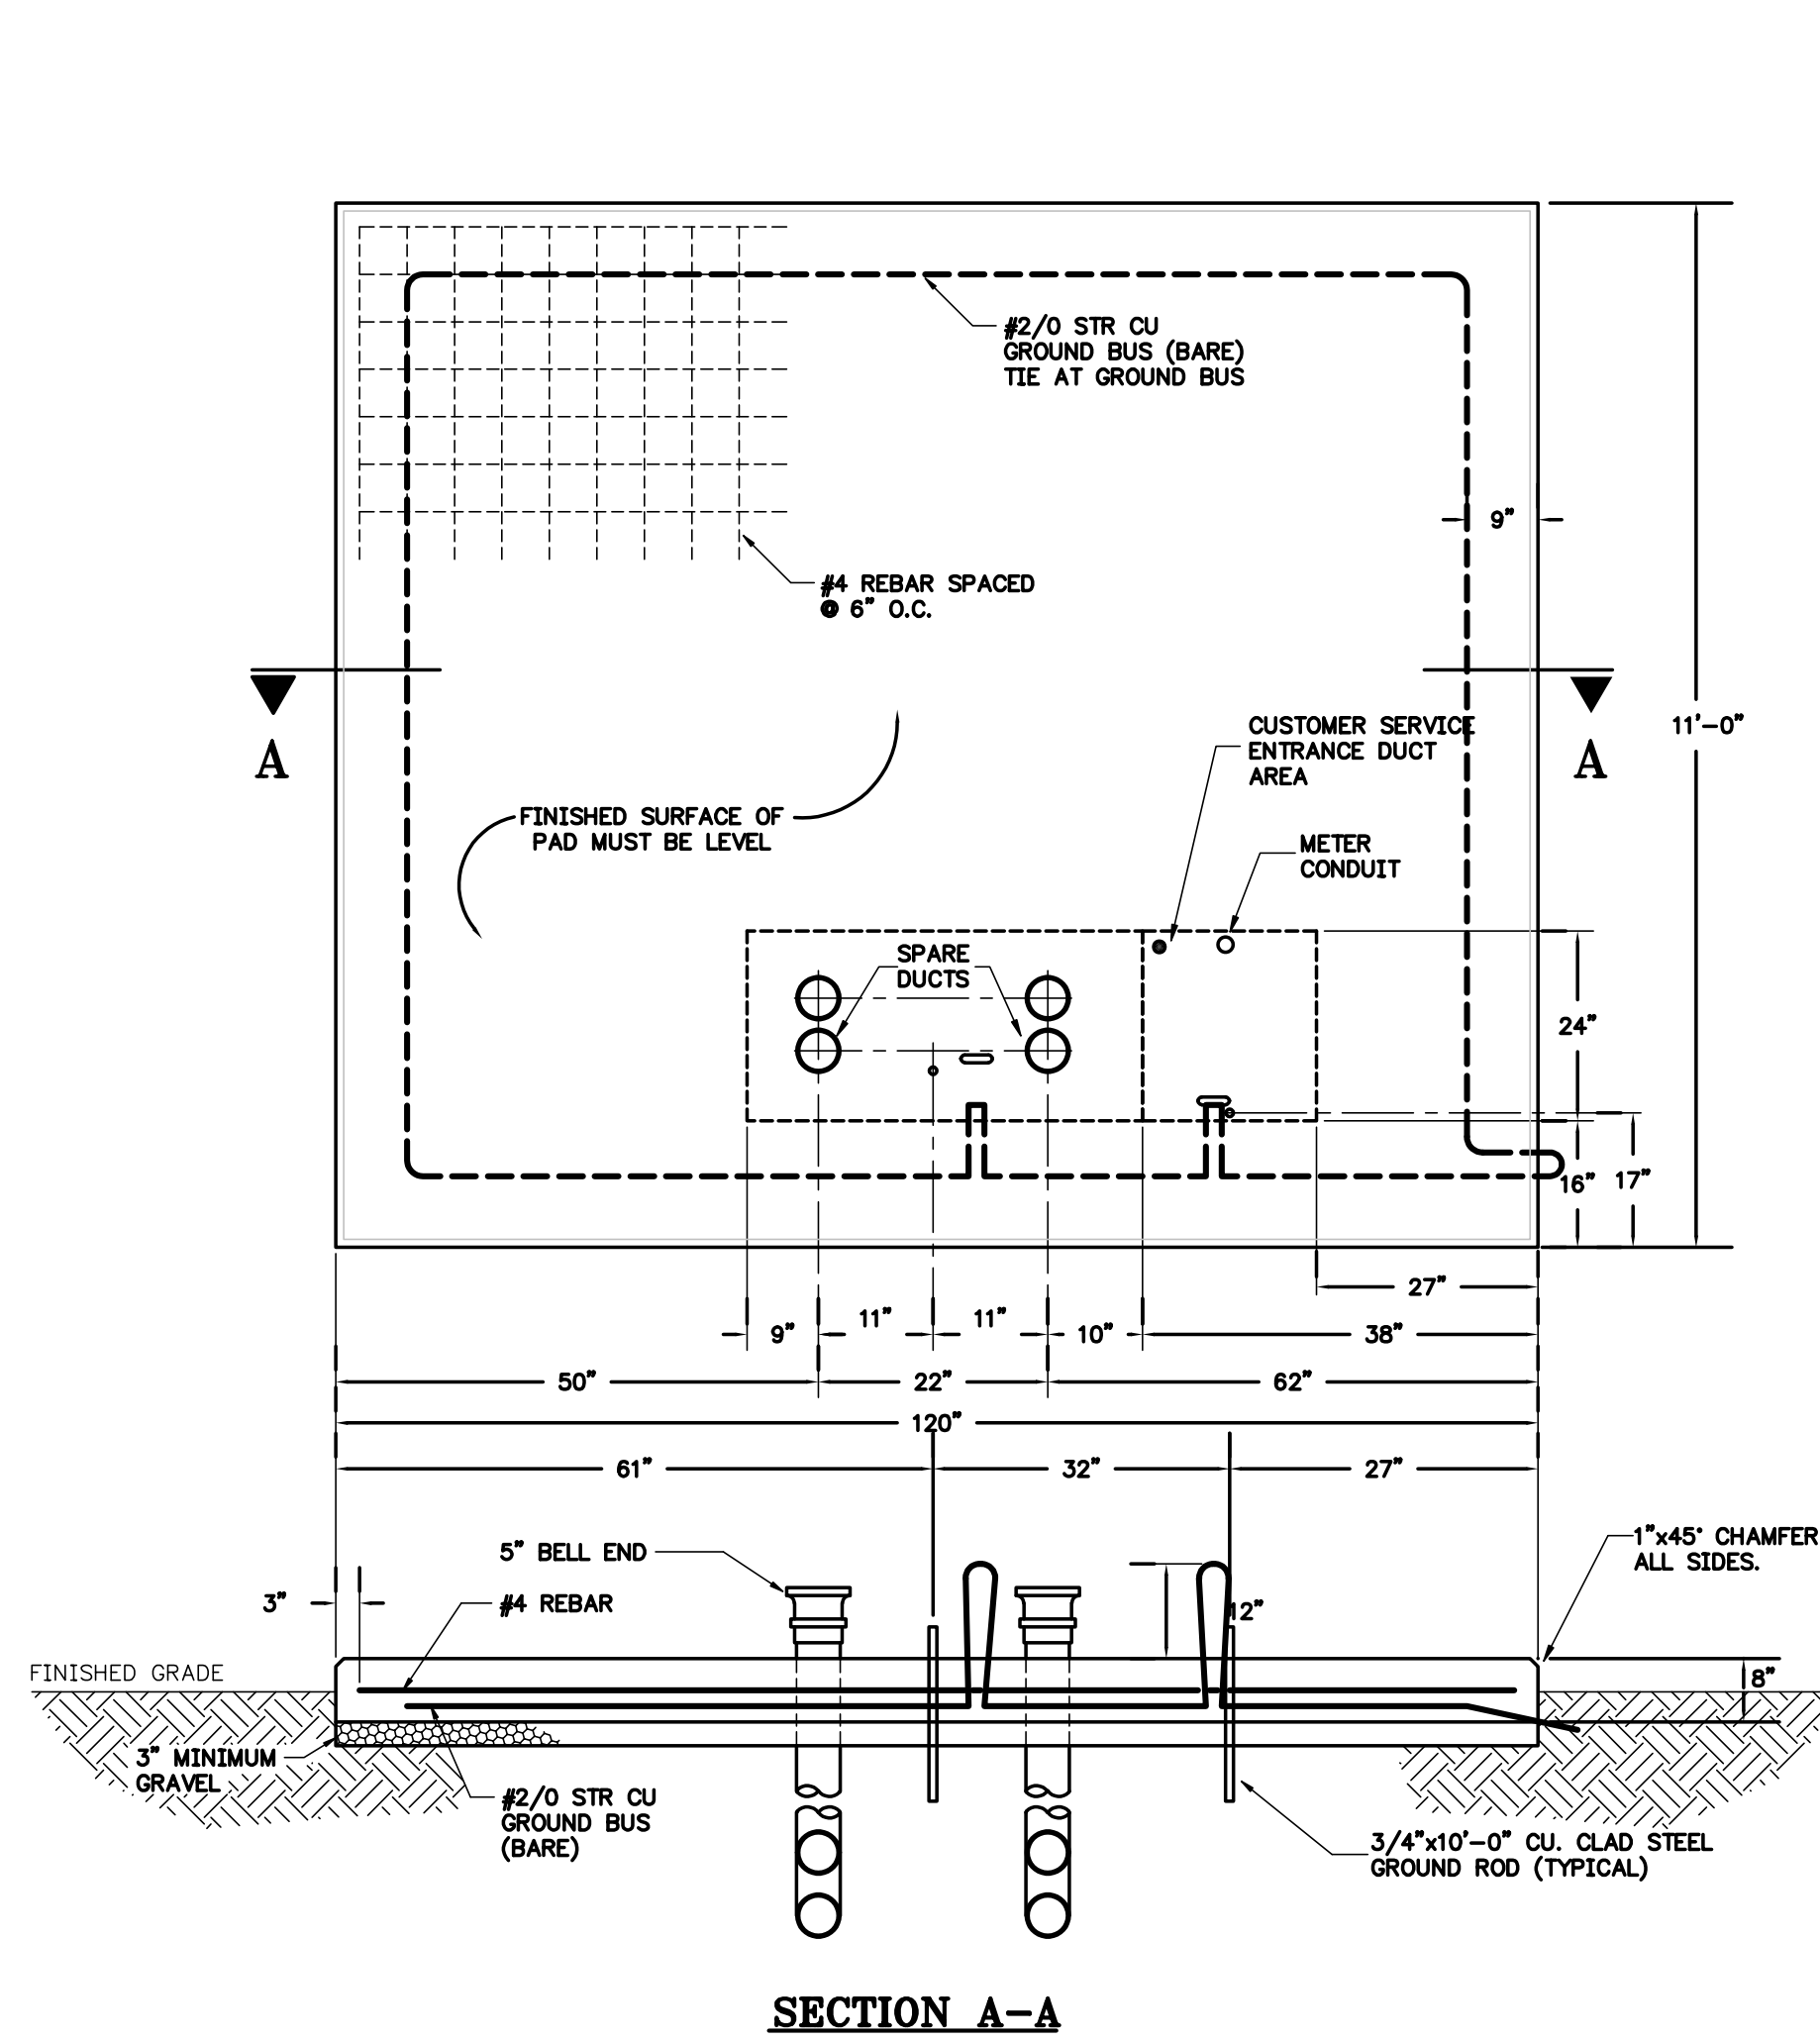


11 DETAIL
CONCRETE PAD FOR POWER CO. TRANSFORMER
NO SCALE

- NOTES:
- COORDINATE EXACT DIMENSIONS AND REQUIREMENTS WITH UTILITY.
 - PAD TO DEVELOP 3000PSI IN 28 DAYS.

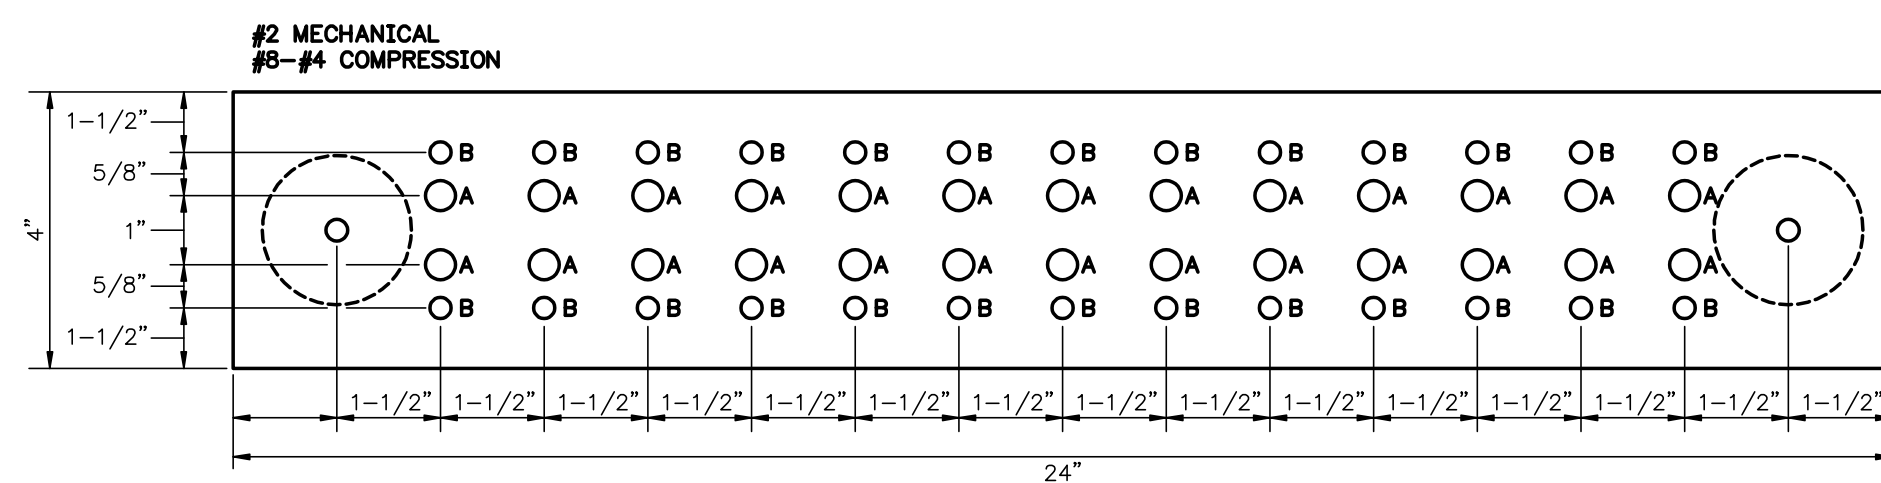


12 DETAIL
DRILLING OF MAIN GROUND POINT
NO SCALE

- NOTES:
- ALL GROUND BUSES TO HAVE SIMILAR BOLT-HOLE PATTERN; LENGTH VARIES.

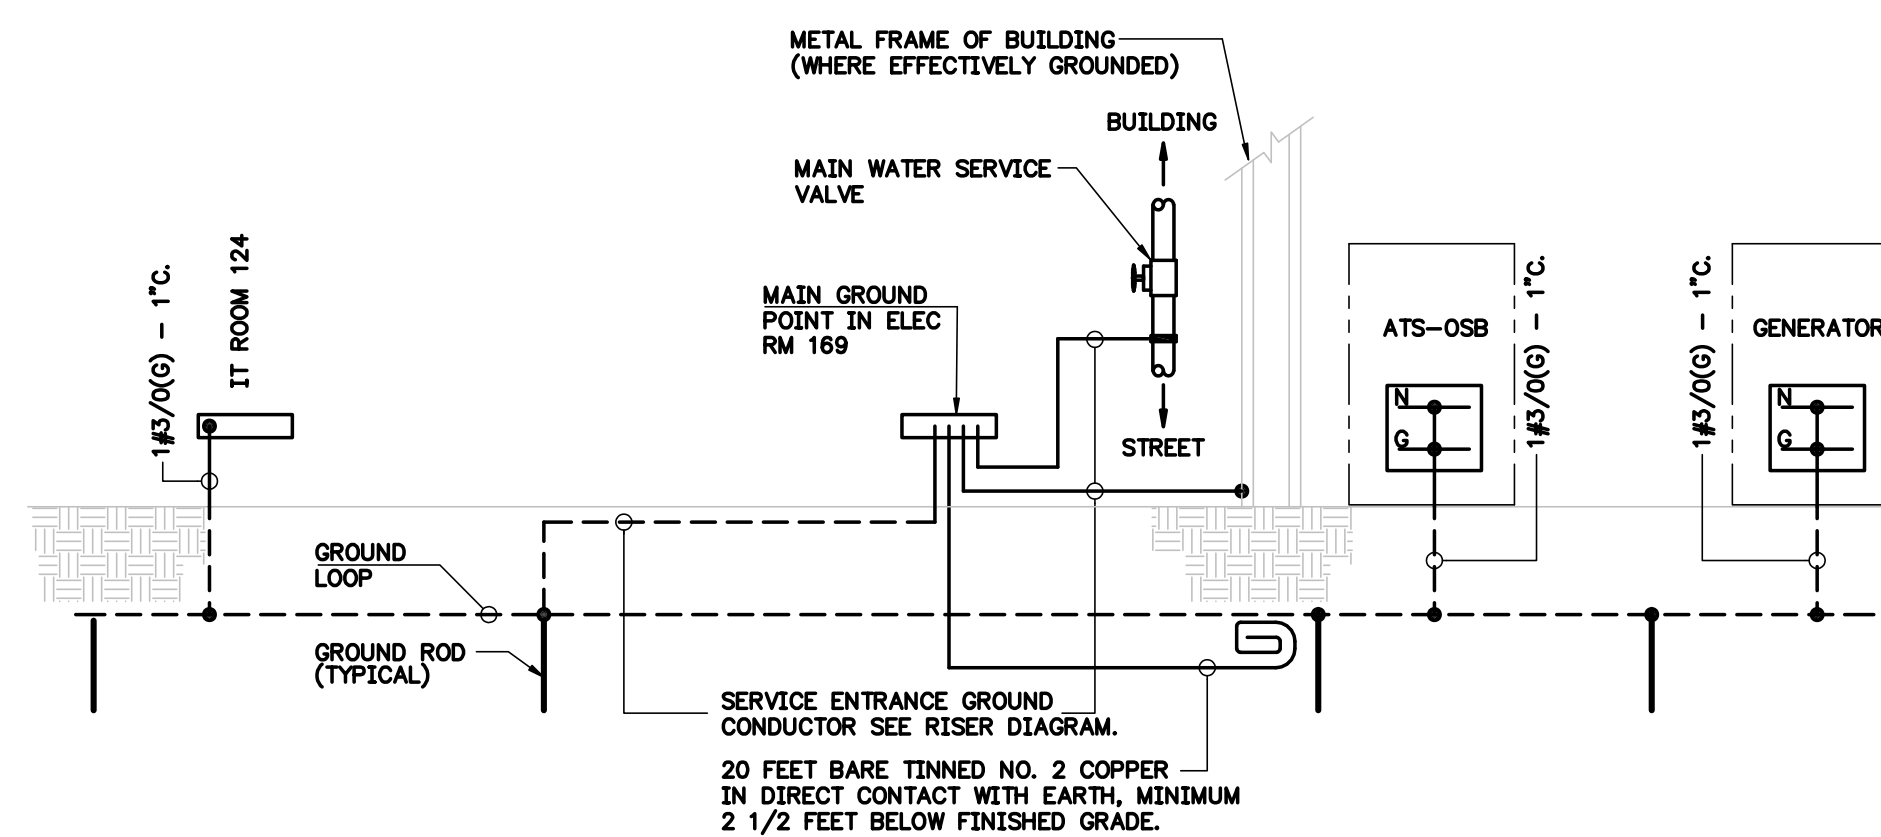


13 DETAIL
MAIN SERVICE GROUND
NO SCALE

- NOTES:
- ALL CONDUCTORS AWG #2/0 BARE TINNED COPPER, UON.

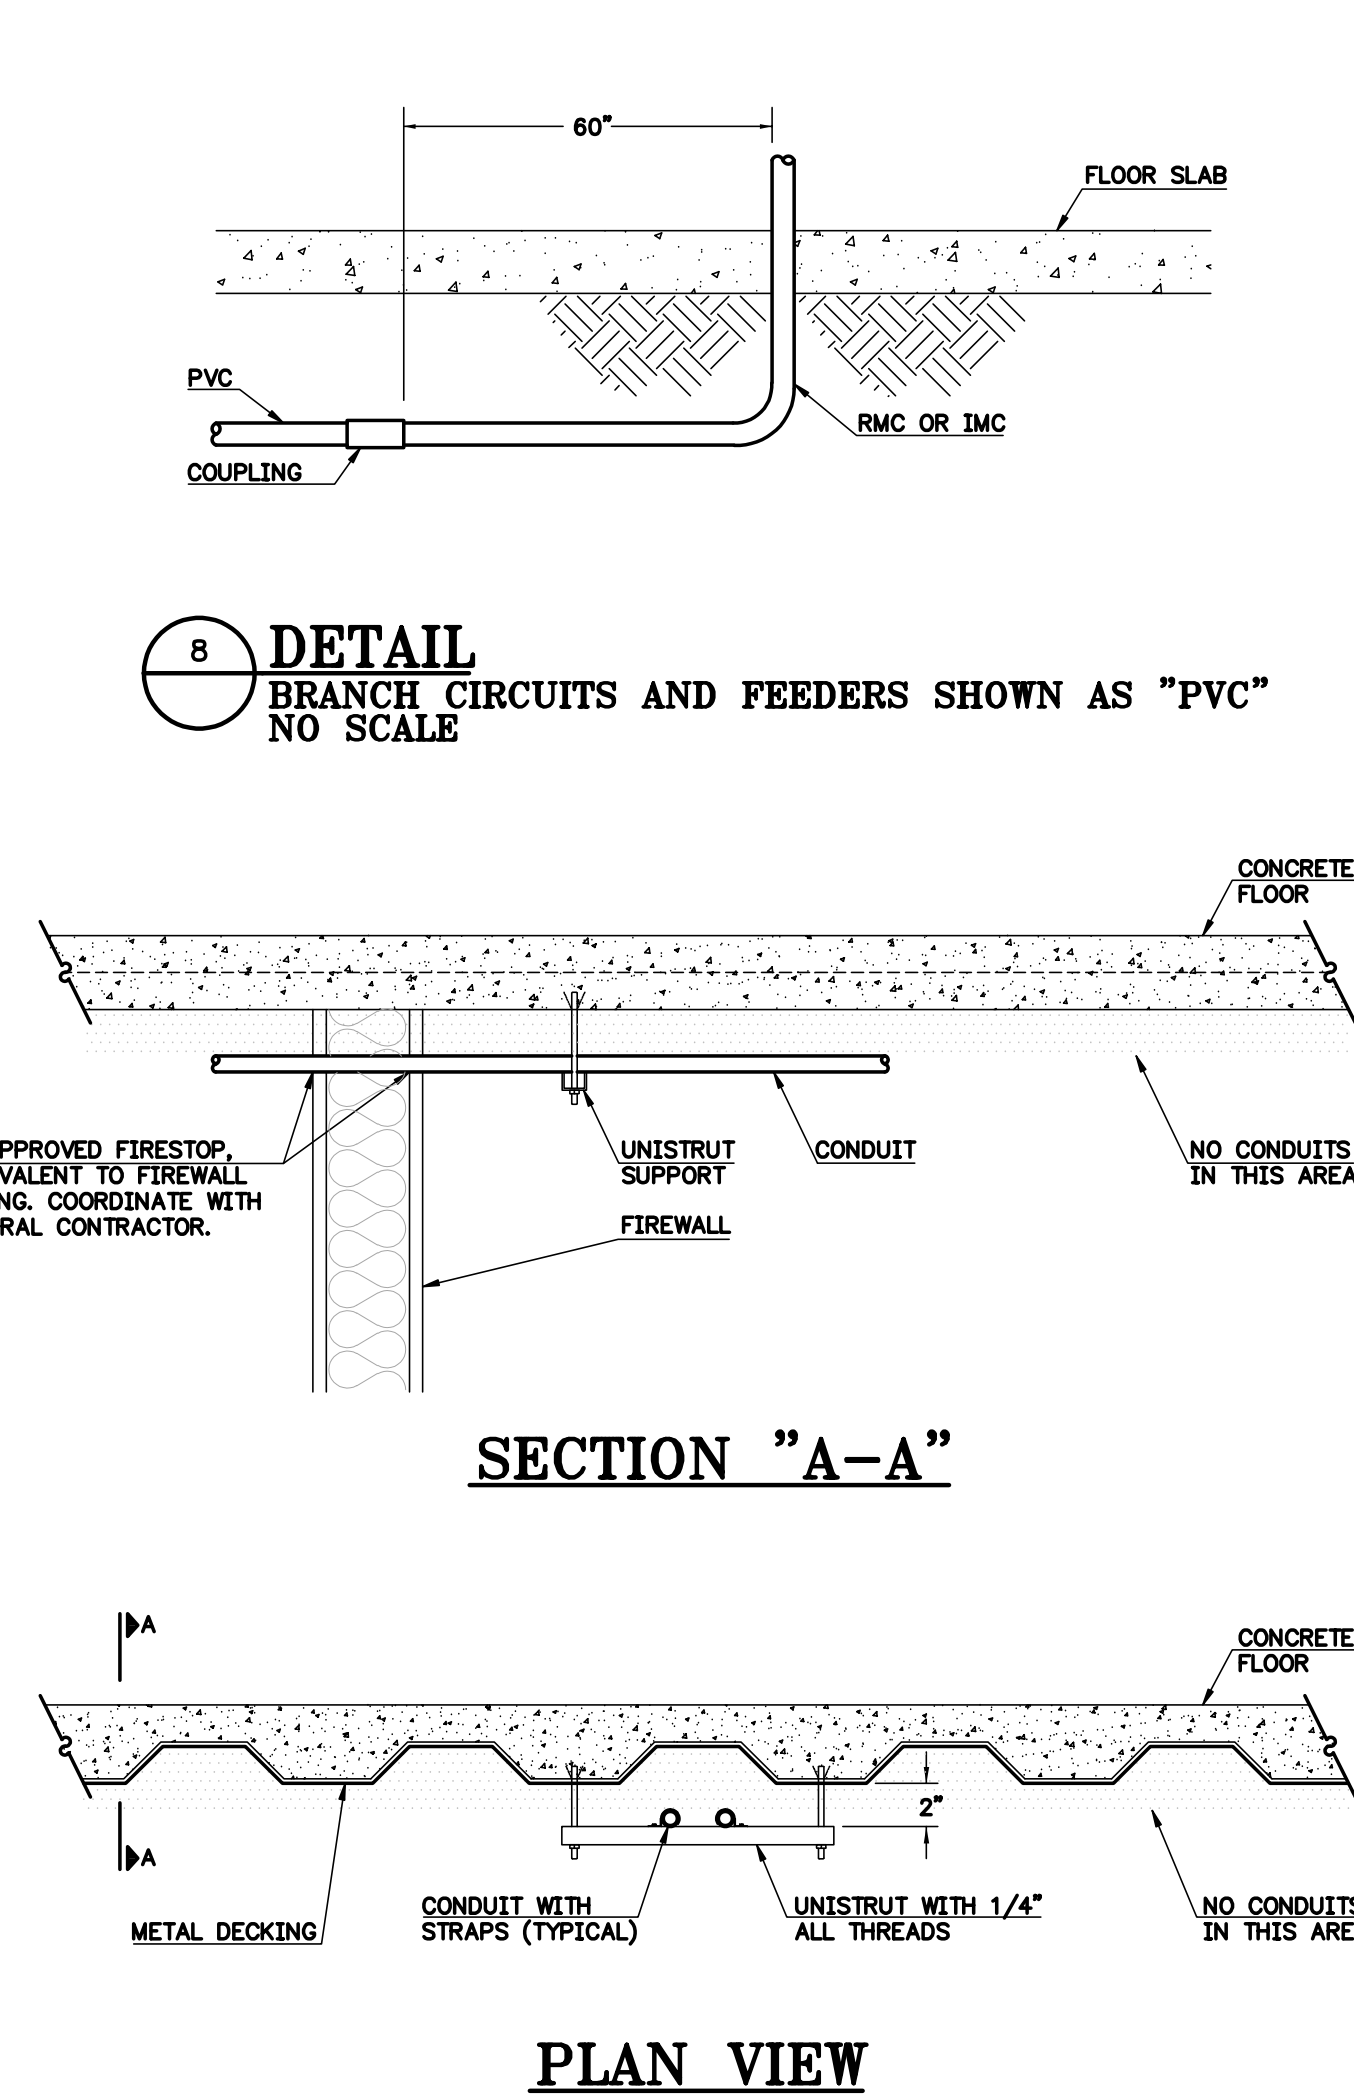

9 DETAIL
TYPICAL CONDUIT PENETRATION OF FIRE WALL
NO SCALE

- NOTES:
- DO NOT INSTALL CONDUIT TIGHT AGAINST DECKING AND MAINTAIN MINIMUM 2" CLEARANCE AT FIREWALL PENETRATION.

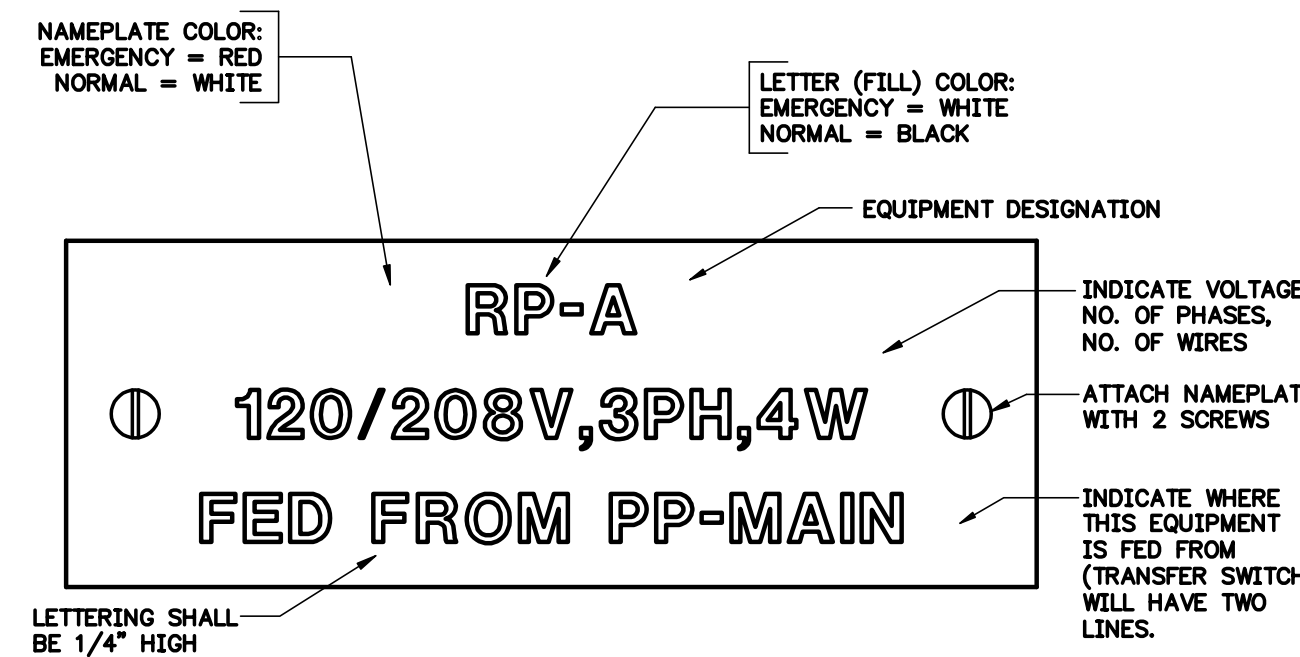


10 DETAIL
ELECTRICAL NAMEPLATE
NO SCALE


- NOTES:
- NAMEPLATE COLOR:
EMERGENCY = RED
NORMAL = WHITE

- NOTES:
- LETTER (FILL) COLOR:
EMERGENCY = WHITE
NORMAL = BLACK


- NOTES:
- LETTERING SHALL BE 1/4" HIGH

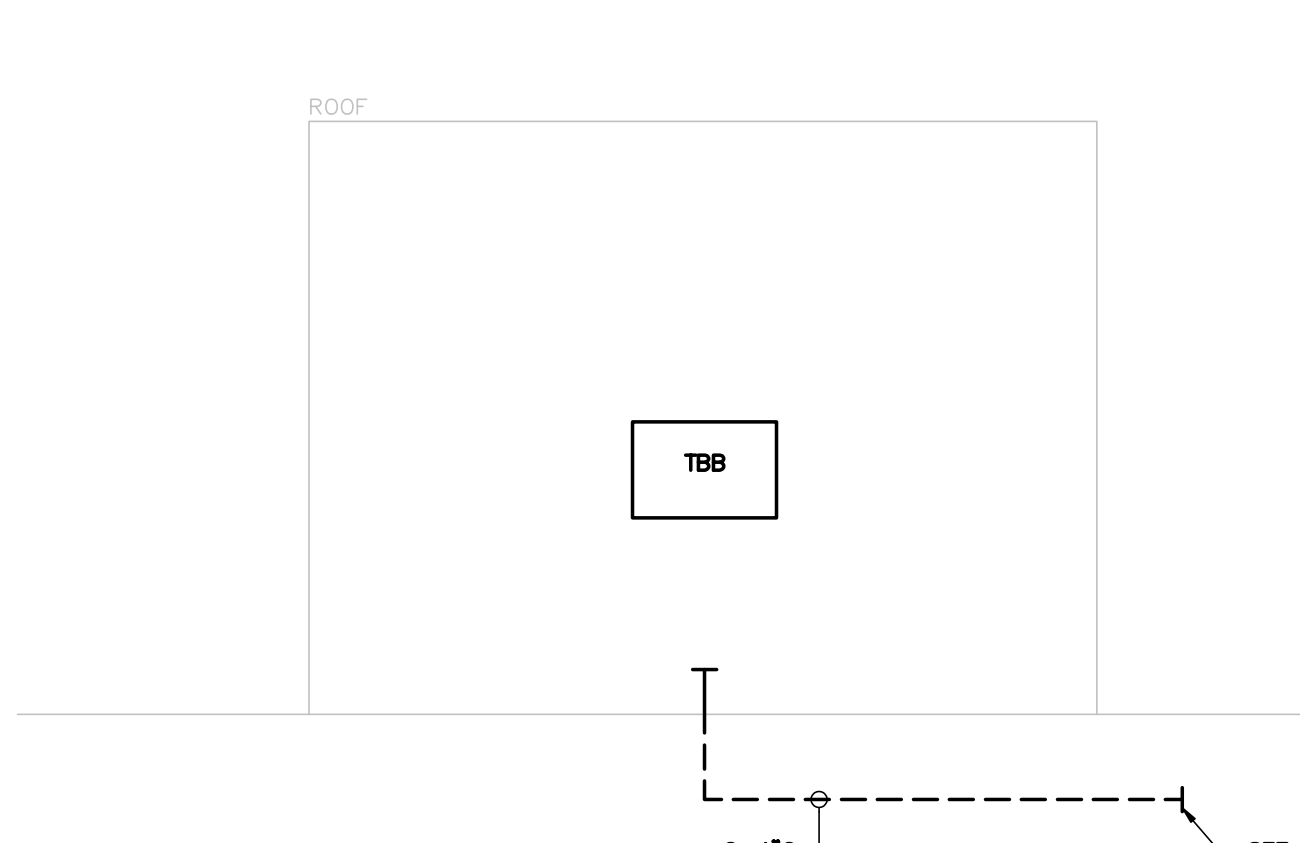


14 RISER DIAGRAM
TELECOM
NO SCALE

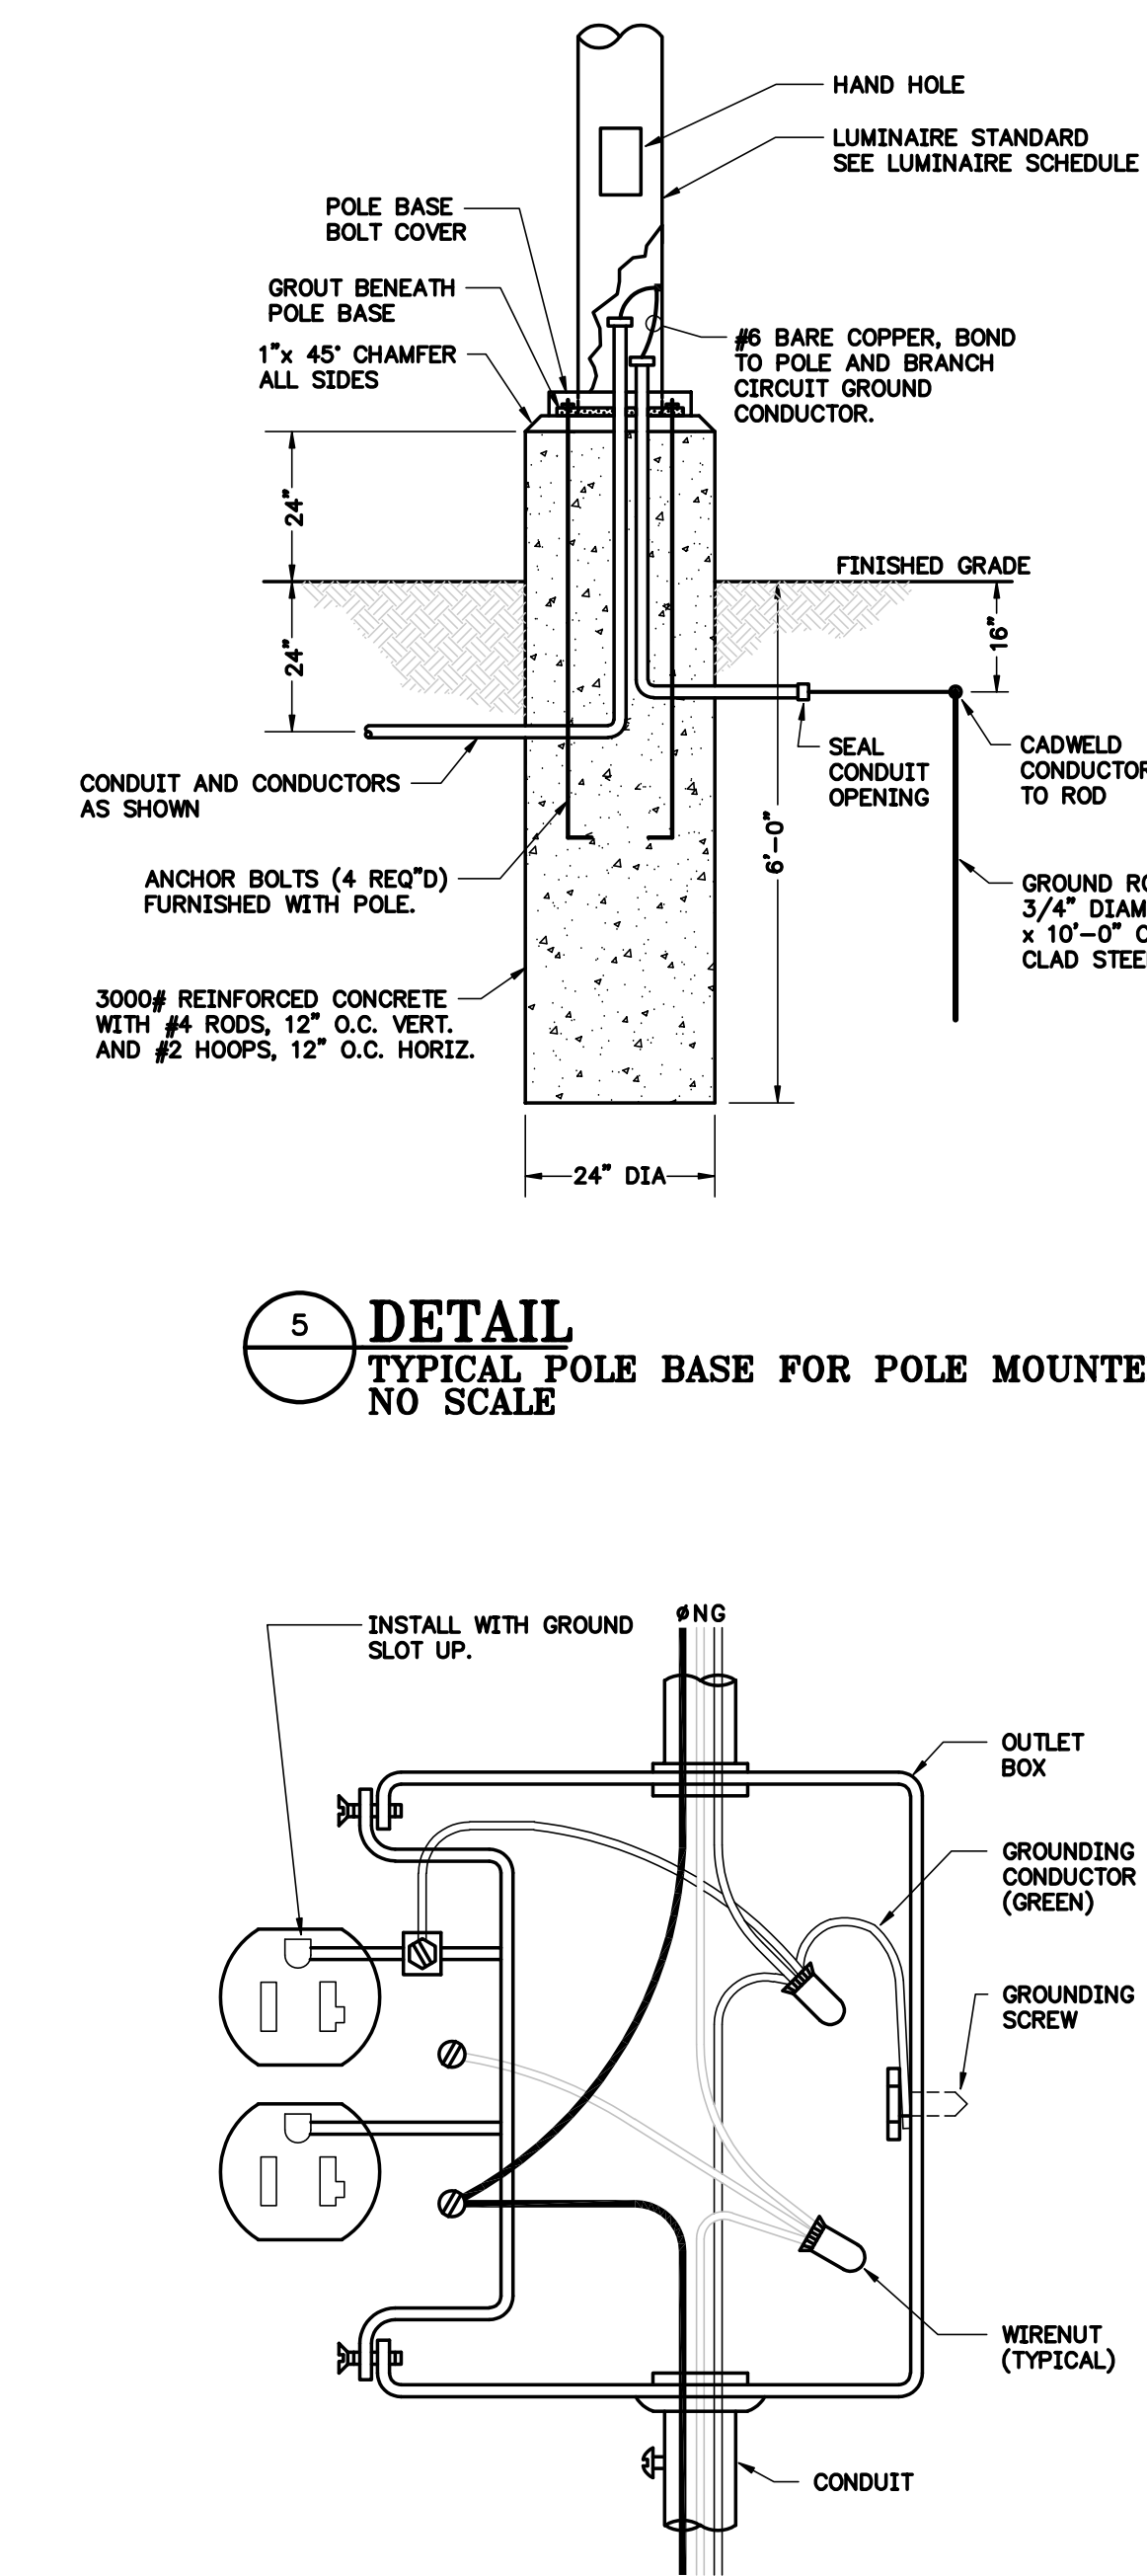

5 DETAIL
TYPICAL POLE BASE FOR POLE MOUNTED
NO SCALE

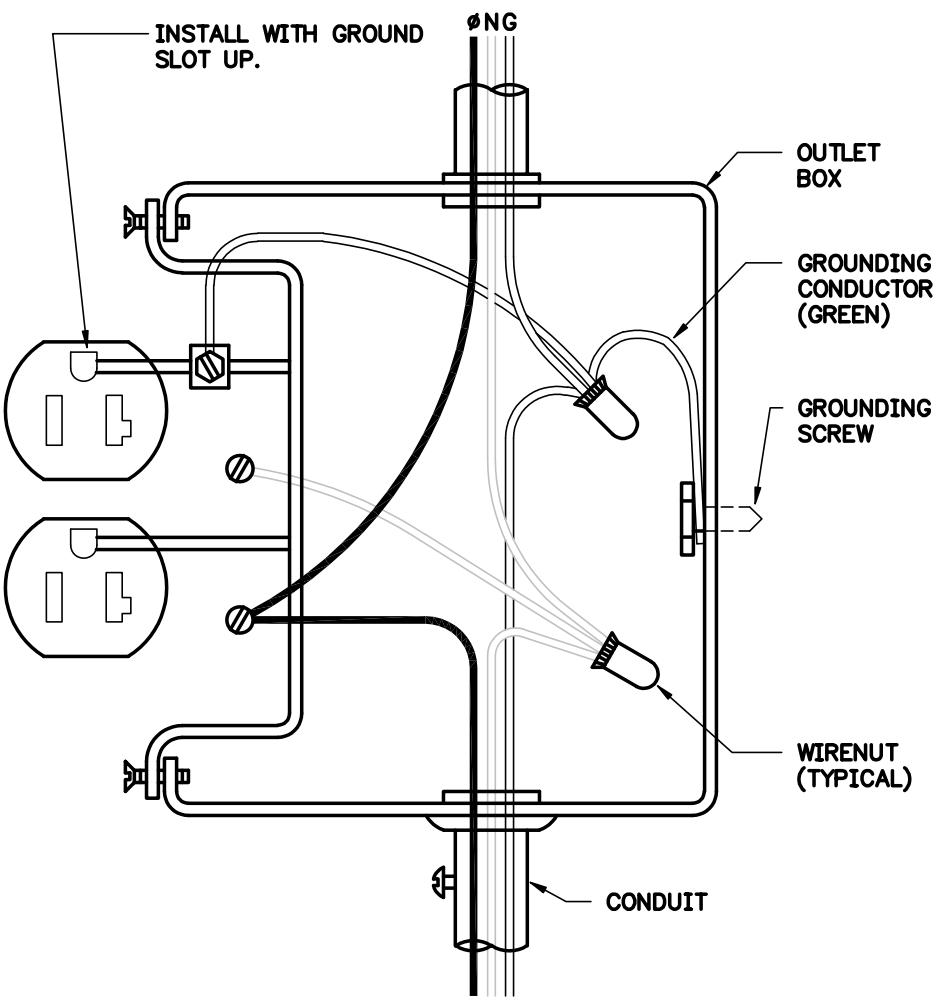


6 DETAIL
RECEPTACLE INSTALLATION
NO SCALE

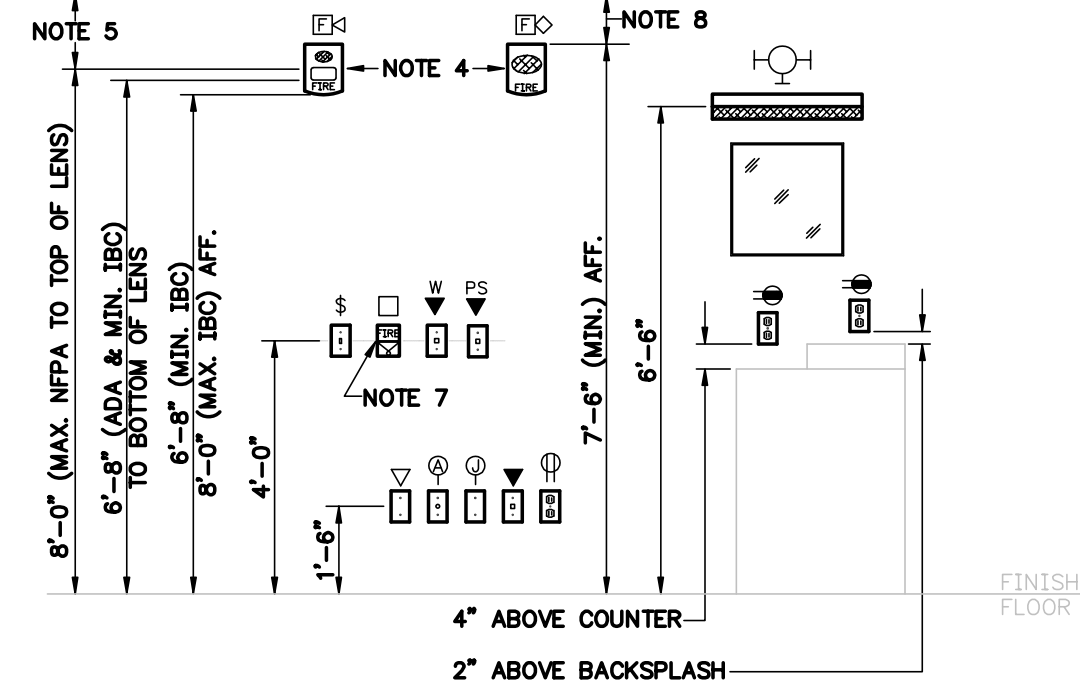

- NOTES:
- INDICATED MOUNTING HEIGHTS ARE FROM FINISHED FLOOR TO CENTERLINE OF OUTLET BOX, UNLESS OTHERWISE NOTED.
 - REFER TO ARCHITECTURAL DETAILS FOR ADDITIONAL REQUIREMENTS.
 - INSTALL OUTLETS THAT ARE IN CLOSE PROXIMITY ON THE SAME CENTERLINE.
 - VERIFY MOUNTING HEIGHT WITH LOCAL AUTHORITY.
 - FOR CEILING HEIGHTS LESS THAN 86", VISUAL LENS MOUNTING HEIGHT SHALL BE WITHIN 6" OF CEILING.
 - IN SLEEPING ROOMS: 110cd STROBES, 2'-0" MIN. FROM CEILING TO TOP OF LENS FOR WITHIN 16'-0" OF PILLOW. 177cd STROBES CAN BE WITHIN THE 2'-0" MIN. FROM CEILING. THE HIGHER INTENSITY IS TO COMPENSATE FOR A POSSIBLE SMOKE LAYER.
 - 48" TO TOP OF PULL HANDLE.
 - 6" MIN. (NFPA 72) BELOW FINISHED CEILING.


7 DETAIL
MOUNTING HEIGHTS
NO SCALE

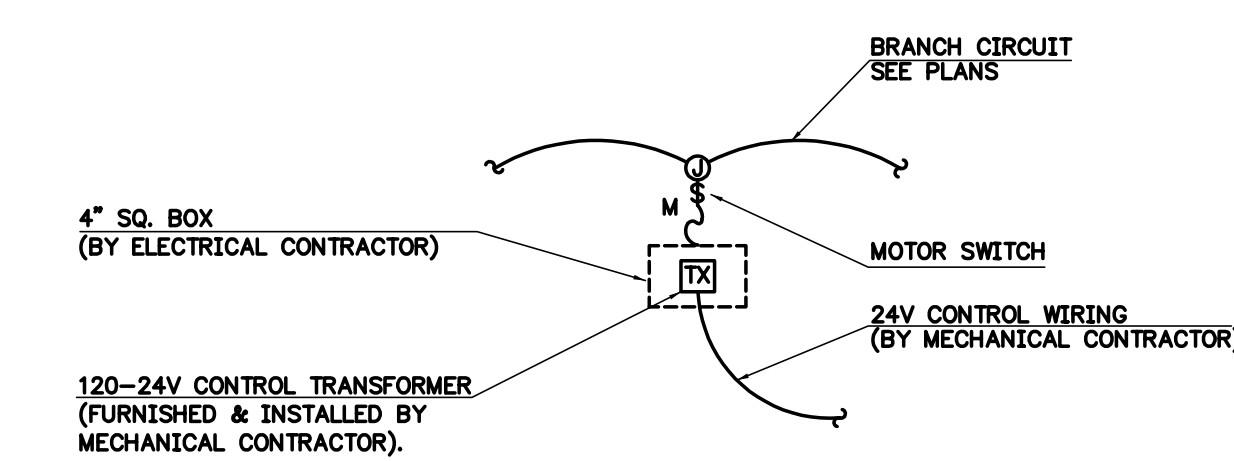


1 WIRING DIAGRAM
TYPICAL (SEE LIST)
NO SCALE

- NOTES:
- ELECTRICAL CONTRACTOR SHALL COORDINATE LOCATION OF EACH DEVICE WITH THE MECHANICAL CONTRACTOR PRIOR TO BID AND INCLUDE 120V. POWER AT EACH.
 - MOTOR SWITCH SHALL BE WEATHER PROOF WHERE APPLICABLE.


- BOU
- AHU CONTROLLER
- EXHAUST FAN CONTROLLER
- TYPICAL ROOM DIFFERENTIAL
- PRESSURE MONITOR
- TYPICAL HEATING COIL CONTROLLER
- TYPICAL BLOWER COIL UNIT CONTROLLER
- TYPICAL FAN COIL UNIT CONTROLLER
- TYPICAL COMBINATION FIRE AND SMOKE DAMPERS
- MISCELLANEOUS ACTUATORS

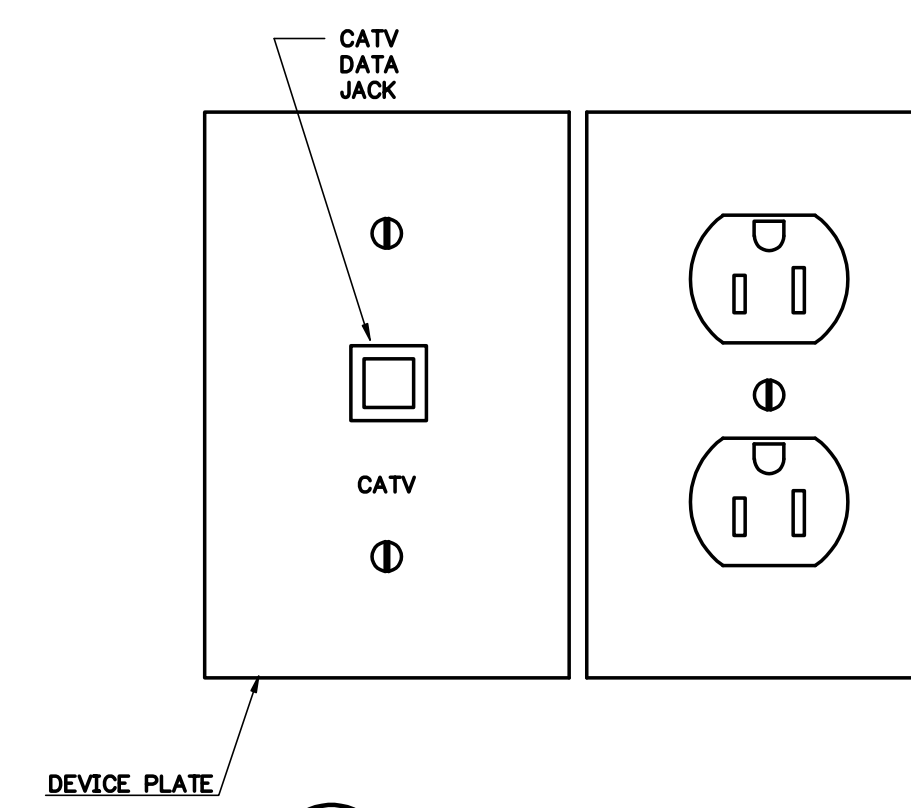

2 DETAIL
TV RECEPTACLE (V)
NO SCALE

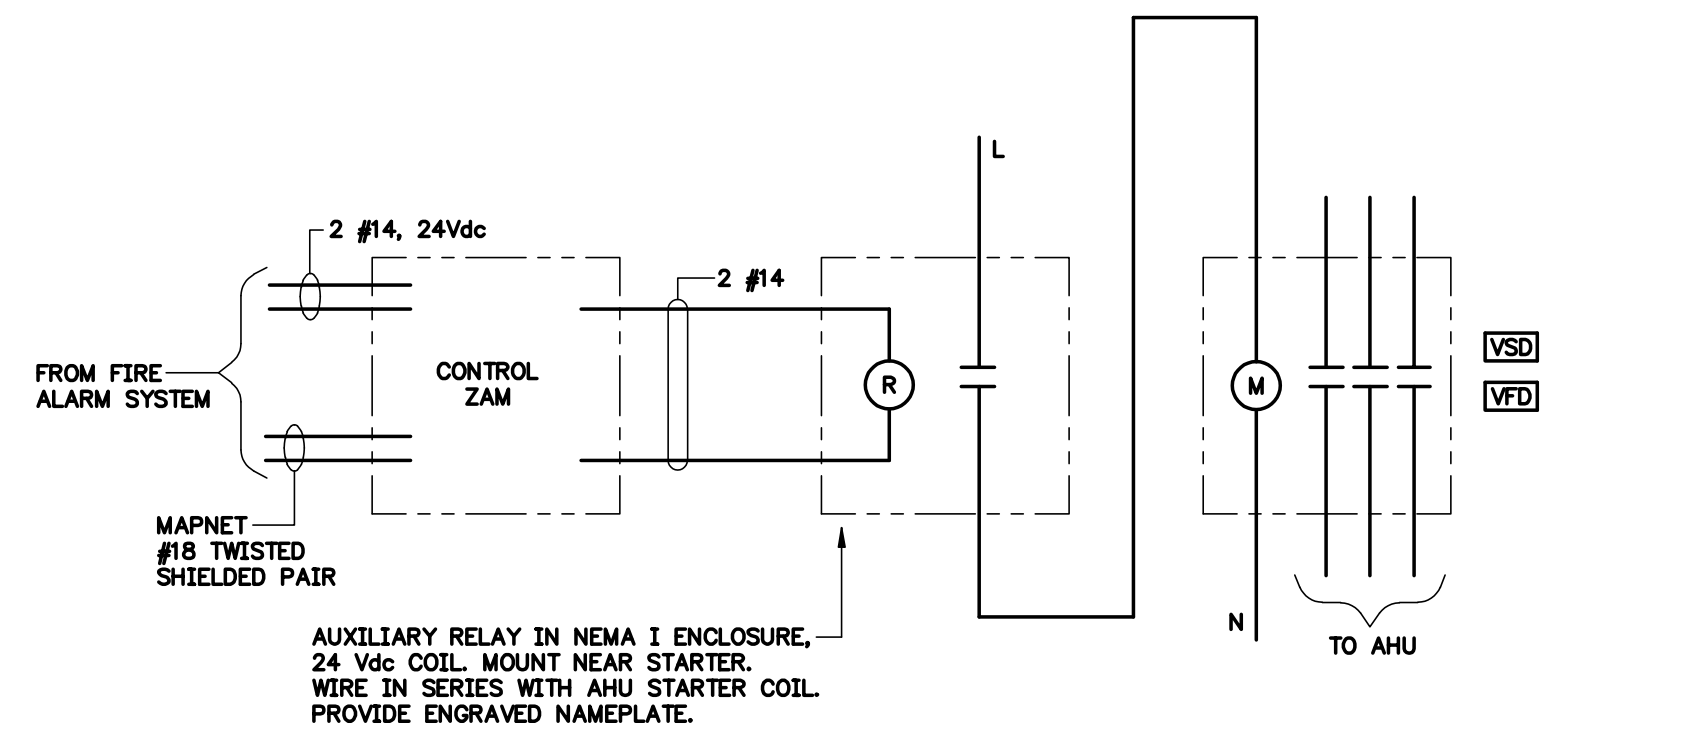

3 WIRING DIAGRAM
FIRE ALARM SHUTDOWN OF AHU
NO SCALE

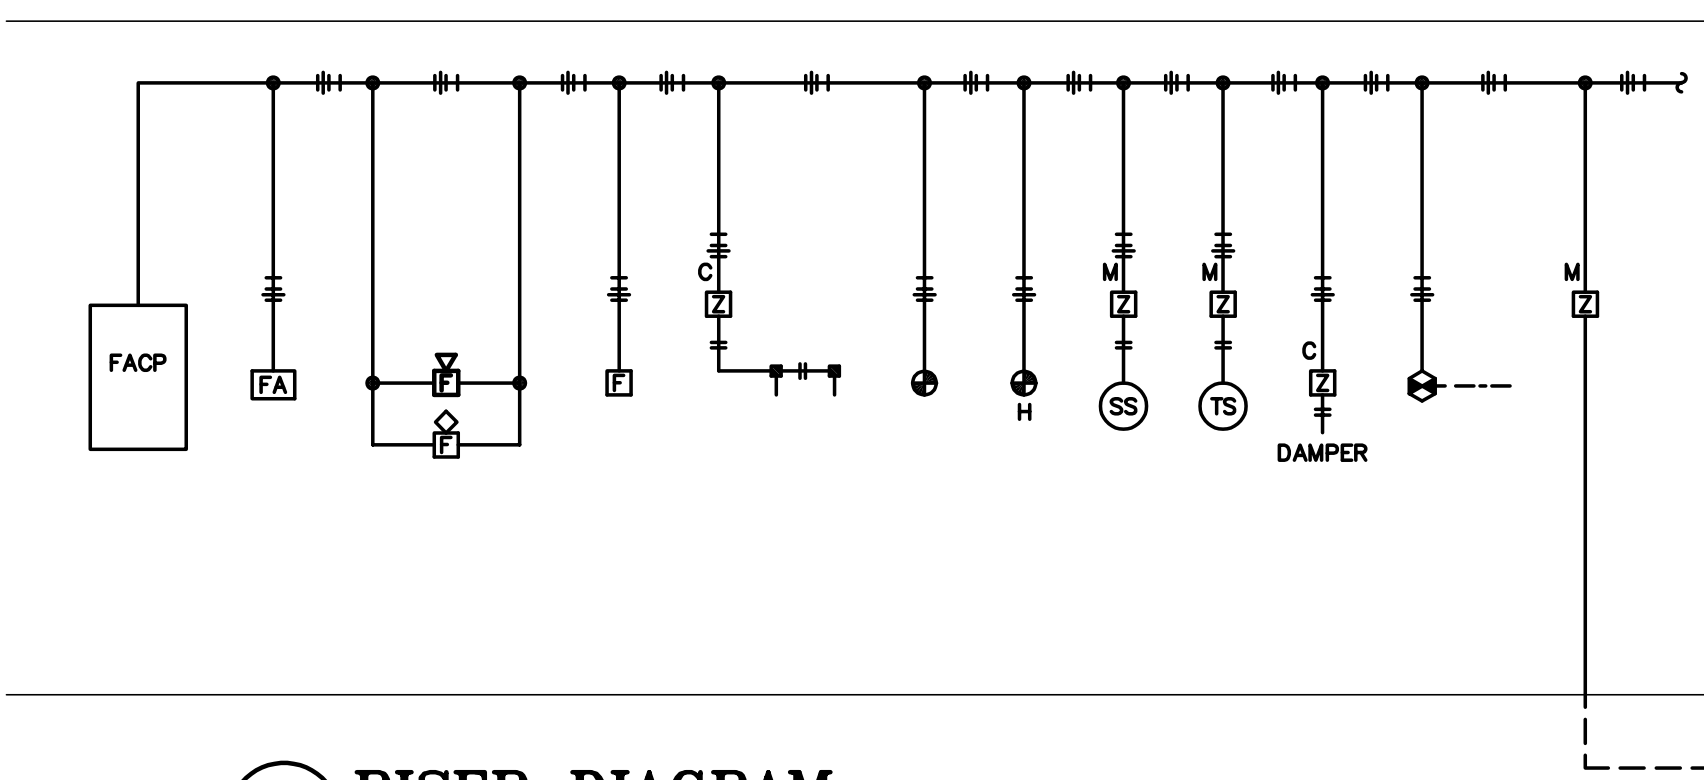


4 RISER DIAGRAM
FIRE ALARM SYSTEM
NO SCALE

- NOTES:
- ALL FIRE ALARM DETECTION AND ALARM DEVICES ARE NOT SHOWN ON THIS RISER DIAGRAM. REFER TO THE FLOOR PLAN FOR QUANTITIES AND LOCATIONS OF THESE DEVICES. THE RISER DIAGRAM ILLUSTRATES THE GENERAL LAYOUT AND TYPICAL CONNECTIONS.
 - NO CONDUIT RUN SHALL EXCEED 100 FEET WITHOUT PULL BOX.
 - REFER TO SPECIFICATIONS FOR ADDITIONAL REQUIREMENTS.
 - ALL FIRE ALARM CONDUIT SHALL BE RED.
 - COORDINATE PIU LOCATION WITH CIVIL PLANS.

LIGHTING CONTROLS SYSTEM

INT	ROOM CONTROLLER, EVO DISTRIBUTED CONTROL PANEL WITH INTEGRATED DIMMING RELAYS, REFER TO DRAWINGS FOR NUMBER OF RELAYS NEEDED, PROVIDE COMPATIBLE WALL STATIONS AND SENSORS AS SHOWN. ILC NO. LLEVO-INT-X OR A PRIOR APPROVED EQUIVALENT, SEE NOTE 7
TC	ROOM CONTROLLER, EVO DISTRIBUTED CONTROL PANEL WITH INTEGRATED TIME CLOCK, PROVIDE COMPATIBLE WALL STATIONS AND SENSORS AS SHOWN. ILC NO. LLEVO-TC OR A PRIOR APPROVED EQUIVALENT, SEE NOTE 7
SM	CEILING MOUNTED DUAL TECHNOLOGY SENSOR, SMALL MOTION, 360°, LOW VOLTAGE SENSORWORK NO. SWX-221-1 OR A PRIOR APPROVED EQUIVALENT, SEE NOTE 7
LM	CEILING MOUNTED DUAL TECHNOLOGY SENSOR, LARGE MOTION, 360°, LOW VOLTAGE SENSORWORK NO. SWX-222-1 OR A PRIOR APPROVED EQUIVALENT, SEE NOTE 7
L1	WALL MOUNTED ONE BUTTON DIGITAL SWITCH FOR USE WITH ROOM CONTROLLER (INT2/TC) COLORS TO BE SELECTED BY ARCHITECT. ILC NO. LS63-XX-1-MZD OR A PRIOR APPROVED EQUIVALENT, SEE NOTE 7
L1D	WALL MOUNTED SINGLE BUTTON DIGITAL SWITCH FOR USE WITH ROOM CONTROLLER (INT2/TC) 0-10V DIMMING FOR SINGLE ZONE. COLORS TO BE SELECTED BY ARCHITECT. ILC NO. LS63-XX-1-MZD OR A PRIOR APPROVED EQUIVALENT, SEE NOTE 7
L2D	WALL MOUNTED TWO BUTTON DIGITAL SWITCH FOR USE WITH ROOM CONTROLLER (INT2/TC) 0-10V DIMMING FOR TWO ZONES. COLORS TO BE SELECTED BY ARCHITECT. ILC NO. LS63-XX-2-MZD OR A PRIOR APPROVED EQUIVALENT, SEE NOTE 7
L4D	WALL MOUNTED FOUR BUTTON DIGITAL SWITCH FOR USE WITH ROOM CONTROLLER (INT2/TC) 0-10V DIMMING FOR FOUR ZONES. COLORS TO BE SELECTED BY ARCHITECT. ILC NO. LS63-XX-4-MZD OR A PRIOR APPROVED EQUIVALENT, SEE NOTE 7
DW	WALL MOUNTED DUAL TECHNOLOGY, SINGLE RELAY, AUTO ON COLORS TO BE SELECTED BY ARCHITECT. SENSORWORK NO. SWX-121-XX OR A PRIOR APPROVED EQUIVALENT, SEE NOTE 7
DWD	WALL MOUNTED PASSIVE INFRARED TECHNOLOGY, 0-10V DIMMING, SINGLE RELAY SENSORWORK NO. SWX-123-D-XX OR A PRIOR APPROVED EQUIVALENT, SEE NOTE 7
RS	REMOTE RELAY, LED LOADS TO 20A, RECEPTACLE LOADS UP TO 20A. ILC NO. R20 OR A PRIOR APPROVED EQUIVALENT, SEE NOTE 7
RSB	REMOTE DIMMING RELAY WITH 0-10V, LED LOADS TO 20A ILC NO. R20D OR A PRIOR APPROVED EQUIVALENT, SEE NOTE 7

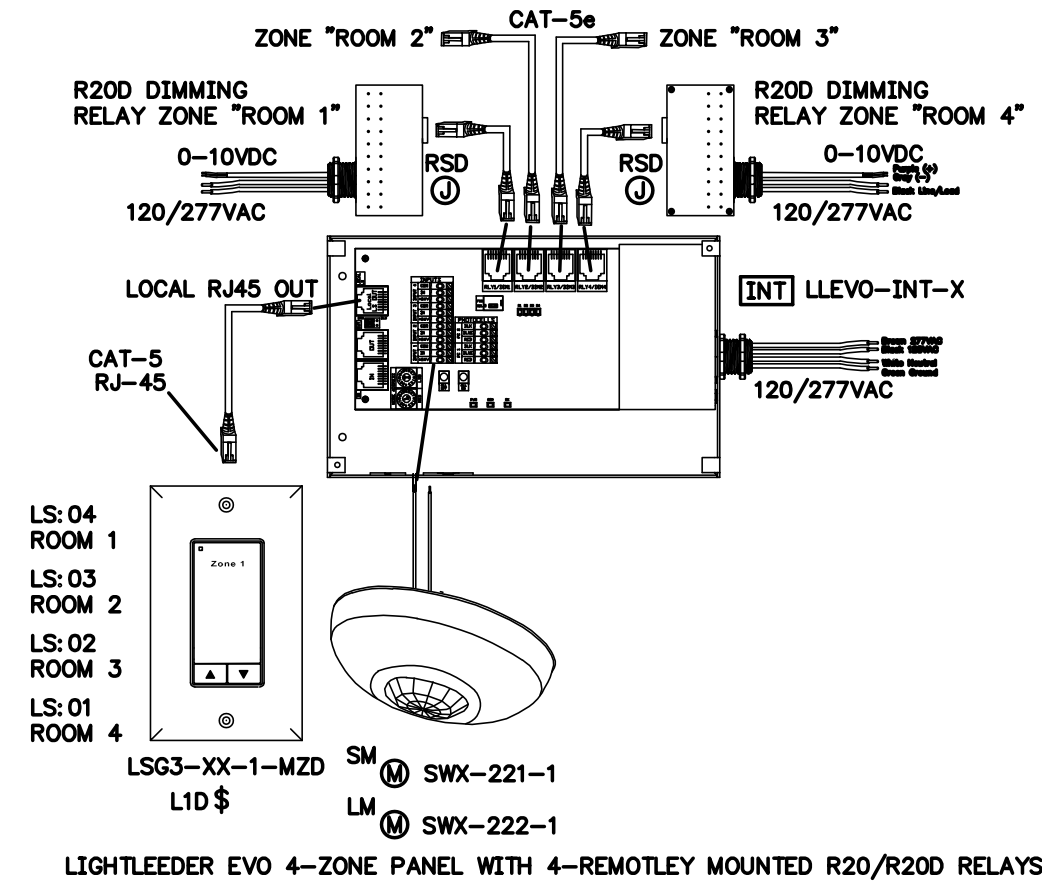


5 WIRING DIAGRAM TYPICAL ROOM CONTROLLER WITH MULTIPLE ROOMS NO SCALE

NOTES:


- CONTRACTOR SHALL LOCATE ALL ROOM CONTROLLERS ABOVE DOORS IN EACH ROOM 6" ABOVE CEILING GRID. PROVIDE ACCESS PANELS WHERE LOCATED ABOVE HARD CEILINGS OR MOUNT IN UTILITY TYPE ROOMS WHENEVER POSSIBLE. ROOM CONTROLLERS SHOWN ON THESE PLANS ARE DIAGRAMMATIC FOR CIRCUITRY. DO NOT USE THESE FOR ACTUAL LOCATIONS. PROVIDE A WHITE PHENOLIC LABEL 1" BLACK TEXT THAT READS "INT" GLUED ON CEILING GRID UNDER ROOM CONTROLLER FOR EACH LOCATION FOR MAINTENANCE.

LIGHTING CONTROL NOTES


- ALL SENSOR LOCATIONS ARE APPROXIMATE. REFER TO MANUFACTURER'S INSTALLATION INSTRUCTIONS PRIOR TO INSTALLATION.
- CEILING MOUNTED SENSORS SHOULD BE LOCATED A MINIMUM OF SIX (6) FEET FROM HVAC SUPPLY/RETURN VENTS.
- FIELD VERIFY PROPER SENSITIVITY AND TIME DELAY SETTINGS FOR NON-ADAPTIVE PRODUCTS, FOLLOWING THE MANUFACTURER'S RECOMMENDED PLACEMENT, AND FIELD VERIFICATION OF CIRCUITS WITH RESPECT TO POWER PACK PLACEMENT.
- CONTRACTOR IS RESPONSIBLE FOR FIELD VERIFICATION OF REQUIRED NUMBER OF POWER PACKS:
 - ONE POWER PACK IS REQUIRED FOR EACH CONTROLLED CIRCUIT.
 - EACH POWER PACK CAN SUPPLY UP TO 150W. REFER TO INSTALLATION GUIDE FOR MAXIMUM NUMBER OF SENSORS CONNECTED TO POWER PACK.
 - IF MULTIPLE CIRCUITS ARE TO BE CONTROLLED BY A SINGLE SENSOR, AUXILIARY RELAYS MAY BE USED IN CONJUNCTION WITH A POWER PACK.
- SENSORS MOUNTED OVER DOORWAYS SHOULD BE PLACED ONE (1) FOOT INSIDE THRESHOLD.
- THE LIGHTING CONTROL SYSTEM MANUFACTURER SHALL PROVIDE SHOP DRAWINGS AND FACTORY ONSITE STARTUP. SHOP DRAWINGS SHALL INCLUDE DETAILED CUTSHEETS, WIRING DIAGRAMS AND SCALED DRAWINGS WITH DEVICE LOCATIONS.
- APPROVED EQUIVALENT MANUFACTURERS FOR OCCUPANCY SENSORS AND LOW VOLTAGE LIGHTING CONTROLS ARE ILC AND HUBBELL. ALL LUMINAIRES AND LIGHTING CONTROLS THAT ARE NOT SPECIFIED MUST BE SUBMITTED FOR PRIOR APPROVAL 10 DAYS PRIOR TO BID. LUMINAIRE AND LIGHTING CONTROLS THAT ARE THEN PRIOR APPROVED WILL BE ADDED AS AN ADDENDUM ITEM. IT IS THE RESPONSIBILITY OF THE ELECTRICAL CONTRACTOR TO REVIEW A COPY OF THE ADDENDUM TO VERIFY IF SUBMITTED ITEMS HAVE BEEN APPROVED.
- PROVIDE LOW VOLTAGE CABLING FROM 0-10V DIMMER SWITCH TO EACH LUMINAIRE AS REQUIRED TO ACCOMPLISH 0-10V DIMMING.
- COORDINATE WITH POWER PLANS FOR RECEPTACLE ROOM CONTROLLERS REQUIRED FOR PLUG LOAD CONTROL.
- LIGHTING CONTROL PANELS SHALL BE NETWORKED TOGETHER, PROVIDE ALL PARTS FOR COMPLETE FUNCTIONING NETWORKED SYSTEM. PROVIDE RELAYS AND BARRIERS AS REQUIRED FOR UL924 EMERGENCY LIGHTING CIRCUITS AS INDICATED.

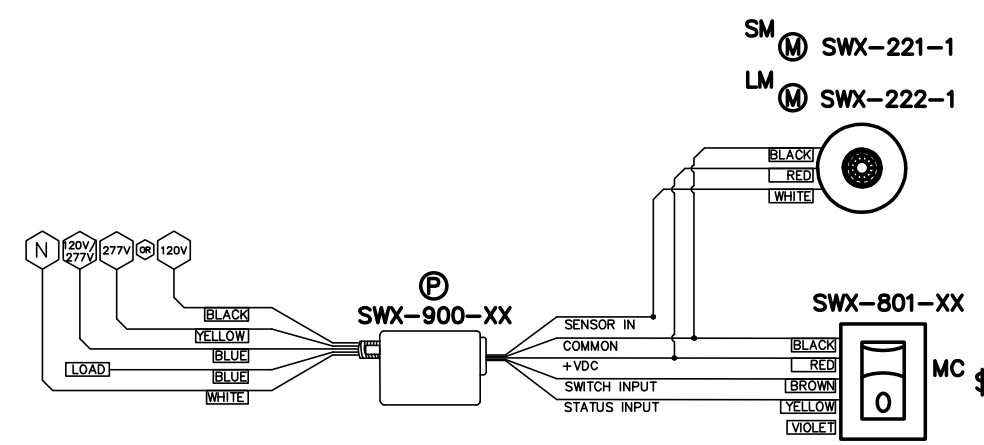


1 WIRING DIAGRAM TYPICAL MANUAL ON VACANCY CONTROL NO SCALE

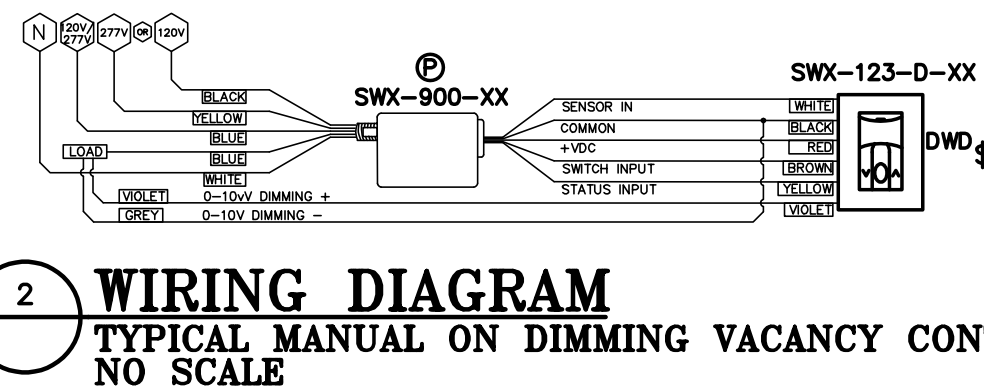

2 WIRING DIAGRAM TYPICAL MANUAL ON DIMMING VACANCY CONTROL NO SCALE

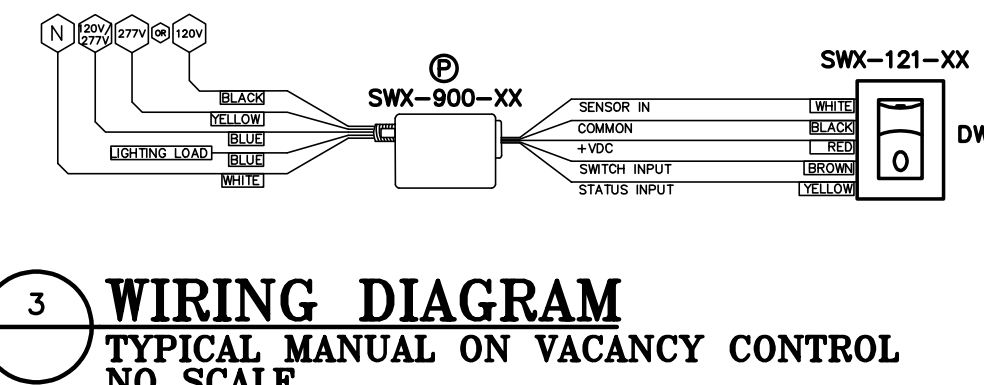

3 WIRING DIAGRAM TYPICAL MANUAL ON VACANCY CONTROL NO SCALE

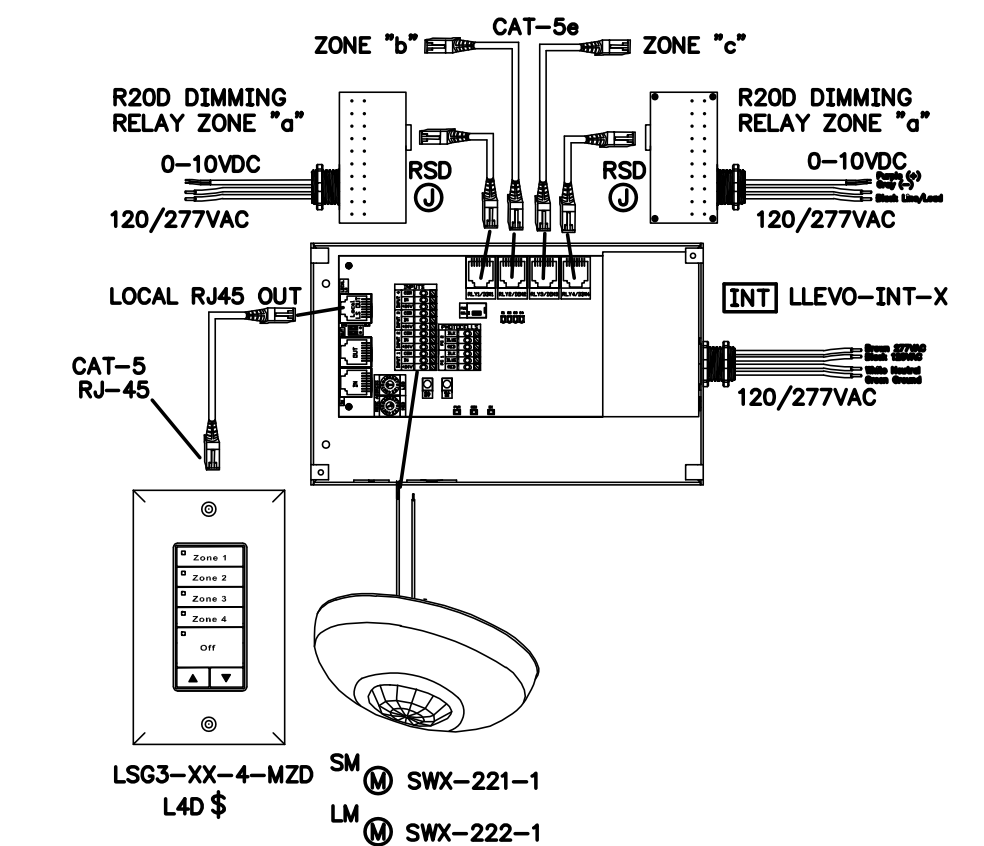

4 WIRING DIAGRAM TYPICAL ROOM CONTROLLER WITH MULTIPLE ZONES NO SCALE

NOTES:


- CONTRACTOR SHALL LOCATE ALL ROOM CONTROLLERS ABOVE DOORS IN EACH ROOM 6" ABOVE CEILING GRID. PROVIDE ACCESS PANELS WHERE LOCATED ABOVE HARD CEILINGS OR MOUNT IN UTILITY TYPE ROOMS WHENEVER POSSIBLE. ROOM CONTROLLERS SHOWN ON THESE PLANS ARE DIAGRAMMATIC FOR CIRCUITRY. DO NOT USE THESE FOR ACTUAL LOCATIONS. PROVIDE A WHITE PHENOLIC LABEL 1" BLACK TEXT THAT READS "INT" GLUED ON CEILING GRID UNDER ROOM CONTROLLER FOR EACH LOCATION FOR MAINTENANCE.

LUMINAIRE SCHEDULE

MARK	LUMENS	WATTS	TEMP	VOLTS	DESCRIPTION	MANUFACTURER	CATALOG NUMBER
L2	2000	20	3500	MVOLT	SURFACE MOUNTED LED STRIP, 2'-0" LENGTH	COOPER	ZSNLED-LD5-41SL-LW-UNV-L835-CD-1-U
L4	4000	40	3500	MVOLT	SURFACE MOUNTED LED STRIP, 4'-0" LENGTH	COOPER	4SNLED-LD5-41SL-LW-UNV-L835-CD-1-U
L4E	4000	40	3500	MVOLT	SURFACE MOUNTED LED STRIP, 4'-0" LENGTH, PROVIDE WITH 90 MIN BATTERY BACKUP	COOPER	4SNLED-LD5-41SL-LW-UNV-EL7W-L835-CD1-U
L20	2000	20	3500	MVOLT	RECESSED DOWNLIGHT, 6" DIAMETER	COOPER	HC6-20-D010-HM6-0525-835-61-MD-C
L20E	2000	20	3500	MVOLT	RECESSED DOWNLIGHT, 6" DIAMETER, PROVIDE WITH 90 MIN BATTERY BACKUP	COOPER	HC6-20-D010-HM6-0525-835-61-MD-C-1EM7
L30	3000	20	3500	MVOLT	RECESSED DOWNLIGHT, 6" DIAMETER	COOPER	HC6-30-D010-HM6-0525-835-61-MD-C
L30E	3000	20	3500	MVOLT	RECESSED DOWNLIGHT, 6" DIAMETER, PROVIDE WITH 90 MIN BATTERY BACKUP	COOPER	HC6-30-D010-HM6-0525-835-61-MD-C-1EM7
L633	3300	47	3500	MVOLT	RECESSED LED BRIDGE LUMINAIRE, 2'x2', LAY IN	COOPER	BRG-WS-4-L35-LD2-UNV-22-T1-STD-
L633E	3300	47	3500	MVOLT	RECESSED LED BRIDGE LUMINAIRE, 2'x2', LAY IN, PROVIDE WITH 90 MIN BATTERY BACKUP.	COOPER	BRGBRG-WS-4-L35-LD2-UNV-22-T1-STD-EL14W
L640	5000	47	3500	MVOLT	RECESSED LED BRIDGE LUMINAIRE, 2'x4', LAY IN	COOPER	BRG-WS-3-L35-LD2-UNV-24-T1-STD
L640E	5000	47	3500	MVOLT	RECESSED LED BRIDGE LUMINAIRE, 2'x4', LAY IN, PROVIDE WITH 90 MIN BATTERY BACKUP.	COOPER	BRG-WS-3-L35-LD2-UNV-24-T1-STD-EL7W
L640T	5000	47	3500	MVOLT	RECESSED LED BRIDGE LUMINAIRE, 2'x4', LAY IN, PROVIDE WITH BOODIE TRANSFER SWITCH	COOPER	BRG-WS-3-L35-LD2-120-24-T1-STD-GTD2
P1-3	31000	258	4000	480	POLE MOUNTED SINGLE HEAD AREA LUMINAIRE, TYPE 3 DISTRIBUTION, 30'-0" STRAIGHT STEEL POLE. COLOR TO MATCH EXISTING POLE LUMINAIRES ON SITE	COOPER	GALN-SA4-C-740-208-T3-BPC
P1-4	31000	258	4000	480	POLE MOUNTED SINGLE HEAD AREA LUMINAIRE, TYPE 4 WIDE DISTRIBUTION, 30'-0" STRAIGHT STEEL POLE. COLOR TO MATCH EXISTING POLE LUMINAIRES ON SITE	COOPER	GALN-SA4-C-740-208-T4W-BPC
P1-5	31000	258	4000	480	POLE MOUNTED SINGLE HEAD AREA LUMINAIRE, TYPE 5 WIDE DISTRIBUTION, 30'-0" STRAIGHT STEEL POLE. COLOR TO MATCH EXISTING POLE LUMINAIRES ON SITE	COOPER	GALN-SA4-C-740-208-5WQ-BPC
PD1	750 PER FT	44	3500	MVOLT	PENDANT MOUNTED LED RING, 4'-0" DIAMETER	LUMENWERX	CURVMRIP-DI-4FT-HLO-HLO-SW-90CRI-350-350-35K-UNV-RD1-1C-POC-XX-SC-XX-XX
SL	2000	20	3500	MVOLT	RECESSED LED SHOWER DOWNLIGHT, 6" DIAMETER, DEAD FRONT CONSTRUCTION.	COOPER	HC4-20-D010-HB128APK-HM4-0525-835-41PS-MD-W
WP1E	;	37	4000	MVOLT	WALL MOUNTED LED AREA LUMINAIRE, TYPE 4 DISTRIBUTION, PROVIDE WITH 90 MIN BATTERY BACKUP.	NLS	NV-W-T4-16-40K-UNV-WM-BRZ
XA	;	;	;	MVOLT	CEILING MOUNTED SINGLE FACE EXIT SIGN, RED LETTERS, PROVIDE WITH 90 MIN BATTERY BACKUP.	BARRON	VEX-U-BP-WB
XB	;	;	;	MVOLT	CEILING MOUNTED DOUBLE FACE EXIT SIGN, RED LETTERS, PROVIDE WITH 90 MIN BATTERY BACKUP.	BARRON	VEX-U-BP-WB

LUMINAIRE SCHEDULE NOTES

- PREAPPROVED EQUIVALENT MEANS ALL REQUESTS FOR APPROVAL OF MANUFACTURER'S EQUIPMENT NOT SPECIFIED IN THE LUMINAIRE SCHEDULE MUST BE RECEIVED BY THE ENGINEER TEN (10) BUSINESS DAYS PRIOR TO BID.
- EXIT LIGHTS SHALL BE PROVIDED WITH COLOR OF LETTERS REQUIRED BY LOCAL CODE AUTHORITY. FURNISH WITH CHEVRON DIRECTIONAL ARROWS AS SHOWN ON DRAWINGS AND REQUIRED.
- FURNISH PLASTER FRAMES FOR ALL RECESSED LUMINAIRES IN PLASTER CEILINGS.
- CONTRACTOR SHALL VERIFY EXACT TYPE CEILINGS BEING FURNISHED AND SUPPLY BASIC LUMINAIRES SPECIFIED IN APPROPRIATE CONFIGURATION FOR CEILING TO BE FURNISHED.
- PROVIDE DEVICES FOR SECURING LUMINAIRE TO CEILING GRID TO COMPLY WITH SECTION 410.36B OF THE 2020 NATIONAL ELECTRICAL CODE FOR ALL LAY-IN TYPE LUMINAIRES. BENT TAB TYPE IS NOT ACCEPTABLE. IN ADDITION, THE ELECTRICAL CONTRACTOR SHALL PROVIDE THE FOLLOWING CEILING GRID SUPPORTS:
 - ONE AT EACH CORNER OF 2'x4'
 - ONE AT DIAGONAL CORNER OF 2'x2'
- EPA RATING OF ALL POLE MOUNTED LUMINAIRE SHALL MEET CURRENT IBC REQUIREMENTS FOR THIS REGION.
- ALL LUMINAIRES AND BALLAST/DRIVERS SHALL BE RATED FOR OPERATION IN AMBIENT TEMPERATURES UP TO 55 DEGREES CELSIUS.
- ALL EMERGENCY AND EXIT LIGHTS PROVIDED WITH BATTERY BACKUP WILL BE CONNECTED TO UNSWITCHED HOT LEG SO THAT BATTERY OPERATES UPON POWER FAILURE.
- TO ENSURE PROPER COORDINATION AND LONG TERM SUPPORT FOR THE OWNER, ALL LIGHTING LUMINAIRES SHALL BE PURCHASED THROUGH MANUFACTURER'S REPRESENTATIVES AND DISTRIBUTORS LOCATED WITHIN SIXTY (60) MILES OF THE PROJECT SITE. SUBMITTALS RECEIVED THAT DO NOT COMPLY WITH THIS REQUIREMENT WILL BE REJECTED WITHOUT REVIEW. THE CONTRACTOR SHALL BE RESPONSIBLE FOR ANY DELAYS CAUSED BY NON-COMPLIANCE WITH THIS REQUIREMENT.

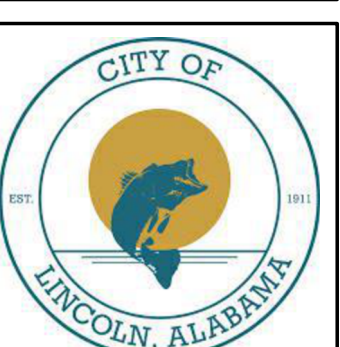

NEW CITY OF LINCOLN
POLICE DEPARTMENT
LINCOLN, ALABAMA



OWNER
City of Lincoln
150 Magnolia St.
Lincoln, AL 35096
256-763-7777
Attn: Lew Watson

ARCHITECT
Bill Whittaker, P.C.
Architecture
236 Martin Street
Anniston, AL 36205
Attn: Bill Whittaker

CIVIL ENGINEER
TTL
10 Inverness Center Pkwy
Suite 350
Hooover, AL 35042
256-441-2232
Attn: Tim Roberts

STRUCTURAL ENGINEER
Barnett, Jones, Wilson
125 18th St N
Pell City, AL 35125
205-884-0334
Attn: Jeremy Deal

MECHANICAL/PLUMBING/FIRE
PROTECTION ENGINEER
Whorton Engineering, Inc.
25 Summerall Gate Road
Anniston, AL 36205
256-820-0897
Attn: Randy Whorton

ELECTRICAL ENGINEER
Hays Cheatwood Consulting
P.O. Box 250
Pinson, AL 35176
256-842-0566
Attn: Tony Dodd


ISSUE:
03.31.25 BID
04.16.25 ADD #2

JOB NO.
24001

DESCRIPTION:
LUMINAIRE
SCHEDULE &
LIGHTING
CONTROLS

SHEET

E00.3

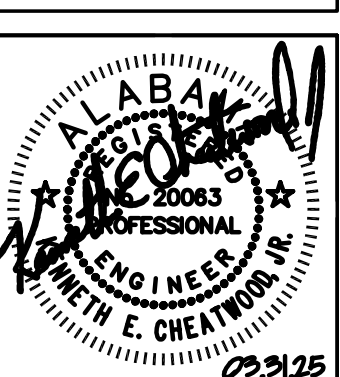



NEW CITY OF LINCOLN
POLICE DEPARTMENT
LINCOLN, ALABAMA



OWNER
City of Lincoln
150 Magnolia St.
Lincoln, AL 35096
205-763-7777
Attn: Lew Watson

ARCHITECT
Bill Whittaker, P.C.
Architecture
236 Martin Street
Anniston, AL 36208
Attn: Bill Whittaker

CIVIL ENGINEER
TTL
10 Inverness Center Pkwy
Suite 350
Hooover, AL 35242
256-441-2232
Attn: Tim Roberts

STRUCTURAL ENGINEER
Barnett, Jones, Wilson
125 18th St N
Patt City, AL 35125
205-884-0334
Attn: Jeremy Deal

MECHANICAL/PLUMBING/FIRE
PROTECTION ENGINEER
Whorton Engineering, Inc.
25 Summerall Gate Road
Anniston, AL 36205
Attn: Randy Whorton

ELECTRICAL ENGINEER
Hays Cheatwood Consulting
P.O. Box 250
Pinson, AL 35126
205-842-0086
Attn: Tony Dodd

ISSUE:
03.31.25 BID
04.16.25 ADD #2

JOB NO.
24001

DESCRIPTION:
PANELBOARD
SCHEDULES

SHEET

E00.5

03/31/25

1500_PP-MAIN

PANEL LOCATION FED FROM UTILITY DISTRIBUTION PANELBOARD		DC DEVICE TYPE DEVICE FAMILY:		Breaker Bolt On	ENCLOSURE MOUNTING VOLTAGE	NEMA 1 Surface 208/120	MAINS(A) WIRING	MLO 3-Phase 4-Wire	CONTINUOUS(A) BUS SC RATING(A) FAULT CURRENT(A)	1000 42000 23327
CUBICLE NO	DESCRIPTION	CONNECTED kVA	DEMAND kVA	DESIGN kVA	DESIGN MAX AMPS	DC DEVICE TYPE	SIZE	P	NOTES	
1	INVERTER	6.67	6.67	6.67	35.05		60	2		
2	RP-HVAC-A	231.24	231.24	231.66	657.65		800	3	100% RATED	
3	SPACE	86.03	57.50	61.76	190.95		250	3		
4	SPACE	0.00	0.00	0.00	0.00		150	3		
5	SPACE	0.00	0.00	0.00	0.00		150	3		
6	SPACE	0.00	0.00	0.00	0.00		150	3		
7	SPACE	0.00	0.00	0.00	0.00		150	3		
8	SPACE	0.00	0.00	0.00	0.00		150	3		
ALL CONNECTED		kVA	MAX PH AMPS	■ PHASE TOTALS		VA	AMPS	BUS TOTALS		kVA
TOTAL CONNECTED		320.43	926.8	■ A-N		110868.0	923.2	CONNECTED		320.43
TOTAL DEMAND		292.71	846.1	■ B-N		111302.9	926.9	DEMAND		292.71
TOTAL DESIGN		297.18	860.0	■ C-N		98269.2	818.3	DESIGN		297.18
										Apr 15, 2025 12:24:23

1700_RP-A_SEC_1

PANEL LOCATION		700 RP-A SEC 1		DC DEVICE TYPE		Breaker Bolt On		ENCLOSURE MOUNTING		NEMA 1 Surface 208/120		MAINS(A) MLO WIRING		3-Phase 4-Wire		CONTINUOUS(A)		250 BUS SC RATING(A)	
FED FROM PP-MAIN LIGHTING & APPLIANCE PANELBOARD TYPE I																		28000 FAULT CURRENT(A)	

1705_RP-A_SEC_2



PANEL LOCATION		705 RP-A SEC 2		DC DEVICE TYPE		Breaker		ENCLOSURE		NEMA 1		MAINS(A)		MLO		CONTINUOUS(A)		250	
FED FROM		RP-A SEC 1		DEVICE FAMILY:		Bolt On		MOUNTING:		Surface		WIRING:		3-Phase 4-Wire		BUS SC RATING(A)		28000	
LIGHTING & APPLIANCE		PANELBOARD TYPE I						VOLTAGE:		208/120						FAULT CURRENT(A)		18619	
CKT	DESCRIPTION	NOTES	DEMAND CODE	VA	DC AMPS P	PHASE	DC AMPS P	VA	DEMAND CODE	NOTES	DESCRIPTION	CKT							
43	RECEPT		RECEPTACLES	1000	20 1	A	20 2	1536	LIGHTING		LIGHTING SITE	64							
44	SPARE			0	20 1	B						65							
45	GEH-1,2,3		RECEPTACLES	721	20 1	C	20 2	512	LIGHTING		LIGHTING SITE	66							
46	RECEPT		RECEPTACLES	1400	20 1	A	20 1	800	GENERAL LOAD		FACP	67							
47	RECEPT		RECEPTACLES	1000	20 1	B	20 1	800	GENERAL LOAD		FACP	68							
48	RECEPT		RECEPTACLES	1000	20 1	C	20 1	1800	RECEPTACLES		RECEPT	69							
49	RECEPT		RECEPTACLES	1000	20 1	A	20 1	640	LIGHTING		LIGHTS	70							
50	RECEPT		RECEPTACLES	1000	20 1	B	20 1	1400	RECEPTACLES		RECEPT	71							
51	RECEPT		RECEPTACLES	1000	20 1	C	20 1	1200	RECEPTACLES		RECEPT	72							
52	RECEPT		RECEPTACLES	800	20 1	A	20 1	1200	RECEPTACLES		RECEPT	73							
53	LIGHTS		LIGHTING	2112	20 1	B	20 1	1800	RECEPTACLES		RECEPT	74							
54	RECEPT		RECEPTACLES	1200	20 1	C	20 1	1200	RECEPTACLES		RECEPT	75							
55	RECEPT		RECEPTACLES	1800	20 1	A	20 1	1000	RECEPTACLES		RECEPT	76							
56	RECEPT		RECEPTACLES	800	20 1	B	20 1	1000	RECEPTACLES		RECEPT	77							
57	RECEPT		RECEPTACLES	800	20 1	C	20 1	1200	GENERAL LOAD		GATE	78							
58	RECEPT		RECEPTACLES	800	20 1	A	20 1	1200	RECEPTACLES		RECEPT	79							
59	RECEPT		RECEPTACLES	800	20 1	B	20 1	1200	RECEPTACLES		RECEPT	80							
60	RECEPT		RECEPTACLES	800	20 1	C	20 1	0	SPARE		SPARE	81							
61	HEATING		HEATING	4500	30 2	A	20 1	0	SPARE		SPARE	82							
62				0	20 1	B	20 1	0	SPARE		SPARE	83							
63	SPARE			0	20 1	C	20 1	0	SPARE		SPARE	84							
ALL CONNECTED		kVA	MAX PH AMPS	■ PHASE TOTALS		VA	AMPS	BUS TOTALS		kVA	DATE: Apr 15, 2025								
TOTAL CONNECTED		37.99	118.4	■ A-N		13820.2	110.1	CONNECTED		37.99	TIME: 12:24:24								
TOTAL DEMAND		25.54	97.4	■ B-N		14222.9	118.4	DEMAND		25.54									
TOTAL DESIGN		31.82	107.9	■ C-N		10567.1	88.0	DESIGN		31.82									

1715_RP-HVAC-A_SEC_1

PANEL LOCATION		715 RP-WHAC-A SEC 1		DC DEVICE TYPE		Breaker		ENCLOSURE		NEMA 1		MAINS(A)		MLO		CONTINUOUS(A)		800	
FED FROM		PP-MAIN		DEVICE FAMILY		Bolt On		MOUNTING		Surface		WIRING		3-Phase 4-Wire		BUS SC RATING(A)		28000	
LIGHTING & APPLIANCE		PANELBOARD TYPE I						VOLTAGE:		208/120		PROVIDE WITH FEED-THRU LUGS				FAULT CURRENT(A)		19770	
CKT	DESCRIPTION	NOTES	DEMAND CODE	VA	DC AMPS P	PHASE	DC AMPS P	VA	DEMAND CODE	NOTES	DESCRIPTION	CKT							
1	HP-1		MOTOR LOAD	4611	25 3	A	20 3	3603	MOTOR LOAD		HP-8	22							
2						B						23							
3						C						24							
4	HP-2		MOTOR LOAD	5044	30 3	A	25 3	4611	MOTOR LOAD		HP-9	25							
5						B						26							
6						C						27							
7	HP-3		MOTOR LOAD	3603	20 3	A	25 3	4611	MOTOR LOAD		HP-10	28							
8						B						29							
9						C						30							
10	HP-4		MOTOR LOAD	3603	20 3	A	30 3	5044	MOTOR LOAD		HP-11	31							
11						B						32							
12						C						33							
13	HP-5		MOTOR LOAD	3603	20 3	A	35 3	6341	MOTOR LOAD		HP-12	34							
14						B						35							
15						C						36							
16			MOTOR LOAD	4611	25 3	A	35 3	6341	MOTOR LOAD		HP-13	37							
17						B						38							
18						C						39							
19	HP-7		MOTOR LOAD	3603	20 3	A	60 3	14771	MOTOR LOAD		HP-13	40							
20						B						41							
21						C						42							
ALL CONNECTED		kVA	MAX PH AMPS	■ PHASE TOTALS		VA		AMPS		BUS TOTALS		kVA							
TOTAL CONNECTED		74.00	205.4	■ A-N		24666.3		205.4		CONNECTED		231.24			DATE: Apr 15, 2025				
TOTAL DEMAND		74.00	205.4	■ B-N		24666.3		205.4		DEMAND		231.24			TIME: 12:24:24				
TOTAL DESIGN		74.00	205.4	■ C-N		24666.3		205.4		DESIGN		231.66							

1720_RP-HVAC-A_SEC_2

EQUINUM-780-SEC2																	
PANEL LOCATION		720 RP-WHAC-A SEC 2		DC DEVICE TYPE		Breaker		ENCLOSURE		NEMA 1		MAINS(A): MLO		CONTINUOUS(A):		800	
FED FROM		LIGHTING & APPLIANCE PANELBOARD TYPE 1		DEVICE FAMILY		Bolt On		MOUNTING		Surface		WIRING: 3-Phase 4-Wire		BUS SC RATING(A)		28000	
								VOLTAGE:		208/120		PROVIDE WITH FEED-THRU LUGS		FAULT CURRENT(A):		18619	
CKT	DESCRIPTION	NOTES	DEMAND CODE	VA	DC AMPS P	PHASE	DC AMPS P	VA	DEMAND CODE	NOTES	DESCRIPTION	CKT					
43	HP-1		MOTOR LOAD	9511	35 3	A	35 3	9511	MOTOR LOAD		HP-9	64					
44	**			**	**	B	**	**				65					
45	**			**	**	C	**	**				66					
46	HP-2		MOTOR LOAD	9511	35 3	A	35 3	9511	MOTOR LOAD		HP-11	67					
47	**			**	**	B	**	**				68					
48	**			**	**	C	**	**				69					
49	HP-3		MOTOR LOAD	5200	35 2	A	60 3	14771	MOTOR LOAD		HP-12	70					
50	**			**	**	B	**	**				71					
51	HP-4		MOTOR LOAD	5200	35 2	C	20 3	3603	MOTOR LOAD		HP-14	72					
52	**			**	**	A	**	**				73					
53	HP-5		MOTOR LOAD	5200	35 2	B	**	**				74					
54	**			**	**	C	**	**				75					
55	HP-6		MOTOR LOAD	5200	35 2	A	30 3	5044	MOTOR LOAD		HP-15	76					
56	**			**	**	B	**	**				77					
57	HP-7		MOTOR LOAD	5200	35 2	C	**	**				78					
58	**			**	**	A	30 3	5044	MOTOR LOAD		HP-16	79					
59	**			**	**	B	**	**				80					
60	HP-8		MOTOR LOAD	5200	35 2	C	30 3	5044	MOTOR LOAD		HP-17	81					
61	**			**	**	A	**	**				82					
62	HP-10		MOTOR LOAD	5200	35 2	B	**	**				83					
63	DH-1		HEATING	492	20 1	C	**	**				84					
ALL CONNECTED		KVA	MAX PH AMPS	■ PHASE TOTALS		VA		AMPS		BUS TOTALS		KVA	DATE: Apr 15, 2025				
TOTAL DEMAND		108.34	306.9	■ A-N		36849.6		306.9		CONNECTED		157.25	TIME: 12:24:24				
TOTAL CONNECTED		108.34	306.9	■ B-N		36849.6		306.9		DEMAND		157.25					
TOTAL DESIGN		108.44	306.9	■ C-N		36849.6		306.9				157.66					

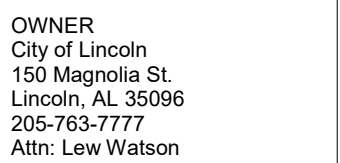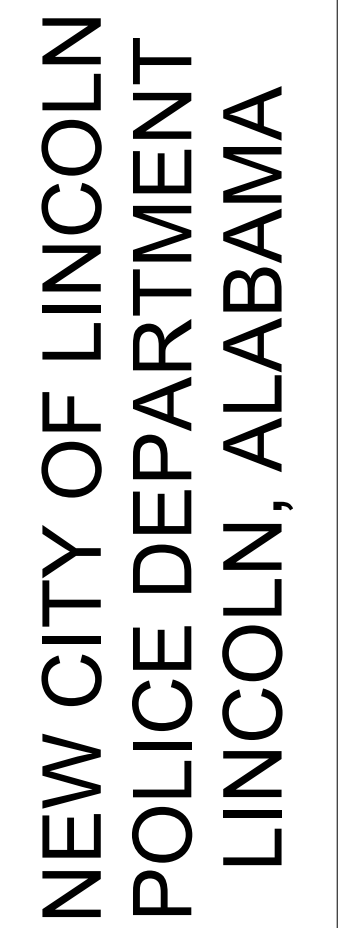

ARCHITECT
Bill Whittaker, P.C.
Architecture
236 Martin Street
Anniston, AL 36206
Attn: Bill Whittaker

CIVIL ENGINEER
TTL
10 Inverness Center Pkwy
Suite 350
Hoover, AL 35242
256-441-2232
Attn: Tim Roberts

STRUCTURAL ENGINEER
Barnett, Jones, Wilson
125 18th St N
Pell City, AL 35125
205-884-5334
Attn: Jeremy Deal

**MECHANICAL/PLUMBING/FIRE
PROTECTION ENGINEER**
Whorton Engineering, Inc.
25 Summerall Gate Road
Anniston, AL 36205
256-820-9897
Attn: Randy Whorton

ELECTRICAL ENGINEER
Hays Cheatwood Consulting
P.O. Box 250
Pinson, AL 35126
205-942-0696
Attn: Tony Dodd


ISSUE:
03.31.25 BID
04.16.25 ADD #2

JOB NO.
24001

DESCRIPTION:
FLOOR PLAN -
LIGHTING

SHEET

E10.0

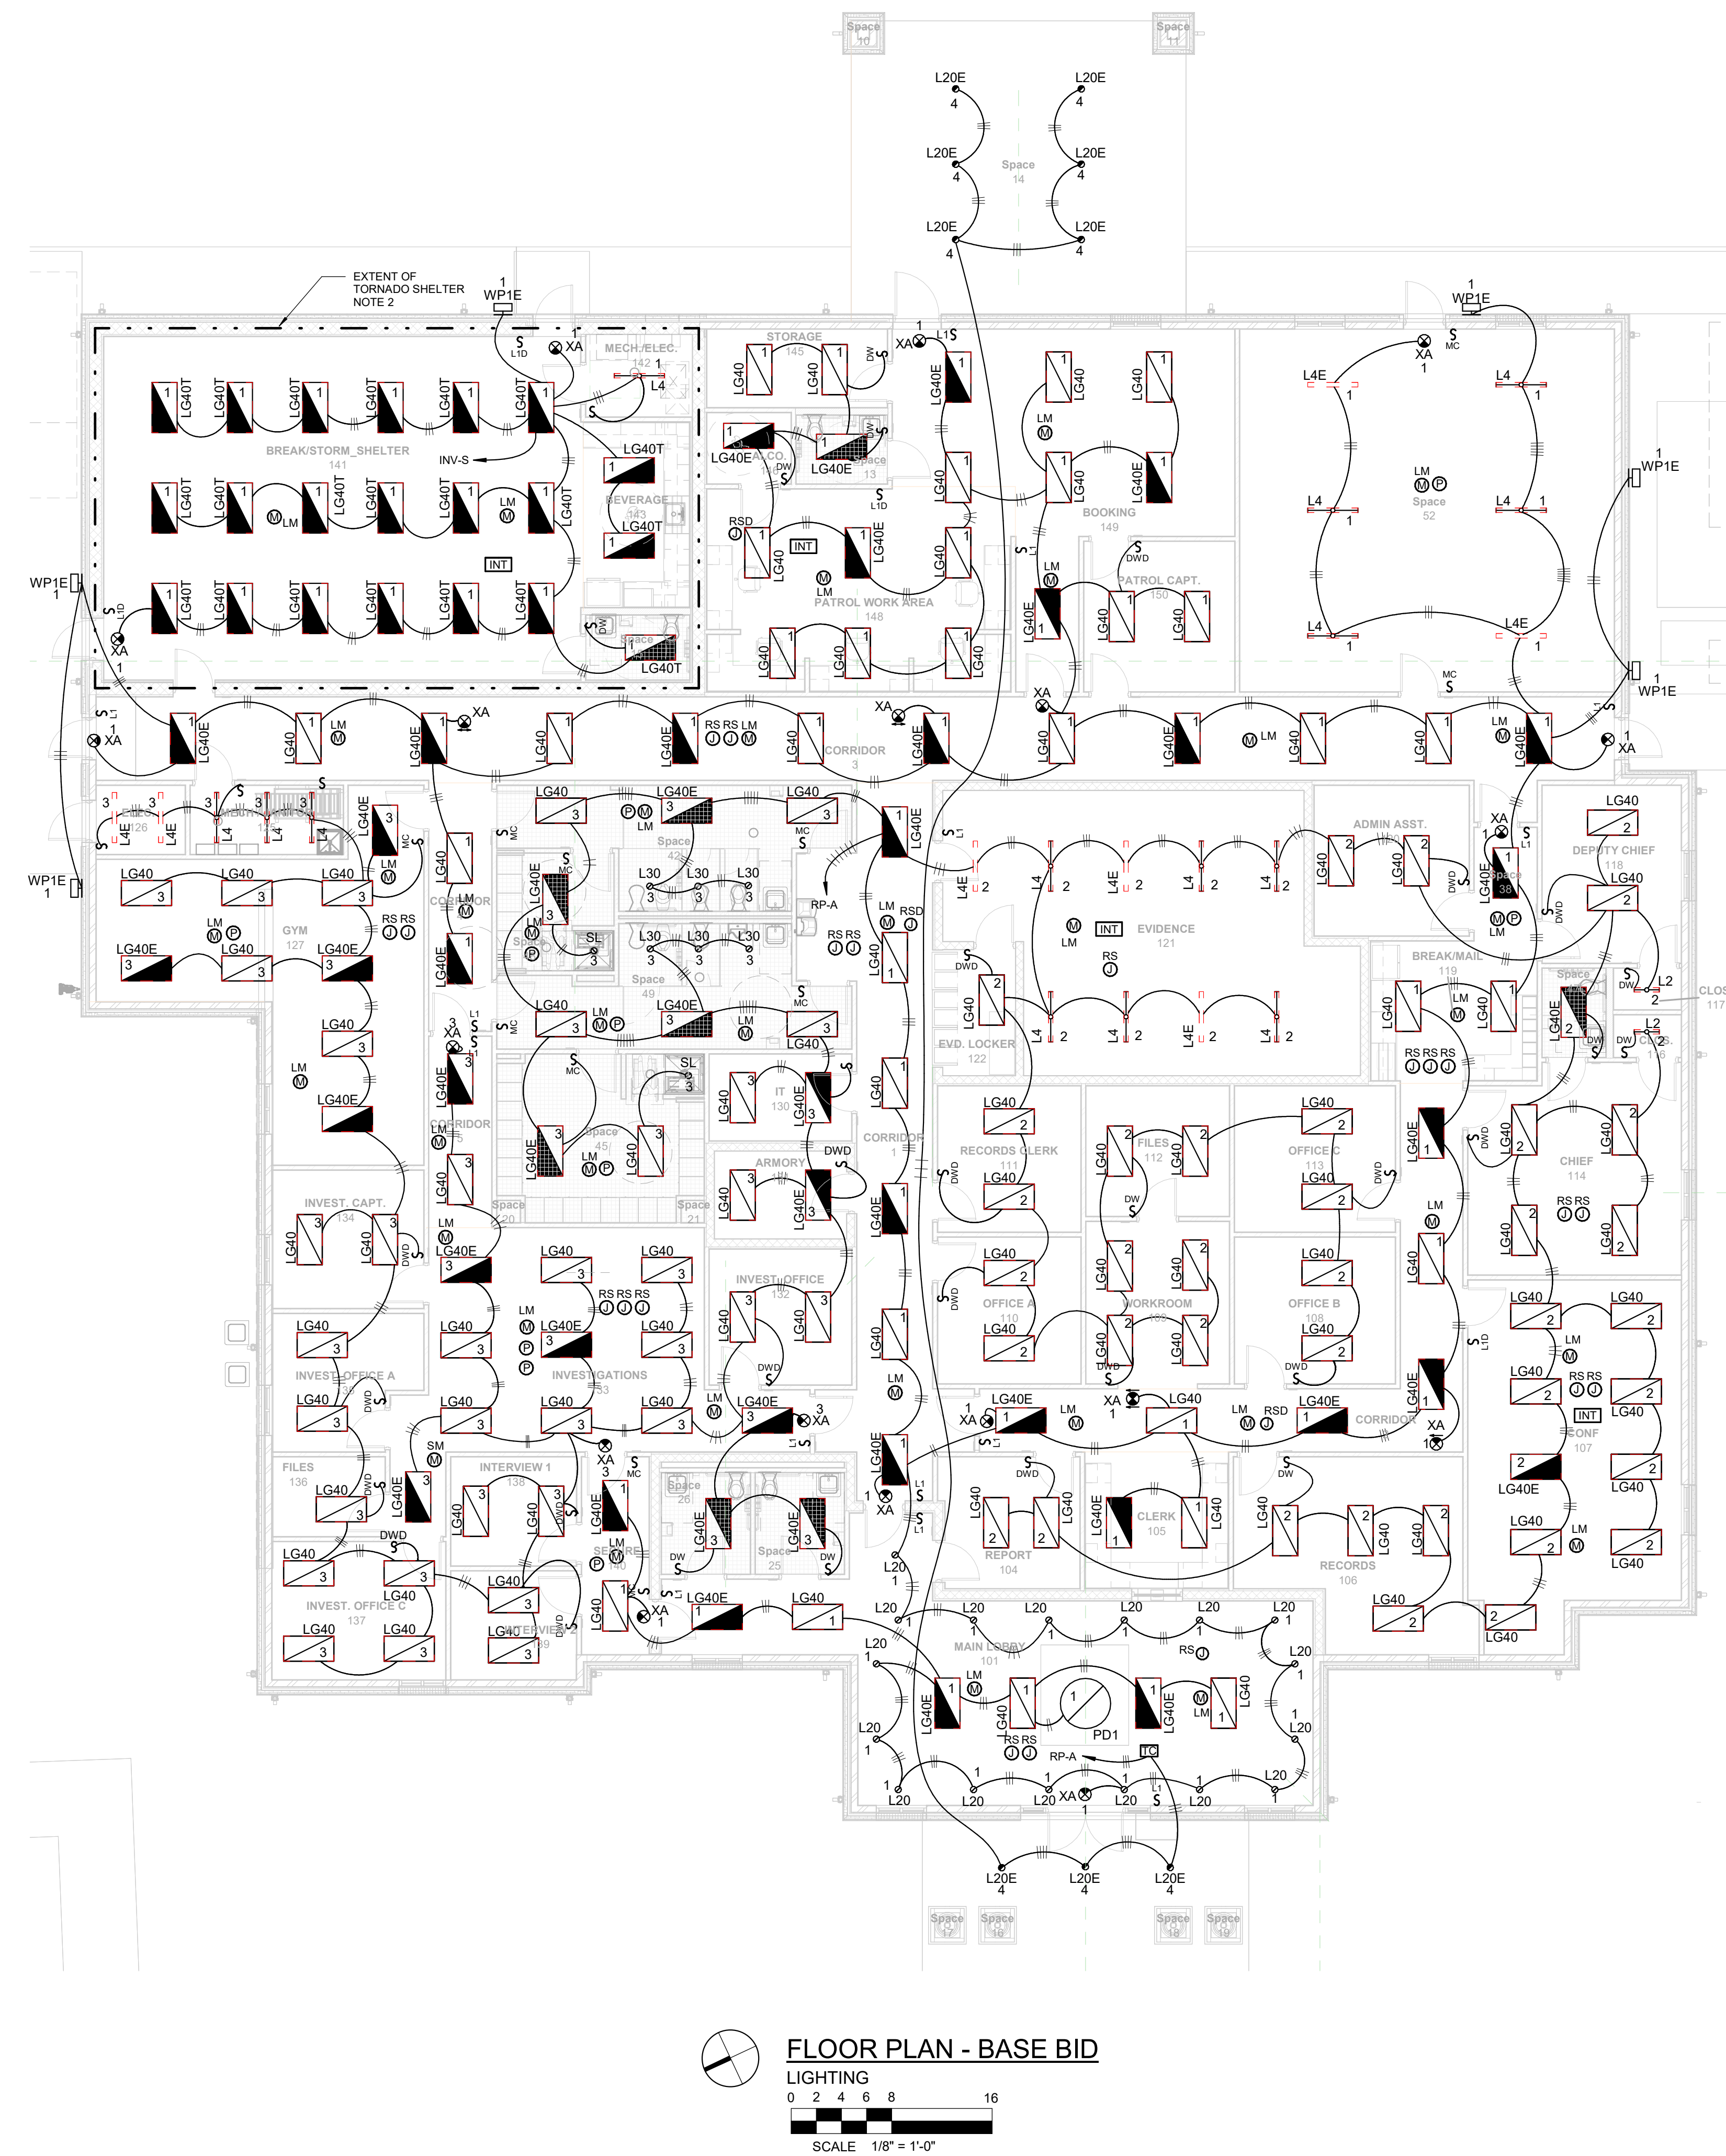

NOTES:

1. THERE SHALL BE NO PENETRATIONS LARGER THAN 2" INTO THE EXTENT OF THE TORNADO SHELTER, PER ICC 309.1.

2. CONTRACTOR SHALL INSTALL ALL CONDITS ENTERING OR EXITING THE STORM SHELTER UNDERGROUND SO THAT THEY DO NOT PENETRATE STORM SHELTER WALLS OR CEILINGS TO THE GREATEST EXTENT POSSIBLE. ANY PENETRATIONS(S) REQUIRED IN THE STORM SHELTER SHALL BE LESS THAN 2" AND SHALL CONFORM TO ICC 500.



OWNER
City of Lincoln
150 Magnolia St.
Lincoln, AL 35096
205-753-7777
Attn: Lew Watson

ARCHITECT
Bill Whittaker, P.C.
Architecture
236 Martin Street
Anniston, AL 36206
Attn: Bill Whittaker

CIVIL ENGINEER
TTL
10 Inverness Center Pkwy
Suite 350
Hoover, AL 35242
256-441-2232
Attn: Tim Roberts

STRUCTURAL ENGINEER
Barnett, Jones, Wilson
125 18th St N
Pell City, AL 35125
205-894-5334
Attn: Jeremy Deal

MECHANICAL/PLUMBING/FIRE
PROTECTION ENGINEER
Whorton Engineering, Inc.
25 Summerall Gate Road
Anniston, AL 36205
256-820-5997
Attn: Randy Whorton



ELECTRICAL ENGINEER
Hays Cheatwood Consulting
P.O. Box 250
Pinson, AL 35126
205-942-0606
Attn: Tony Dodd

ISSUE:
03.31.25 BID
04.16.25 ADD #2

JOB NO.
24001
DESCRIPTION:
FLOOR PLAN -
POWER

SHEET

E10.1

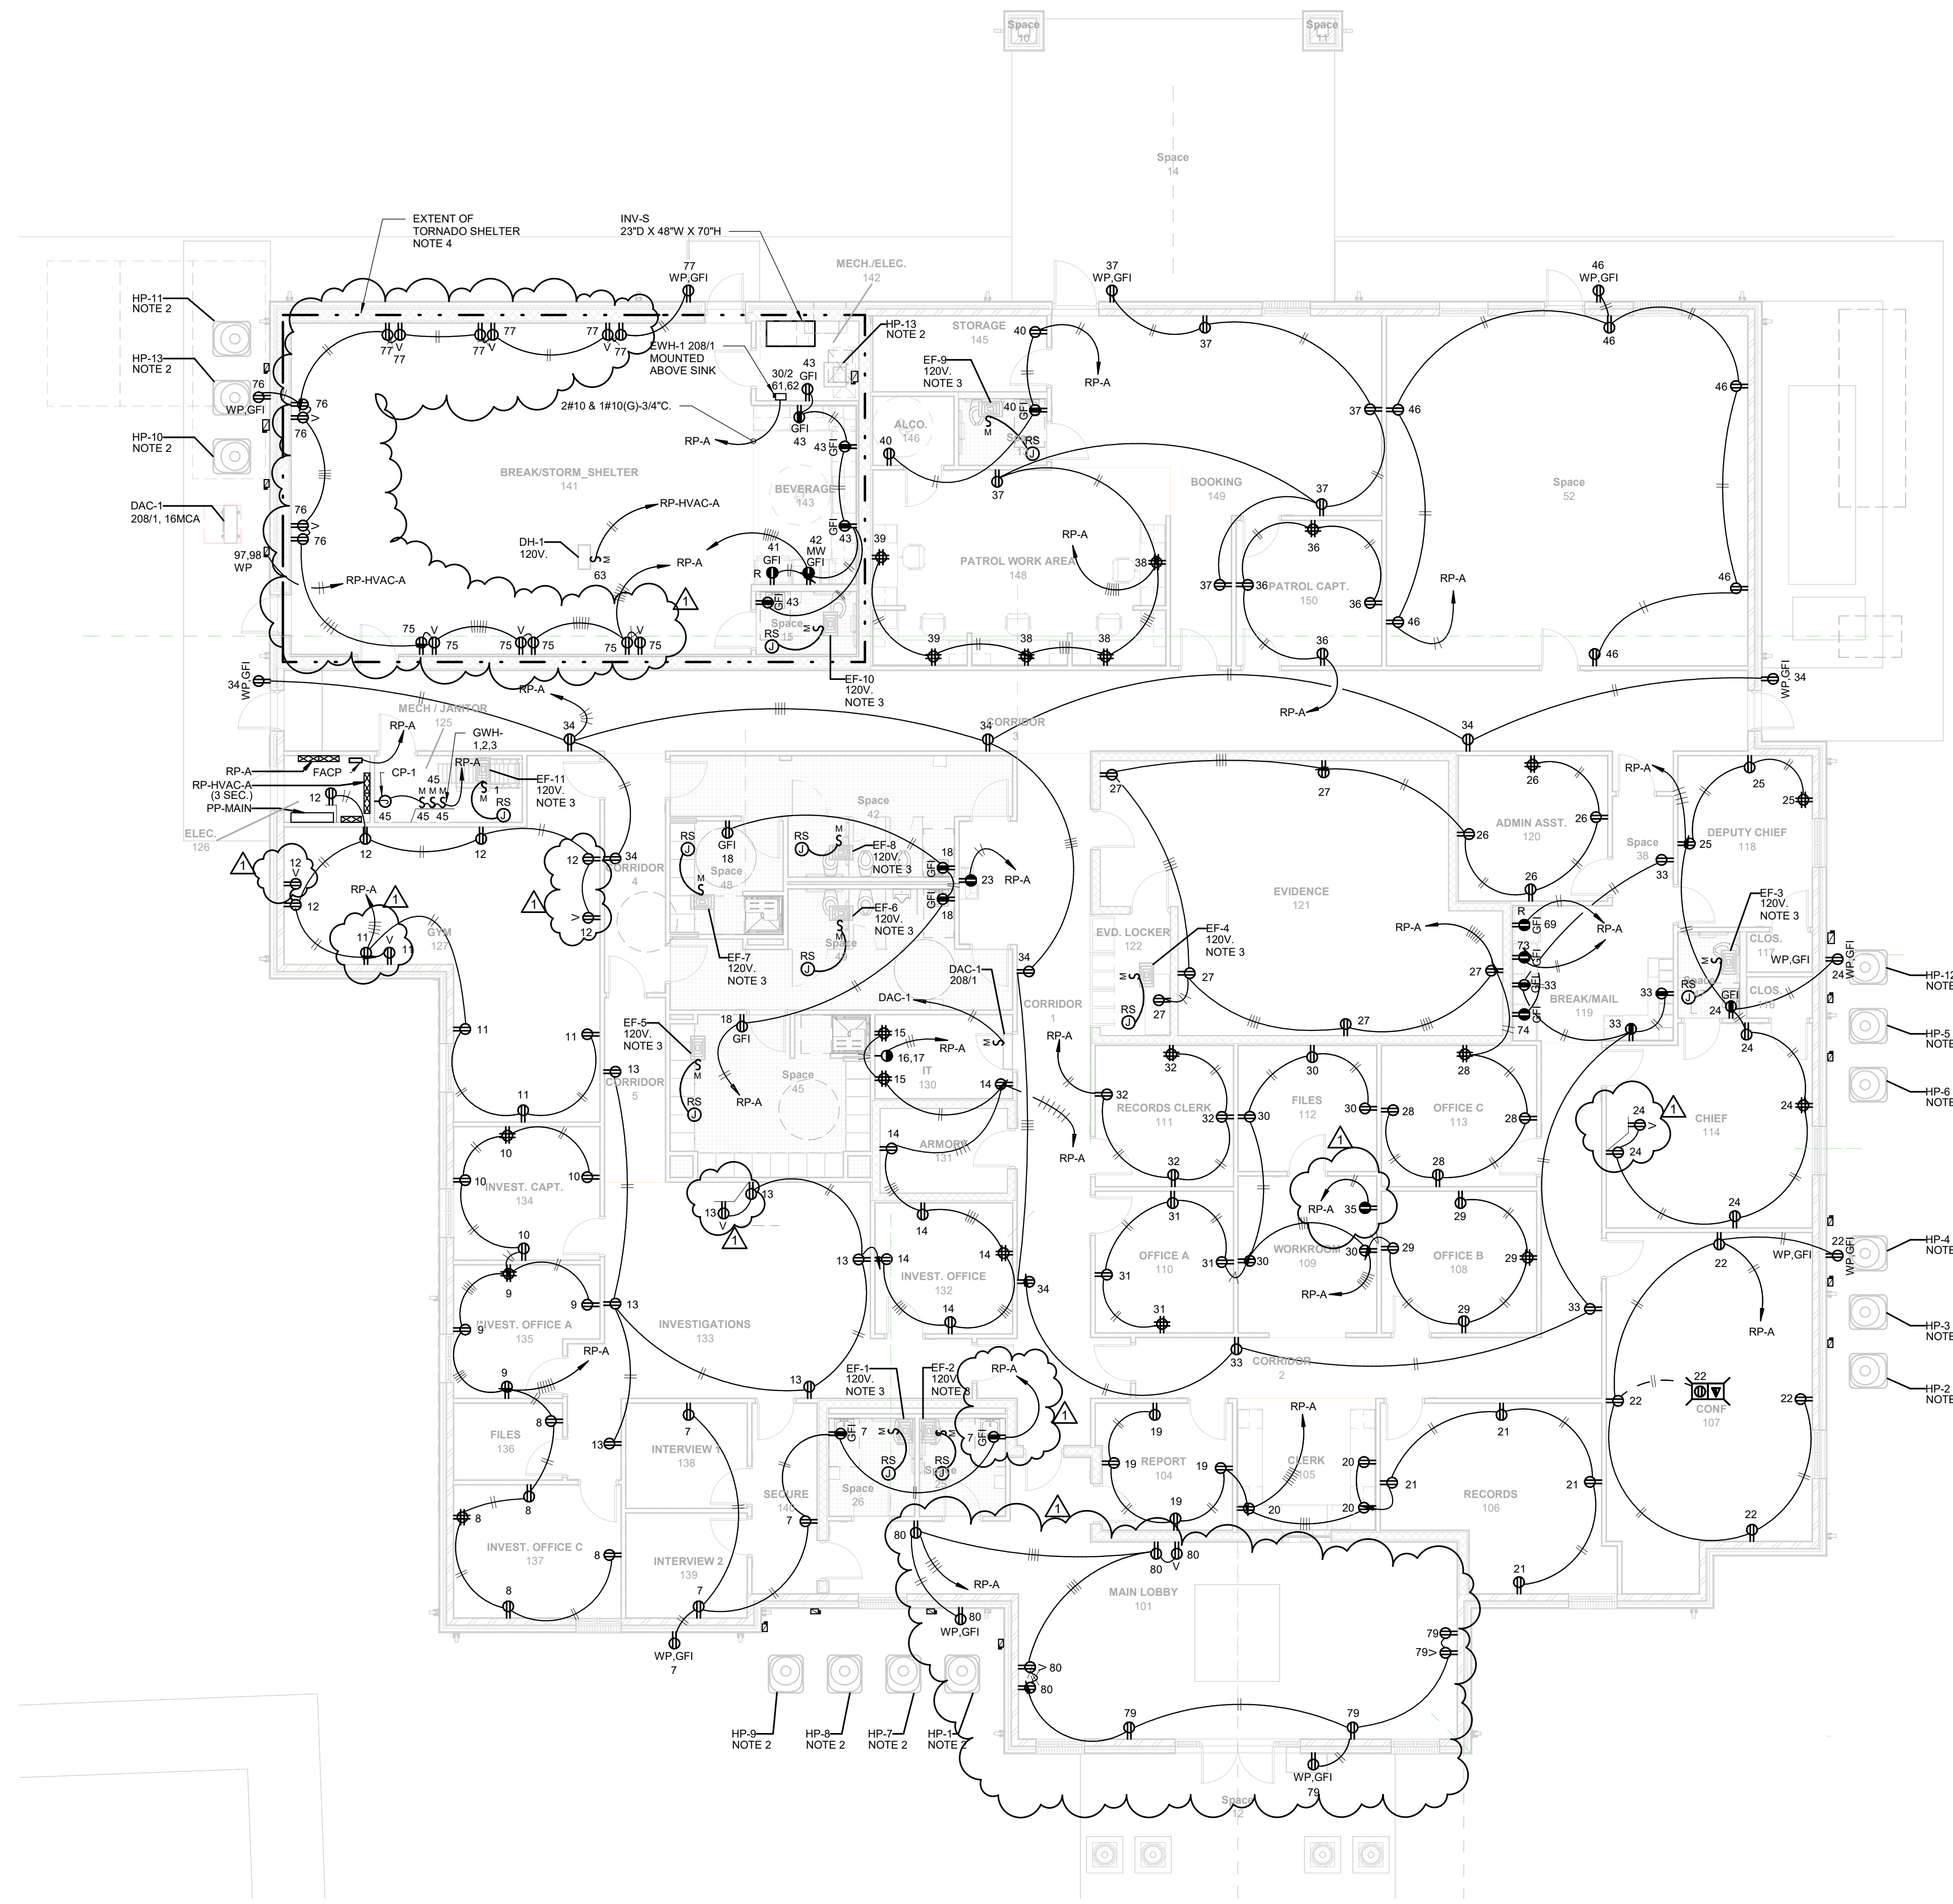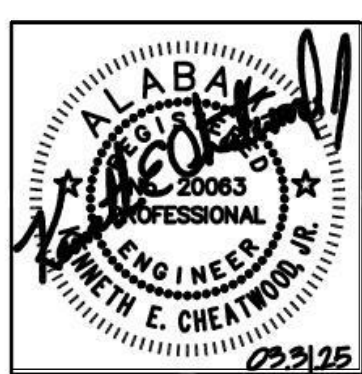

FLOOR PLAN - BASE BID
POWER
0 2 4 6 8 16
SCALE 1/8" = 1'-0"



- NOTES:
1. THERE SHALL BE NO PENETRATIONS LARGER THAN 2" INTO THE EXTENT OF THE TORNADO SHELTER, PER ICC 309.1.
 2. REFER TO SHEET E00.4 FOR ADDITIONAL ELECTRICAL INFORMATION AND REQUIREMENTS.
 3. EXHAUST FAN TO BE CONNECTED AND CONTROLLED BY LIGHTING CONTROLS.
 4. CONTRACTOR SHALL INSTALL ALL CONDUITS ENTERING OR EXITING THE STORM SHELTER UNDERGROUND SO THAT THEY DO NOT PENETRATE STORM SHELTER WALLS OR CEILINGS TO THE GREATEST EXTENT POSSIBLE. ANY PENETRATIONS(S) REQUIRED IN THE STORM SHELTER SHALL BE LESS THAN 2" AND SHALL CONFORM TO ICC 300.



**FLOOR PLAN - BASE BID
AUXILIARY**

0 2 4 6 8 16
SCALE 1/8" = 1'-0"

- NOTES:**
1. THERE SHALL BE NO PENETRATIONS LARGER THAN 2" INTO THE EXTENT OF THE TORNADO SHELTER, PER ICC 308.1.
 2. CONTRACTOR SHALL INSTALL ALL CONDUITS ENTERING OR EXITING THE STORM SHELTER UNDERGROUND SO THAT THEY DO NOT PENETRATE STORM SHELTER WALLS OR CEILINGS TO THE GREATEST EXTENT POSSIBLE. ANY PENETRATIONS(S) REQUIRED IN THE STORM SHELTER SHALL BE LESS THAN 2" AND SHALL CONFORM TO ICC 308.
 3. CONTRACTOR TO INSTALL EMPTY J HOOKS FOR FUTURE DATA. COORDINATE WITH ARCHITECTURAL FOR ADDITIONAL INFORMATION AND REQUIREMENTS.

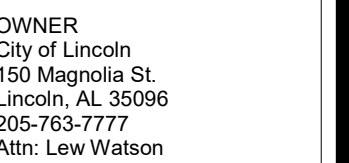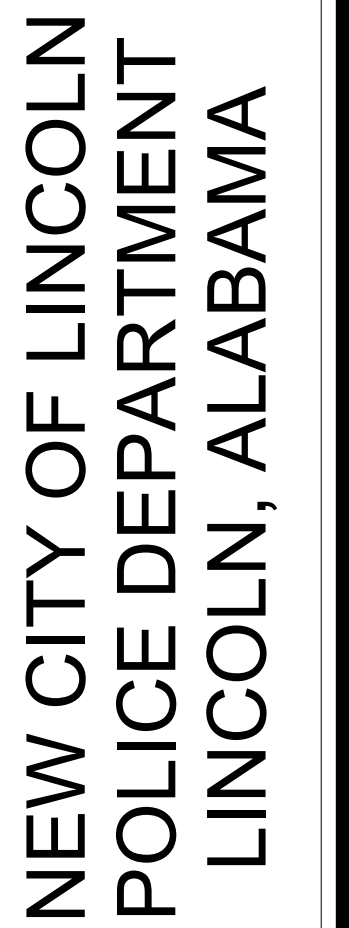

ARCHITECT
Bill Whittaker, P.C.
Architecture
236 Martin Street
Anniston, AL 36206
Attn: Bill Whittaker

CIVIL ENGINEER
FLL
10 Inverness Center Pkwy
Suite 350
Hoover, AL 35242
256-441-2232
Attn: Tim Roberts

STRUCTURAL ENGINEER
Barnett, Jones, Wilson
125 18th St N
Pell City, AL 35125
205-884-5334
Attn: Jeremy Deal

MECHANICAL/PLUMBING/FIRE
PROTECTION ENGINEER
Whorton Engineering, Inc.
25 Summerall Gate Road
Anniston, AL 36205
256-820-9897
Attn: Randy Whorton

ELECTRICAL ENGINEER
Days Cheatwood Consulting
P.O. Box 250
Pinson, AL 35126
205-942-0696
Attn: Tony Dodd



ISSUE:
03.31.25 BID
04.16.25 ADD #2

JOE NO.
24001

DESCRIPTION:
ATTIC PLAN -
ELECTRICAL


SHEET

10.3

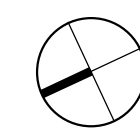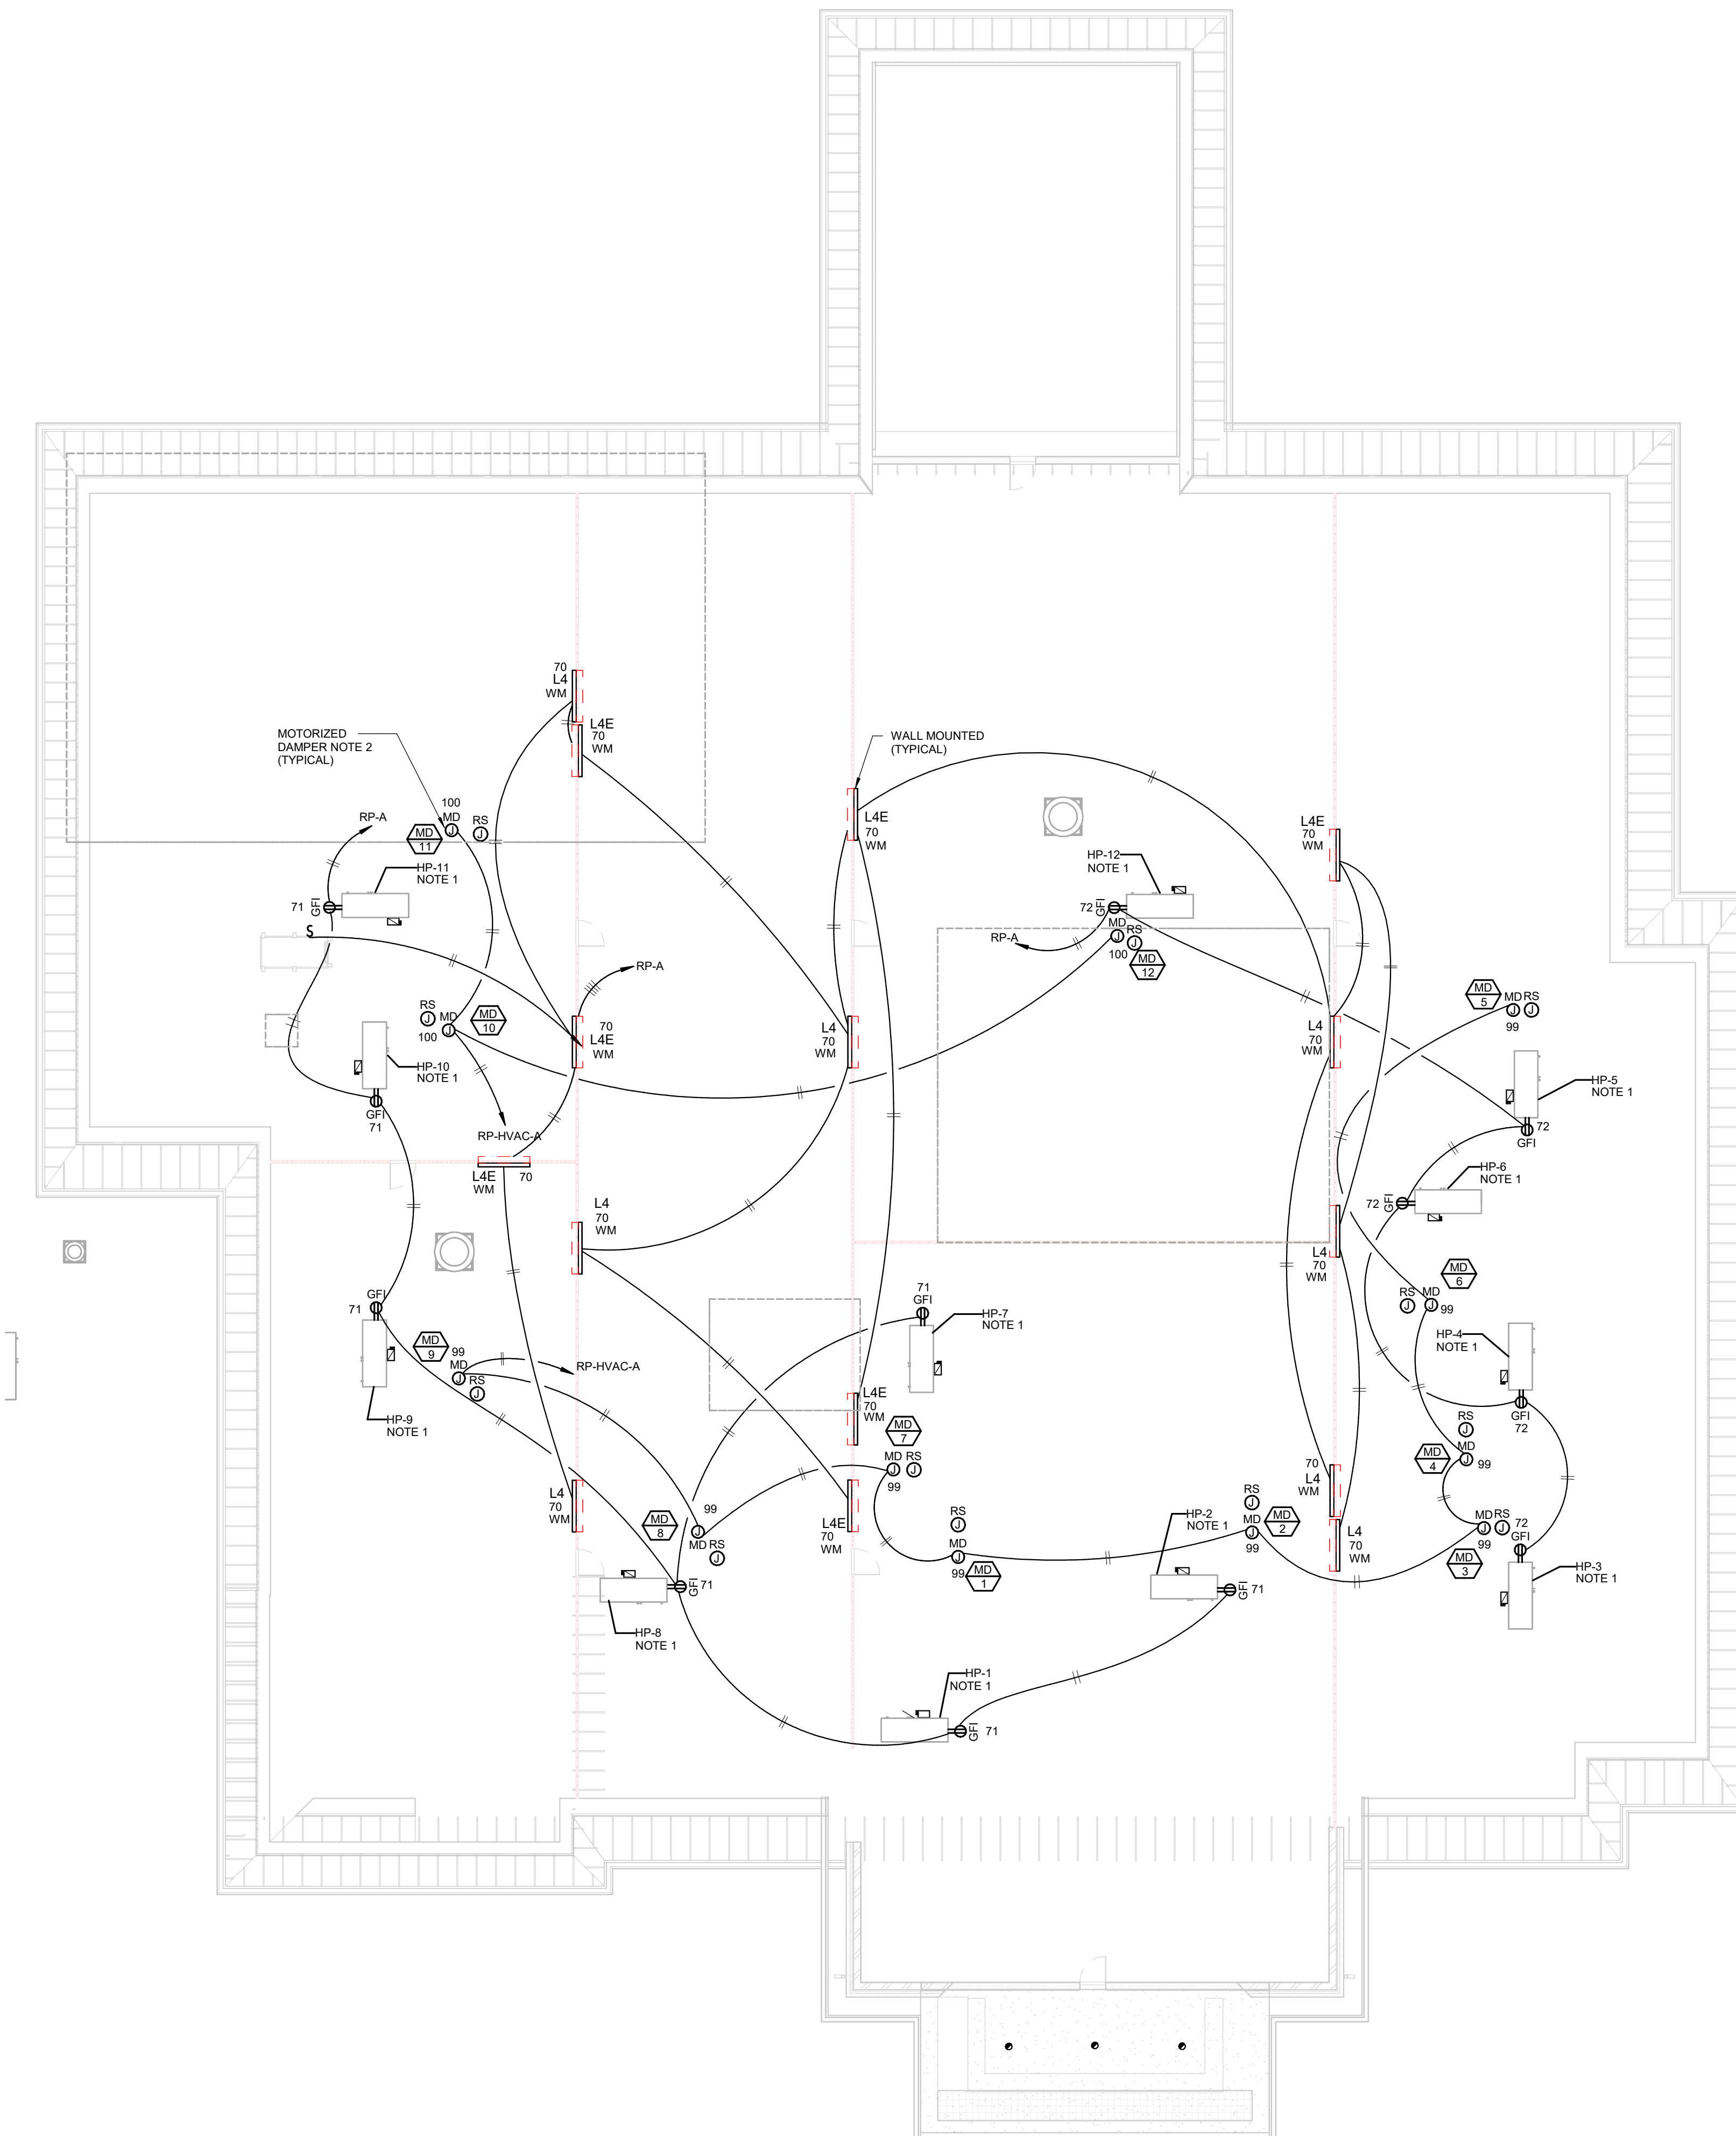

ATTIC PLAN - BASE BID


ELECTRICAL

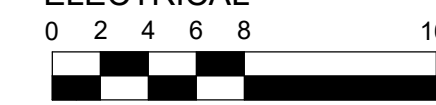


SCALE 1/8" = 1'-0"

NOTES:

1. REFER TO SHEET E00.4 FOR ADDITIONAL ELECTRICAL INFORMATION AND REQUIREMENTS.
2. 120V. MOTORIZED DAMPER TO BE CONNECTED AND CONTROLLED BY LIGHTING CONTROLS. COORDINATE WITH MECHANICAL DRAWINGS, SHEET M3.2 FOR EXACT LOCATION .

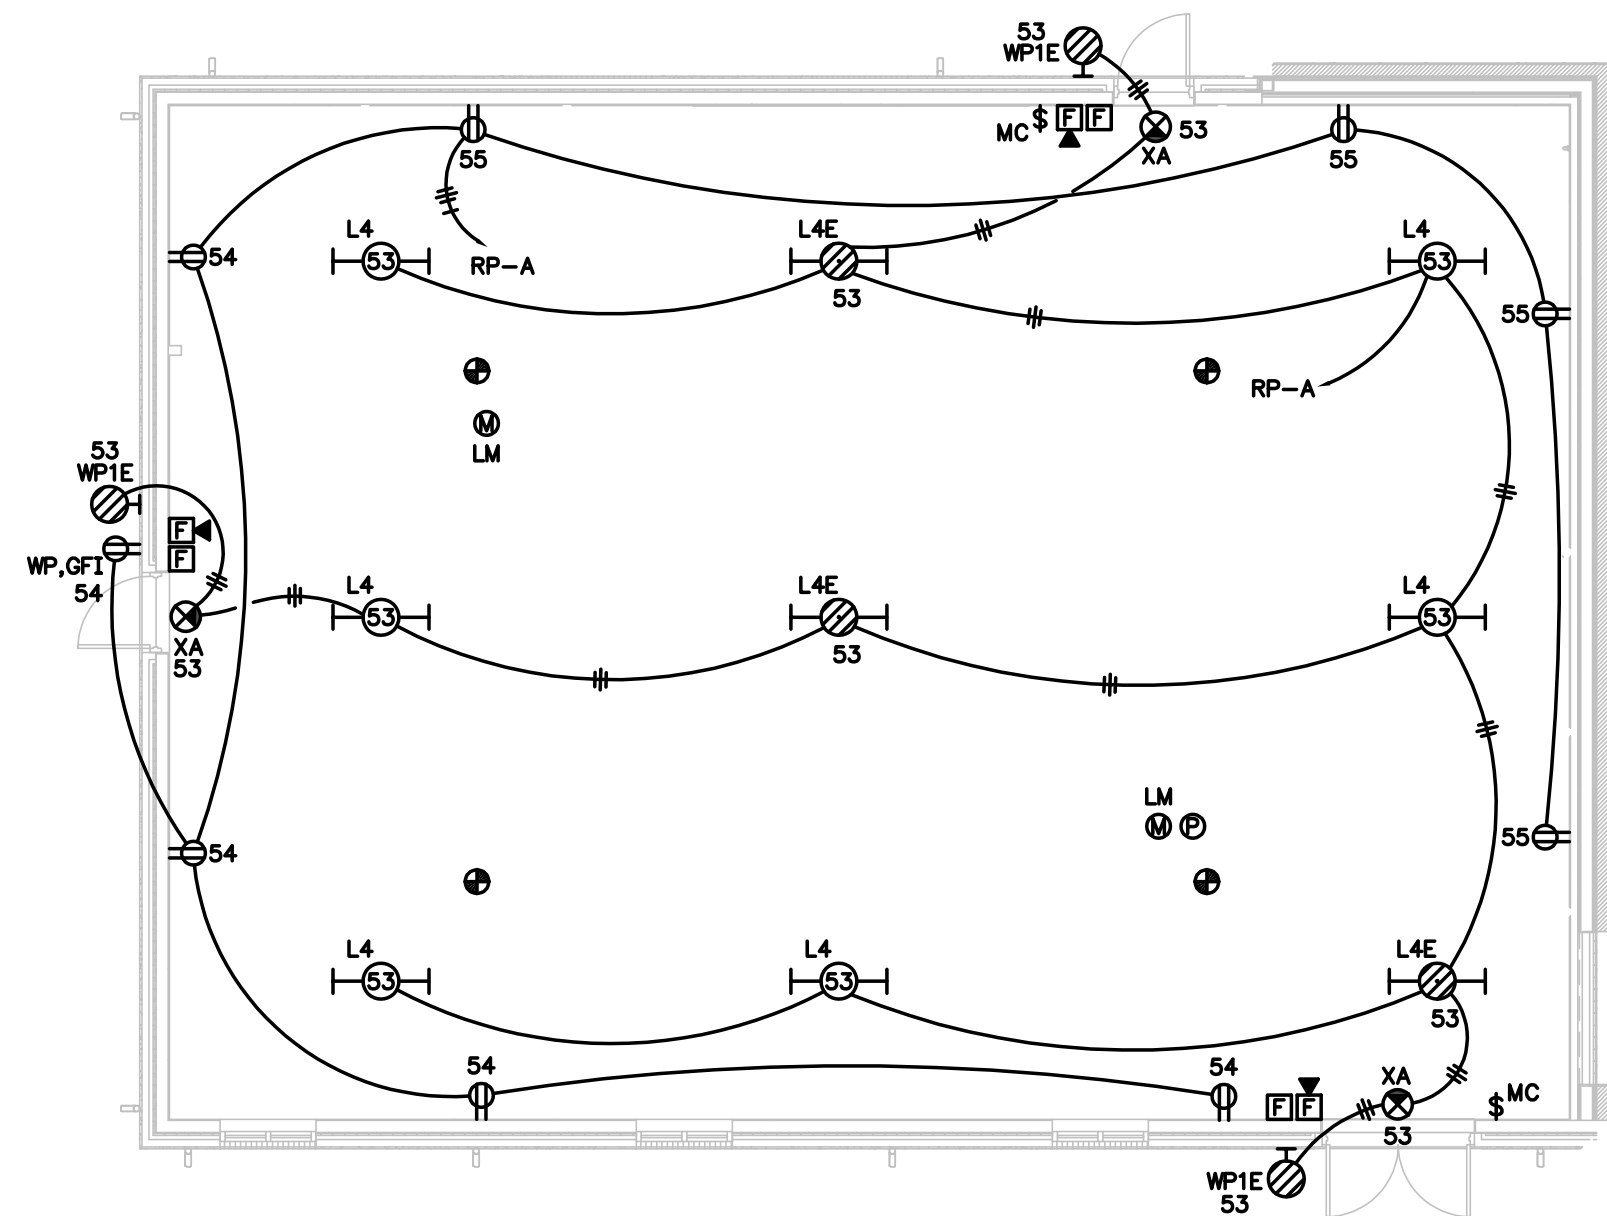


PARTIAL FLOOR PLAN
ELECTRICAL - ALTERNATE COURT ROOM SHELL
SCALE: 1/8" = 1'-0"

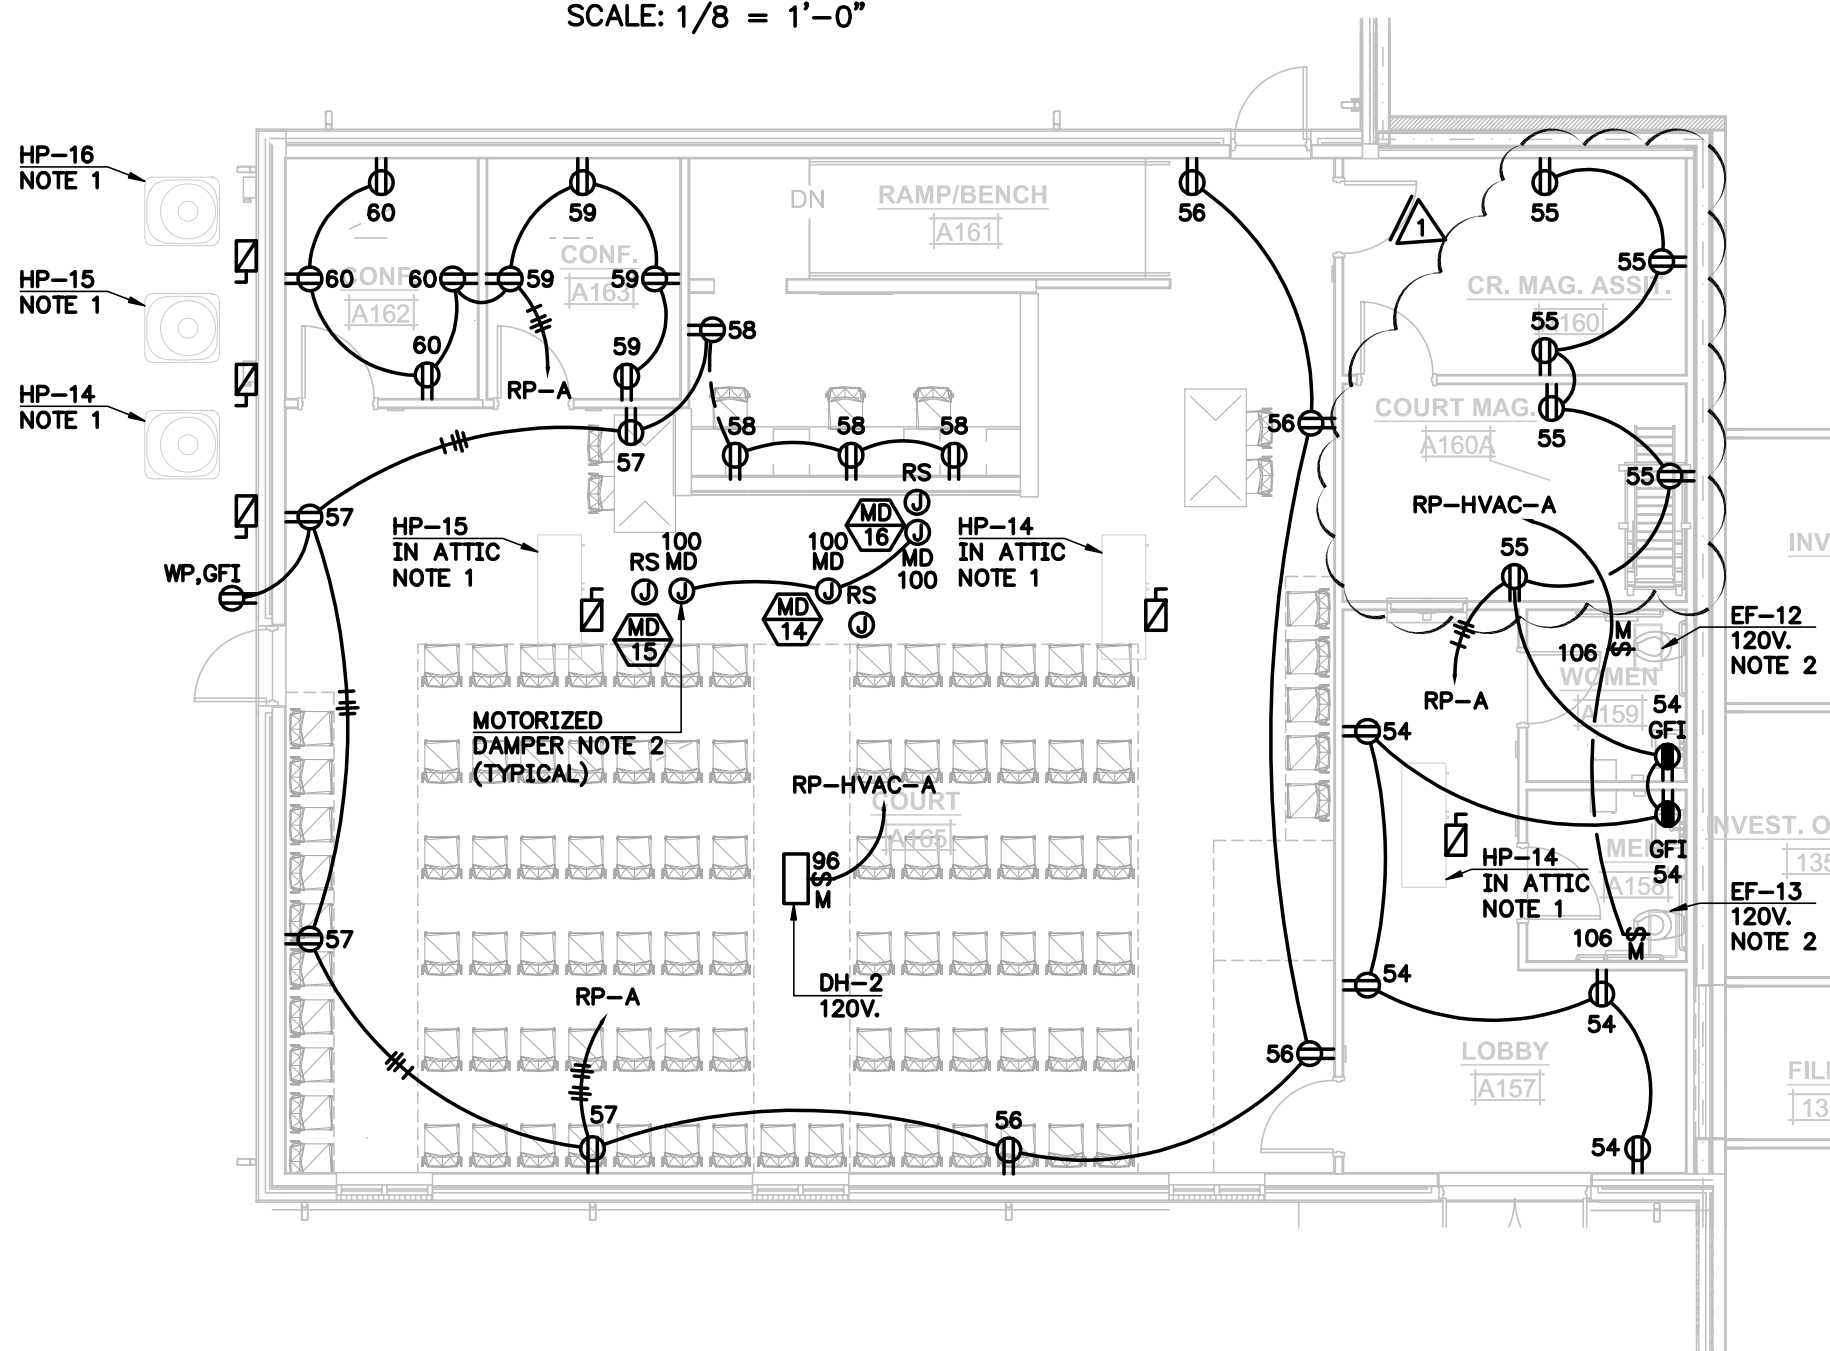


PARTIAL FLOOR PLAN
POWER - ALTERNATE COURT ROOM FULL INTERIOR
SCALE: 1/8" = 1'-0"

- NOTES:
1. REFER TO SHEET E00.4 FOR ADDITIONAL ELECTRICAL INFORMATION AND REQUIREMENTS.
 2. EXHAUST FAN TO BE CONNECTED TO LIGHTING CONTROLS.
 3. 120V. MOTORIZED DAMPER, LOCATED IN ATTIC, TO BE CONNECTED AND CONTROLLED BY LIGHTING CONTROLS. COORDINATE WITH MECHANICAL DRAWINGS, SHEET M3.2 FOR EXACT LOCATION.

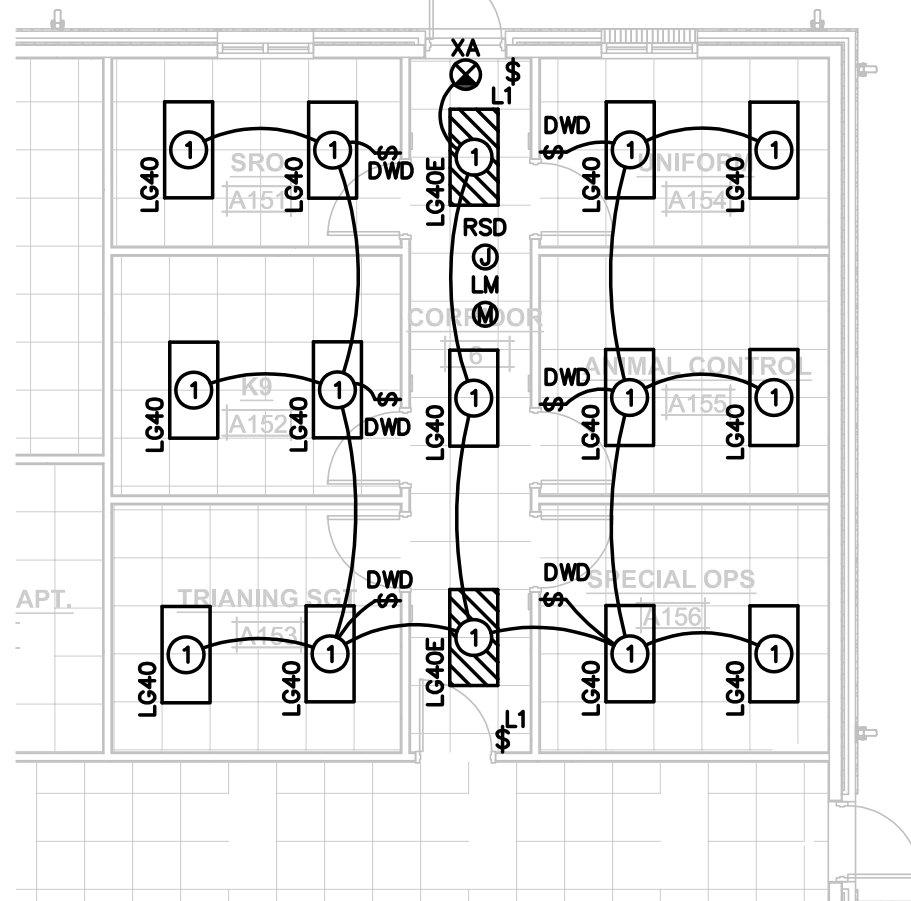

PARTIAL FLOOR PLAN
LIGHTING - ALTERNATE BUILD OUT 6 OFFICES
SCALE: 1/8" = 1'-0"

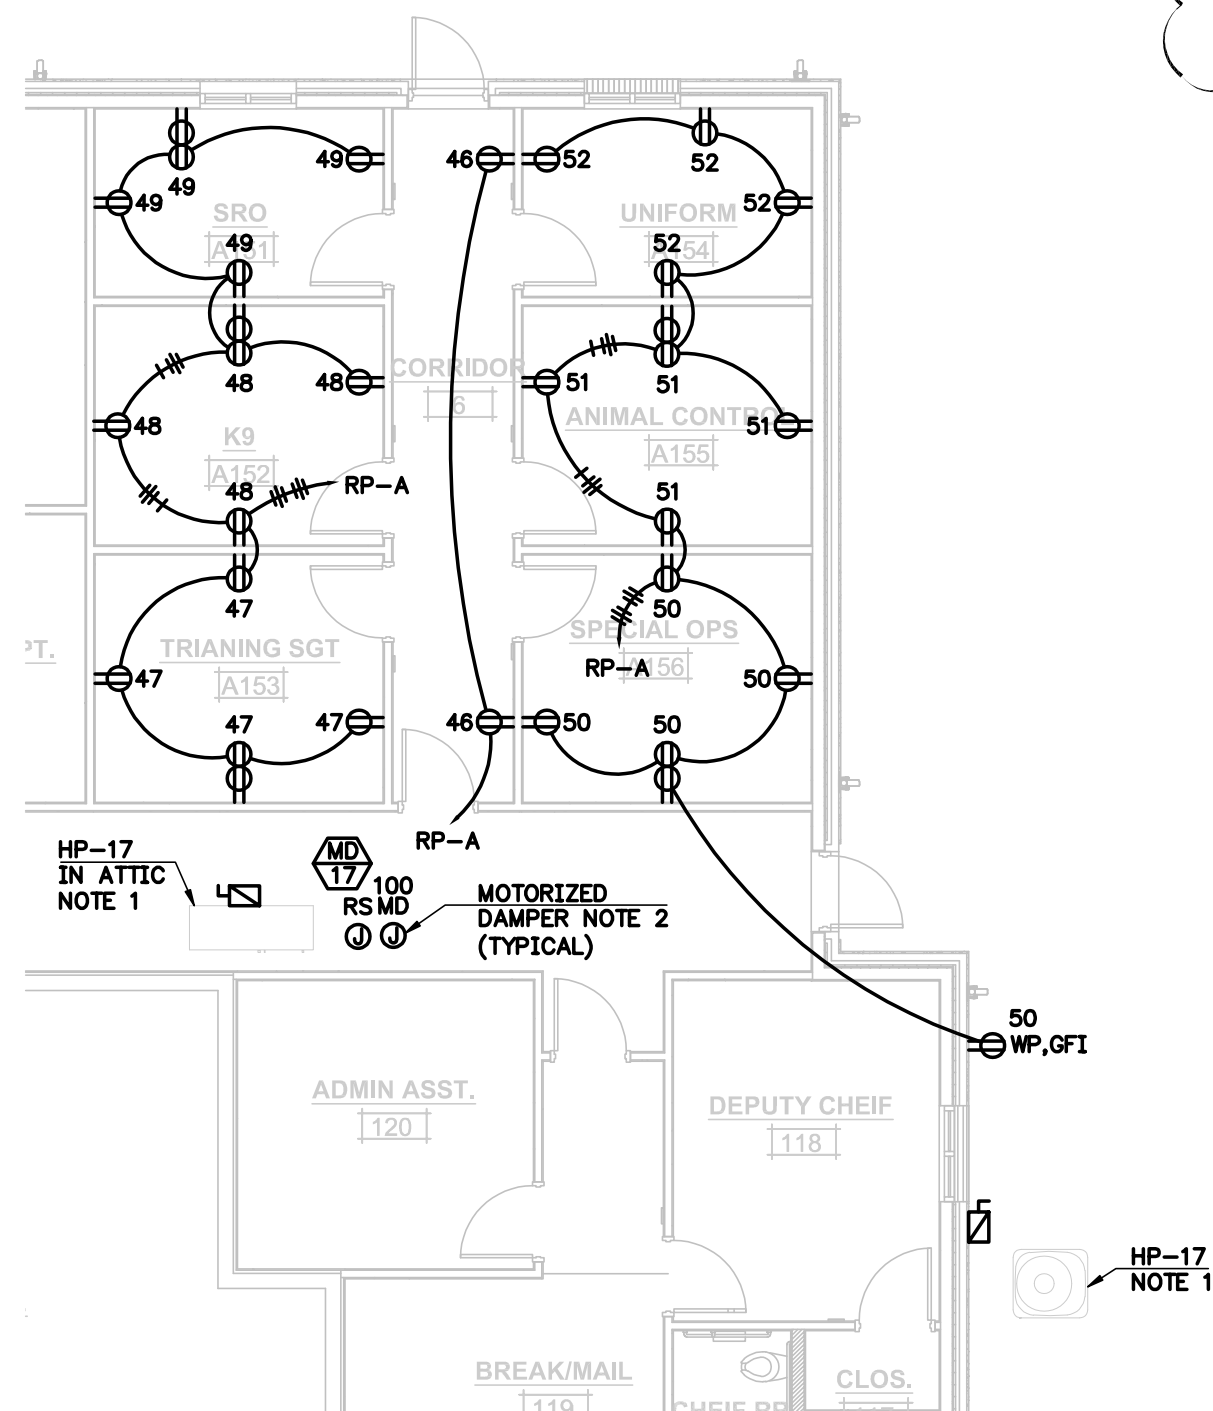



HAYS CHEATWOOD
CONSULTING, INC.
3245 OLD SPRINGVILLE RD
PINSON, ALABAMA 35126
SUITE 201
PHONE 205-942-0606
FAX 205-942-0608
H.C. NO. 24038 - 14010101.DWG
P.16 OF 21.DWG



BILL WHITTAKER, P.C.
ARCHITECTURE
236 MARTIN STREET
ANNISTON, AL 36205
256-689-0238
WWW.BILLWHITTAKER.COM



**NEW CITY OF LINCOLN
POLICE DEPARTMENT
LINCOLN, ALABAMA**



OWNER
City of Lincoln
150 Magnolia St.
Lincoln, AL 35096
205-763-7777
Attn: Lew Watson

ARCHITECT
Bill Whittaker, P.C.
Architecture
236 Martin Street
Anniston, AL 36205
Attn: Bill Whittaker

CIVIL ENGINEER
TTL
10 Inverness Center Pkwy
Suite 350
Hoover, AL 35242
256-441-2232
Attn: Tim Roberts

STRUCTURAL ENGINEER
Barnett, Jones, Wilson
125 18th St N
Prichard, AL 35125
205-884-5334
Attn: Jeremy Deal

MECHANICAL/PLUMBING/FIRE
PROTECTION ENGINEER
Whorton Engineering, Inc.
25 Summerall Gate Road
Anniston, AL 36205
256-620-9897
Attn: Randy Whorton

ELECTRICAL ENGINEER
Hays Cheatwood Consulting
P.O. Box 250
Pinson, AL 35126
205-942-0608
Attn: Tony Dodd



ISSUE:
03.31.25 BID
04.16.25 ADD #2

JOB NO.
24001


DESCRIPTION:
SITE PLAN -
ELECTRICAL

SHEET

E20.0

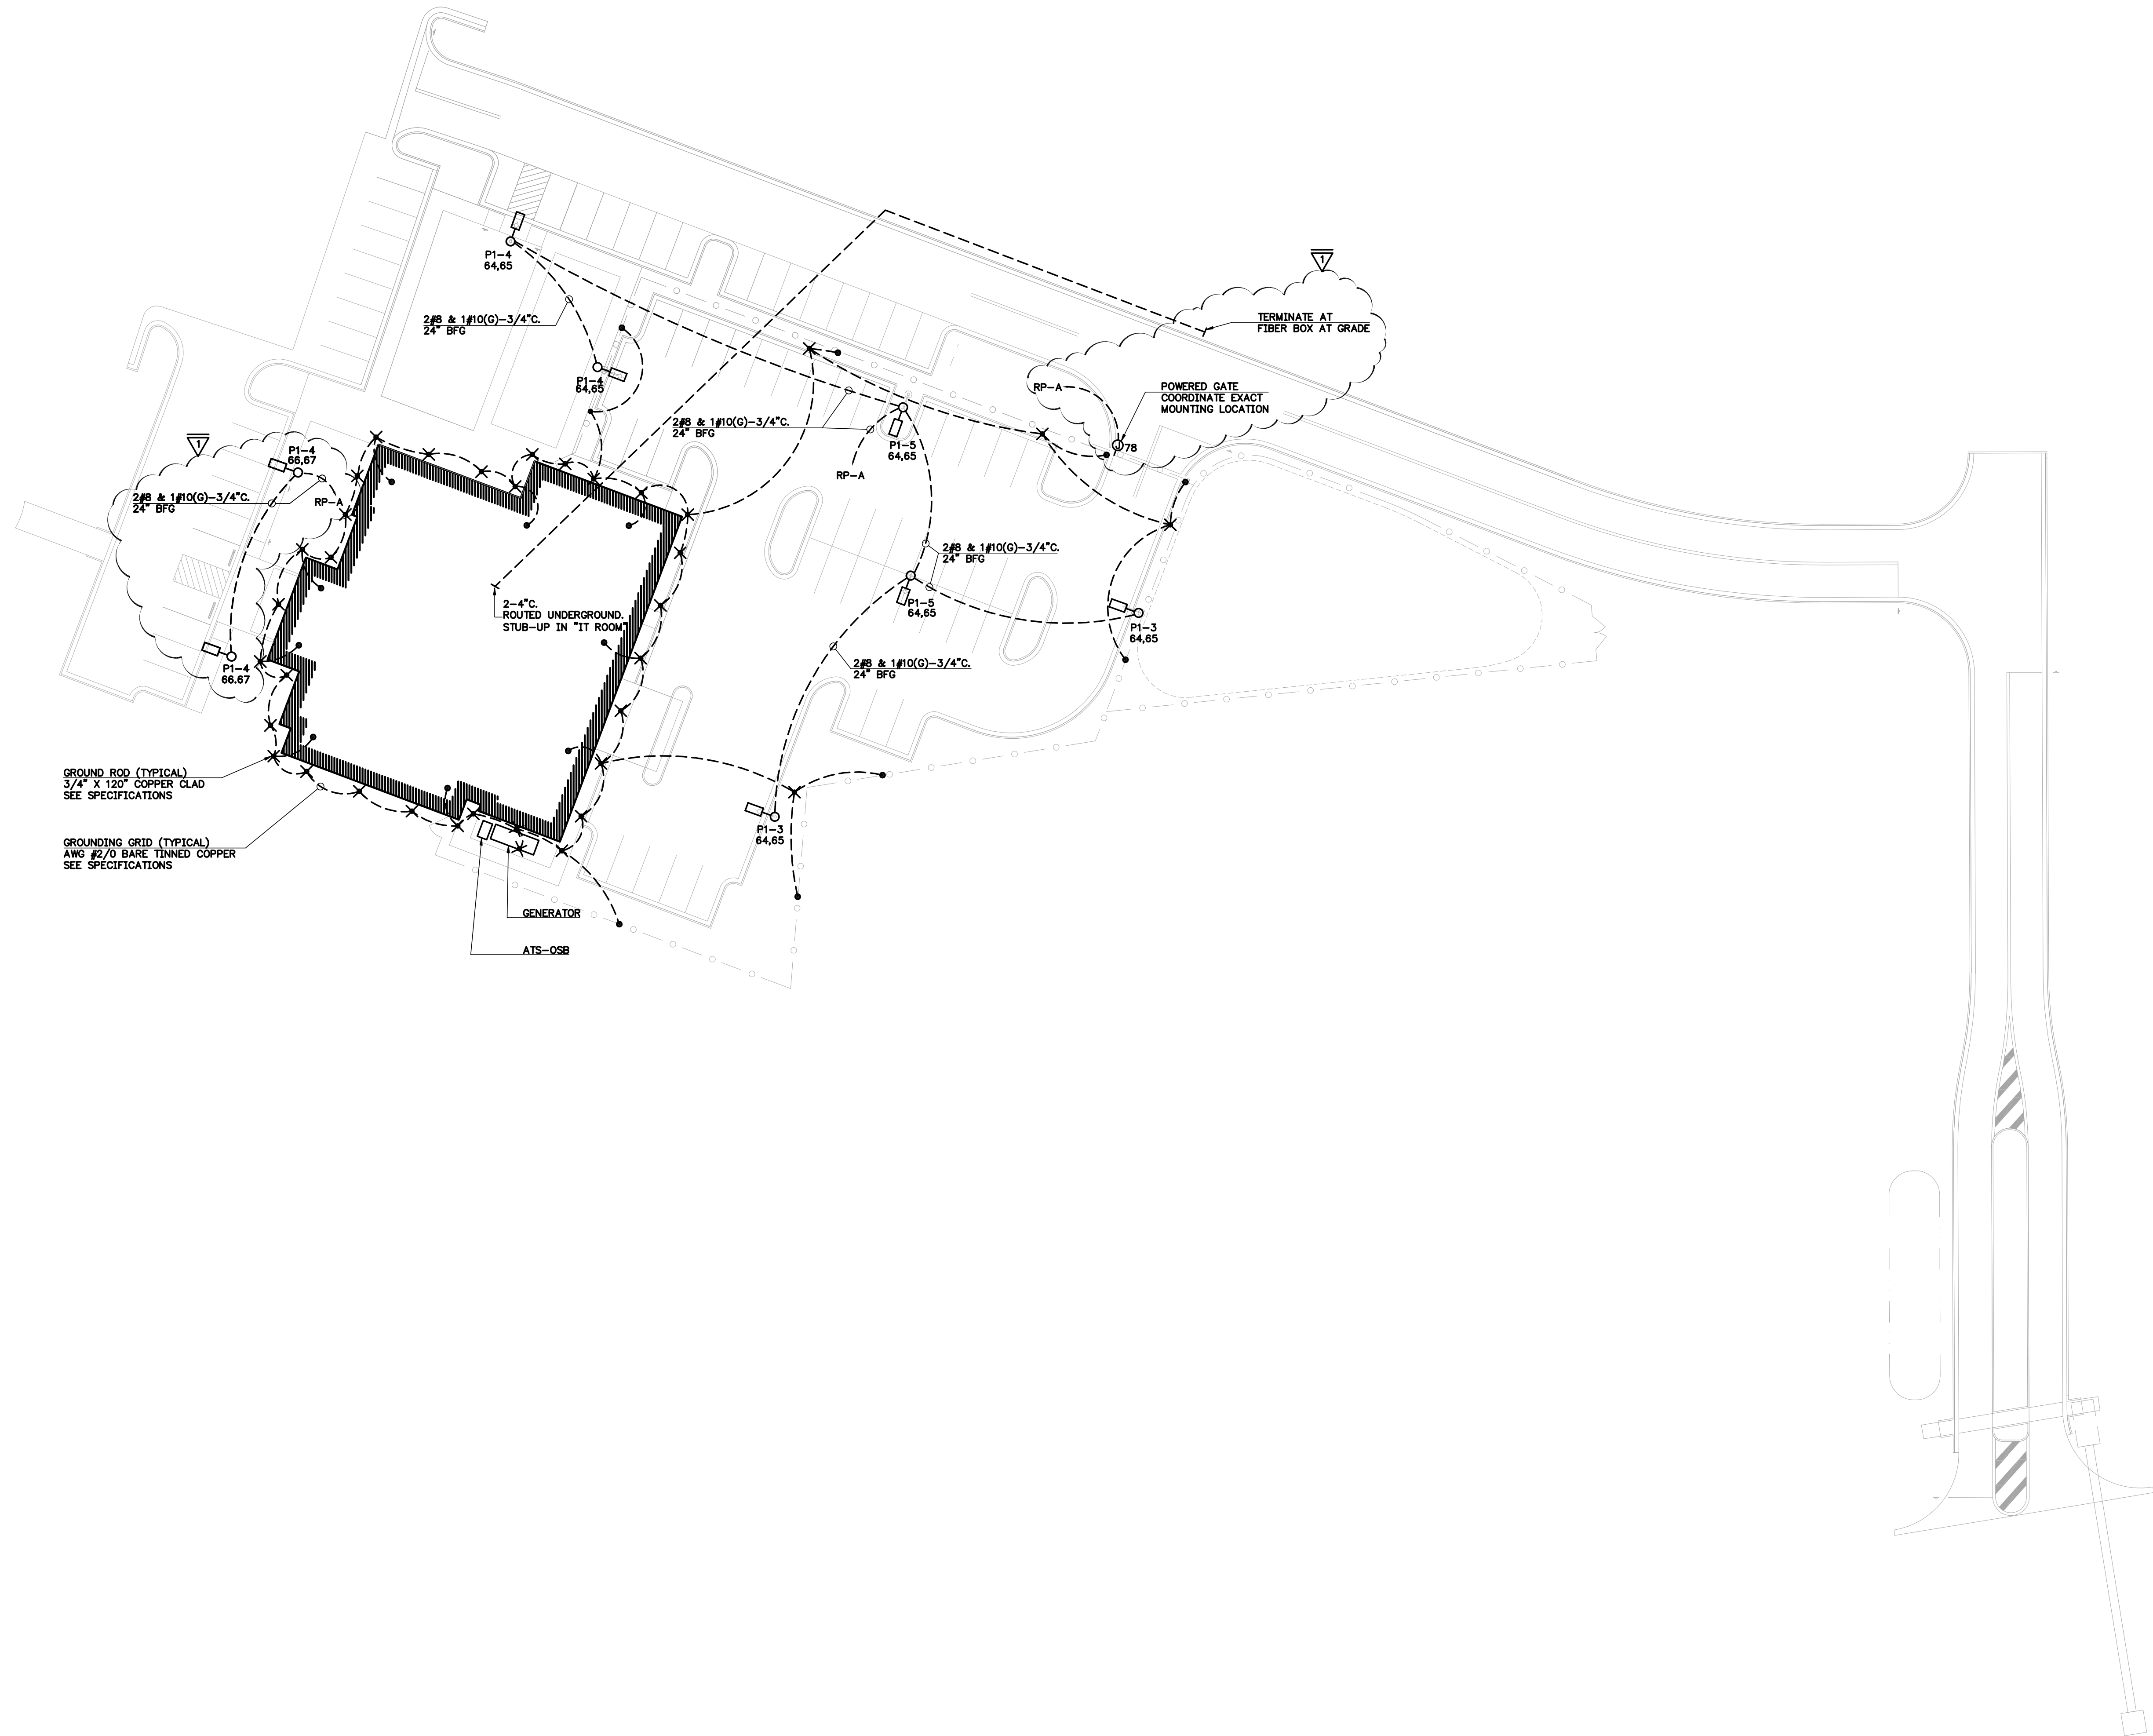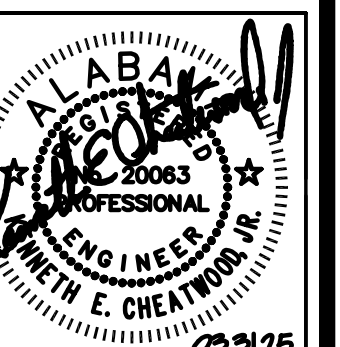

**SITE PLAN - BASE BID
ELECTRICAL**
0 15 30 60
SCALE: 1" = 30'-0"
NOTES:
1. PROVIDE #2 AWG STRANDED TINNED COPPER FROM
CHAIN LINK FENCE POST TO COUNTERPOISE SYSTEM
AS SHOWN.

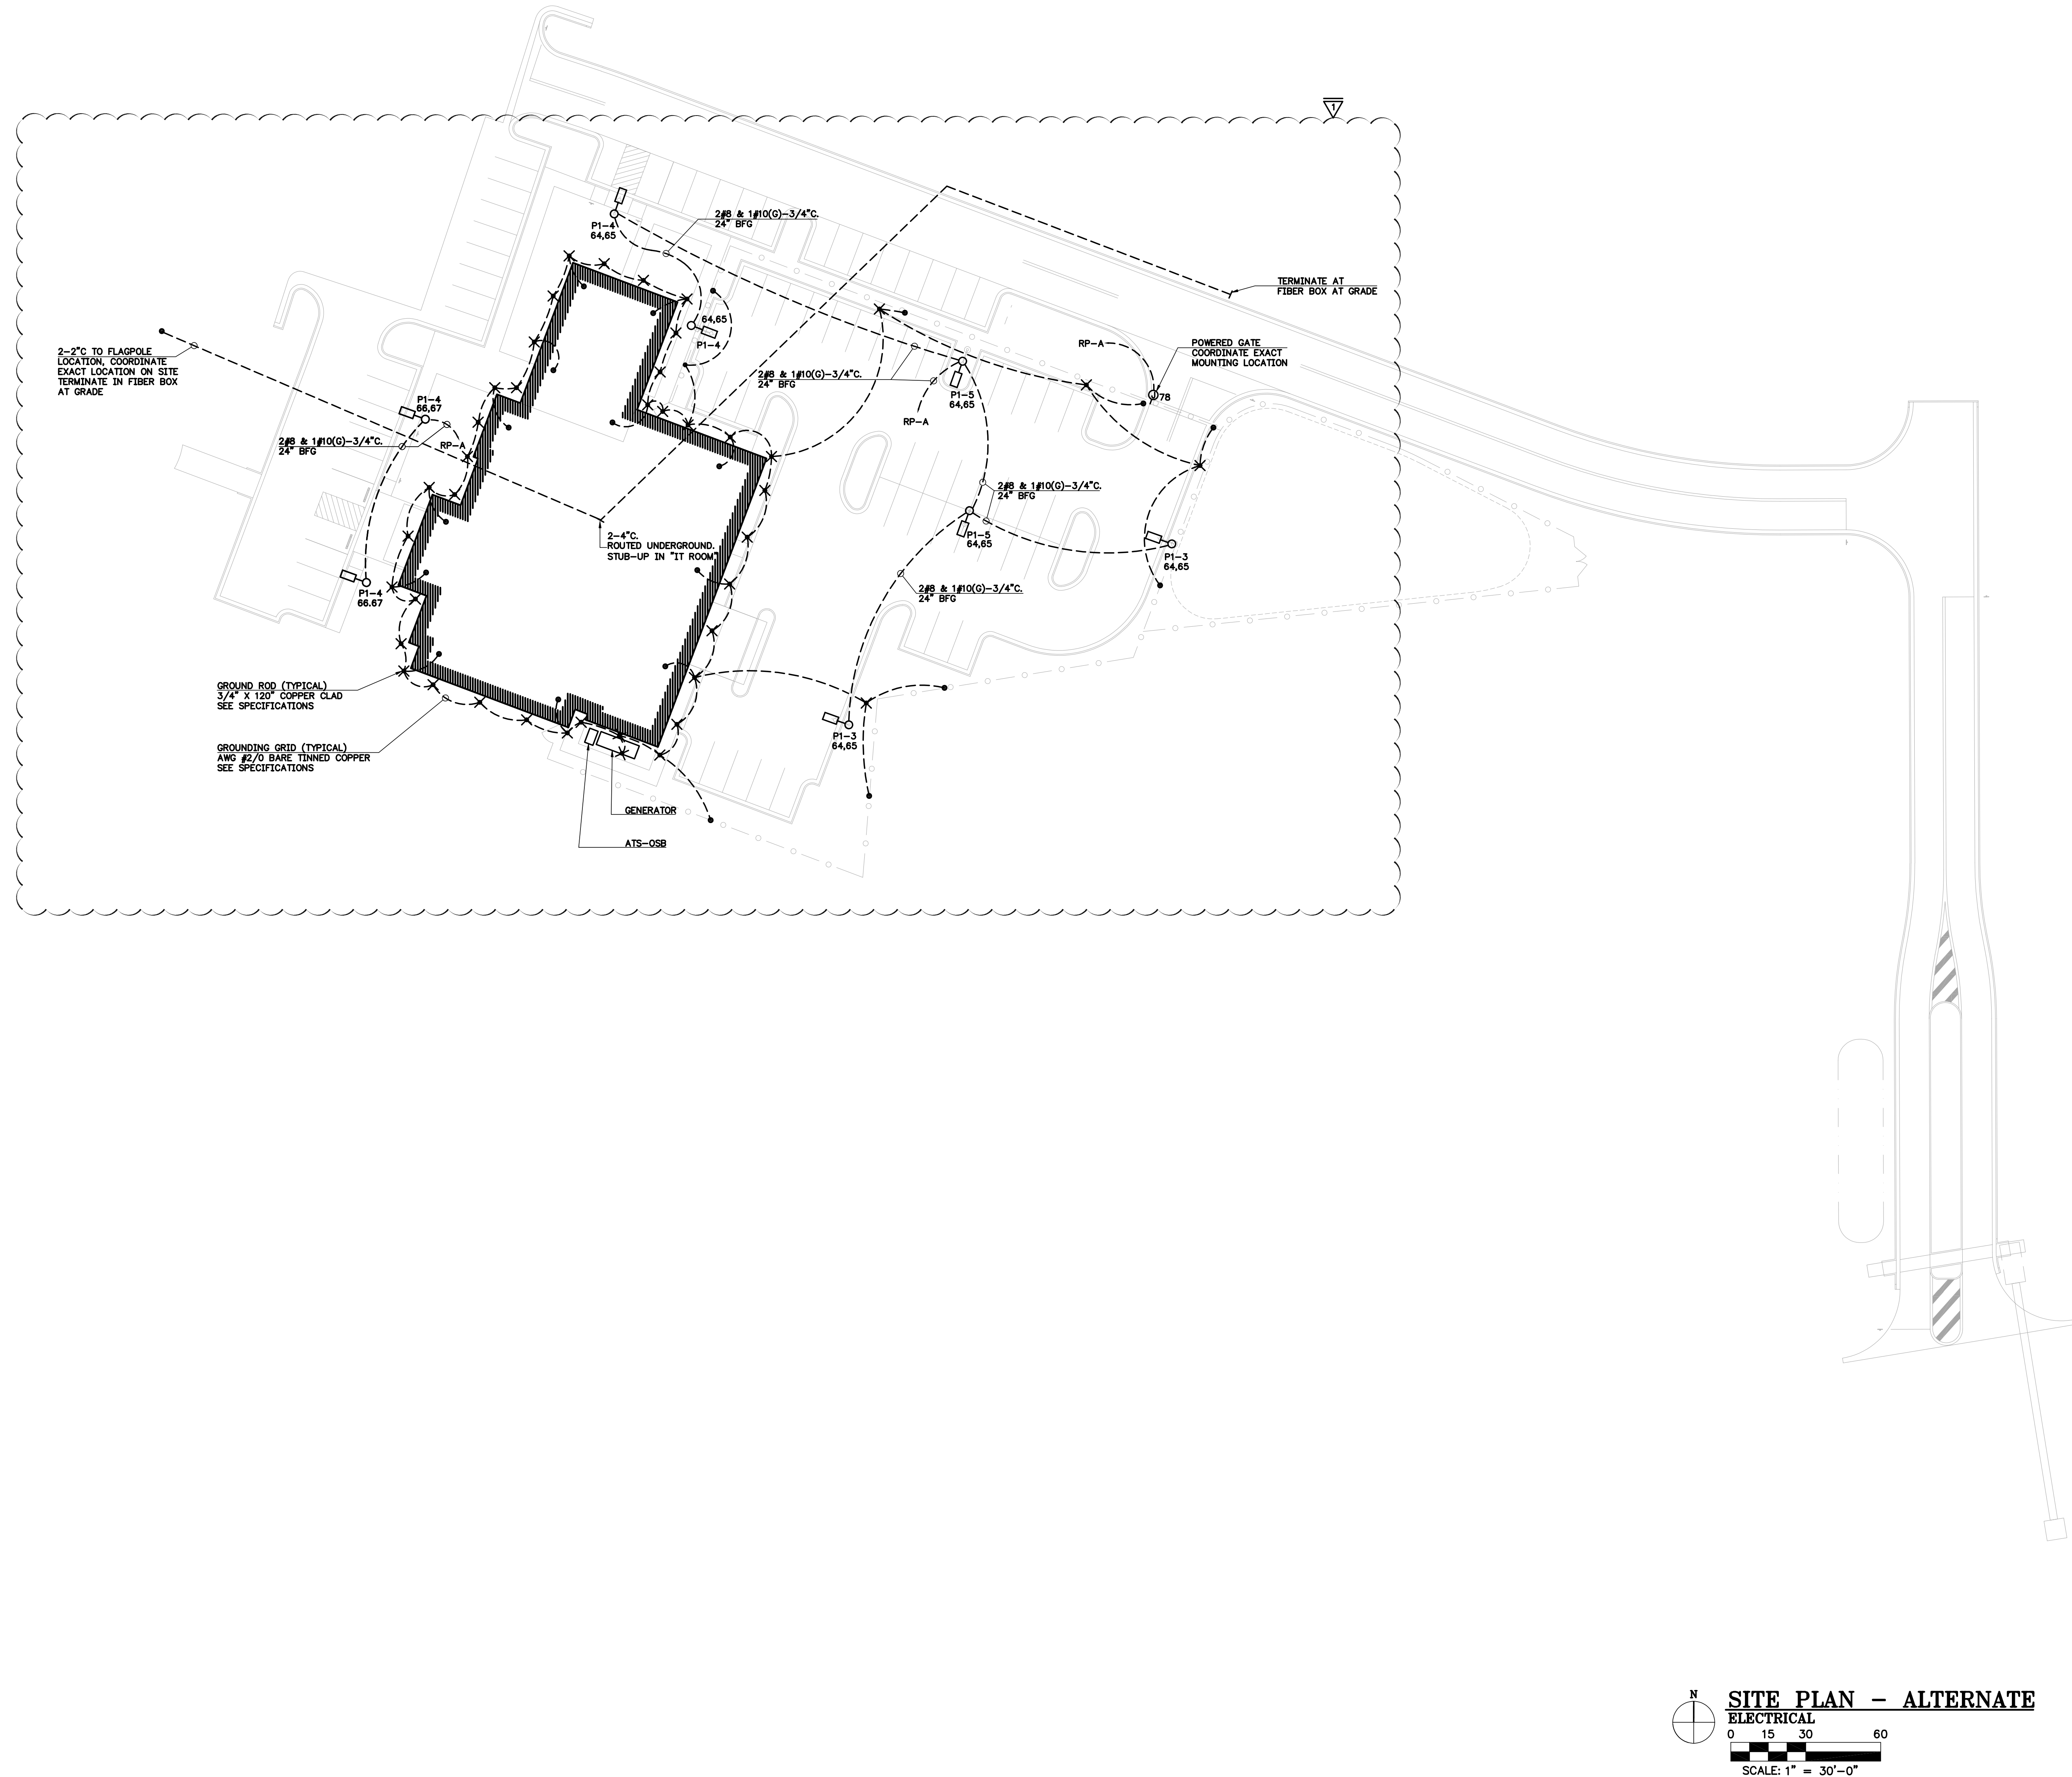

N
SITE PLAN - ALTERNATE
ELECTRICAL
0 15 30 60
SCALE: 1" = 30'-0"