



Founded 1957 ♦ Pearson, Humphries, & Jones Architects

Patrick T. Addison, AIA

Harrell G. Gandy, AIA

Renis Jones III, AIA

Brian J. Klinkhammer, AIA

Steven R. Hall, AIA

ADDENDUM #1


DATED: JULY 15, 2025

**PROJECT: HUXFORD ELEMENTARY SCHOOL GYMNASIUM AND
CLASSROOM ADDITION FOR
ESCAMBIA COUNTY BOARD OF EDUCATION
HUXFORD, ALABAMA**

PH&J No: 2312SC

DCM No: 2023650

PSCA No. 9551

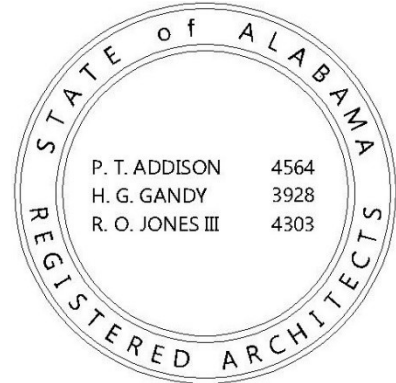

1A-1 GENERAL

This Addendum is hereby made part of the Bid/Contract Documents and as such shall be acknowledged with the Bid. Failure to do so may subject the Bidder to disqualification. The following conditions take precedence over conflicting conditions in the Specifications, on the Drawings, and in any other Supplementary Documents. When a change is called for on a Drawing, this change shall carry through all applicable drawings, including all related architectural, civil, structural, mechanical, plumbing, electrical drawings or other discipline employed by the architect of record. The Bid/Contract Documents are hereby addended in the following:

1A-2 BIDDING REQUIREMENTS (N/A)

1A-3 SPECIFICATIONS

1. **Storm Shelter Door Hardware Installers** (Par 0834.1.4.C.1): Add the following:

“Note: Hardware installers for the Storm Shelter Doors shall be trained and qualified by the manufacturer. Submit qualifications.”

2. **Storm Shelter Door Hardware Installers** (Par 0870.A.2): Add the following to the Scope:

“Note: Hardware installers for the Storm Shelter Doors shall be trained and qualified by the manufacturer.”

3. **Shelter First Aid Kit** (Par 1000B.9): Add the following paragraph:

9. **Shelter First Aid Kit**: Provide seven (7) Class A first aid kits equal to First Aid Product.com Model Number URG-249L. Units shall be mounted on a wall as directed by the Owner inside the Shelter Area.

1A-4 DRAWINGS

1. **Life Safety Plan** (Sheet LS1.1): Substitute revised Life Safety Plan and Code Study, Sheet LS1.1 enclosed as **Attachment No. 1** for the sheet bound in the Drawings.
2. **Stage Details** (Sheet A8.1): Substitute revised Stage Details, Sheet A8.1 enclosed as **Attachment No. 2** for the sheet bound in the Drawings.

MECHANICAL
NA



ELECTRICAL

1. **Electrical Revisions** (See Revised Sheets E0.1, E1.2, E2.1, E2.2, E3.1, E3.3, E3.4, E4.1, E4.2, E5.2, and E7.1): Substitute the revised sheets listed and enclosed as **Attachment No. 3** for the sheets bound in the Drawings.

A-5 ATTACHMENTS


Attachment No. 1	Sheet LS1.1
Attachment No. 2	Sheet A8.1
Attachment No. 3	Electrical Drawings E0.1, E1.2, E2.1, E2.2, E3.1, E3.3, E3.4, E4.1, E4.2, E5.2, and E7.1

End of Addendum

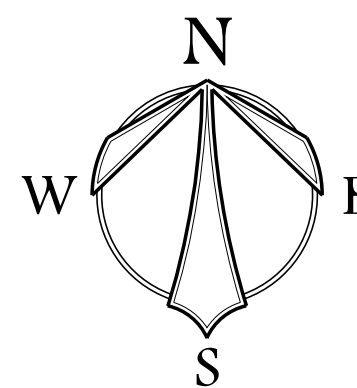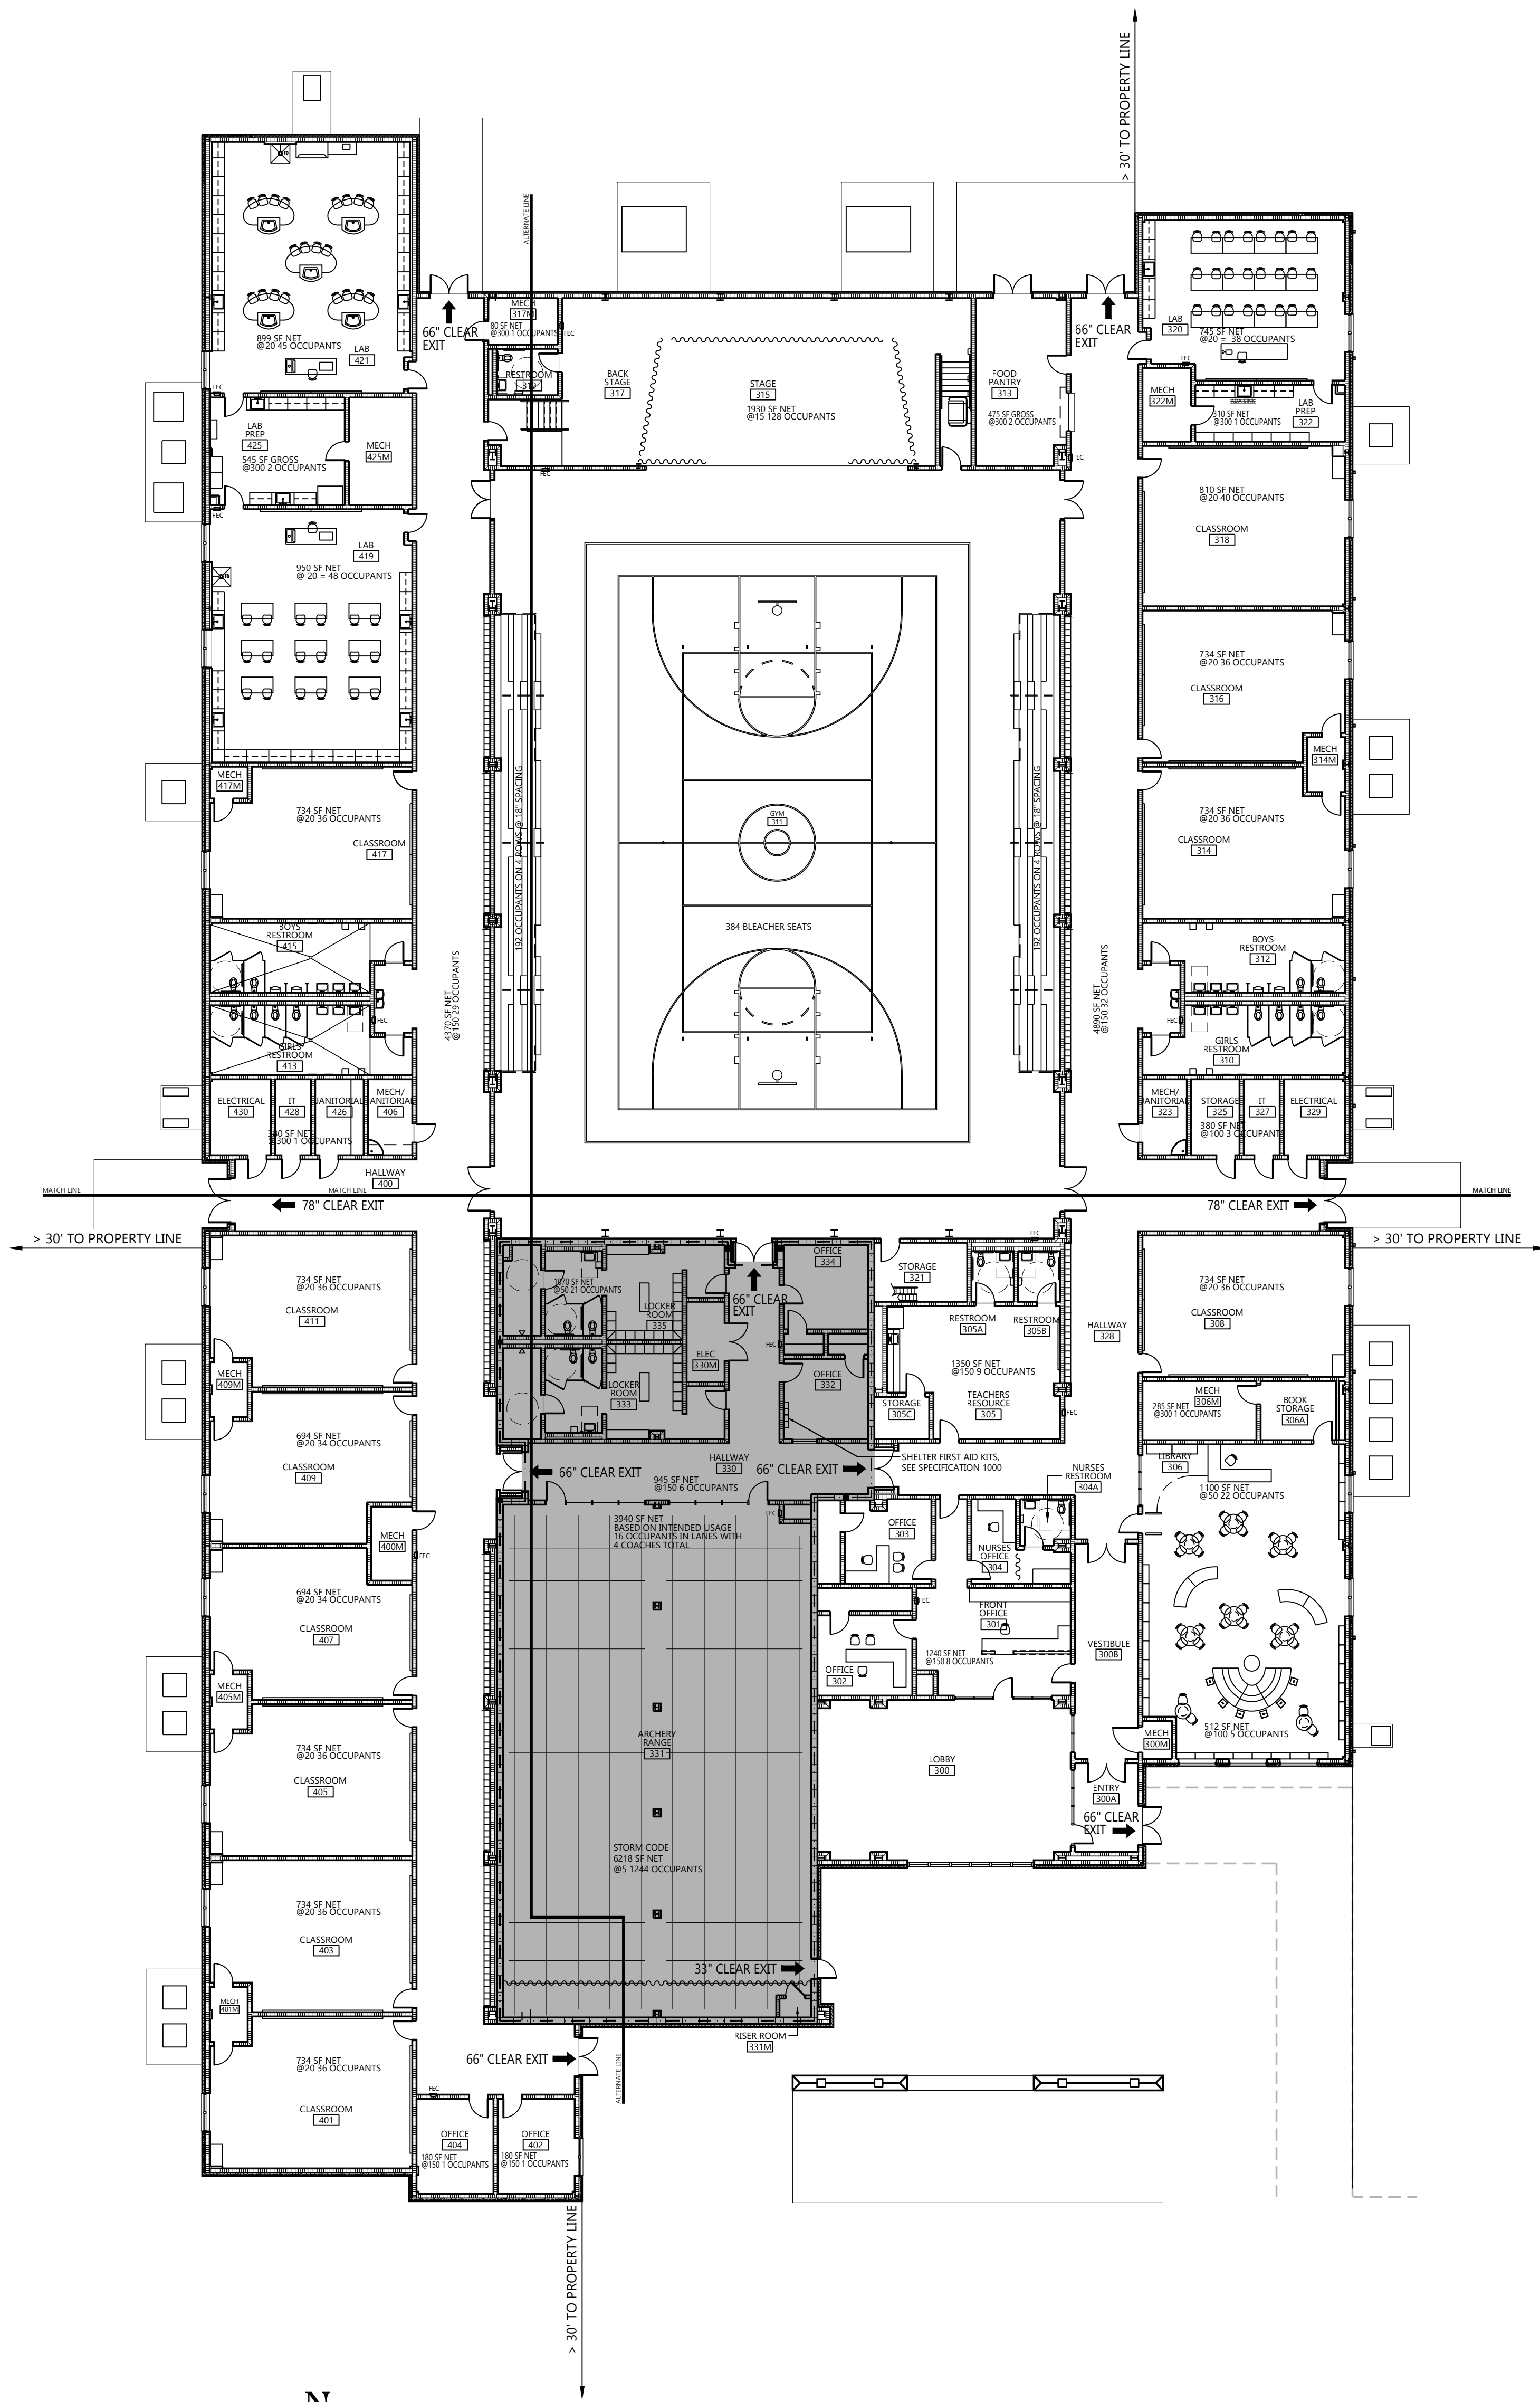

FLOOR PLAN

SCALE: 1/16" = 1'-0"

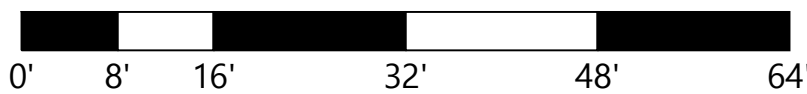

PLAN LEGEND

LIFE SAFETY TEXT - THIS INFORMATION IS PROVIDED FOR CODE PURPOSES ONLY AND IS NOT FOR CONSTRUCTION USE.

FIRE EXTINGUISHER CABINET



ELECTRIC WATER COOLER

EWC


PRIMARY EGRESS ROUTE



EGRESS WIDTH

78" CLEAR EXIT

2 HR WALL ASSEMBLY

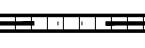

CODE STUDY

CODES USED:

IBC 2021
IPC 2021
IMC 2021
NEC 2020
ADA 2010 STANDARDS

CHAPTER 3 - OCCUPANCY

303.4 OCCUPANCY: EDUCATION (E), ASSEMBLY (A-4), BUSINESS (B), AND STORAGE (S-2)

CHAPTER 5 - BUILDING HEIGHT AND AREA

TABLE 504.3 AND 504.4: ALLOWABLE BUILDING HEIGHTS TYPE IIB, SPRINKLERED
EDUCATION = 75', 3 STORY
MEAN ROOF HEIGHT OF BUILDING: 24'-6" & ONE(1) STORY

TABLE 506.2 ALLOWABLE AREA TYPE IIB, SPRINKLERED
EDUCATION = 58,000 SF

ACTUAL BUILDING AREA = 49,858 SF

SECTION 508 MIXED USE OCCUPANCY

508.3 NONSEPARATED USES

508.3.2 ALLOWABLE HEIGHT AND AREA SHALL BE BASED ON EDUCATION

MAXIMUM ALLOWABLE HEIGHT = 75' AND 3 STORY
MAXIMUM ALLOWABLE AREA = 58,000 SF

CHAPTER 6 - CONSTRUCTION TYPES

TABLE 601 - FIRE RESISTANCE RATING OF STRUCTURAL ELEMENTS

CONSTRUCTION TYPE: IIB

PRIMARY FRAME 0 HR
BEARING EXTERIOR WALLS 0 HR
BEARING INTERIOR WALLS 0 HR
NON BEARING EXTERIOR WALLS SECTION 602
NON BEARING INTERIOR WALLS 0 HR
FLOOR CONSTRUCTION 0 HR
ROOF CONSTRUCTION 0 HR

CHAPTER 7 - FIRE & SMOKE PROTECTION

TABLE 705.8 MAXIMUM AREA OF OPENINGS
DISTANCE DEGREE OF OPENING ALLOWABLE AREA
30' ≤ UP/S NO LIMIT

TABLE 706.4 FIRE WALL FIRE RESISTANCE

OCCUPANCY RATING
E 3 HR

SECTION 713 SHAFT ENCLOSURES

713.4 FIRE RESISTANCE RATING

SHAFT ENCLOSURES SHALL HAVE A FIRE RESISTANCE RATING OF NOT LESS THAN 1 HOUR WHERE CONNECTING LESS THAN FOUR STORIES.

TABLE 716.5 OPENING PROTECTION ASSEMBLIES: N/A

SECTION 720.2 CONCEALED INSULATION: FLAME SPREAD < 25 AND SMOKE DEVELOPMENT < 450.

SHELTER CODE STUDY

ICC 500-2020

SECTION 104.1 STORM SHELTER WITHIN HOST BUILDING

THE FACILITY IS DESIGNED TO BE OCCUPIED BY OTHER PURPOSES EXCEPT DURING A STORM

SECTION 106.2 INFORMATION REQUIRED

-COMMUNITY TORNADO SHELTER

-BUILDING OCCUPANTS ONLY

-DESIGN CONFORMS TO THE ICC 500 STANDARD FOR THE DESIGN AND CONSTRUCTION OF STORM SHELTERS, 2020

-SHELTER DESIGN WIND SPEED IS 200MPH

-WIND EXPOSURE CATEGORY IS "C"

*-INTERNAL PRESSURE COEFFICIENT = +/- 0.55

*-TOPOGRAPHICAL FACTOR = 1.0

*-DIRECTIONALITY FACTOR = 1.0

-SHELTER IS NOT LOCATED IN AN AREA SUSCEPTIBLE TO FLOODING

-SEE ARCHITECTURAL PLANS AND DETAILS FOR SHELTER LOCATION

-SHELTER IS DESIGNED FOR THE 253 OCCUPANTS OF THE BUILDING

-USABLE FLOOR AREA IS = 3969 (5523) SQFT

*-VENTING AREA, NOT REQUIRED SINCE USING +/- 0.55 FOR INTERNAL PRESSURE

-SEE STRUCTURAL PLANS AND DETAILS FOR FOUNDATION AND ANCHORING DETAILS

SECTION 504 EGRESS

6218 SQFT @ 5 NET = 1244 PERSONS

THE CAPACITY, IN INCHES, OF MEANS OF EGRESS COMPONENTS

OTHER THAN STAIRWAYS SHALL BE CALCULATED BY MULTIPLYING

THE OCCUPANT LOAD OF 1244 BY A MEANS OF EGRESS CAPACITY

FACTOR OF 0.2 INCH PER OCCUPANT = 248.8" REQUIRED; 267" PROVIDED

SECTION 702 TORNADO SHELTERS WATER CLOSET

COMMUNITY, DESIGN OCCUPANT CAPACITY ≥50:

WATER CLOSET: 1 PER 250 FOR FIRST 500, 1 PER 500 AFTER: 4 REQUIRED & 4 PROVIDED

LAVATORIES- 1 PER 1000, 1 REQUIRED & 2 PROVIDED

CHAPTER 8 - INTERIOR FINISHES

TABLE 803.13 - SPRINKLERED

OCCUPANCY	EXITS	CORRIDOR	ROOMS
EDUCATION	B	C	C
ASSEMBLY A-4	B	B	C
BUSINESS	B	C	C
STORAGE	B	C	C

CHAPTER 9 - FIRE PROTECTION SYSTEMS

FIGURE 903.2 OCCUPANCY RELATED SPRINKLER THRESHOLD

OCCUPANCY THRESHOLD EXCEPTION

E SPRINKLERS REQUIRED NONE

REQUIRED TO HAVE AN AUTOMATIC SPRINKLER SYSTEM

SECTION 906 PORTABLE FIRE EXTINGUISHERS

PORTABLE FIRE EXTINGUISHERS SHALL BE LOCATED PER IFC.

SECTION 907 MANUAL FIRE ALARM - ARE REQUIRED PER FIGURE 907.2

OCCUPANCY THRESHOLD

E OCCUPANTS > 50

OCCUPANT LOAD: 1320 > 50

TABLE 1004.1.1 MAXIMUM FLOOR ALLOWANCES PER OCCUPANT

EDUCATION	9140 SF @ 20 GROSS	= 457 PERSONS
ASSEMBLY W/O FIXED SEATS	4947 SF @ 50 GROSS	= 99 PERSONS
BUSINESS	13155 @ 150 GROSS	= 87 PERSONS
EXERCISE AREA	1070 SF @ 50 GROSS	= 21 PERSONS
STORAGE AREA	3940 SF @ PURPOSE	= 20 PERSONS
TOTAL OCCUPANT LOAD:	2375 SF @ 300 GROSS	= 8 PERSONS
		= 1076 PERSONS

SECTION 1005.3.2 OTHER EGRESS COMPONENTS

THE CAPACITY, IN INCHES, OF MEANS OF EGRESS COMPONENTS OTHER THAN STAIRWAYS SHALL BE CALCULATED BY MULTIPLYING THE OCCUPANT LOAD OF 1320 BY A MEANS OF EGRESS CAPACITY FACTOR OF 0.2 INCH PER OCCUPANT = 264" REQUIRED; 288" PROVIDED

TABLE 1017.2 EXIT ACCESS TRAVEL DISTANCE MEASUREMENT

OCCUPANCY DISTANCE WITH SPRINKLERS

E 250'

TABLE 1020.2 CORRIDOR FIRE-RESISTANCE RATING

OCCUPANCY CORRIDOR LOAD REQUIRED FIRE RATING (HRS)

E X > 30 0 (W/ SPRINKLERS)

SECTION 1020.5 DEAD ENDS W/ SPRINKLERS SHALL NOT BE GREATER THAN 50'.

2902.1 MINIMUM NUMBER OF REQUIRED PLUMBING FIXTURES

EDUCATION (E) = 556 PERSONS (278 PER SEX)

MALE W/C 1:50 = 5.56

FEMALE W/C 1:50 = 5.56

LAVS 1:50 = 11.12

EWC 1:100 = 5.56

ASSEMBLY (A-3) = 384 PERSONS (192 PER SEX)

MALE W/C 1:125 = 1.6

FEMALE W/C 1:65 = 2.96

LAVS 1:200 = 1.92

EWC 1:500 = .768

BUSINESS (B) = 87 PERSONS (44 PER SEX)

MALE W/C 1:125 = .35

FEMALE W/C 1:65 = .68

LAVS 1:200 = .44

EWC 1:500 = .17

EXERCISE (EX) = 41 PERSONS (21 PER SEX)

MALE W/C 1:125 = .17

FEMALE W/C 1:65 = .32

LAVS 1:200 = .21

EWC 1:500 = .08

STORAGE (S-1) = 8 PERSONS

W/C 1:100 = .08

LAVS 1:100 = .08

EWC 1:1000 = .00


TOTAL W/C = 20.06 ∴ 17 REQUIRED & 24 PROVIDED

TOTAL LAVS = 14.99 ∴ 14 REQUIRED & 18 PROVIDED

TOTAL EWCs = 7.07 ∴ 7 REQUIRED & 2 PROVIDED (HI/LOW UNIT)

1 SERVICE SINK REQUIRED & PROVIDED

HUXFORD ELEMENTARY SCHOOL
GYMNASIUM AND CLASSROOM ADDITION
FOR
ESCAMBIA COUNTY BOARD OF EDUCATION
BREWTON, ALABAMA

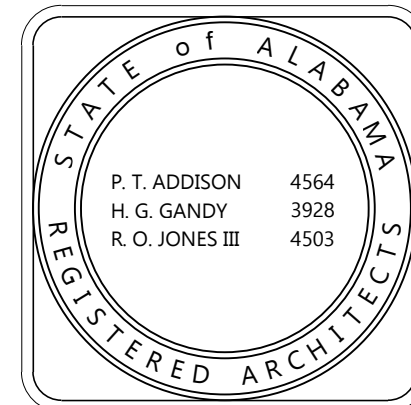

DRAWN: CW/RTS CHECK: HG
DATE: 06/18/2025
REVISED: 07/15/2025
REVISED:

SHEET TITLE
LIFE SAFETY
PLAN


JOB NO.: PHJ # 2312SC
DCMR 2023650
PSCAB 95511

SEQUENCE
NO. 14 OF 124


LS1.1

© PH&J ARCHITECTS, INC.
ALL RIGHTS RESERVED


ADDENDUM 1
ATTACHMENT 1

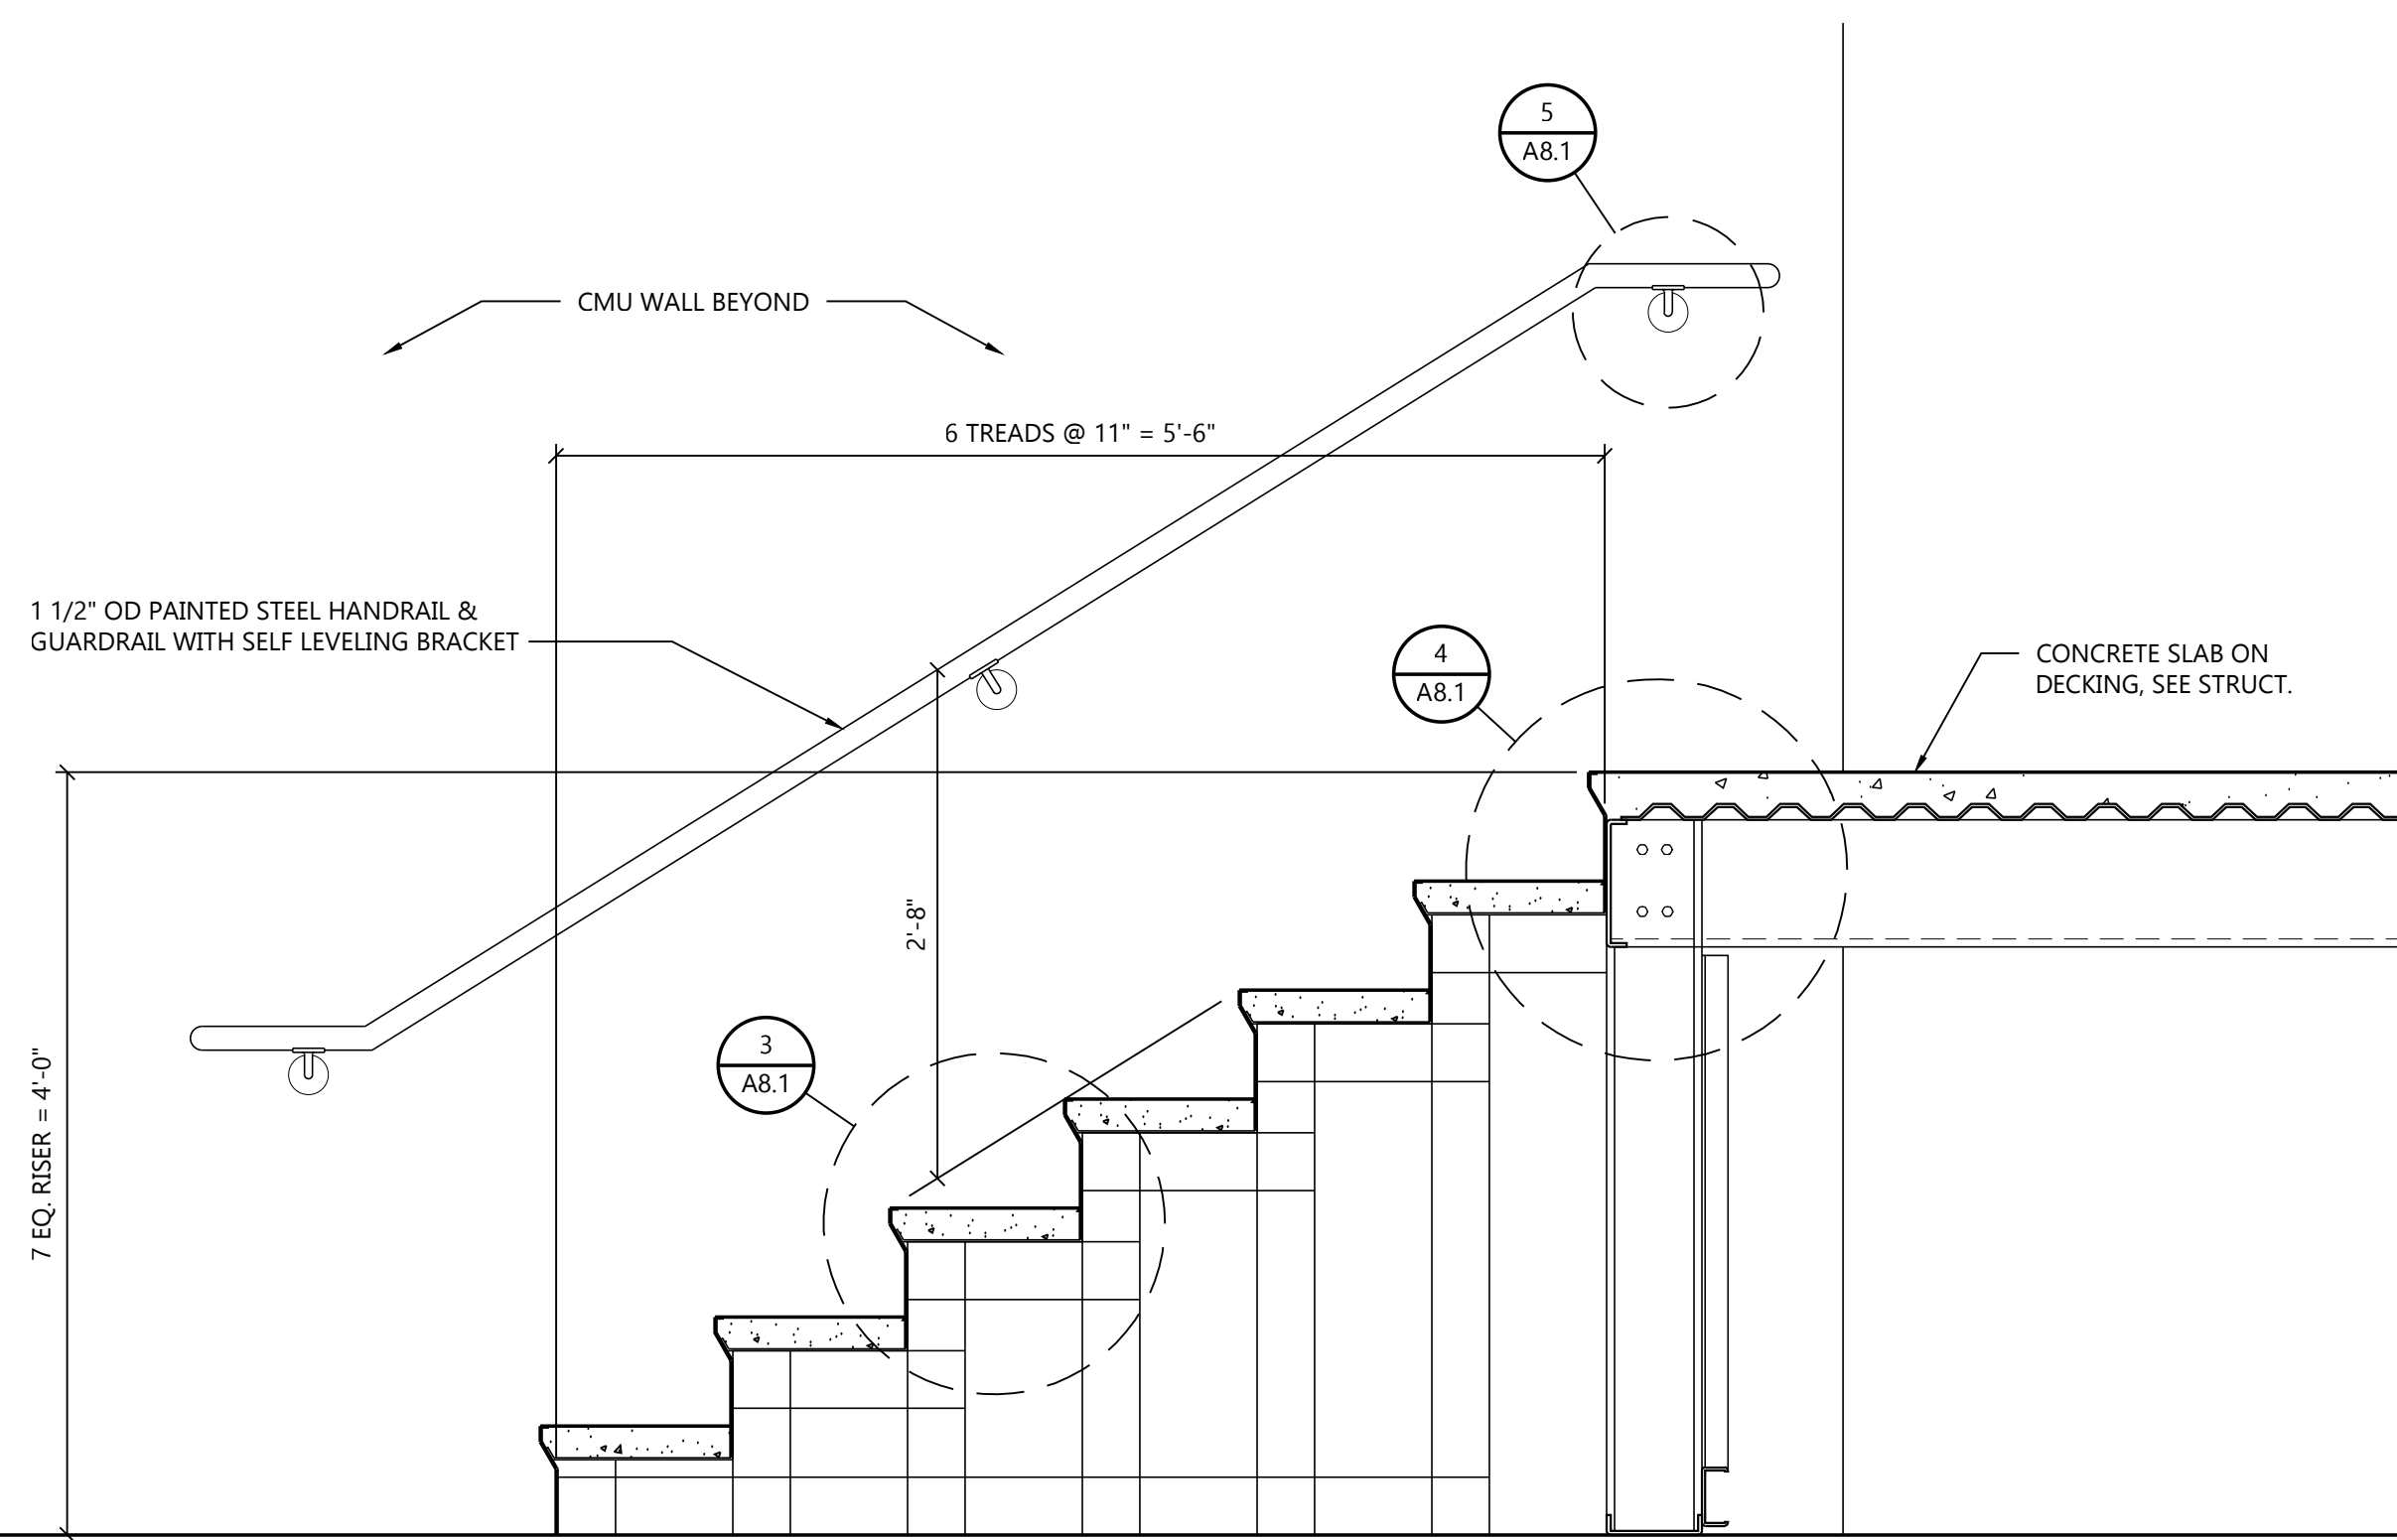


STEP SECTION @ STAGE 315, TYP.
SCALE: 1" = 1'-0"

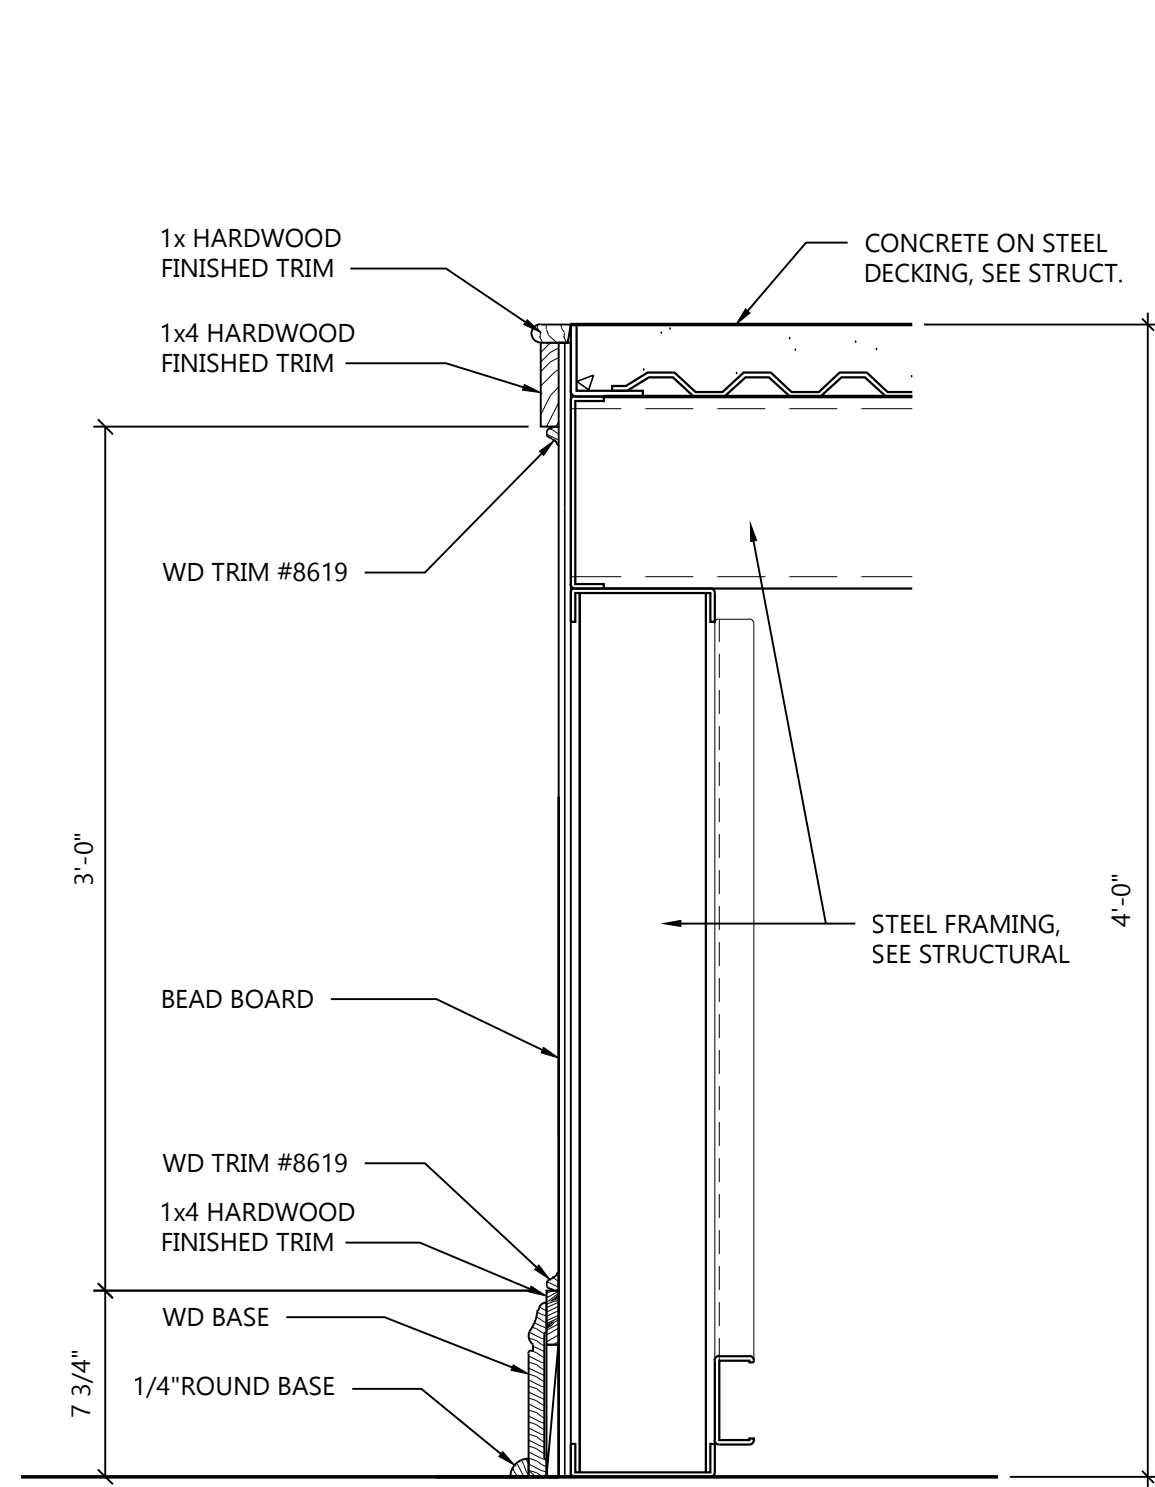


STAGE TRIM DETAIL
SCALE: 1 1/2" = 1'-0"

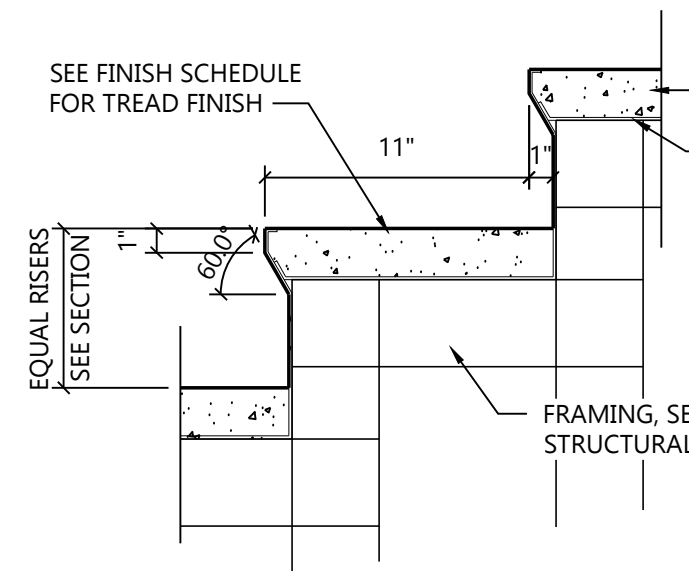


STAIR DETAIL
SCALE: 1 1/2" = 1'-0"

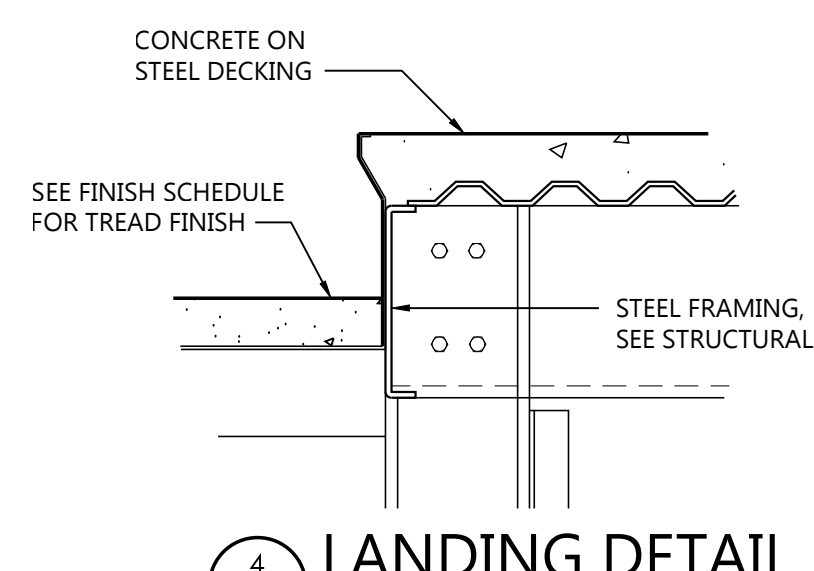


LANDING DETAIL
SCALE: 1 1/2" = 1'-0"

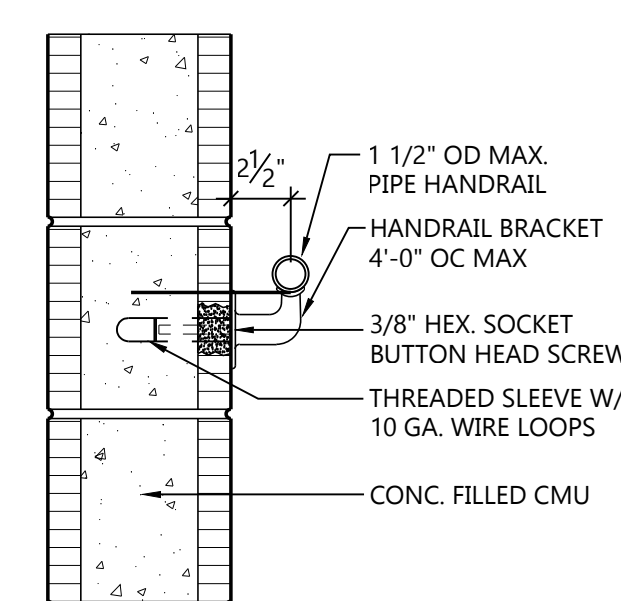


HANDRAIL BRACKET
SCALE: 1 1/2" = 1'-0"

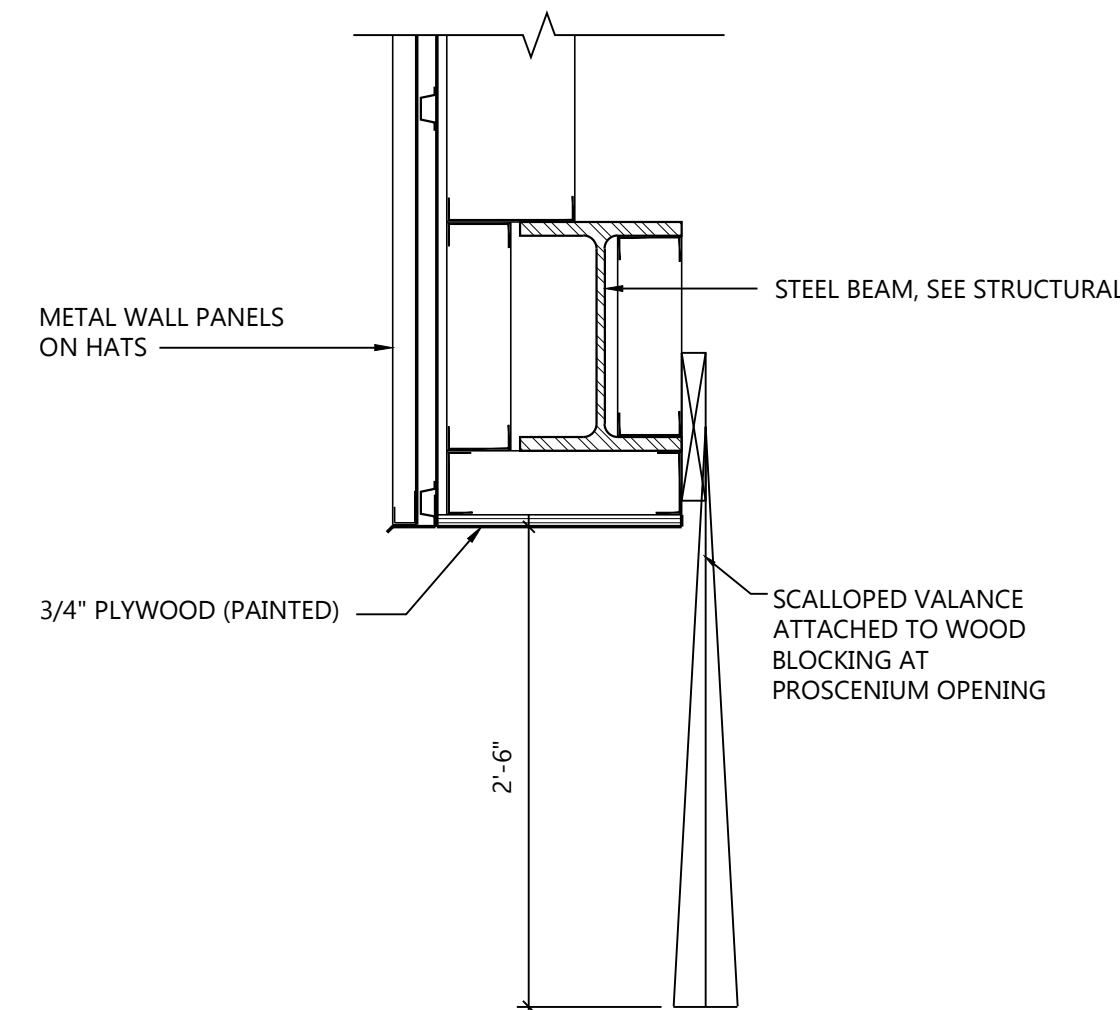


VALANCE CURTAIN
SCALE: 1" = 1'-0"

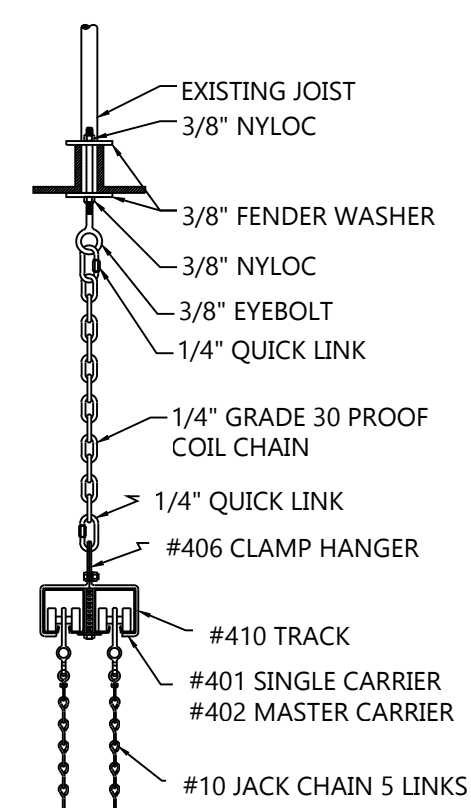


FRONT CURTAIN ATTACHMENT
SCALE: 1" = 1'-0"

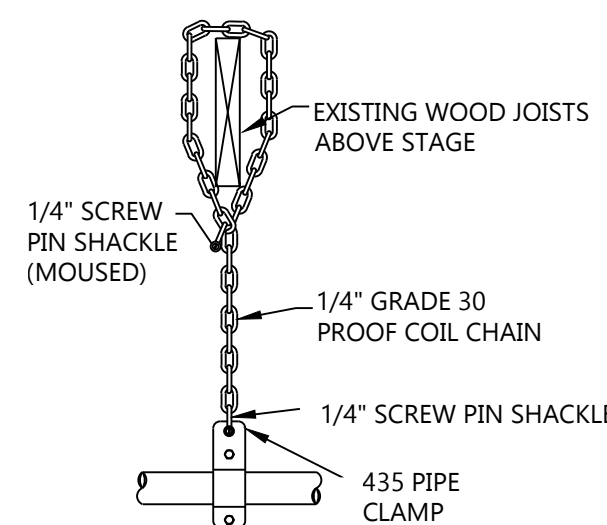

DEAD-HUNG RIGGING ATTACHMENT
SCALE: 1" = 1'-0"

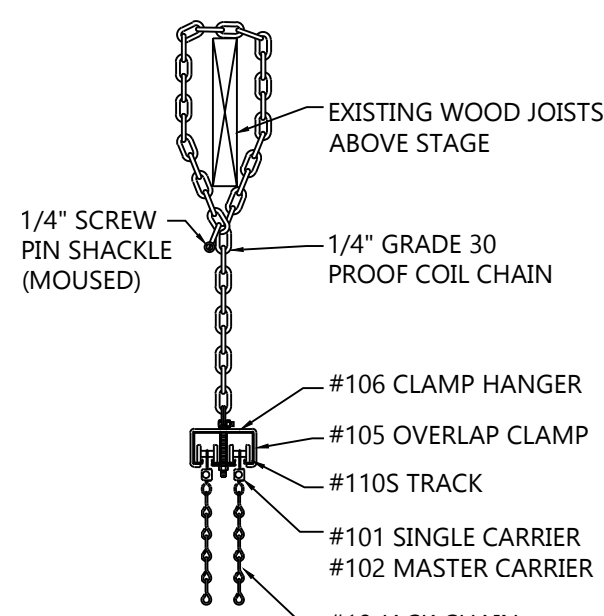


REAR CURTAIN ATTACHMENT
SCALE: 1" = 1'-0"

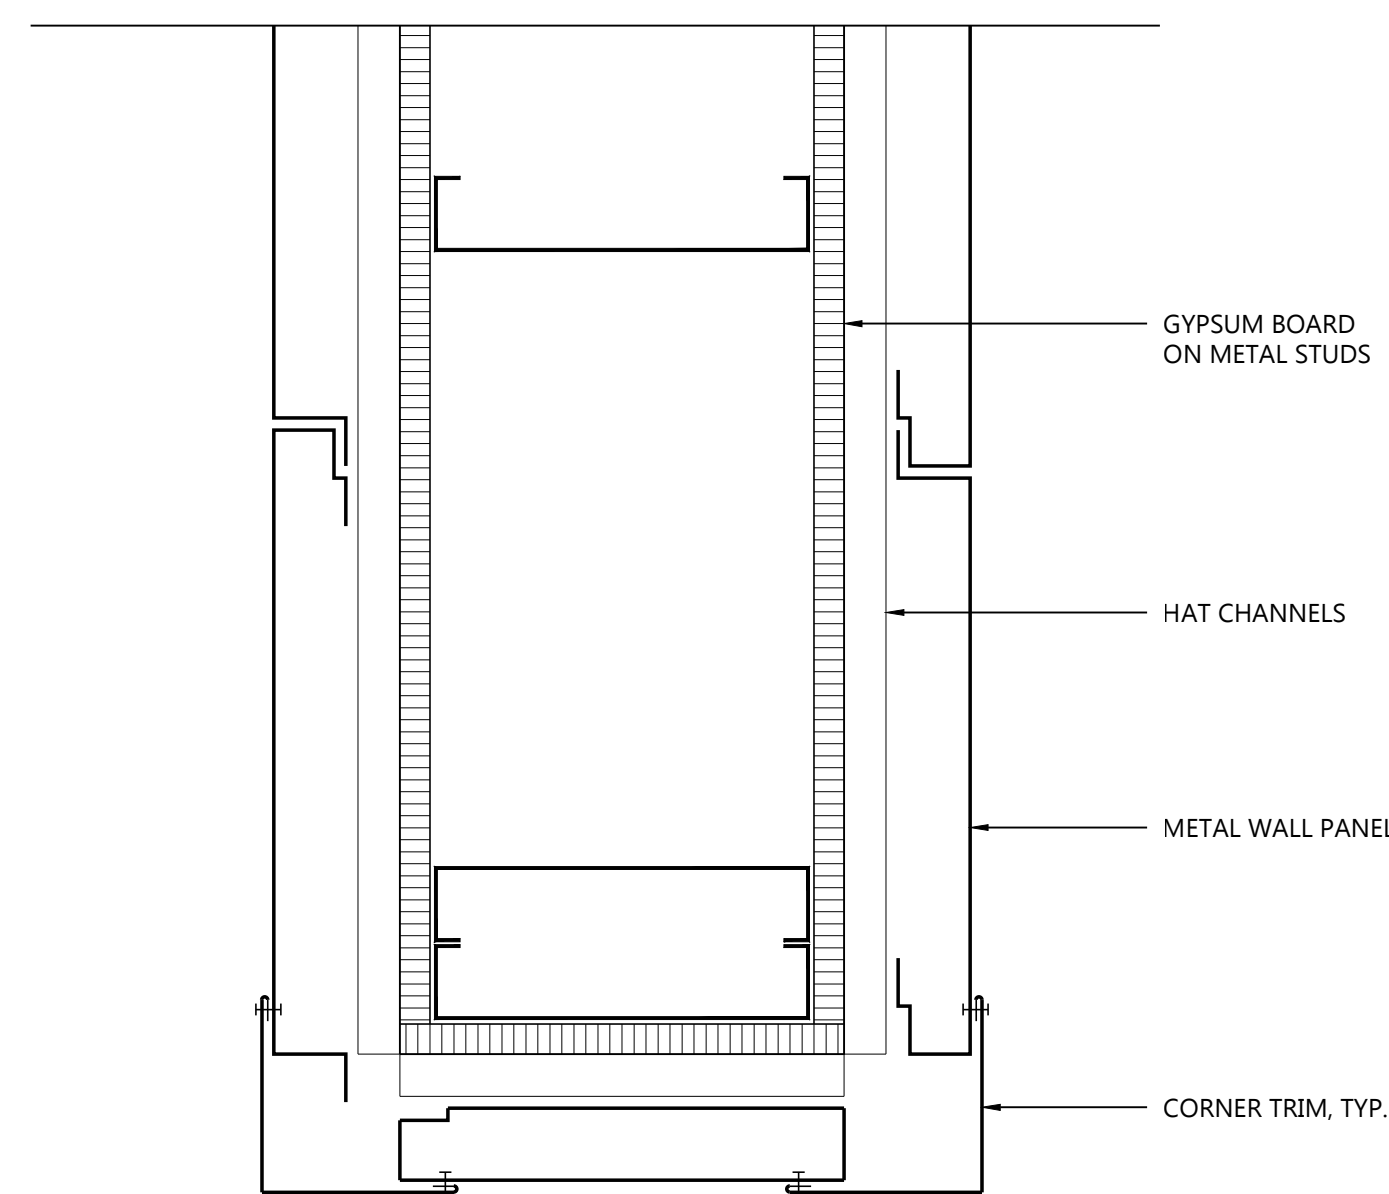

CORNER TRIM DETAIL @ STAGE WALL
SCALE: 1 1/2" = 1'-0"

HUXFORD ELEMENTARY SCHOOL
GYMNASIUM AND CLASSROOM ADDITION
FOR
ESCAMBIA COUNTY BOARD OF EDUCATION
BREWTON, ALABAMA

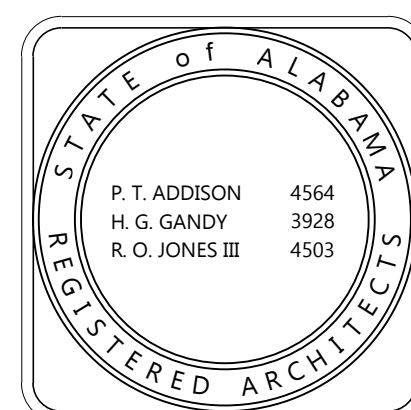

DRAWN	RTS/RB	CHECK	HG
DATE	06/18/2025 RTA		
REVISED	07/15/2025		
REVISED			

SHEET TITLE
STAGE DETAILS

JOB NO. PHJ # 2312SC
DCMR 2023650
PSCA# 95511

SEQUENCE NO. 48 OF 124

A8.1

© PH&J ARCHITECTS, INC.
ALL RIGHTS RESERVED

ADDENDUM 1
ATTACHMENT 2

CEILING OUTLETS

- Ⓐ ② RECESSED 2'x4' LAY-IN FIXTURE, MARK 'A' CIRCUIT NUMBER 2, TYPICAL.
- Ⓐ ② RECESSED 2'x4' LAY-IN FIXTURE, MARK 'A' CIRCUIT NUMBER 2, TYPICAL, 'EMERGENCY POWER'.
- Ⓐ ② RECESSED 1'x4' LAY-IN FIXTURE, MARK 'A' CIRCUIT NUMBER 2, TYPICAL.
- Ⓐ ② RECESSED 1'x4' LAY-IN FIXTURE, MARK 'A' CIRCUIT NUMBER 2, TYPICAL, 'EMERGENCY POWER'.
- Ⓐ ② RECESSED 2'x2' LAY-IN FIXTURE, MARK 'A' CIRCUIT NUMBER 2, TYPICAL.
- Ⓐ ② RECESSED 2'x2' LAY-IN FIXTURE, MARK 'A' CIRCUIT NUMBER 2, TYPICAL, 'EMERGENCY POWER'.
- Ⓐ ② SURFACE OR PENDANT MOUNTED LINEAR STRIP FIXTURE, MARK 'A' CIRCUIT NUMBER 2, TYPICAL.
- Ⓐ ② SURFACE OR PENDANT MOUNTED LINEAR STRIP FIXTURE, MARK 'A' CIRCUIT NUMBER 2, TYPICAL, 'EMERGENCY POWER'.
- Ⓐ ② RECESSED OR SURFACE MOUNTED DOWNLIGHT, MARK 'A' CIRCUIT NUMBER 2, TYPICAL.
- Ⓐ ② RECESSED OR SURFACE MOUNTED DOWNLIGHT, MARK 'A' CIRCUIT NUMBER 2, TYPICAL, 'EMERGENCY POWER'.
- Ⓐ ② RECESSED OR SURFACE MOUNTED ROUND FIXTURE, MARK 'A' CIRCUIT NUMBER 2, TYPICAL.
- Ⓐ ② RECESSED OR SURFACE MOUNTED ROUND FIXTURE, MARK 'A' CIRCUIT NUMBER 2, TYPICAL 'EMERGENCY POWER'.
- Ⓐ ② CEILING MOUNTED SINGLE FACE EXIT SIGN, ARROWS AS SHOWN ON DRAWINGS.
- Ⓐ ② CEILING MOUNTED DOUBLE FACE EXIT SIGN, ARROWS AS SHOWN ON DRAWINGS.
- Ⓐ ② CEILING MOUNTED JUNCTION BOX.
- Ⓐ ② DUPLEX RECEPTACLE - 20AMP., 125 VOLT, 2 POLE, 3 WIRE GROUNDED TYPE, NEMA 5-20R. CEILING MOUNTED.
- Ⓐ ② DUPLEX RECEPTACLE - 20AMP., 125 VOLT, GFI, 2 POLE, 3 WIRE GROUNDED TYPE, NEMA 5-20R. CEILING MOUNTED.
- Ⓐ ② DUPLEX RECEPTACLE - 20AMP., 125 VOLT, GFI, 2 POLE, 3 WIRE GROUNDED TYPE, NEMA 5-20R. CEILING MOUNTED, MOUNT IN 4"x4"x2" BOX. PROVIDE STEEL BARRIER BETWEEN CATV/RECEPTACLE AND CONNECTOR WITH BUSHING FOR CATV CABLE.
- Ⓐ ② CEILING MOUNTED JUNCTION BOX FOR AUTOMATIC DOORS.
- Ⓐ ② JUNCTION BOX WITH FLEXIBLE CONNECTION TO EQUIPMENT.
- Ⓐ ② JUNCTION BOX WITH FLEXIBLE CONNECTION TO FIXTURE.
- * ALL EMERGENCY LIGHTING SHALL BE PROVIDED WITH SELF-CONTAINED EMERGENCY BATTERY. GENERATOR IS STAND-BY ONLY.

WALL OUTLETS

- Ⓐ ② WALL MOUNTED FIXTURE, MARK 'A' CIRCUIT NUMBER 2, TYPICAL.
- Ⓐ ② WALL MOUNTED FIXTURE, MARK 'A' CIRCUIT NUMBER 2, TYPICAL, 'EMERGENCY POWER'.
- Ⓐ ② WALL MOUNTED SINGLE FACE EXIT SIGN, ARROWS AS SHOWN ON DRAWINGS.
- Ⓐ ② WALL MOUNTED FIXTURE, MARK 'A' CIRCUIT NUMBER 2, TYPICAL.
- Ⓐ ② WALL MOUNTED FIXTURE, MARK 'A' CIRCUIT NUMBER 2, TYPICAL, 'EMERGENCY POWER'.
- Ⓐ ② BATTERY OPERATED EMERGENCY FIXTURE.
- Ⓐ ② DUPLEX RECEPTACLE - 20AMP., 125 VOLT, 2 POLE, 3 WIRE GROUNDED TYPE, NEMA 5-20R. MOUNT 18" A.F.F. UNLESS OTHERWISE NOTED.
- Ⓐ ② DUPLEX RECEPTACLE - 20AMP., 125 VOLT, GFI, 2 POLE, 3 WIRE GROUNDED TYPE, NEMA 5-20R. MOUNT 18" A.F.F. UNLESS OTHERWISE NOTED.
- Ⓐ ② DUPLEX RECEPTACLE - 20AMP., 125 VOLT, GFI, 2 POLE, 3 WIRE GROUNDED TYPE, NEMA 5-20R. MOUNT 18" A.F.F. UNLESS OTHERWISE NOTED, PROVIDE WEATHERPROOF WHILE IN USE. BOX FOR RECEPTACLE.
- Ⓐ ② DUPLEX RECEPTACLE - 20AMP., 125 VOLT, GFI, 2 POLE, 3 WIRE GROUNDED TYPE, NEMA 5-20R. MOUNT AS DIRECTED FOR SMARTBOARD.
- Ⓐ ② DUPLEX RECEPTACLE - 20AMP., 125 VOLT, 2 POLE, 3 WIRE GROUNDED TYPE, NEMA 5-20R. MOUNT 6" ABOVE COUNTER.
- Ⓐ ② DUPLEX RECEPTACLE - 20AMP., 125 VOLT, GFI, 2 POLE, 3 WIRE GROUNDED TYPE, NEMA 5-20R. MOUNT 6" ABOVE COUNTER.
- Ⓐ ② QUADRAPLEX RECEPTACLE - 20AMP., 125 VOLT, 2 POLE, 3 WIRE GROUNDED TYPE, NEMA 5-20R. MOUNT 18" A.F.F. UNLESS OTHERWISE NOTED.
- Ⓐ ② QUADRAPLEX RECEPTACLE - 20AMP., 125 VOLT, GFI, 2 POLE, 3 WIRE GROUNDED TYPE, NEMA 5-20R. MOUNT 18" A.F.F. UNLESS OTHERWISE NOTED.
- Ⓐ ② QUADRAPLEX RECEPTACLE - 20AMP., 125 VOLT, 2 POLE, 3 WIRE GROUNDED TYPE, NEMA 5-20R. MOUNT 6" ABOVE COUNTER.
- Ⓐ ② QUADRAPLEX RECEPTACLE - 20AMP., 125 VOLT, GFI, 2 POLE, 3 WIRE GROUNDED TYPE, NEMA 5-20R. MOUNT 6" ABOVE COUNTER.
- Ⓐ ② QUADRAPLEX RECEPTACLE - 20AMP., 125 VOLT, GFI, 2 POLE, 3 WIRE GROUNDED TYPE, NEMA 5-20R. MOUNT 26" A.F.F. TO CENTER LINE FOR DRINKING FOUNTAIN.
- Ⓐ ② DUPLEX RECEPTACLE - 20AMP., 125 VOLT, 2 POLE, 3 WIRE GROUNDED TYPE, NEMA 5-20R. MOUNT 18" A.F.F. UNLESS OTHERWISE NOTED, TAMPER-PROOF.
- Ⓐ ② DUPLEX RECEPTACLE - 20AMP., 125 VOLT, 2 POLE, GFI, 3 WIRE GROUNDED TYPE, NEMA 5-20R. CONNECTION FOR COFFEE MAKER, COORDINATE MOUNTING HEIGHT WITH ARCHITECTURAL ELEVATIONS.
- Ⓐ ② DUPLEX RECEPTACLE - 20AMP., 125 VOLT, 2 POLE, GFI, 3 WIRE GROUNDED TYPE, NEMA 5-20R. CONNECTION FOR MICROWAVE, COORDINATE MOUNTING HEIGHT WITH ARCHITECTURAL ELEVATIONS.
- Ⓐ ② DUPLEX RECEPTACLE - 20AMP., 125 VOLT, 2 POLE, GFI, 3 WIRE GROUNDED TYPE, NEMA 5-20R. CONNECTION FOR REFRIGERATOR, COORDINATE MOUNTING HEIGHT WITH ARCHITECTURAL ELEVATIONS.
- Ⓐ ② DUPLEX RECEPTACLE - 20AMP., 125 VOLT, 2 POLE, GFI, 3 WIRE GROUNDED TYPE, NEMA 5-20R. CONNECTION FOR UNDER COUNTER REFRIGERATOR, COORDINATE MOUNTING HEIGHT WITH ARCHITECTURAL ELEVATIONS.
- Ⓐ ② DUPLEX RECEPTACLE - 20AMP., 125 VOLT, GFI, 2 POLE, 3 WIRE GROUNDED TYPE, NEMA 5-20R. MOUNT IN 4"x4"x2" BOX. PROVIDE STEEL BARRIER BETWEEN CATV/RECEPTACLE AND CONNECTOR WITH BUSHING FOR CATV CABLE.
- Ⓐ ② SINGLE RECEPTACLE - SEE DRAWINGS FOR NEMA CONFIGURATION.
- Ⓐ ② WALL MOUNTED JUNCTION BOX SIZE NOTED OR REQUIRED WITH BLANK SCREW COVER.
- Ⓐ ② WALL MOUNTED JUNCTION BOX SIZE NOTED OR REQUIRED WITH BLANK SCREW COVER AND FLEXIBLE CONDUIT CONNECTION.
- Ⓐ ② WALL MOUNTED JUNCTION BOX SIZE NOTED OR REQUIRED WITH BLANK SCREW COVER AND FLEXIBLE CONDUIT POWER CONNECTION FOR PREWIRED MODULAR FURNITURE. 3/10 & 3/10(NETURAL) & 1/10 (GROUND) 1" C.
- Ⓐ ② PLUGMOLD ASSEMBLY WITH RECEPTACLES SPACED EVERY 24" ON CENTER. ALTERNATE CIRCUITS FOR EVERY OTHER RECEPTACLE. VERIFY LENGTH ON FLOOR PLANS. PROVIDE 1-1/4". FOR COMMUNICATION CABLING UP ABOVE ACCESSIBLE CEILING. SIMILAR TO WIREMOLD #4000 DESIGNER SERIES.
- * ALL RECEPTACLES MOUNTED IN STUDENT AREAS SHALL BE TAMPER PROOF RECEPTACLES.
- * ALL EMERGENCY LIGHTING SHALL BE PROVIDED WITH SELF-CONTAINED EMERGENCY BATTERY. GENERATOR IS STAND-BY ONLY.

WALL SWITCHES (MOUNT 48" A.F.F. TO TOP OF BOX)

- \$ A.C. TYPE, SINGLE POLE, 20AMP, 120/277 VOLT.
- 3\$ A.C. TYPE, 3-WAY, 20AMP, 120/277V VOLT.
- 4\$ A.C. TYPE, 4-WAY, 20AMP, 120/277V VOLT.
- 5\$ A.C. TYPE, 4-WAY, 20AMP, 120/277V VOLT, CONTROLS ZONE 'a'.
- 1M\$ ICE MACHINE DISCONNECT SWITCH, INSTALL RECESSED JUNCTION BOX WITH FUSE BLOCK AND FUSES (SIZE PER MANUFACTURER), AT 14". (COORDINATE LOCATION WITH EQUIPMENT TO BE USED). INSTALL MANUAL MOTOR SWITCH AT 48". ENGRAVE JUNCTION BOX COVER TO READ "ICE MACHINE FUSES".
- 2\$ TWO SWITCHES IN TWO GANG BOX UNDER ONE WALLPLATE (NOTE: IF SWITCHES ARE CONNECTED TO DIFFERENT PANELBOARDS PROVIDE STEEL BARRIER BETWEEN SWITCHES.).
- MC\$ MOMENTARY CONTACT, 15A., 3-POSITION.
- T\$ MOTOR RATED TOGGLE SWITCH DISCONNECT, WITH THERMAL OVERLOADS, A.C. TYPE, 20AMP, 120/277 VOLT.
- M\$ MOTOR RATED TOGGLE SWITCH DISCONNECT, WITHOUT THERMAL OVERLOADS, A.C. TYPE, 20AMP, 120/277 VOLT.
- 3M\$ MOTOR RATED TOGGLE SWITCH DISCONNECT, WITH THERMAL OVERLOADS, A.C. TYPE, 30AMP, 120/277 VOLT.
- RL\$ RAISE/LOWER SWITCH FOR PROJECTION SCREEN.

LIGHTING CONTROLS

- ⑨ CEILING MOUNTED OCCUPANCY SENSOR.
- PP POWER PACK FOR OCCUPANCY SENSOR.
- L1 ROOM CONTROLLER - 1 ZONE DIMMING.
- L2 ROOM CONTROLLER - 2 ZONE DIMMING.
- L3 ROOM CONTROLLER - 3 ZONE DIMMING.
- EL U.L. 924 TRANSFER DEVICE TO BRING DIMMED FIXTURES TO 100%.
- RC ROOM CONTROLLER - ON/OFF NO DIMMING.
- D1 WALL DIMMER - ON/OFF & 0-10V 1-ZONE DIMMING.
- D2 WALL DIMMER - ON/OFF & 0-10V 2-ZONE DIMMING.
- D3 WALL DIMMER - ON/OFF & 0-10V 2-ZONE DIMMING.
- \$L LOW VOLTAGE SWITCH, 2-BUTTON.
- \$L2 LOW VOLTAGE SWITCH CONNECTED TO LIGHTING CONTROL PANEL, 2-BUTTON.
- \$L4 LOW VOLTAGE SWITCH CONNECTED TO LIGHTING CONTROL PANEL, 4-BUTTON.
- \$O1 OCCUPANCY SENSOR WALL SWITCH, DUAL TECHNOLOGY, ON/OFF.
- \$O2 OCCUPANCY SENSOR WALL SWITCH, DUAL TECHNOLOGY, ON/OFF, RAISE LOWER. 0-10V DIMMING.
- J PUSH BUTTON, TOGGLE SWITCH, ROTARY SWITCH, ETC., FURNISHED WITH EQUIPMENT BY OTHER, INSTALLED AND WIRED BY THE ELECTRICAL CONTRACTOR.
- ⓪ PHOTOCELL, TORK MODEL 5231 (120V), TWIST RECEPTACLE: TORK 2421.
- *COORDINATE WITH LIGHTING CONTROL DETAILS FOR MORE REQUIREMENTS.

BRANCH CIRCUITING

- RUN CONCEALED UNDER FLOOR OR IN GROUND SLAB.
- RUN CONCEALED IN CEILING OR WALLS.
- EXISTING - REMOVE IF EXPOSED, ABANDON IF CONCEALED, REMOVE ALL CONDUCTORS.
- SURFACE MOUNTED CONDUIT, RUN PARALLEL OR PERPENDICULAR TO BUILDING LINES.
- EMERGENCY.
- LIQUID-TIGHT FLEXIBLE CONDUIT CONNECTION.
- LA HOMERUN TO PANEL. ANY CIRCUIT WITHOUT FURTHER IDENTIFICATION INDICATES 2/10 & 1/10 GROUND - 3/4". 3/10 & 1/10 GROUND - 3/4". 4/10 & 1/10 GROUND - 3/4". ETC AS PER NEC. LETTERS INDICATE PANELBOARD DESIGNATION.
- WHERE A NUMBER IS SHOWN NEXT TO OR ON THE CIRCUIT OR HOMERUN, THE NUMBER INDICATES CONDUCTOR SIZE OTHER THAN #12 - NUMBER OF CONDUCTORS INDICATED. PROVIDE GROUND SIZED PER NEC TABLE 250 FOR MAX AMPACITY OF CONDUCTOR SIZE AS SHOWN. SIZE CONDUIT PER NEC ANNEX C.
- RISER: UP, RUNNING TO SOURCE.
 - RISER: DOWN, RUNNING TO SOURCE.

FIRE ALARM

- FACP FIRE ALARM SYSTEM CONTROL PANEL.
- ANN FIRE ALARM SYSTEM REMOTE ANNUNCIATOR.
- FPG FIRE ALARM SYSTEM REMOTE ANNUNCIATOR.
- NAG FIRE ALARM SYSTEM NOTIFICATION APPLIANCE CIRCUIT.
- FJ JUNCTION BOX WITH HINGED COVER AND TERMINAL STRIP. 24"x24"x8" MINIMUM SIZE. SIZE LARGER AS REQUIRED.
- F MINIMUM 3/4" CONDUIT UON. PROVIDE NUMBER AND TYPE OF CONDUCTORS AS REQUIRED BY MANUFACTURER. PROVIDE LARGER CONDUIT IF REQUIRED BY NEC.
- Ⓐ FIRE ALARM SYSTEM MANUAL PULL STATION.
- Ⓐ FIRE ALARM SYSTEM VOICE EVAC SPEAKER.
- Ⓐ FIRE ALARM SYSTEM VOICE EVAC SPEAKER/STROBE.
- Ⓐ COMBINATION CHIME AND LIGHT.
- Ⓐ ALARM SIGNAL LIGHT.
- Ⓐ FIRE ALARM SYSTEM SIGNAL HORN.
- Ⓐ FIRE ALARM SYSTEM SIGNAL HORN/STROBE.
- Ⓐ FIRE ALARM SYSTEM SIGNAL HORN/STROBE, WEATHERPROOF.
- Ⓐ FIRE ALARM SYSTEM SUPERVISORY SWITCH.
- Ⓐ FIRE ALARM SYSTEM TAMPER SWITCH.
- Ⓐ FIRE ALARM SYSTEM FLOW SWITCH.
- Ⓐ FIRE ALARM SYSTEM AUTOMATIC HEAT DETECTOR, 135 DEGREE/RATE OF RISER TYPE, CEILING MOUNTED.
- Ⓐ FIRE ALARM SYSTEM AUTOMATIC HEAT DETECTOR, 190 DEGREE/RATE OF RISER TYPE, CEILING MOUNTED.
- Ⓐ FIRE ALARM SYSTEM AUTOMATIC SMOKE DETECTOR, CEILING MOUNTED.
- Ⓐ FIRE ALARM SYSTEM AUTOMATIC SMOKE DETECTOR, CEILING MOUNTED, ELEVATOR RECALL.
- Ⓐ FIRE ALARM SYSTEM FLAME DETECTOR.
- Ⓐ FIRE ALARM SYSTEM AUTOMATIC AIR DUCT SMOKE DETECTOR MOUNTED IN MECHANICAL DUCT.
- Ⓐ FIRE ALARM SYSTEM AUTOMATIC AIR DUCT SMOKE DETECTOR MOUNTED IN MECHANICAL DUCT. PROVIDE AUXILIARY CONTACTS TO INITIATE SMOKE DAMPER CLOSURE, ADDRESSABLE. REMOTE ALARM PILOT LIGHT WITH KEY TEXT SWITCH.
- Ⓐ FIRE ALARM SYSTEM REMOVE TEST STATION.
- Ⓐ FIRE ALARM SYSTEM ZONE MODULE, CONTROL TYPE.
- Ⓐ FIRE ALARM SYSTEM ZONE MODULE, MONITOR TYPE.
- Ⓐ FIRE ALARM SYSTEM ZONE MODULE, SIGNAL TYPE.
- Ⓐ FIRE ALARM SYSTEM MAGNETIC DOOR HOLDERS.
- Ⓐ FIRE ALARM SYSTEM SUPERVISED CIRCUITING IN CONDUIT, RACEWAY INSTALLED CONCEALED.
- Ⓐ FIRE ALARM SYSTEM FIREMANS PHONE, MOUNTED 48" A.F.F. TO CENTERLINE.

PANELS AND POWER

- PANELBOARD SURFACE MOUNTED.
- PANELBOARD FLUSH MOUNTED.
- CON CONTROL PANEL.
- NON-FUSIBLE DISCONNECT SWITCH, XX/YY/ZZ WHERE X INDICATES AMPERAGE, Y INDICATES # OF POLES, AND Z INDICATES NEMA RATING.
- FUSIBLE DISCONNECT SWITCH, XX/YY/ZZ WHERE X INDICATES AMPERAGE, Y INDICATES # OF POLES, AND Z INDICATES NEMA RATING. FURNISH AND INSTALL FUSES PER MANUFACTURER'S RECOMMENDATIONS.
- CIRCUIT BREAKER, XX/YY WHERE X INDICATES AMPERAGE, Y INDICATES # OF POLES.
- MAGNETIC MOTOR STARTER, SIZE 1.
- COMBINATION NON-FUSIBLE DISCONNECT SWITCH AND STARTER, XX/YY/ZZ WHERE X INDICATES AMPERAGE, Y INDICATES # OF POLES, AND Z INDICATES NEMA RATING.
- COMBINATION FUSIBLE DISCONNECT SWITCH AND STARTER, XX/YY/ZZ WHERE X INDICATES AMPERAGE, Y INDICATES # OF POLES, AND Z INDICATES NEMA RATING. FURNISH AND INSTALL FUSES PER MANUFACTURER'S RECOMMENDATIONS.
- ② MOTOR: SHOWN 2HP (TYPICAL)
- CIRCUIT BREAKER
- NONFUSIBLE SWITCH
- FUSIBLE SWITCH
- AUTOMATIC TRANSFER SWITCH
- AUTOMATIC TRANSFER SWITCH (OPEN TRANSITION) WITH BYPASS-ISOLATION
- >> DRAWOUT CONNECTION
- PAD MOUNTED TRANSFORMER
- > LOAD BREAK CONNECTION
- GROUND
- METER
- GROUNDING ELECTRODE CONNECTION.
- ENGINE GENERATOR.

MISCELLANEOUS EQUIPMENT

- Ⓐ CONTACTOR
- Ⓐ RELAY
- Ⓐ TRANSFORMER
- Ⓐ SITE LIGHTING POLE
- Ⓐ EXTERIOR POST TOP LIGHT
- Ⓐ WATER HEATER
- Ⓐ UNIT HEATER
- Ⓐ EXHAUST FAN
- Ⓐ GENERATOR ANNUNCIATOR PANEL
- Ⓐ VARIABLE AIR VOLUME BOX
- Ⓐ ELEVATOR CONTROLLER
- Ⓐ VARIABLE FREQUENCY DRIVE
- Ⓐ GENERATOR ANNUNCIATOR PANEL
- Ⓐ AUTOMATIC TRANSFER SWITCH
- Ⓐ MANUAL TRANSFER SWITCH
- Ⓐ TIME SWITCH

DRAWING CONVENTIONS

- NEW WORK
- EXISTING TO REMAIN
- x-x- EXISTING TO REMOVE
- EX EXISTING TO REMAIN
- XRR EXISTING TO BE RELOCATED
- XRP EXISTING TO BE REPLACED
- XRL EXISTING RELOCATED
- XR EXISTING TO BE REMOVED

FLOOR BOXES

- Ⓐ RECESSED FLOOR BOX WITH FULL EIGHT GANGS. SIMILAR TO WALKER RFB11 OR PRIOR APPROVED EQUALS. ARCHITECT TO SELECT FINISH. PROVIDE WITHIN 2-DUPLEX RECEPTACLES NEMA 5-20R. PROVIDE CONDUIT AS SHOWN ON DRAWINGS. PROVIDE TWO (2) 1-1/4" CONDUITS TO ABOVE ACCESSIBLE CEILING IN CORRIDOR. PROVIDE TWO (2) 1-1/4" CONDUITS TO TBB. PROVIDE ADDITIONAL CONDUITS AS SHOWN ON DRAWINGS. PROVIDE PROTECTIVE COLLAR FOR STUDS. PROVIDE WITH FLOOR EXTENSION FOR MOUNTING IN GYMNASIUM FLOOR.
- Ⓐ RECESSED FLOOR BOX WITH FULL EIGHT GANGS. SIMILAR TO WALKER RFB-119-SL OR PRIOR APPROVED EQUALS. ARCHITECT TO SELECT FINISH. PROVIDE WITHIN 2-DUPLEX RECEPTACLES NEMA 5-20R. PROVIDE CONDUIT AS SHOWN ON DRAWINGS. PROVIDE TWO (2) 1-1/4" CONDUITS TO ABOVE ACCESSIBLE CEILING IN CORRIDOR. PROVIDE TWO (2) 1-1/4" CONDUITS TO TBB. PROVIDE ADDITIONAL CONDUITS AS SHOWN ON DRAWINGS. PROVIDE PROTECTIVE COLLAR FOR STUDS. PROVIDE WITH FLOOR EXTENSION FOR MOUNTING IN GYMNASIUM FLOOR.
- Ⓐ RECESSED FLOOR BOX - QUADRAPLEX RECEPTACLE - 20AMP, 125 VOLT, 2-POLE, 3 WIRE, GROUNDED TYPE, NEMA 5-20R, PROVIDE WITH 8 GANG, ARCHITECT TO SELECT COLORS, SIMILAR TO WALKER EVOLUTION SERIES. EFB85-DG/EFB810CTR/EFB810BTK OR PRIOR APPROVED EQUAL FOR TYPICAL UNITS. PROVIDE TWO (2) 1-1/4" CONDUITS TO CABLE BASKET. (X) INDICATES NUMBER OF RJ45 JACKS AND CAT6 CABLES BACK TO THE NEAREST TBB. PROVIDE BARE CONCRETE RING WHERE INSTALLED IN FINISHED CONCRETE FLOOR.
- Ⓐ RECESSED FLOOR BOX - QUADRAPLEX RECEPTACLE - 20AMP, 125 VOLT, GFI, 2-POLE, 3 WIRE GROUNDED TYPE, NEMA 5-20R WITH 4-RJ45 CAT 6 JACKS, ARCHITECT TO SELECT COLORS, SIMILAR TO WALKER 881R4 OR PRIOR APPROVED EQUAL.
- Ⓐ RECESSED POKE THRU FLOOR BOX - QUADRAPLEX RECEPTACLE - 20AMP, 125 VOLT, GFI, 2-POLE, 3 WIRE, GROUNDED TYPE, NEMA 5-20R WITH 4-RJ45 CAT 6 JACKS, ARCHITECT TO SELECT COLORS SIMILAR TO WALKER RC4 OR PRIOR APPROVED EQUAL.
- Ⓐ RECESSED FLOOR BOX - INSTALLED FLUSH WITH RAISED FLOOR PANEL, PROVIDE WITH TWO (2) 120 VOLT, 20AMP, 2-POLE, 3 WIRE, GROUNDED TYPE, NEMA 5-20R RECEPTACLES WITH 4-RJ45 CAT 5E JACKS, ARCHITECT TO SELECT COLORS, SIMILAR TO WIREMOLD #42 SERIES OR PRIOR APPROVED EQUAL.
- Ⓐ RECESSED FLOOR BOX - WALKER NO. 88R4 WITH SURFACE STYLE COVER, COLOR BY ARCHITECT. BOX TO INCLUDE (2) FACTORY PRE-WIRED NEMA 5-20R DUPLEX RECEPTACLES WITH MATCHING HOUSING ASSEMBLY AND (4) CAT6 RF45 CONNECTORS. PROVIDE WITH ALL FACEPLACES, ADAPTERS AND HARDWARE. PROVIDE A 1-1/4" CONDUIT FROM FLOOR BOX AUXILIARY COMPARTMENT TO ABOVE FINISHED CEILING.

MISCELLANEOUS

- A AMPERE
- ADA AMERICANS WITH DISABILITIES ACT
- AFT ABOVE FINISHED FLOOR
- AIC AMPERE INTERRUPTING CAPACITY
- AL ALUMINUM
- ATS AUTOMATIC TRANSFER SWITCH
- AWG AMERICAN WIRE GAUGE
- C CONDUIT
- CFCI CONTRACTOR FURNISHED CONTRACTOR INSTALLED
- CFIO CONTRACTOR FURNISHED OWNER INSTALLED
- CO CIRCUITS
- CL CENTER LINE
- CJ COPPER
- CWP COLD WATER PIPE
- DIA DIAMETER
- EC ELECTRICAL CONTRACTOR
- EM EMERGENCY
- EMT ELECTRIC METALLIC TUBING
- EP EXPLOSION PROOF
- FCM FLEXIBLE METAL CONDUIT
- FLA FULL LOAD AMPERES
- G GROUND
- GFI GROUND FAULT INTERRUPTER
- GRC GALVANIZED RIGID METAL CONDUIT
- GRD GROUND
- H MOUNTING HEIGHT ABOVE FINISHED FLOOR TO CENTERLINE
- HP HORSE POWER
- KVA KILOVOLT-AMPERES
- KW KILOWATT
- KMIL THOUSAND CIRCULAR MILS
- MCA MINIMUM CIRCUIT AMPACITY
- MCB MAIN CIRCUIT BREAKER
- MCC MOTOR CONTROL CENTER
- MLO MAIN LUGS ONLY
- MT MOUNT
- N NEUTRAL
- NIC NOT IN CONTRACT
- NEC NATIONAL ELECTRICAL CODE
- NEMA NATIONAL ELECTRICAL MANUFACTURER'S ASSOC.
- NFPA NATIONAL FIRE PROTECTION ASSOCIATION
- NL NIGHT LIGHT
- NTS NOT TO SCALE
- P POLE
- PF POWER FACTOR
- PH PHASE
- PML PANEL
- PVC (POLYVINYL CHLORIDE) CONDUIT
- SLD SINGLE LINE DIAGRAM
- TBB TELEPHONE BACKBOARD
- TVSS TRANSIENT VOLTAGE SURGE SUPPRESSORS
- UL UNDERWRITER'S LABORATORY
- UNO UNLESS NOTED OTHERWISE
- V VOLTAGE
- W WIRE
- WP WEATHERPROOF
- # NUMBER
- 3R NEMA 3R WEATHERPROOF ENCLOSURE
- 4X NEMA 4X WEATHERPROOF/CORROSION ENCLOSURE

HUXFORD ELEMENTARY SCHOOL
GYMNASIUM AND CLASSROOM ADDITION
FOR
ESCAMBIA COUNTY BOARD OF EDUCATION
BREWTON, ALABAMA



DRAWN: FIP CHECK: KRK
DATE 05-16-2025
REVISED 7/10/25 ADDENDUM 1
REVISED


SHEET TITLE
ELECTRICAL LEGEND
& NOTES

JOB NO.
2312SC
SEQUENCE NO. 94 OF 124

E0.1



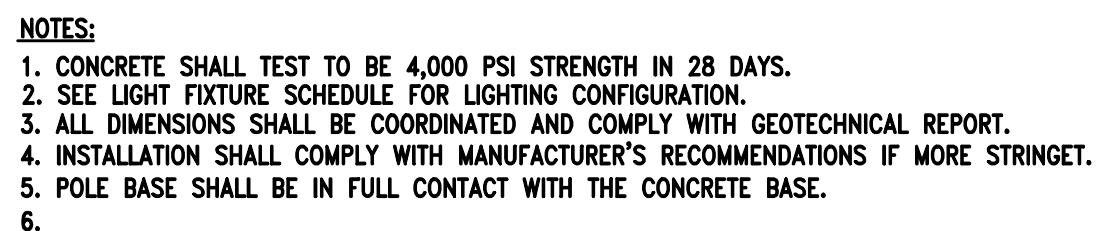


Gunn & Associates, P.C.
Consulting Engineers
3102 Highway 14
Millbrook, AL 36054
Tel: 334.285.1273
1200 Providence Park, Suite 200
Birmingham, AL 35242
GA/23-190

© PH&J ARCHITECTS, INC.
ALL RIGHTS RESERVED





- OH— OVERHEAD ELECTRICAL BY UTILITY
- OS— OVERHEAD SECONDARY
- UP— UNDERGROUND PRIMARY
- US— UNDERGROUND SECONDARY
- UC— UNDERGROUND COMMUNICATION
- OC— OVERHEAD COMMUNICATION
- UG— UNDERGROUND BRANCH CIRCUITING
- OB— OVERHEAD BRANCH CIRCUITING

1. LOCATIONS OF RISER POLES, AND TRANSFORMERS SHALL BE COORDINATED PRIOR TO BIDS. ADJUST FEEDER AND CONDUIT LENGTHS ACCORDINGLY. PAY ALL UTILITY COMPANY FEES. BID ACCORDINGLY.
2. ALL UNDERGROUND CONDUITS SHALL BE 36" MINIMUM BELOW GRADE. PRIMARY CONDUIT SHALL BE MINIMUM 48" BELOW GRADE.
3. ALL ROUTING IS SHOWN DIAGRAMMATIC. VERIFY ACTUAL ROUTING AND FIELD CONDITIONS PRIOR TO BIDS.
4. CONTRACTOR SHALL LABEL ALL CONDUITS ENTERING BACKBOARDS.
5. ALL ELECTRICAL PRIMARY SITE WORK SHALL BE COORDINATE WITH GUNTERSVILLE ELECTRIC BOARD. PRIOR TO BID.


- | | |
|---|---|
|  | PAD MOUNTED TRANSFORMER |
|  | POLE MOUNTED TRANSFORMER |
|  | UTILITY POLE |
|  | UTILITY POLE WITH UTILITY FLOOD LIGHT |
|  | <p>NEW IN GRADE PULLBOX. FOR COMMUNICATIONS 30"x48"x30"D
 IN-GRADE JUNCTION BOX FOR COMMUNICATIONS SYSTEM
 BOX SHALL BE COMPOSITE MATERIAL OF HIGH STRENGTH
 WITH COVER AND STAINLESS STEEL INSERTS. COVER
 SHALL HAVE LOGO INDICATING CONTENTS WITHIN
 INDICATIONS BOX SHALL BE DESIGNED FOR LIGHT
 TRAFFIC AREAS. MOUNT COVER FLUSH WITH GRAD.
 MOUNT ON A 12 INCH GRAVEL BED WITH 9 INCHES OF
 CONCRETE ABOVE PERIMETER AND A 3 INCH SOLID
 POLYETHYLENE BOX AND COVER APPROVAL. BOX TO BE
 EQUAL TO CDR SYSTEMS CORP., MODEL #A10-3448-S-30</p> |

- 1 COORDINATE WITH UTILITY COMPANY FOR SPECIFIC LOCATION AND REQUIREMENTS OF TRANSFORMER PAD. SEE POWER RISER DIAGRAM SHEET E7.1 FOR ADDITIONAL INFORMATION.
- 2 ROUTE FIBER ABOVE CEILING, PENETRATE EXTERIOR WALL WITH LB AND TRANSITION BELOW GRADE. SEE FIBER BACKBONE RISER SHEET E8.1 FOR ADDITIONAL INFORMATION.
- 3 AS FIBER BACKBONE RISERS UNDER GRADE PROVIDE (2) 2" CONDUIT WITH FIBER AS SHOWN ON RISER BACKBONE SHEET E8.1. BORE UNDER SIDEWALK AS REQUIRED TO HAND HOLE.
- 4 PROVIDE (1) 2" WITH FIBER AS INDICATED ON FIBER BACKBONE RISER SHEET E8.1. TURN CONDUIT UP INTO GLASS FIBER CONDUIT.
- 5 TAMPER SWITCH AT WATER VAULT. COORDINATE EXACT LOCATION AND QUANTITY WITH CIVIL CONTRACTOR PRIOR TO ROUGH-IN.

SCALE: 1" = 30'-0"

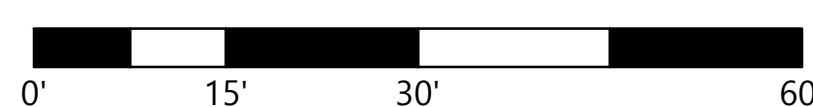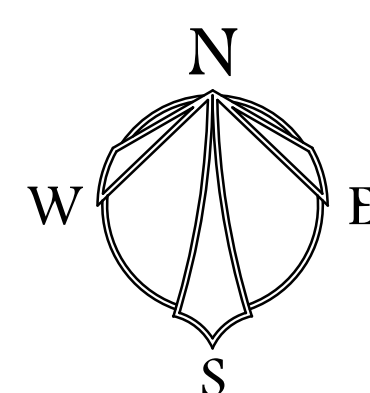

HUXFORD ELEMENTARY SCHOOL
GYMNASIUM AND CLASSROOM ADDITION
FOR
ESCAMBIA COUNTY BOARD OF EDUCATION
BREWTON, ALABAMA

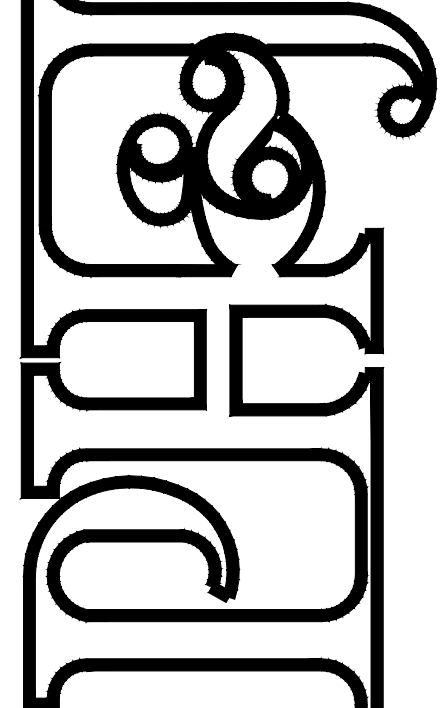

architects inc.
Montgomery,
Alabama




DRAWN: FJP CHECK: KRG
DATE: 05-16-2025
REVISED: 7/10/25 ADDENDUM 1
REVISED:


SHEET TITLE
FLOOR PLAN -
NORTH
LIGHTING
JOB NO.
2312SC
SEQUENCE
NO. 98 OF 124

E2.1

Gunn & Associates, P.C.
Consulting Engineers
3102 Highway 14
Millbrook, AL 36054
Tel: 334.285.1273
1200 Providence Park, Suite 200
Birmingham, AL 35242
GA#23-190

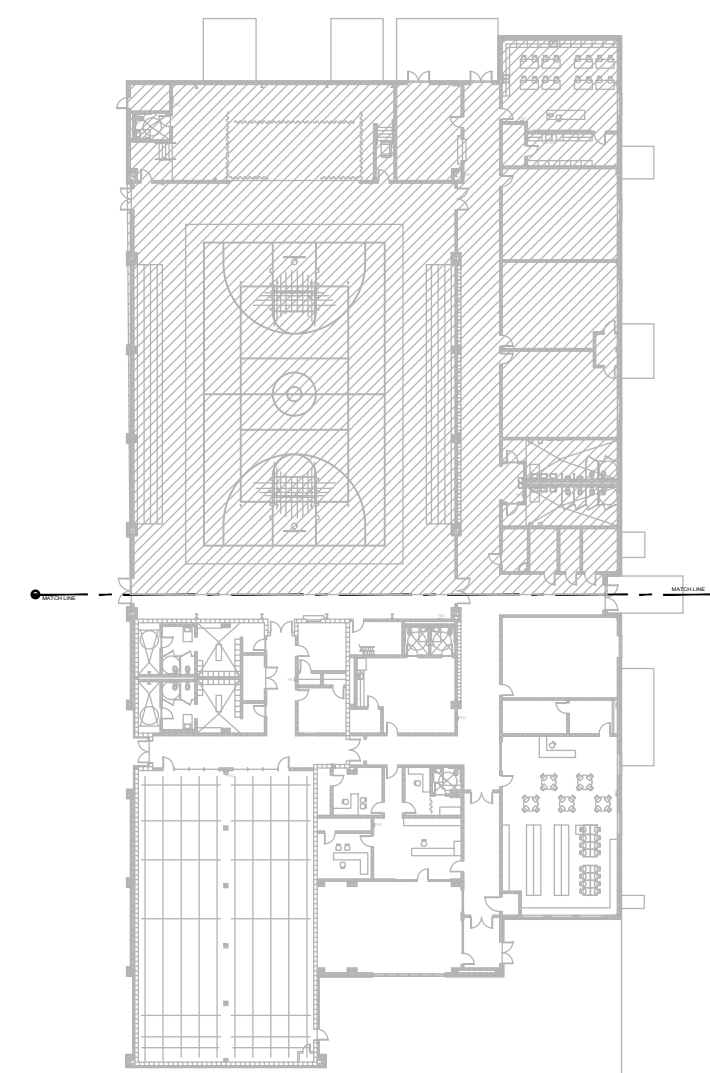

KEY PLAN


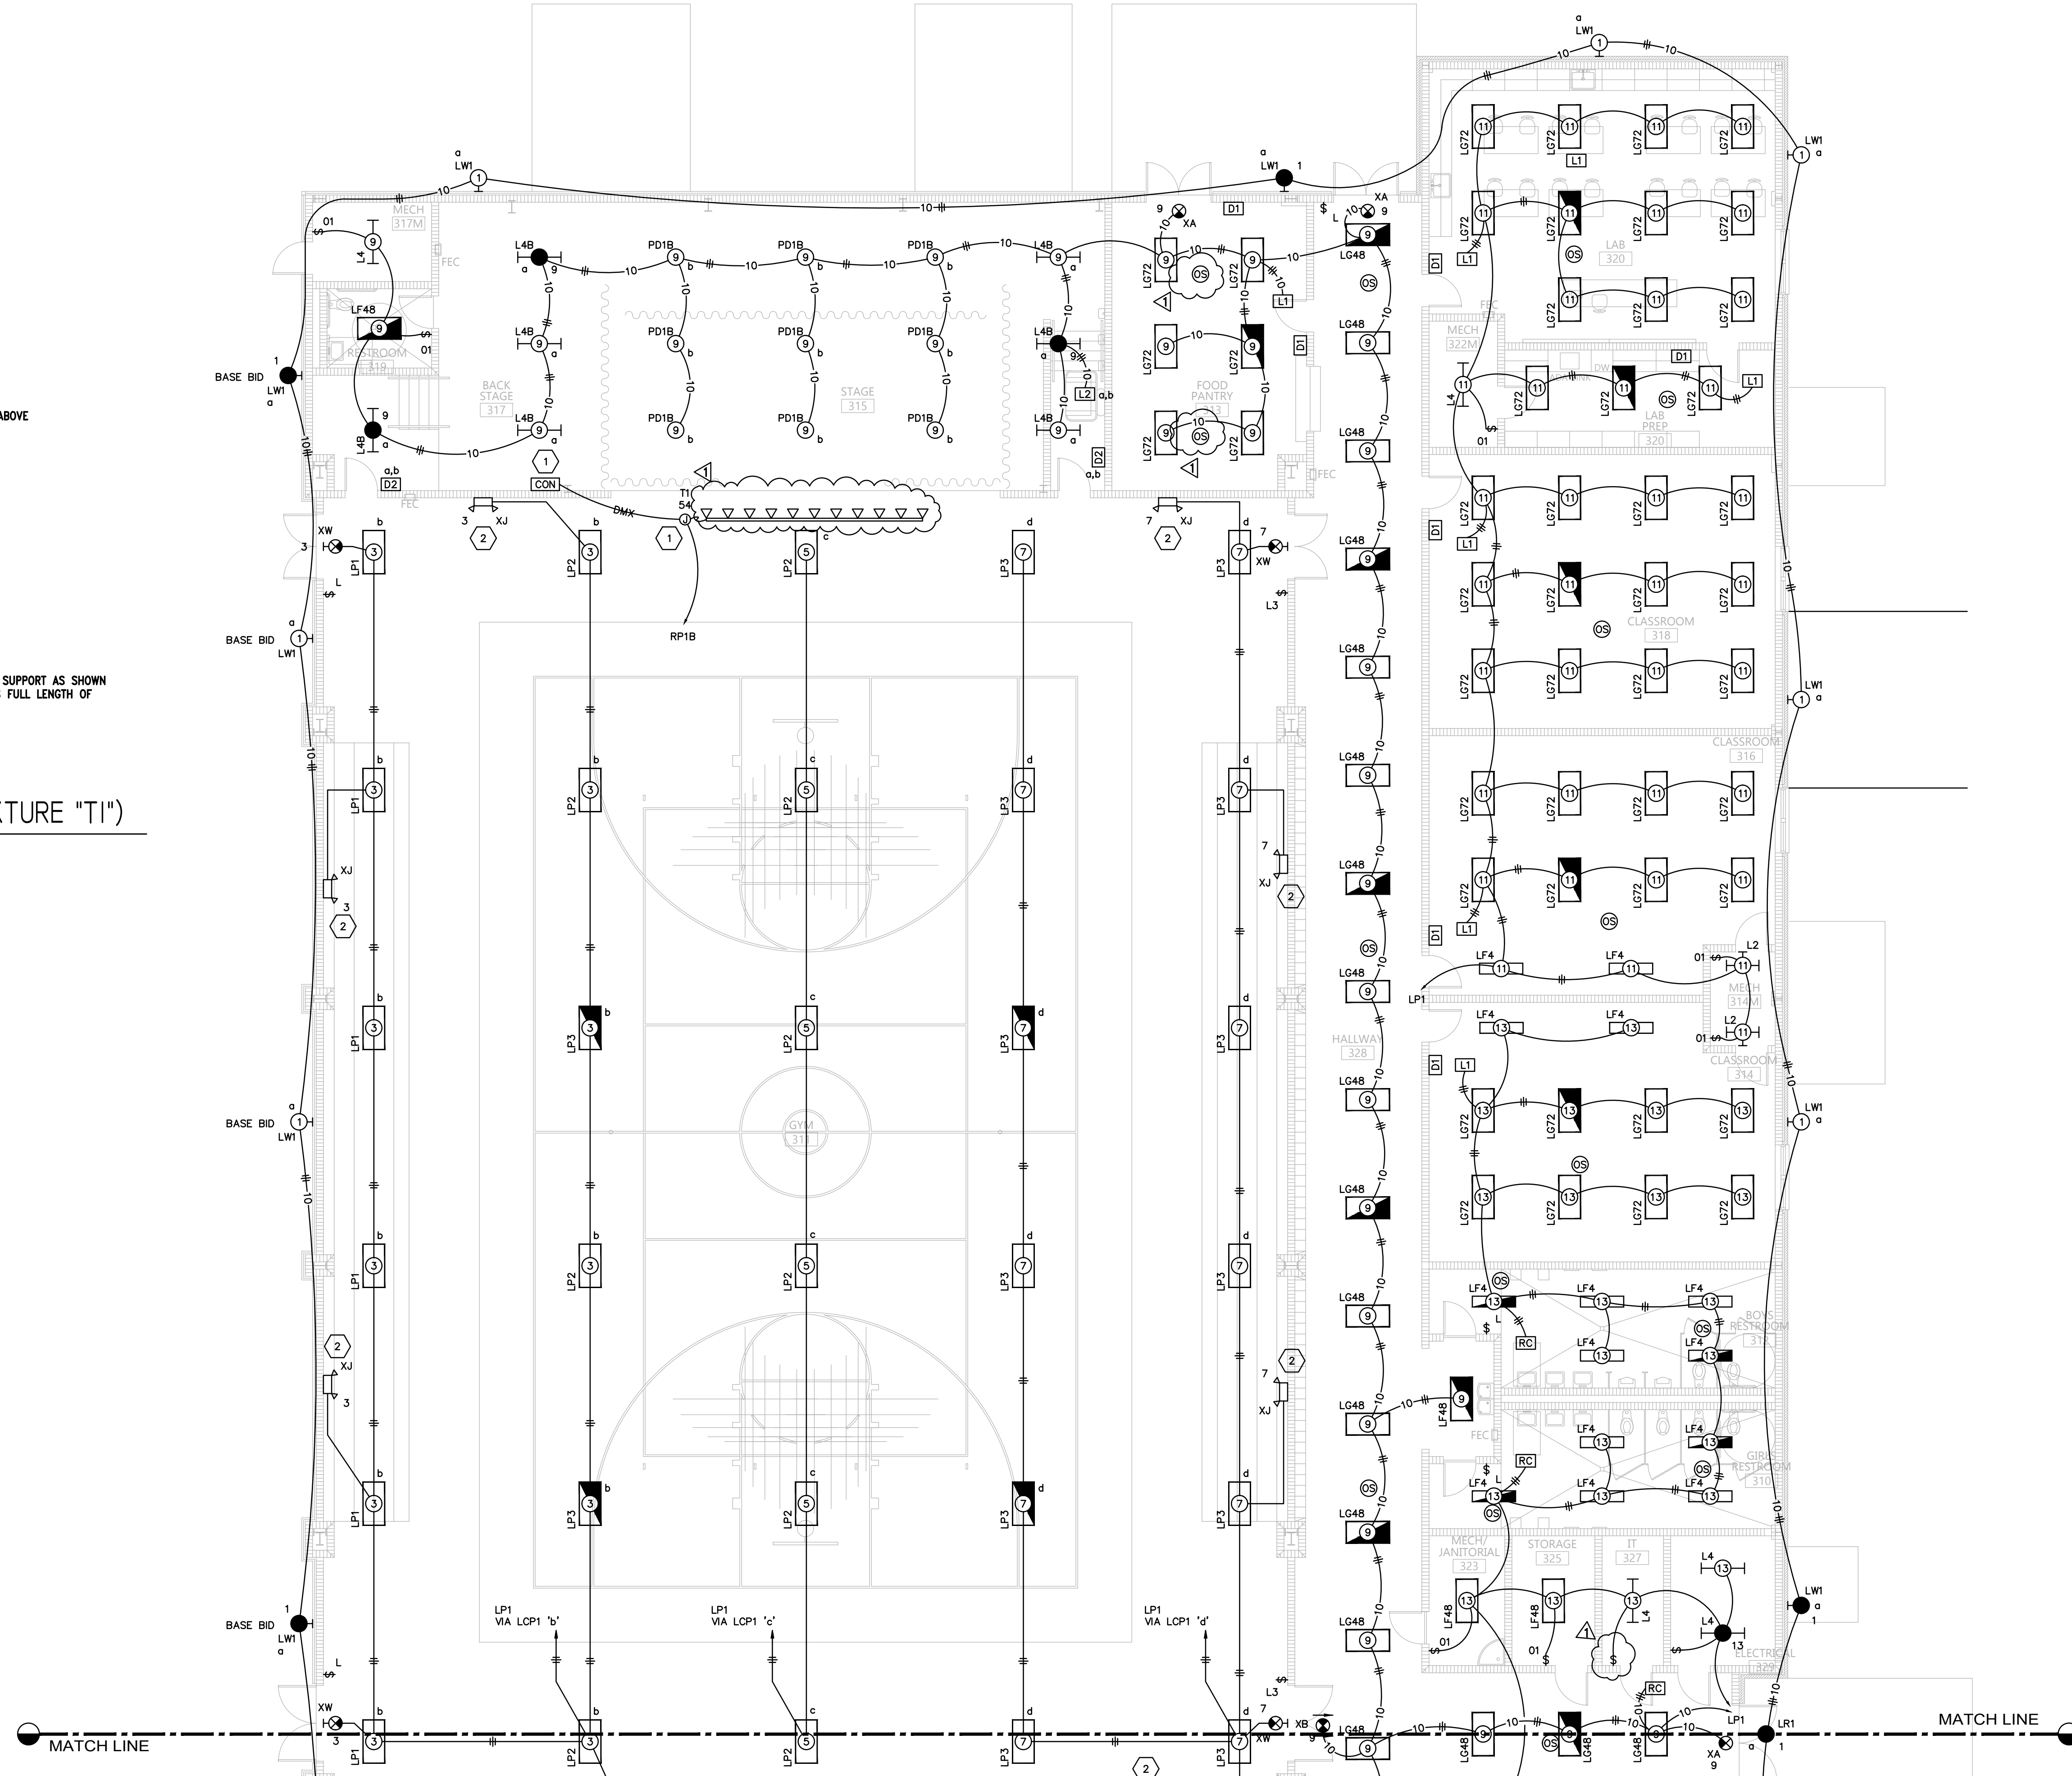


SHEET NOTES:

- 1 WALL MOUNTED DMX CONTROLLER FOR RGB TRACK LIGHTING PROVIDE BRANCH CIRCUITING AS RECOMMENDED BY MANUFACTURER.
- 2 PROVIDE WIREGUARD FOR ALL EQUIPMENT IN GYMNASIUM.




FLOOR PLAN - NORTH - LIGHTING

SCALE: 1/8" = 1'-0"


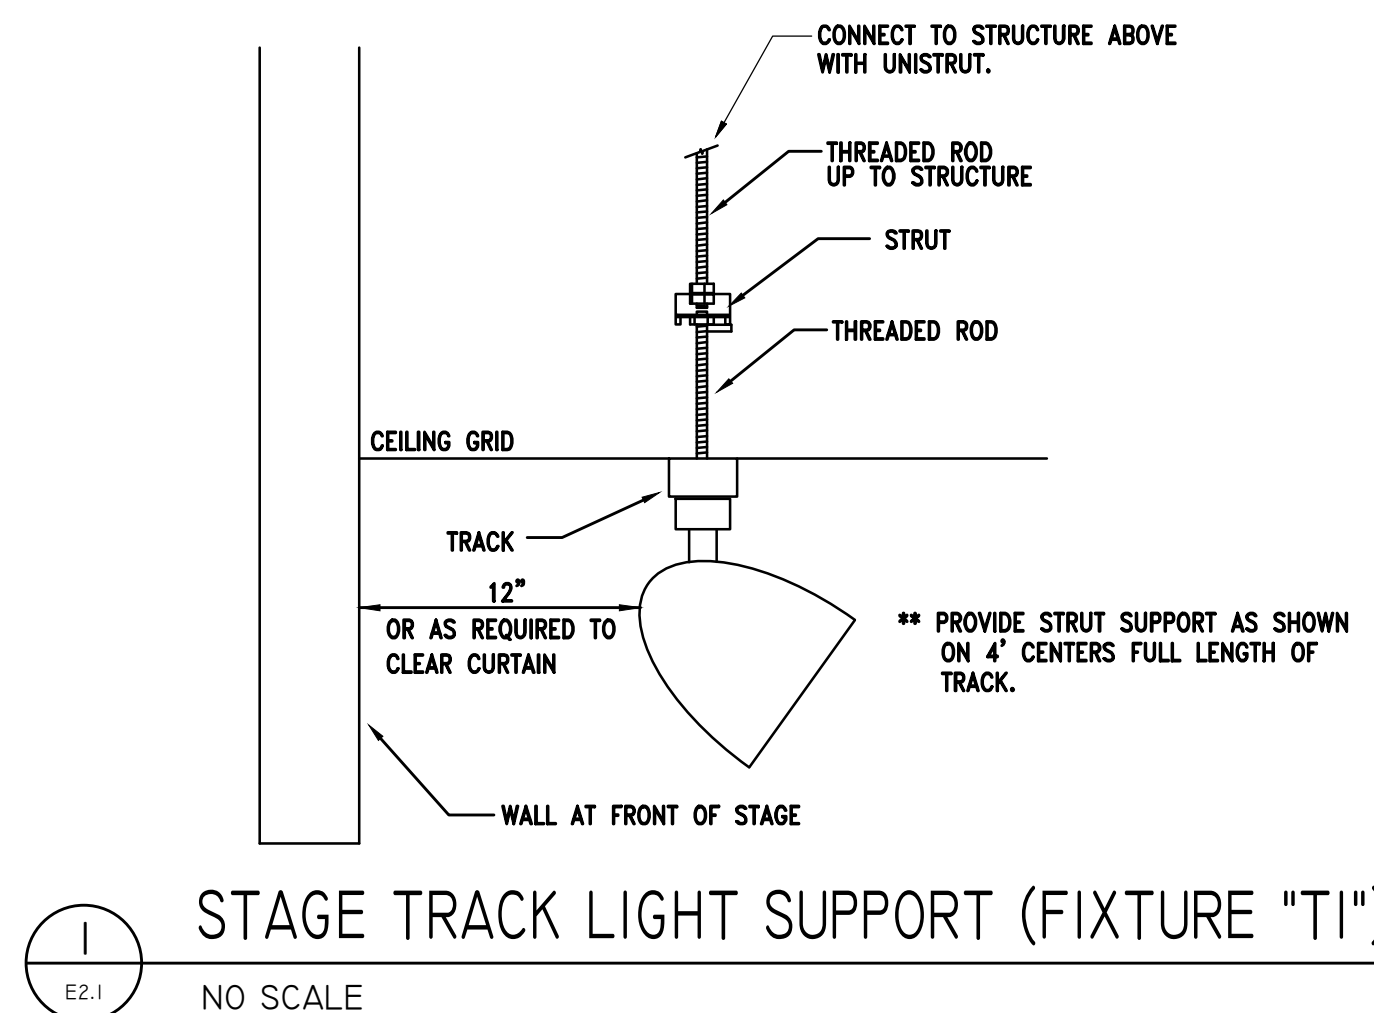
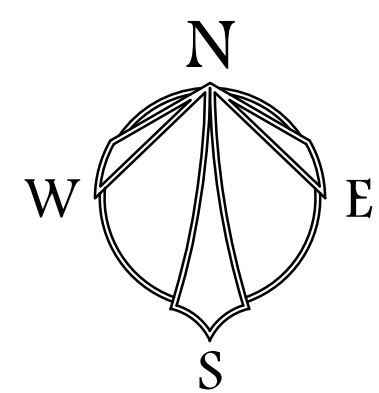


STORM SHELTER:
CONTRACTOR SHALL INSTALL ALL CONDUITS ENTERING OR EXITING THE STORM SHELTER UNDERGROUND SUCH THAT THEY DO NOT PENETRATE THE STORM SHELTER WALLS OR CEILING. IF A PENETRATION IS REQUIRED, THEN THERE SHALL BE NO PENETRATION GREATER THAN 2". ANY PENETRATIONS SHALL CONFORM TO ICC 500.



1. CONTRACTOR SHALL LOCATE ALL ROOM CONTROLLERS ABOVE DOORS IN EACH ROOM 6" ABOVE CEILING GRID. PROVIDE ACCESS PANELS WHERE LOCATED ABOVE HARD CEILINGS OR MOUNT IN UTILITY TYPE ROOMS WHENEVER POSSIBLE. ROOM CONTROLLER SHOWN ON THIS PLAN IS DIAGRAMMATIC FOR CIRCUTRY. DO NOT USE THESE FOR ACTUAL LOCATIONS. PROVIDE A WHITE PHENOLIC LABEL WITH 1" BLACK TEXT THAT READS "RC" GLUED ON CEILING GRID UNDER POWER PACK FOR EACH LOCATION FOR FUTURE MAINTENANCE.

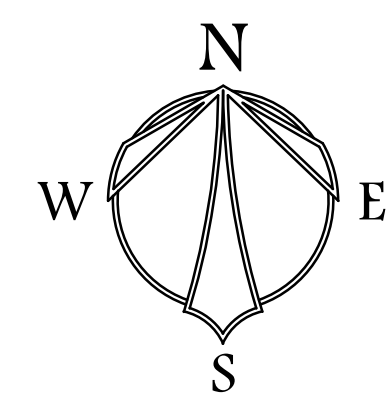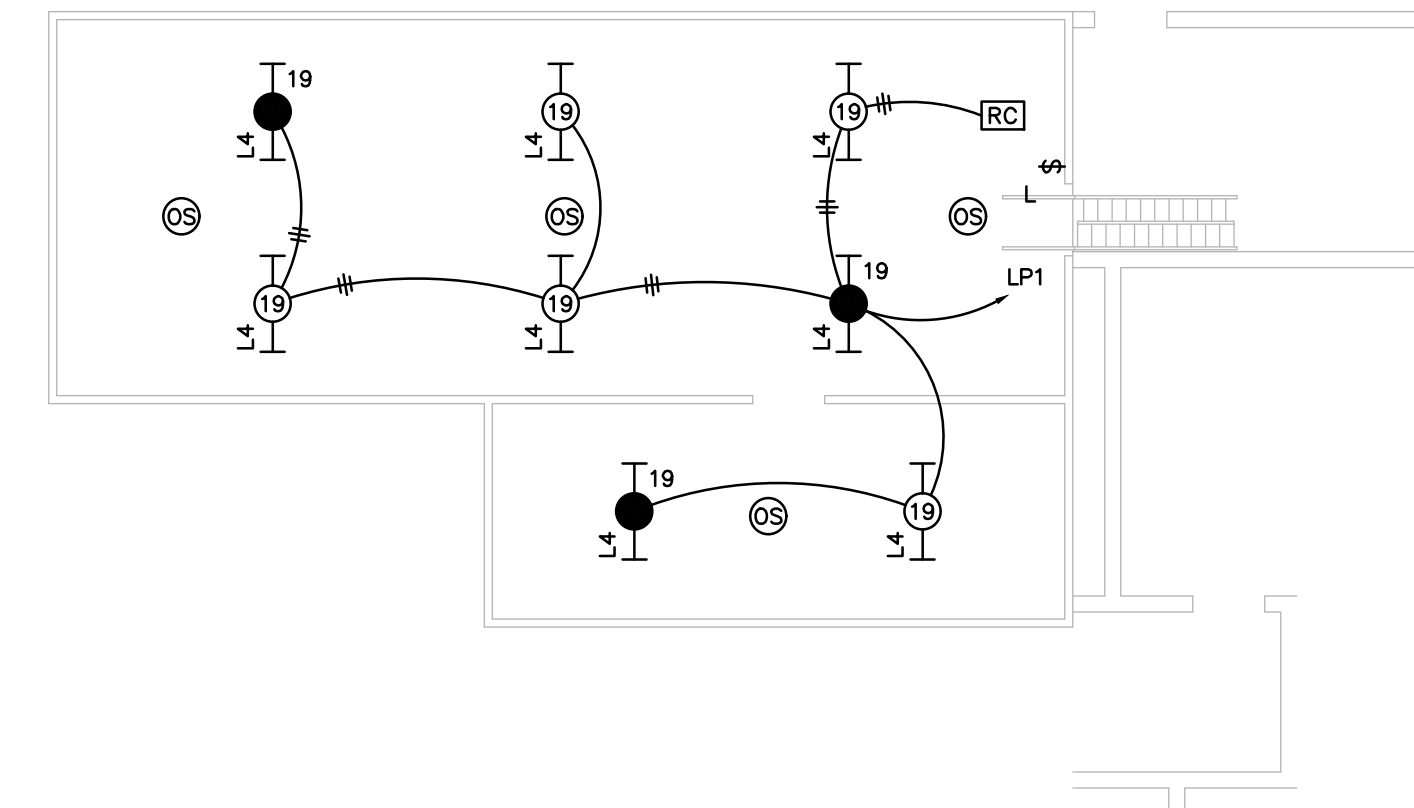

SCALE: 1/8" = 1'-0"

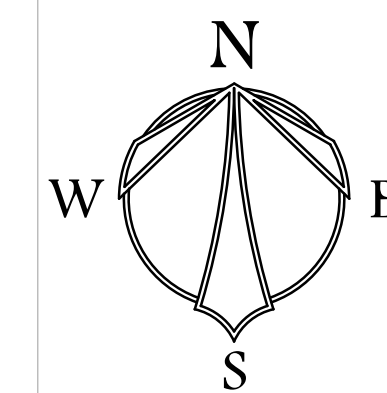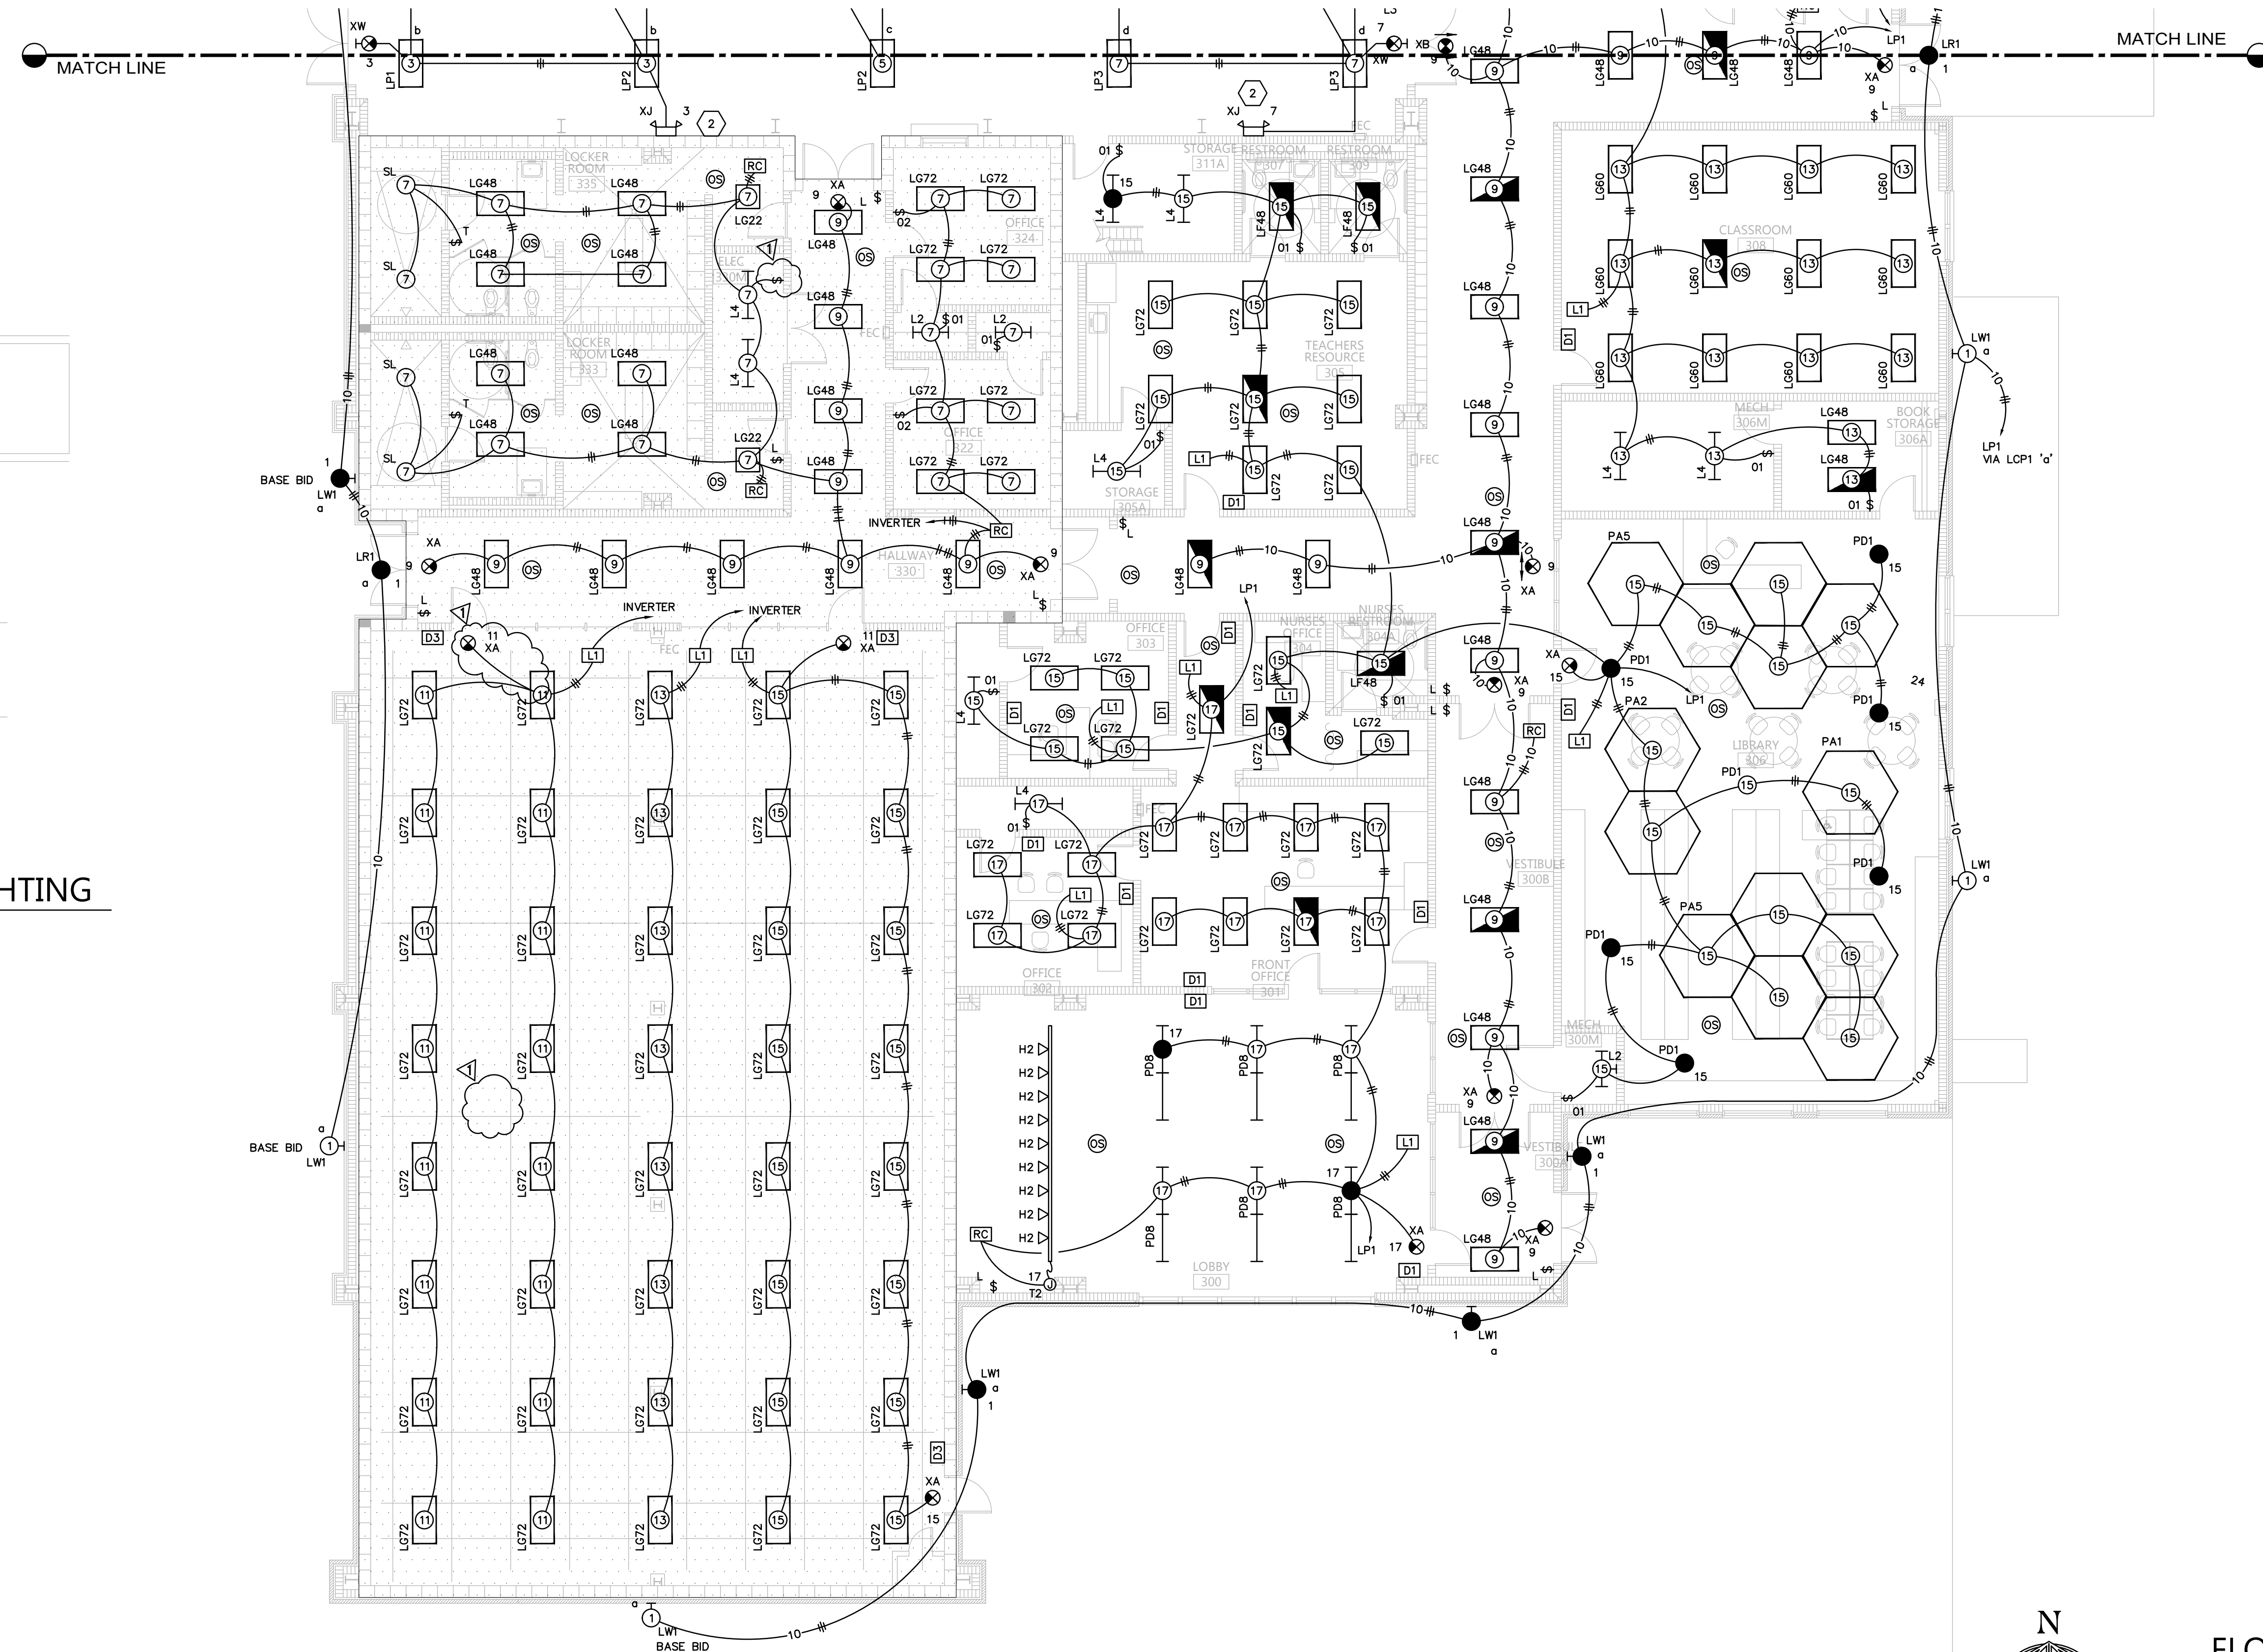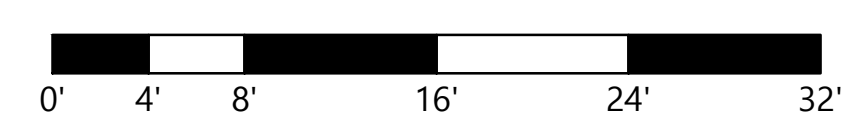


SCALE: 1/8" = 1'-0"

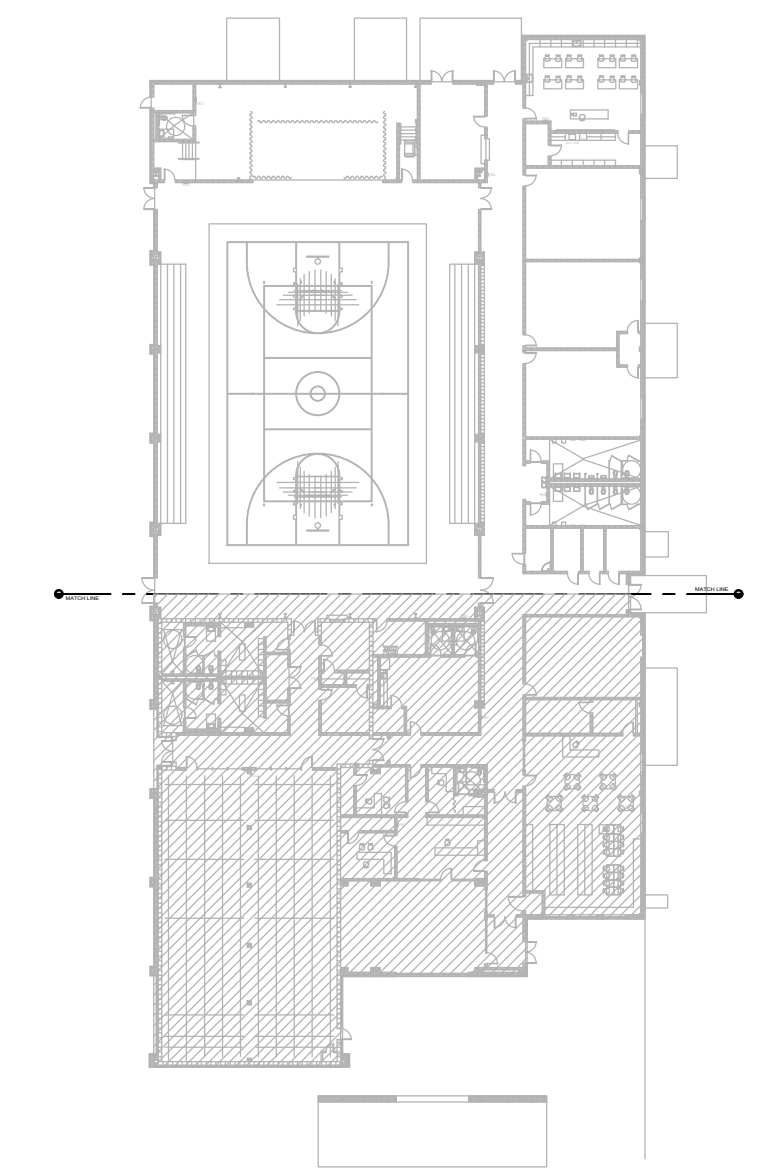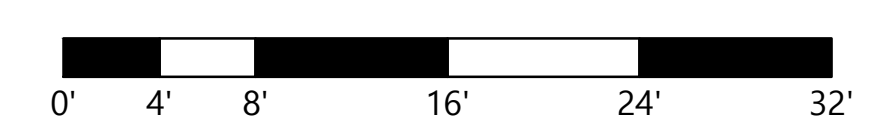

KEY PLAN

HUXFORD ELEMENTARY SCHOOL
GYMNASIUM AND CLASSROOM ADDITION
FOR
ESCAMBIA COUNTY BOARD OF EDUCATION
BREWTON, ALABAMA

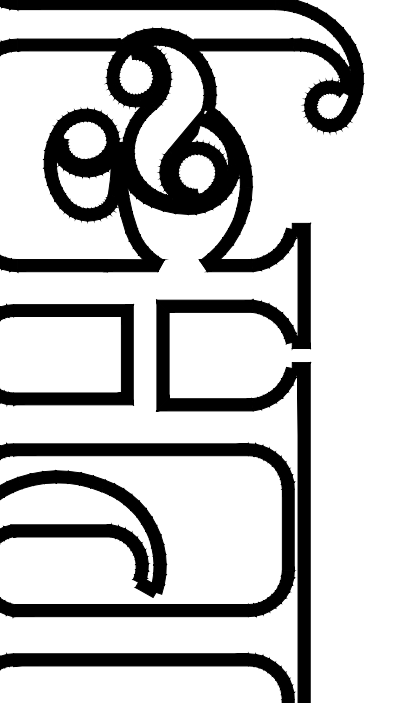

architects inc.
Montgomery, Alabama



AWN: FJP	CHECK: KRG
DATE	05-16-2025
REVISED	7/10/25 ADDENDUM 1
REVISED	

FLOOR PLAN -
OUTH
GHTING

2312SC

2.2

H&J ARCHITECTS, INC.
ALL RIGHTS RESERVED


GA **Gunn & Associates, P.C.**
Consulting Engineers
3102 Highway 14
Millbrook, AL 36054
Tel: 334.285.1273
1200 Providence Park, Suite 200
Birmingham, AL 35242
GA#23-190

ASHRAE 90.1 2013

THE OWNER HAS REQUESTED EXEMPTION FOR THE FOLLOWING SECTIONS OF ASHRAE 90.1 2013.
1. SECTION 8.4.2 AUTOMATIC RECEPTACLE CONTROLS.
2. SECTION 8.4.3 ELECTRIC ENERGY MONITORING.


SHEET NOTES:

- 1 CONTRACTOR SHALL COORDINATE CASEWORK SHOP DRAWINGS AND ADJUST RECEPTACLE LOCATIONS AS REQUIRED.
- 2 POWER FOR SCOREBOARD. COORDINATE EXACT LOCATION AND MOUNTING HEIGHT WITH ARCHITECTURAL PRIOR TO ROUGH-IN.
- 3 PUSHBUTTON CONTROL SWITCH - 3" DEEP SINGLE GANG BOX 48" AFF. PROVIDE WITH PROTECTIVE GUARD.
- 4 PROVIDE POWER FOR STAGE CURTAIN 120V., 20A. COORDINATE LOCATION AND RATING OF CURTAIN AND CURTAIN CONTROLS WITH OWNER PRIOR TO ROUGH-IN.
- 5 CONTRACTOR SHALL PROVIDE 3/4" CONDUIT TO BASKETBALL HOIST CONTROL PANEL.
- 6 CHAIR LIFT, 30A., 120/208V., 1PH., COORDINATE RATING AND CONTROLS WITH CHAIR LIFT VENDOR.
- 7 PROVISIONS FOR ELECTRIC HAND DRYER. MOUNT JUNCTION BOX BEHIND PAPER TOWEL DISPENSER AND WALL BLANK OFF. CIRCUIT BREAKERS FEEDING CIRCUITRY SHALL BE SWITCHED OFF AND WIRE DISCONNECTED.
- 8 TELESCOPING BLEACHER DRIVE. CONTROL SWITCH, CONTACTOR AND LIMIT SWITCHES FURNISHED WITH DRIVE. THE ELECTRICAL CONTRACTOR SHALL INSTALL ALL ELECTRICAL DEVICES, CONDUIT, CONTROL CIRCUITING AND POWER CIRCUITING. VERIFY THE LOCATIONS OF ALL DEVICES AND EQUIPMENT AND CIRCUITING REQUIREMENTS PRIOR TO ROUGH-IN.
- 9 PUSHBUTTON CONTROL SWITCH - 3" DEEP SINGLE GANG BOX 48" A.F.F. PROVIDE WITH PROTECTIVE GUARD.

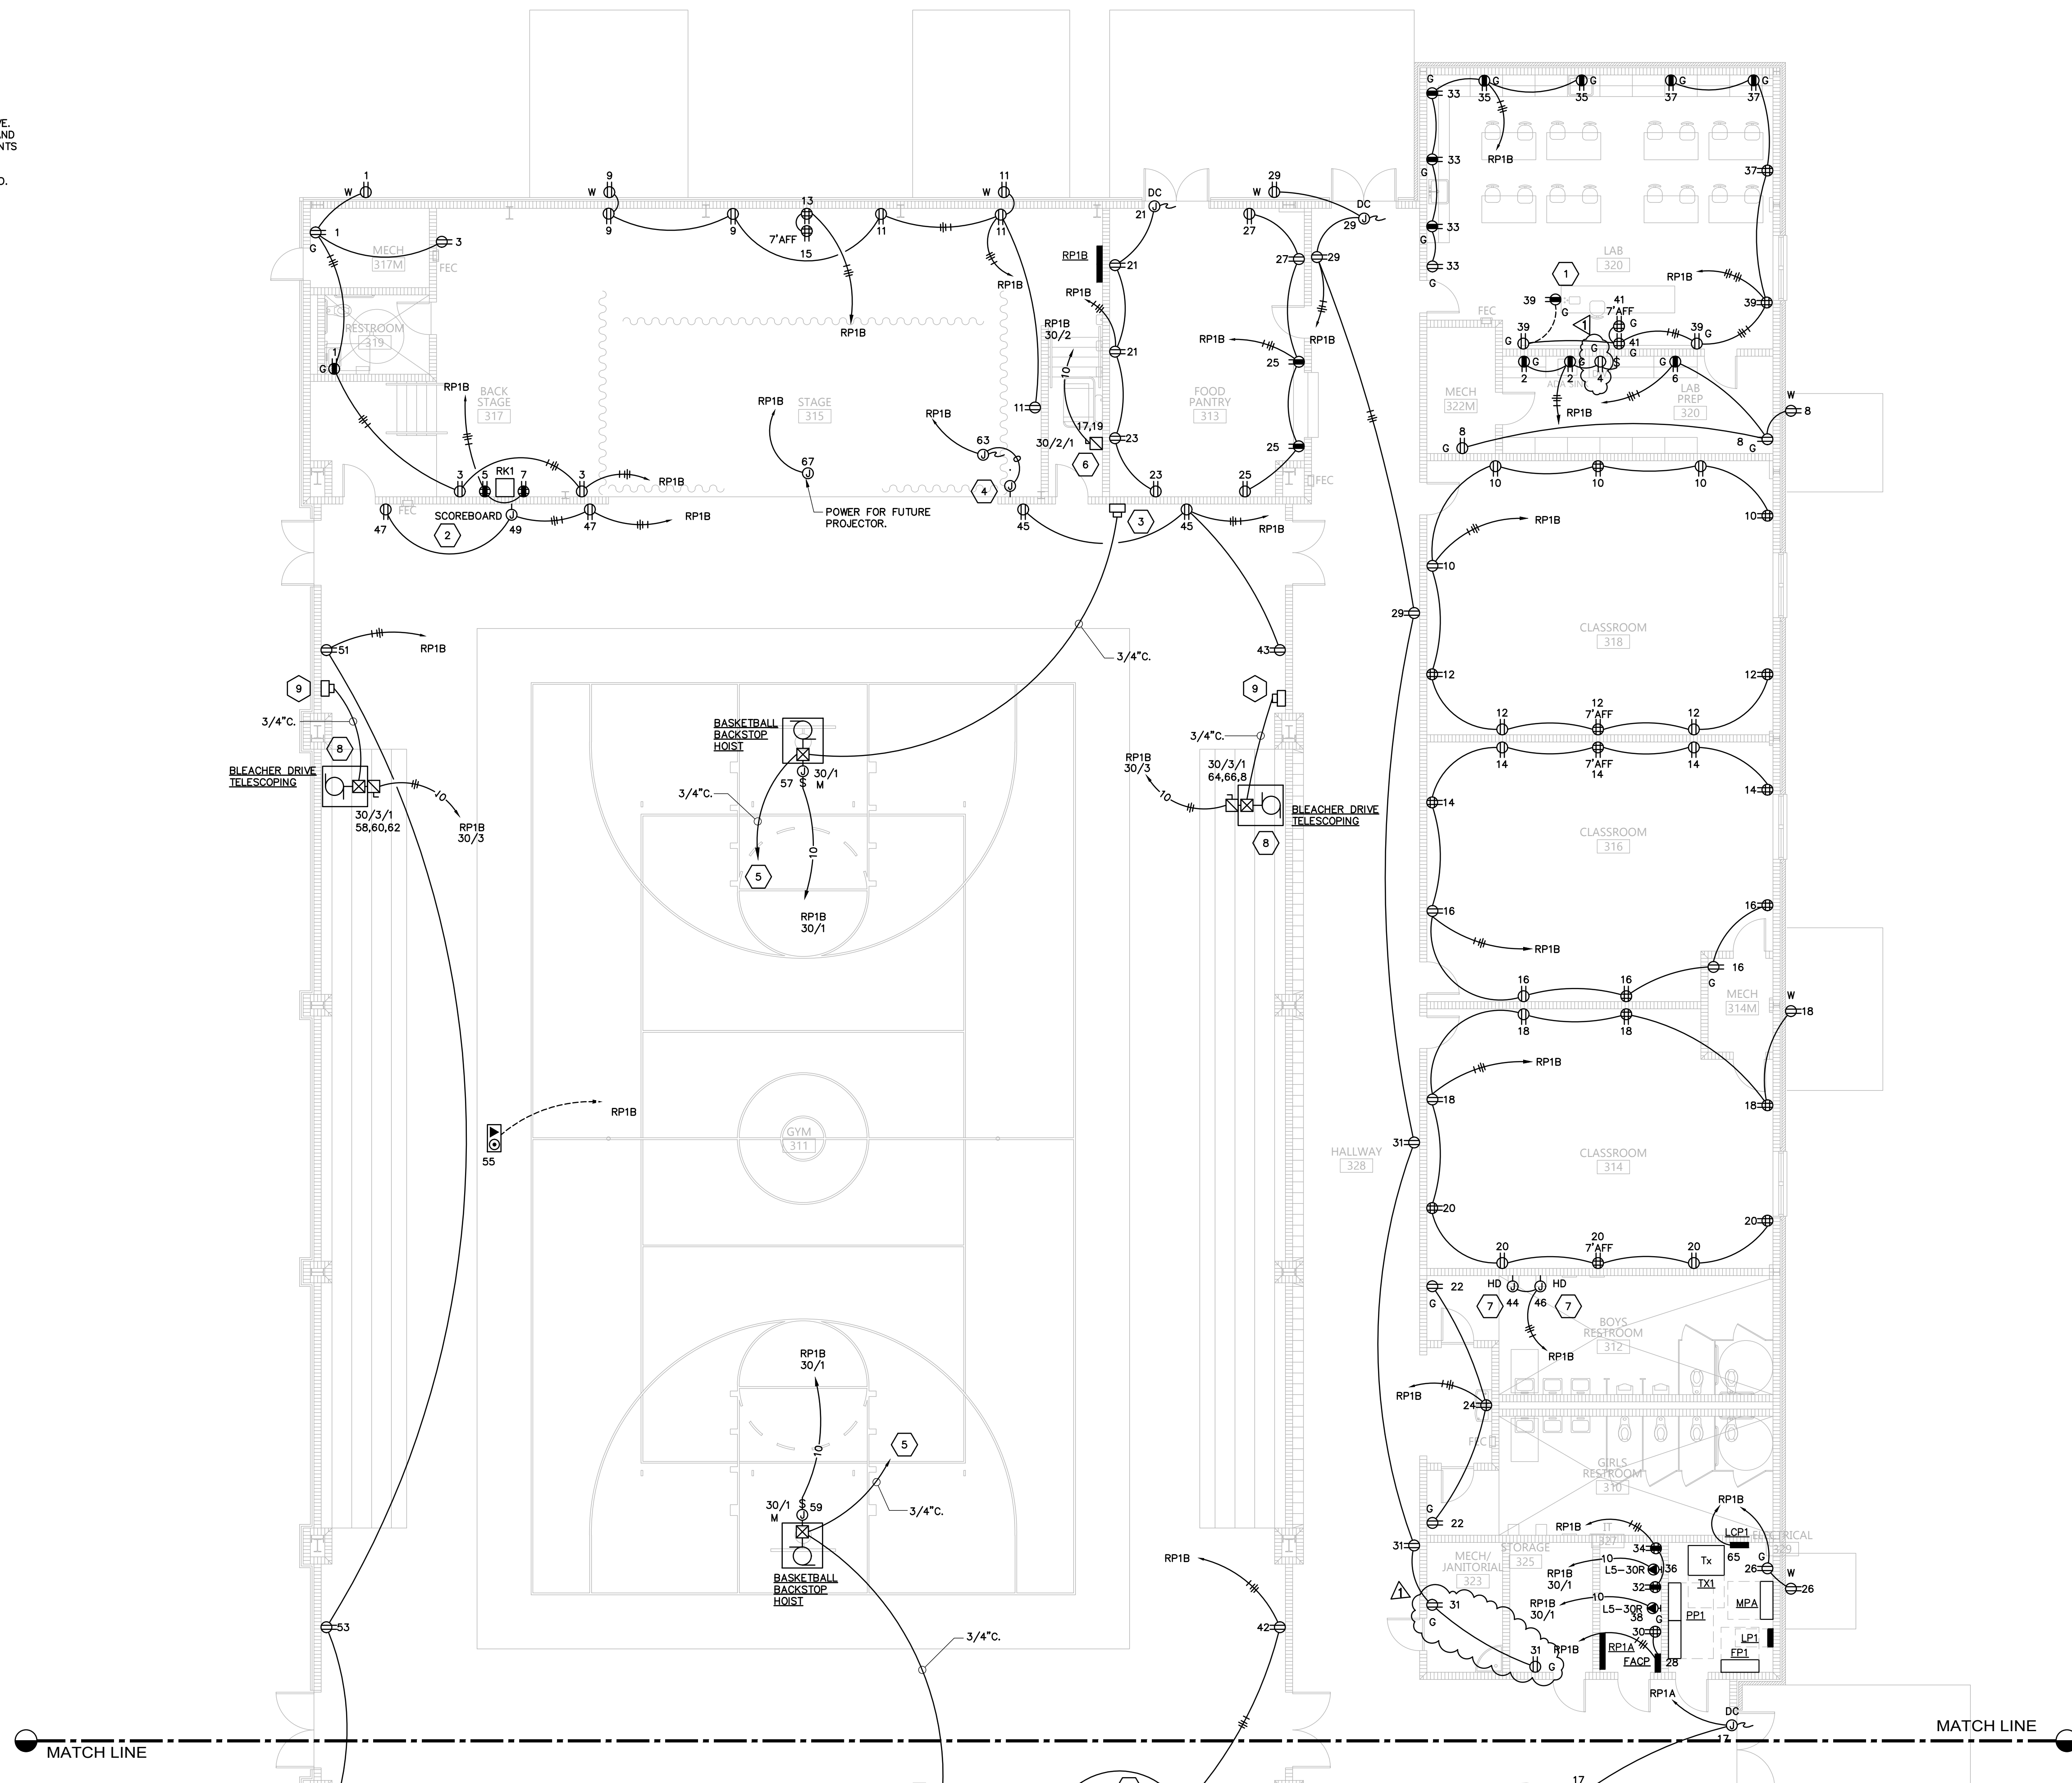

STORM SHELTER



STORM SHELTER:
CONTRACTOR SHALL INSTALL ALL CONDUITS ENTERING OR EXITING THE STORM SHELTER UNDERGROUND SUCH THAT THEY DO NOT PENETRATE THE STORM SHELTER WALLS OR CEILING. IF A PENETRATION IS REQUIRED, THEN THERE SHALL BE NO PENETRATION GREATER THAN 2". ANY PENETRATIONS SHALL CONFORM TO ICC 500.

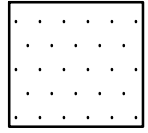


INDICATES AREA OF STORM SHELTER

ROOM CONTROLLER NOTES:

1. CONTRACTOR SHALL LOCATE ALL ROOM CONTROLLERS ABOVE DOORS IN EACH ROOM 6" ABOVE CEILING GRID. PROVIDE ACCESS PANELS WHERE LOCATED ABOVE HARD CEILINGS OR MOUNT IN UTILITY TYPE ROOMS WHENEVER POSSIBLE. ROOM CONTROLLER SHOWN ON THIS PLAN IS DIAGRAMMATIC FOR CIRCUITRY. DO NOT USE THESE FOR ACTUAL LOCATIONS. PROVIDE A WHITE PHENOLIC LABEL WITH 1" BLACK TEXT THAT READS "RC" GLUED ON CEILING GRID UNDER POWER PACK FOR EACH LOCATION FOR FUTURE MAINTENANCE.

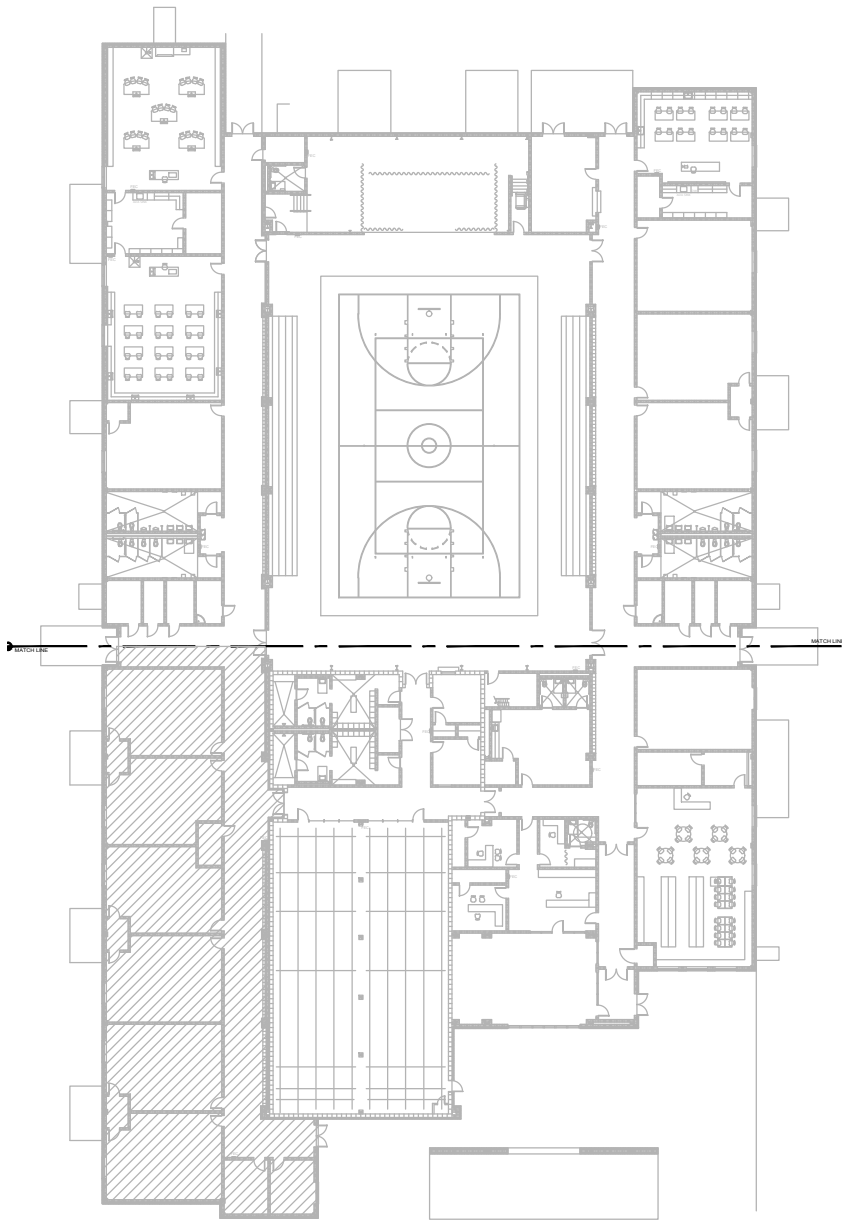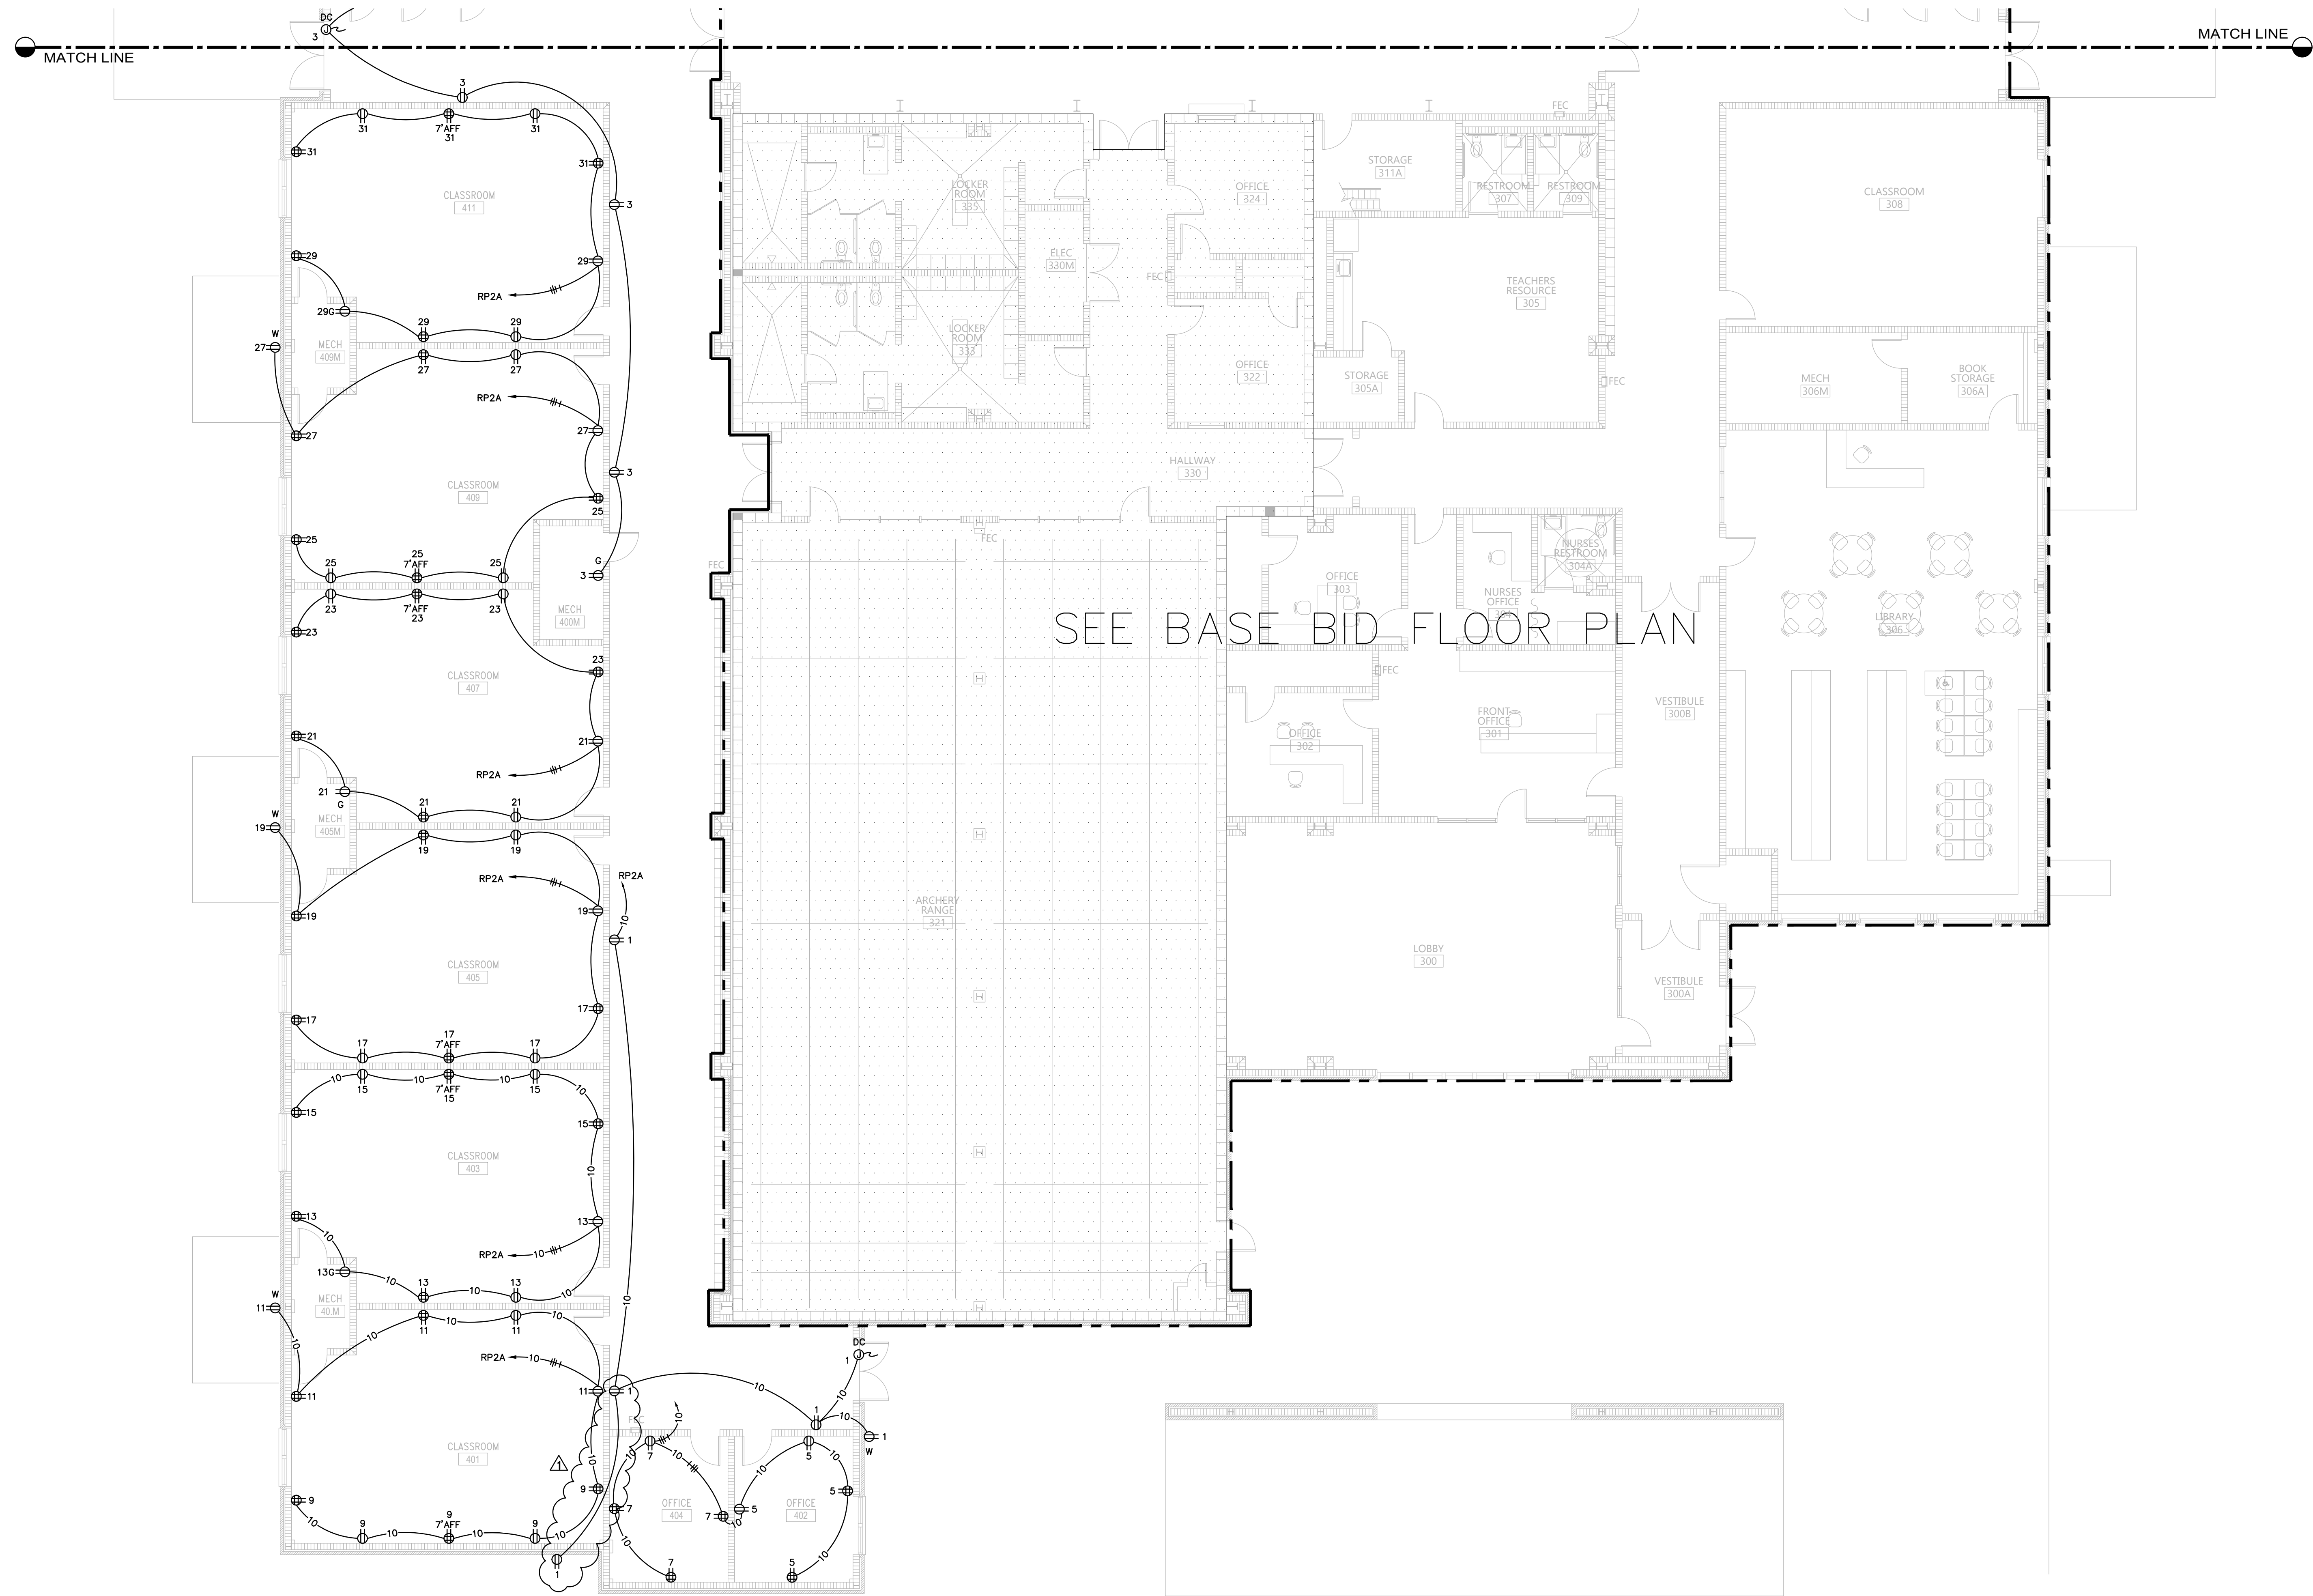


KEY PLAN

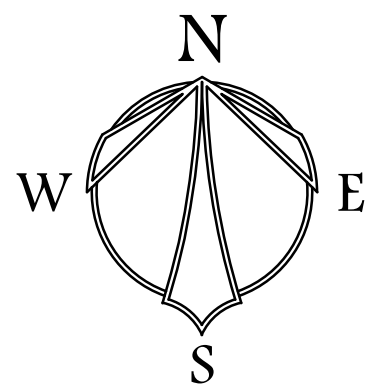


FLOOR PLAN - ALT. SOUTH - POWER

SCALE: 1/8" = 1'-0"

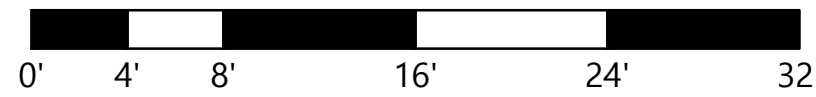

HUXFORD ELEMENTARY SCHOOL
GYMNASIUM AND CLASSROOM ADDITION
FOR
ESCAMBIA COUNTY BOARD OF EDUCATION
BREWTON, ALABAMA

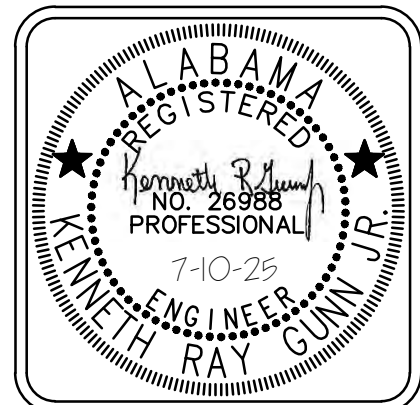


DRAWN: FJP	CHECK: KRG
DATE	05-16-2025
REVISED	
REVISED	

SHEET TITLE	FLOOR PLAN - ALT. SOUTH POWER
JOB NO.	2312SC
SEQUENCE NO.	105 OF 124

E3.4



Gunn & Associates, P.C.
Consulting Engineers
3102 Highway 14
Millbrook, AL 36054
Tel: 334.285.1273
1200 Providence Park, Suite 200
Birmingham, AL 35242
GA#23-190

© PH&J ARCHITECTS, INC.
ALL RIGHTS RESERVED.

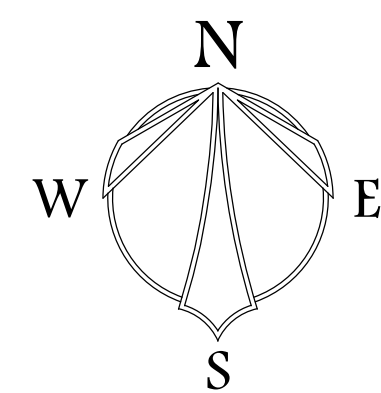


FLOOR PLAN - NORTH - AUXILIARY

SCALE: 1/8" = 1'-0"

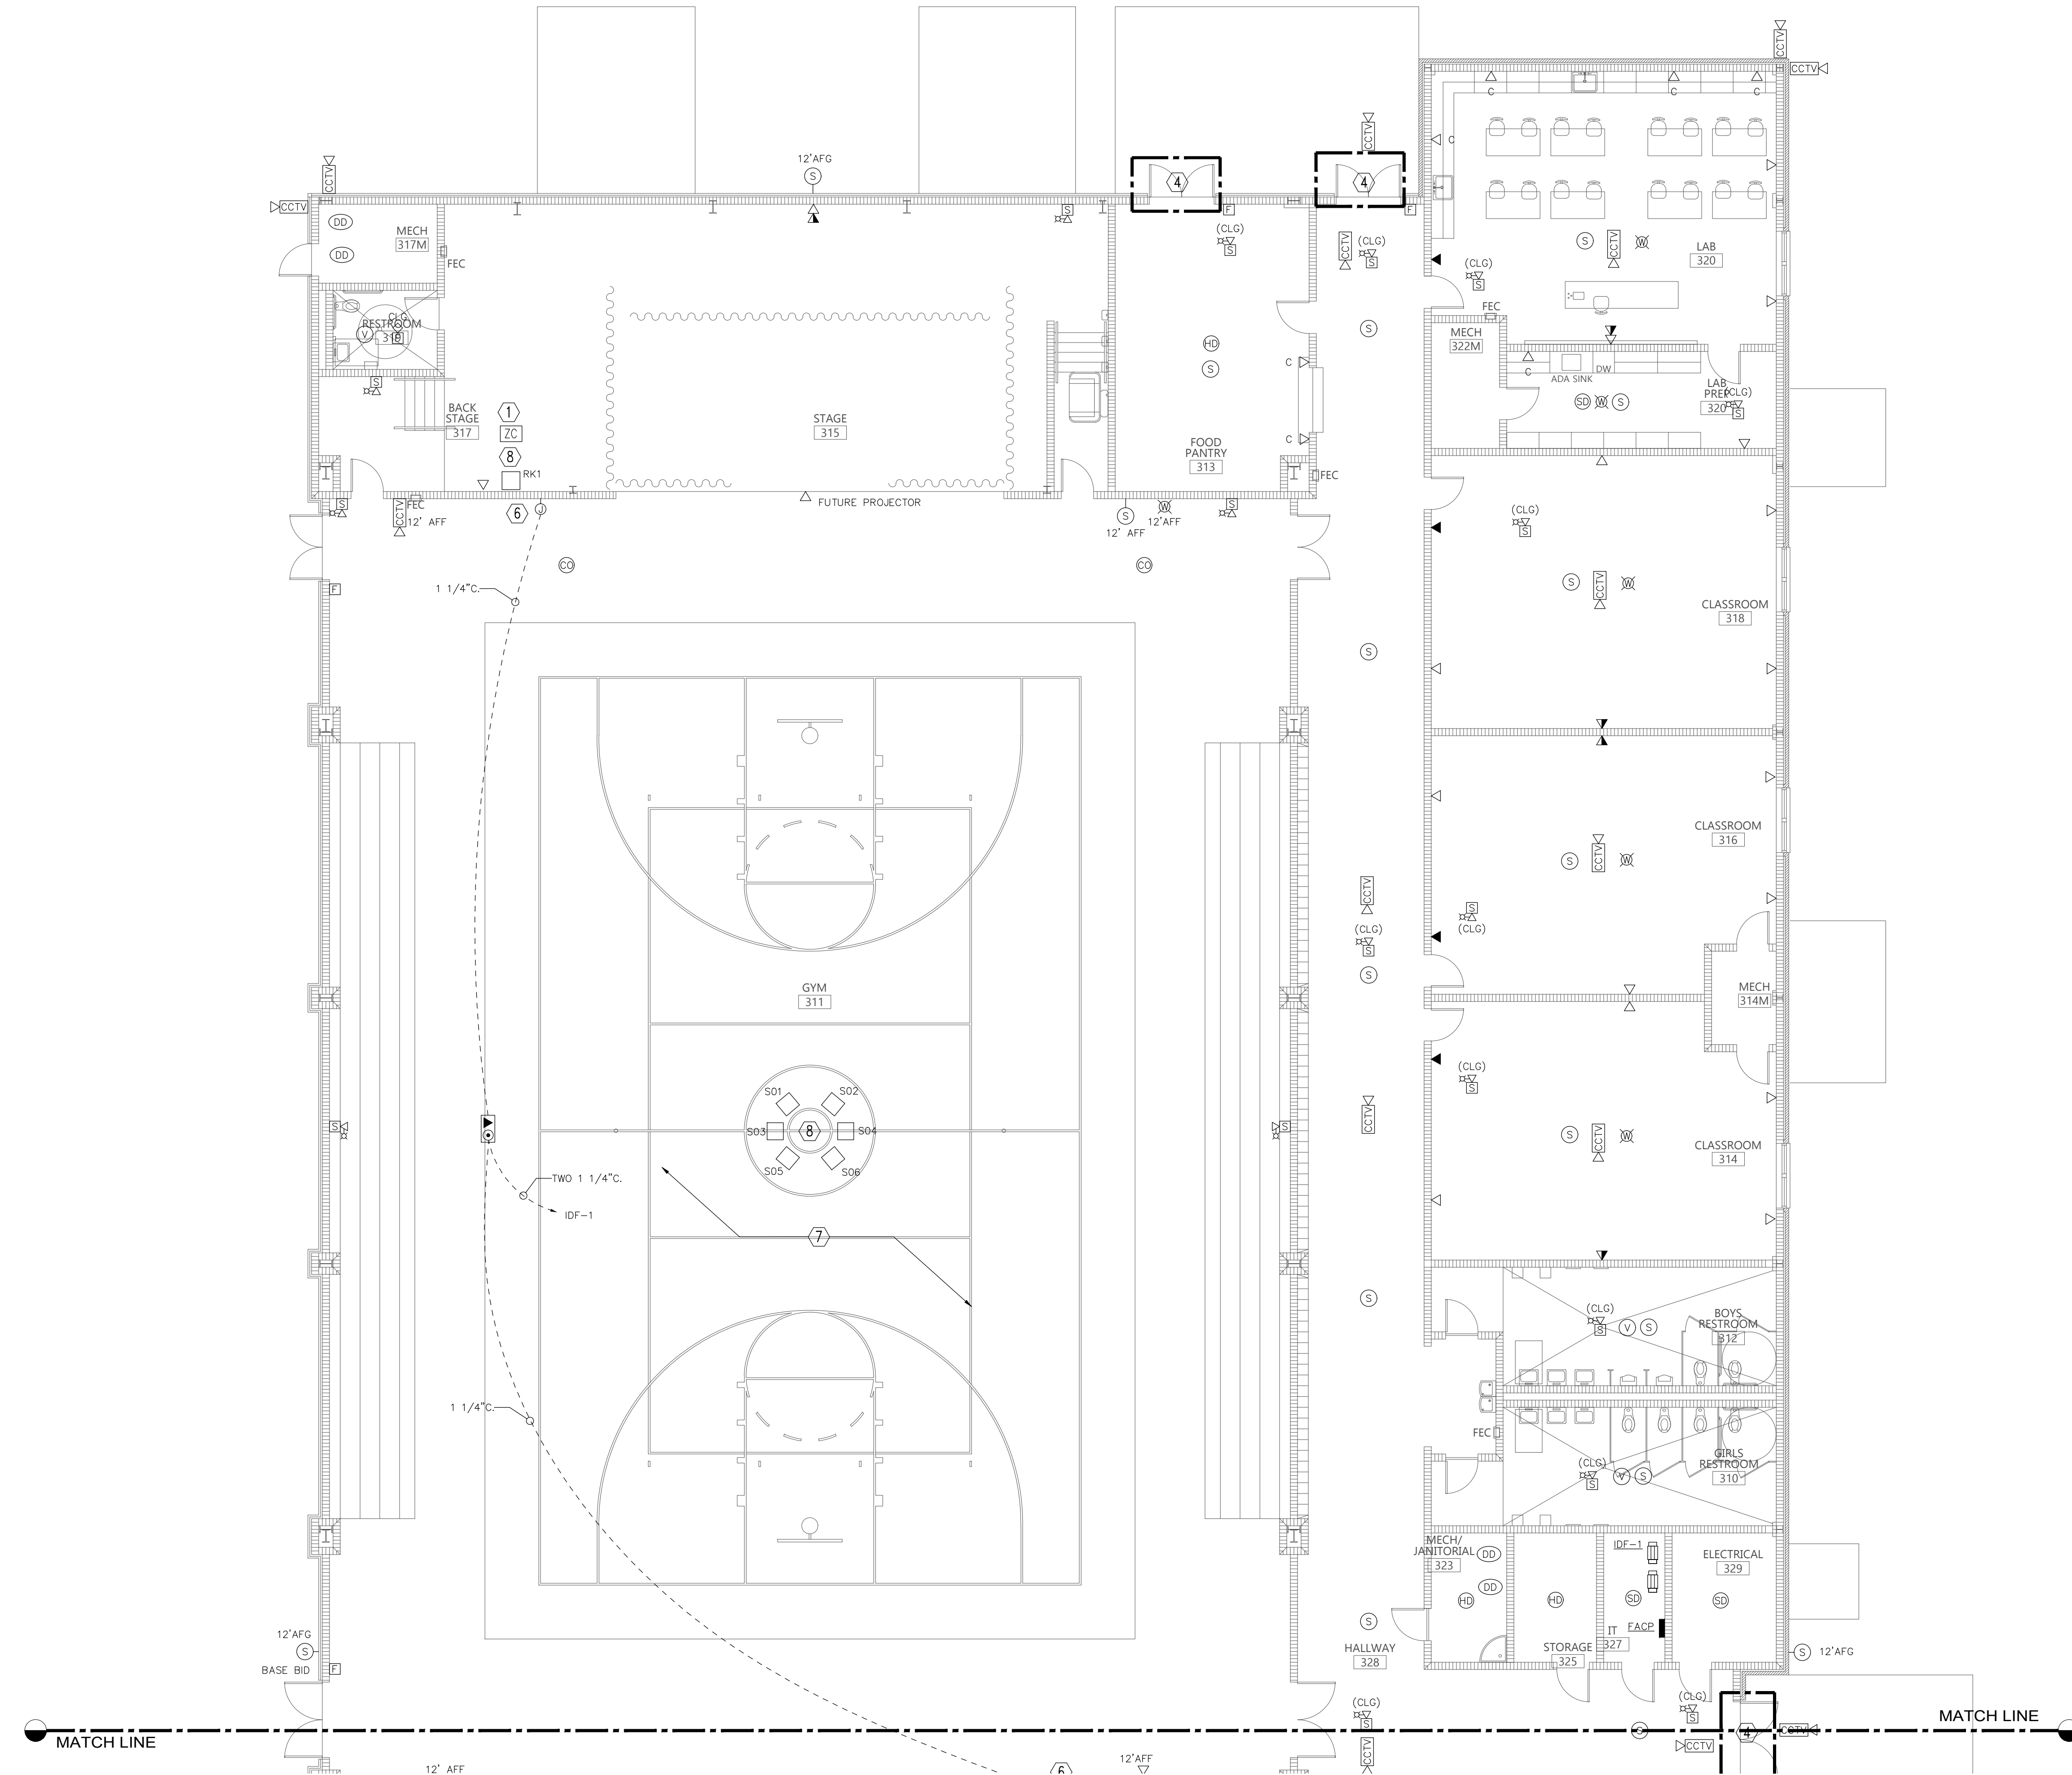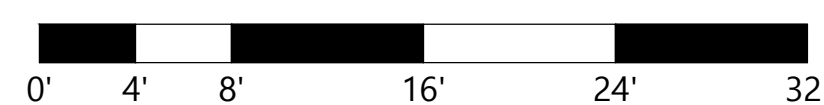


KEYED NOTES:

- 1 PROVIDE FIRE ALARM CONTROL MODULE TO MUTE SOUND SYSTEM UPON FIRE ALARM.
- 2 NOTE USED.
- 3 NOTE USED.
- 4 PROVIDE SECURITY DOOR ROUGH PER TYPICAL DOOR DETAIL B SHEET E8.2.
- 5 NOTE USED.
- 6 PROVISIONS FOR SCOREBOARD. VERIFY EXACT MOUNTING HEIGHT WITH ARCHITECT PRIOR TO ROUGH-IN.
- 7 ALL AUXILIARY DEVICES IN GYMNASIUM SHALL BE PROVIDED WITH WIREGUARD.
- 8 SEE SOUND SYSTEM DIAGRAM SHEET E4.7 FOR ADDITIONAL INFORMATION AND REQUIREMENTS.

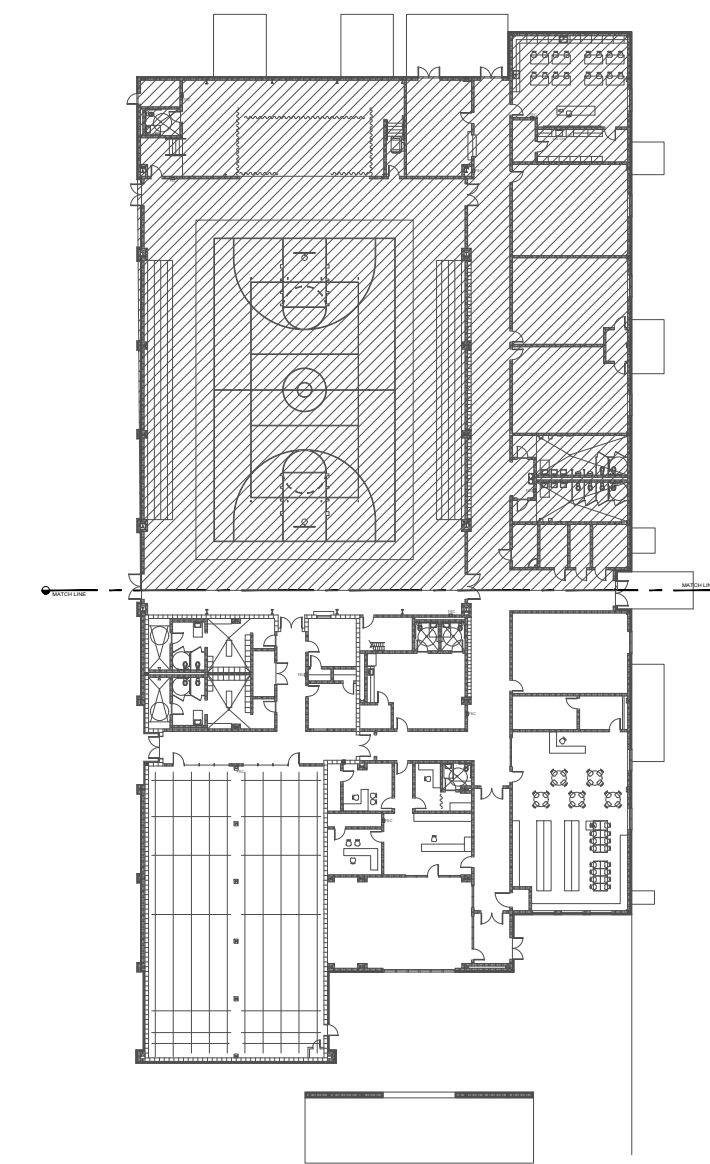


KEY PLAN

HUXFORD ELEMENTARY SCHOOL
GYMNASIUM AND CLASSROOM ADDITION
FOR
ESCAMBIA COUNTY BOARD OF EDUCATION
BREWTON, ALABAMA

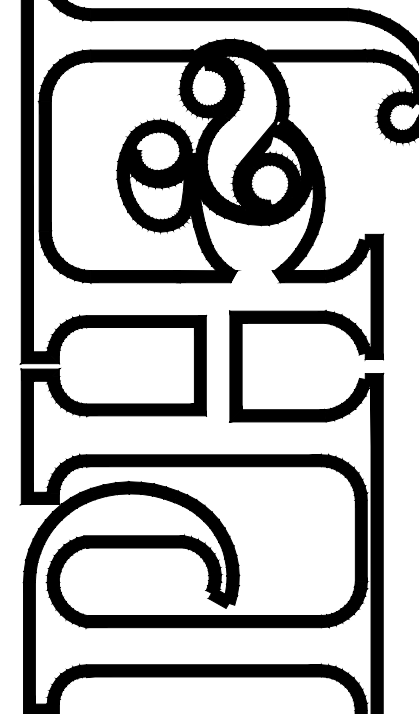

architects inc.
Montgomery,
Alabama

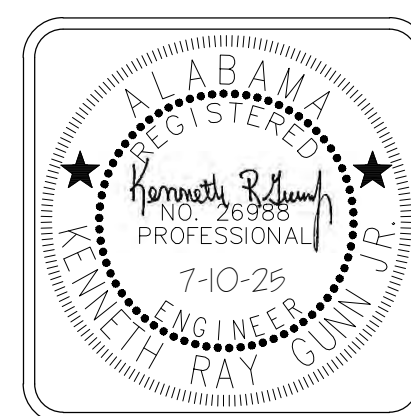

DRAWN: FIP CHECK: KRG
DATE 05-16-2025
REVISED 7/10/25 ADDENDUM 1
REVISED

SHEET TITLE
FLOOR PLAN -
NORTH
AUXILIARY
JOB NO.
2312SC
SEQUENCE
NO. 111 OF 124

E4.1

Gunn & Associates, P.C.
Consulting Engineers
3102 Highway 14
Millbrook, AL 36054
Tel: 334.285.1273
1200 Providence Park, Suite 200
Birmingham, AL 35242
GA#23-190


© PH&J ARCHITECTS, INC.
ALL RIGHTS RESERVED

STORM SHELTER




STORM SHELTER:
CONTRACTOR SHALL INSTALL ALL CONDUITS ENTERING OR EXITING THE STORM SHELTER UNDERGROUND SUCH THAT THEY DO NOT PENETRATE THE STORM SHELTER WALLS OR CEILING. IF A PENETRATION IS REQUIRED, THEN THERE SHALL BE NO PENETRATION GREATER THAN 2". ANY PENETRATIONS SHALL CONFORM TO ICC 500.

ROOM CONTROLLER NOTES:

1. CONTRACTOR SHALL LOCATE ALL ROOM CONTROLLERS ABOVE DOORS IN EACH ROOM 6" ABOVE CEILING GRID. PROVIDE ACCESS PANELS WHERE LOCATED ABOVE HARD CEILINGS OR MOUNT IN UTILITY TYPE ROOMS WHENEVER POSSIBLE. ROOM CONTROLLER SHOWN ON THIS PLAN IS DIAGRAMMATIC FOR CIRCUITRY. DO NOT USE THESE FOR ACTUAL LOCATIONS. PROVIDE A WHITE PHENOLIC LABEL WITH 1" BLACK TEXT THAT READS "RC" GLUED ON CEILING GRID UNDER POWER PACK FOR EACH LOCATION FOR FUTURE MAINTENANCE.

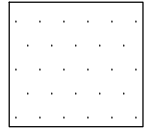

INDICATES AREA OF STORM SHELTER

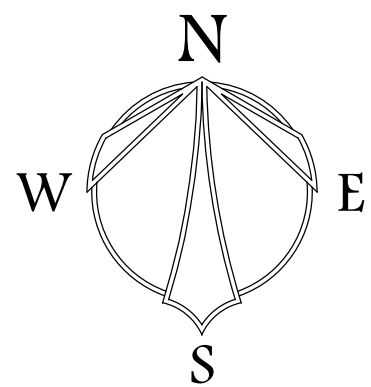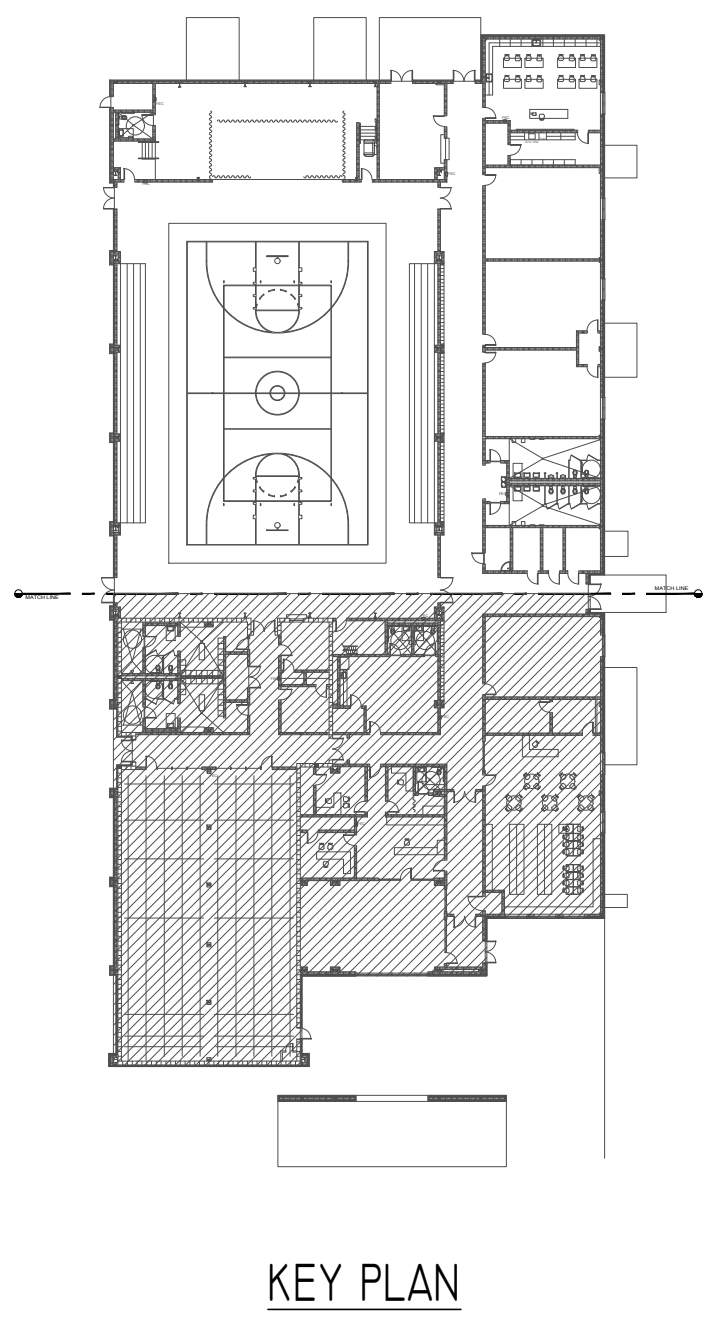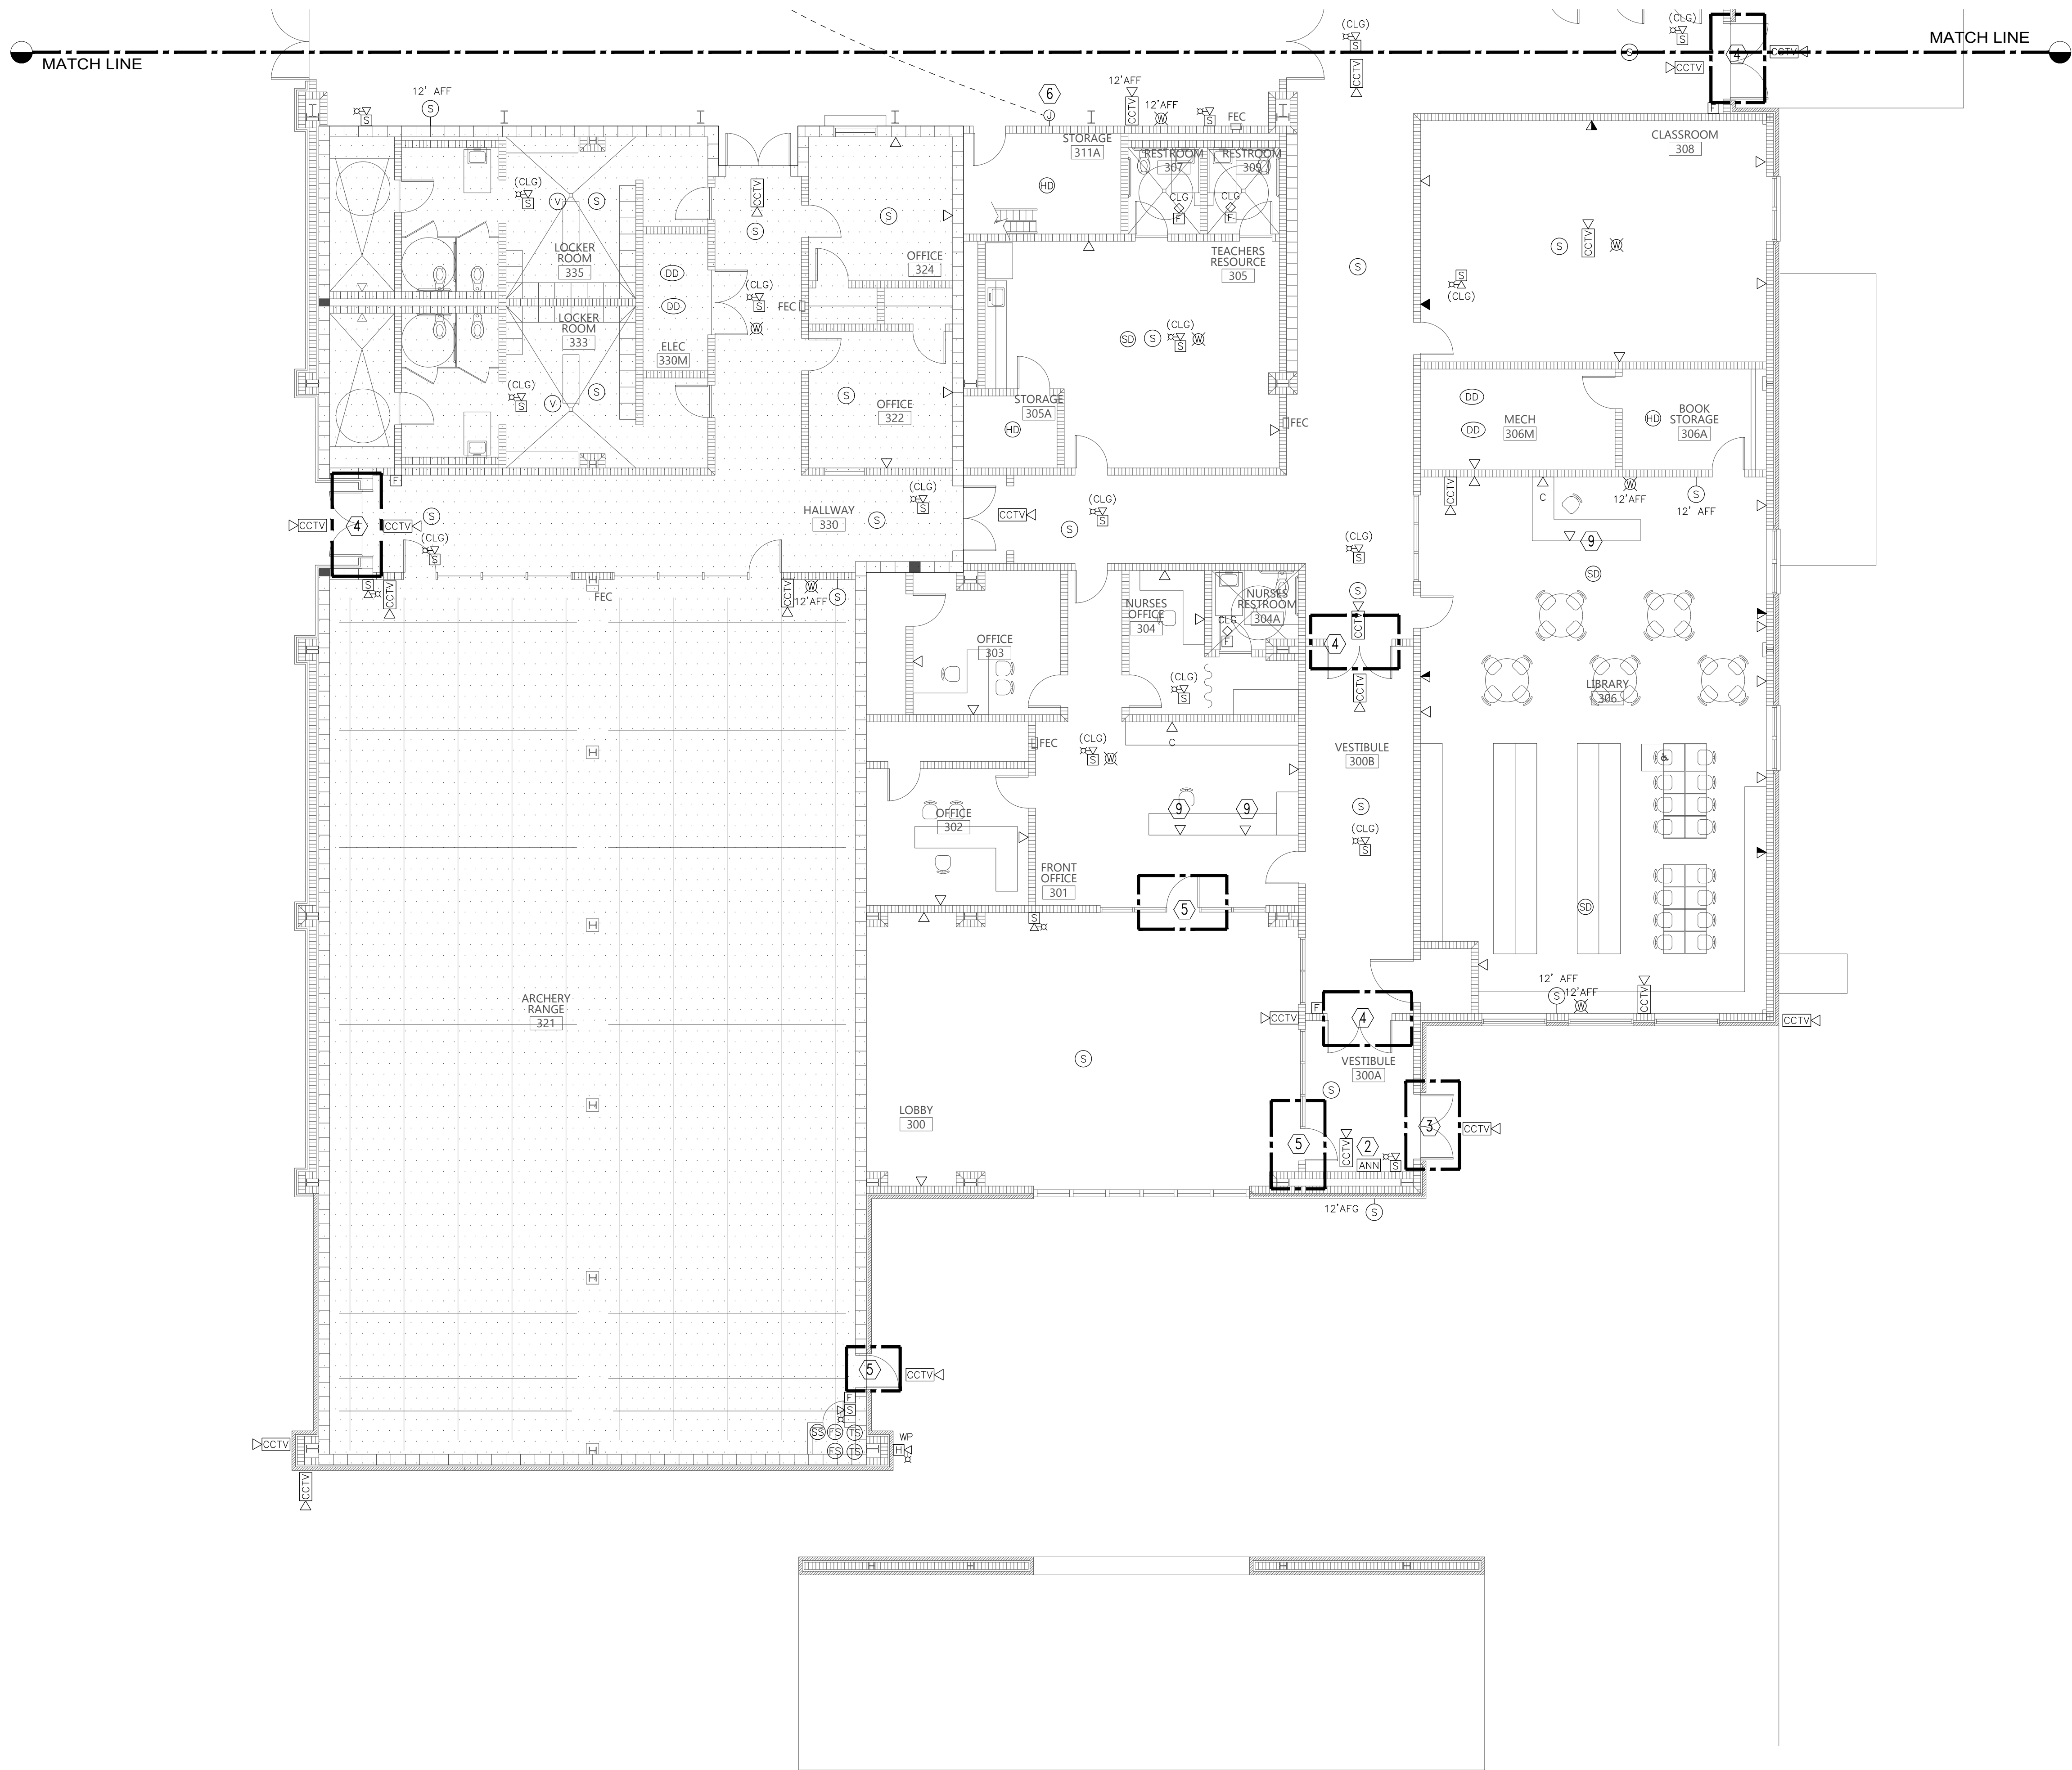

FLOOR PLAN - SOUTH - AUXILIARY


SCALE: 1/8" = 1'-0"



KEYED NOTES:

- 1 NOT USED.
2 PROVIDE FLUSH MOUNTING FOR ANNUNCIATOR.
3 PROVIDE SECURITY DOOR ROUGH PER TYPICAL DOOR DETAIL A SHEET E8.2.
4 PROVIDE SECURITY DOOR ROUGH PER TYPICAL DOOR DETAIL B SHEET E8.2.
5 PROVIDE SECURITY DOOR ROUGH PER TYPICAL DOOR DETAIL C SHEET E8.2.
6 PROVISIONS FOR SCOREBOARD. VERIFY EXACT MOUNTING HEIGHT WITH ARCHITECT PRIOR TO ROUGH-IN.
7 NOT USED.
8 NOT USED.
9 MOUNTED IN FURNITURE.

HUXFORD ELEMENTARY SCHOOL
GYMNASIUM AND CLASSROOM ADDITION
FOR
ESCAMBIA COUNTY BOARD OF EDUCATION
BREWTON, ALABAMA

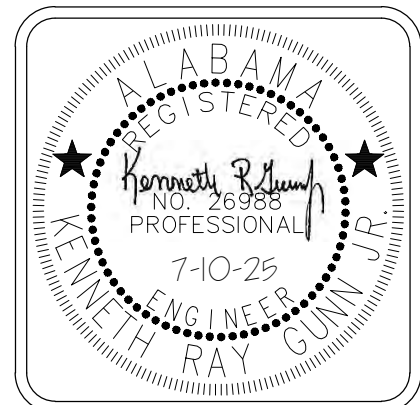

DRAWN: FJP CHECK: KRK
DATE: 05-16-2025
REVISED: 7/10/25 ADDENDUM 1
REVISED:

SHEET TITLE
FLOOR PLAN -
SOUTH
AUXILIARY
JOB NO.
2312SC
SEQUENCE
NO. 112 OF 124

E4.2

Gunn & Associates, P.C.
Consulting Engineers
3102 Highway 14
Millbrook, AL 36054
Tel: 334.285.1273
1200 Providence Park, Suite 200
Birmingham, AL 35242
GA#23-190

© PH&J ARCHITECTS, INC.
ALL RIGHTS RESERVED

PANELBOARD MPA															
TYPE: 1200 AMP MCB SHUNT TRIP				AIC: 65,000 AMPERES				MOUNTED: SURFACE				VOLTAGE: 277/480 VOLTS, 3 PHASE, 4 WIRE			
CIRCUIT DIRECTORY	(VA) PER PHASE			AMP	POLE	CIRCUIT NUMBER	AMP	POLE	(VA) PER PHASE			CIRCUIT DIRECTORY			
	PHASE A	PHASE B	PHASE C						PHASE A	PHASE B	PHASE C				
PP1	123,456			600		1	2	800	134,836			PP2			
		123,456				3	4			137,708					
LP1	7,843			100		7	8	400				SPARE			
		8,302				9	10								
FP1			4,935		3	11	12		3			SPARE			
	49,738			300		13	14	225							
VIA TX1		49,675				15	16								
BUSSED SPACE			50,089		3	17	18					BUSSED SPACE			
				225		19	20	225	3						
BUSSED SPACE						21	22					SPARE			
					3	23	24		3						
BUSSED SPACE				100		25	26	100				SPARE			
						27	28								
BUSSED SPACE					3	29	30		3			BUSSED SPACE			
				100		31	32	100							
BUSSED SPACE						33	34					BUSSED SPACE			
					3	35	36								
BUSSED SPACE				100		37	38	100	3			BUSSED SPACE			
						39	40								
						41	42		3						
					3	41	42								
SUB TOTAL (VA)	180,837	151,433	178,480							134,836	137,708	131,129			
TOTAL LOAD PHASE A:				315,673 (VA)										NOTES: 1. PROVIDE WITH INTEGRAL TVSS WITH 200,000 AMPS PER MODE PROTECTION. 2. PROVIDE PANELBOARD WITH INTEGRAL GROUND FAULT MONITORING. 3. PROVIDE PANEL WITH NAME PLATE INDICATING AIC RATING. SEE DETAILS. 4. PROVIDE ARC FAULT LABEL PER DETAIL DETAILS.	
TOTAL LOAD PHASE B:				319,141 (VA)											
TOTAL LOAD PHASE C:				305,609 (VA)											
TOTAL LOAD:				944,423 (VA) = 1136 AMPS											

PANEL - PP1													
TYPE: 600 AMP MAIN LUGS				AIC: 65,000 AMPERES				MOUNTED: SURFACE				VOLTAGE: 277/480 VOLTS, 3 PHASE, 4 WIRE	
CIRCUIT DIRECTORY	(VA) PER PHASE			AMP	POLE	CIRCUIT NUMBER	AMP	POLE	(VA) PER PHASE			CIRCUIT DIRECTORY	
	PHASE A	PHASE B	PHASE C						PHASE A	PHASE B	PHASE C		
PHAC-A1	13,296			90		1	2	30	4,443			IHP-D1	
		13,296				3	4			4,443			
			13,296			5	6				4,443		
PHAC-A2	13,296			90		7	8	30	5,581			IHP-E1	
		13,296				9	10			5,581			
			13,296			11	12				5,581		
IHP-A1	4,304			30		13	14	30	3,776			IHP-F1	
		4,304				15	16			3,776			
			4,304			17	18				3,776		
IHP-A2	4,304			30		19	20	30	3,776			IHP-G1	
		4,304				21	22			3,776			
			4,304			23	24				3,776		
IHP-A3	4,304			30		25	26	30	3,638			IHP-J1	
		4,304				27	28			3,638			
			4,304			29	30				3,638		
IHP-B1	9,275			50		31	32	50	9,275			IHP-K1	
		9,275				33	34			9,275			
			9,275			35	36				9,275		
IHP-C1	4,443			30		37	38	20	2,271			OHP-A1	
		4,443				39	40			2,271			
			4,443			41	42				2,271		
OHP-A2	2,271			20		43	44	20	1,745			OHP-G1	
		2,271				45	46			1,745			
			2,271			47	48				1,745		
OHP-A3	2,271			20		49	50	20	1,745			OHP-J1	
		2,271				51	52			1,745			
			2,271			53	54				1,745		
OHP-B1	4,570			30		55	56	30	4,570			OHP-K1	
		4,570				57	58			4,570			
			4,570			59	60				4,570		
OHP-C1	2,326			20		61	62	30				SPARE	
		2,326				63	64						
			2,326			65	66						
OHP-D1	2,326			20		67	68	60				SPARE	
		2,326				69	70						
			2,326			71	72						
OHP-E1	2,576			20		73	74	60	11,329			IHP-H1/BASE BID	
		2,576				75	76			11,329			
			2,576			77	78				11,329		
OHP-F1	1,745			20		79	80	100				BUSSED SPACE	
		1,745				81	82						
			1,745			83	84						
SUB TOTAL (VA)	71,307	71,307	71,307						52,149	52,149	52,149	SUB TOTAL (VA)	
TOTAL LOAD PHASE A:		123,456 (VA)											
TOTAL LOAD PHASE B:		123,456 (VA)											
TOTAL LOAD PHASE C:		123,456 (VA)											
TOTAL LOAD:		370,368 (VA) = 446 AMPS											
NOTES: 1. PANELBOARD TO BE BOLT-ON TYPE WITH DOOR-IN-DOOR CONSTRUCTION. 2. PROVIDE ARC FAULT LABEL PER DETAIL.													

PANEL - LP1

TYPE: 100 AMP MAIN LUGS				AIC: 65,000 AMPERES				MOUNTED: SURFACE				VOLTAGE: 277/480 VOLTS, 3 PHASE, 4 WIRE			
CIRCUIT DIRECTORY	(VA) PER PHASE			AMP	POLE	CIRCUIT NUMBER	AMP	POLE	(VA) PER PHASE			CIRCUIT DIRECTORY			
	PHASE A	PHASE B	PHASE C						PHASE A	PHASE B	PHASE C				
LIGHTS VIA LCP1 'a'	990			20	1	1	20	1	1,575			LIGHTS VIA LCP1 'e'			
LIGHTS VIA LCP1 'b'		1,922		20	1	3	20	1		1,575		LIGHTS VIA LCP1 'f'			
LIGHTS VIA LCP1 'c'			1,044	20	1	5	50	1				BUSSED SPACE			
LIGHTS VIA LCP1 'd'	2,602			20	1	7	8	50	1			BUSSED SPACE			
LIGHTS		2,393		20	1	9	10	50	1			BUSSED SPACE			
LIGHTS			2,254	20	1	11	12	50	1			BUSSED SPACE			
LIGHTS	2,092			20	1	13	14	50	1			BUSSED SPACE			
LIGHTS		2,412		20	1	15	16	50	1			BUSSED SPACE			
LIGHTS			1,637	20	1	17	18	50	1			BUSSED SPACE			
LIGHTS	384			20	1	19	20	50	1			BUSSED SPACE			
SPARE				20	1	21	22	50	1			BUSSED SPACE			
SPARE				20	1	23	24	50	1			BUSSED SPACE			
SPARE				20	1	25	26	50	1			BUSSED SPACE			
SPARE				20	1	27	28	50	1			BUSSED SPACE			
SPARE				20	1	29	30	50	1			BUSSED SPACE			
BUSSED SPACE				50	1	31	32	50	1			BUSSED SPACE			
BUSSED SPACE				50	1	33	34	50	1			BUSSED SPACE			
BUSSED SPACE				50	1	35	36	50	1			BUSSED SPACE			
BUSSED SPACE				50	1	37	38	50	1			BUSSED SPACE			
BUSSED SPACE				50	1	39	40	50	1			BUSSED SPACE			
BUSSED SPACE				50	1	41	42	50	1			BUSSED SPACE			
SUB TOTAL (VA)	6,068	6,727	4,935						1,575	1,575	0	SUB TOTAL (VA)			
TOTAL LOAD PHASE A	7,843 (VA)			NOTES: 1. PANELBOARD TO BE BOLT-ON TYPE WITH DOOR-IN-DOOR CONSTRUCTION. 2. PROVIDE ARC FAULT LABEL PER DETAIL.											
TOTAL LOAD PHASE B:	8,302 (VA)														
TOTAL LOAD PHASE C:	4,935 (VA)														
TOTAL LOAD:	20,880 (VA) = 25 AMPS														

PANEL - FP1													
TYPE: 600 AMP MAIN BREAKER				AIC: 22,000 AMPERES				MOUNTED: SURFACE				VOLTAGE: 120/208 VOLTS, 3 PHASE, 4 WIRE	
CIRCUIT DIRECTORY	(VA) PER PHASE			AMP	POLE	CIRCUIT NUMBER	AMP	POLE	(VA) PER PHASE			CIRCUIT DIRECTORY	
	PHASE A	PHASE B	PHASE C						PHASE A	PHASE B	PHASE C		
IDHP-A1	156			20		1	2	225		9,920		RP1A	
		156			2	3	4				7,800		
IDHP-A2			156	20	5	5	6	3			10,060		
	156				2	7	8	225		22,980		RP1B	
ODHP-A1		1,040		20	9	10				22,396			
			1,040		2	11	12	3			24,950		
ODHP-A2	1,040			20	13	14	225		13,050			RPSH	
		1,040		2	15	16				11,703			
TWH-1			3,600	40	1	17	19	3			6,807		
SPARE				20	1	19	20	225				SPARE	
WH-2		2,250		40	21	22							
			2,250		2	23	24	3					
WH-3	2,250			40	25	26	60					SPARE	
		2,250			2	27	28						
ICCHP-B1			156	20	29	30		3					
	156				2	31	32	100				BUSSED SPACE	
OCCHP-B1		1,040		20	33	34							
			1,040		2	35	36	3					
SPARE				100	37	38	100					BUSSED SPACE	
					39	40							
					41	42		3					
SUB TOTAL (VA)	3,758	7,776	8,242		3	41	42		3	45,980	41,899	41,847	SUB TOTAL (VA)
TOTAL LOAD PHASE A						49,738 (VA)						NOTES:	
TOTAL LOAD PHASE B						49,875 (VA)						1. PANELBOARD TO BE BOLT-ON TYPE WITH DOOR-IN-DOOR CONSTRUCTION	
TOTAL LOAD PHASE C						50,089 (VA)						2. PROVIDE ARC FAULT LABEL PER DETAIL.	
TOTAL LOAD:						149,802 (VA) =						415 AMP/S	

ASHRAE 90.1 2013
THE OWNER HAS REQUESTED EXEMPTION FOR THE FOLLOWING SECTIONS OF ASHRAE 90.1 2013. 1. SECTION 8.4.2 AUTOMATIC RECEPTACLE CONTROLS. 2. SECTION 8.4.3 ELECTRIC ENERGY MONITORING.

DRY TYPE TRANSFORMER SCHEDULE					
MARK	KVA	VOLTAGE		°C RISE	K FACTOR
		PRIMARY	SECONDARY		
TX1	150	480 V. DELTA 3 PH., 3 W.	208Y/120 V. 3 PH., 4 W.	150	1
TX2	112.5	480 V. DELTA 3 PH., 3 W.	208Y/120 V. 3 PH., 4 W.	150	1

INVERTER				
MARK	KVA	VOLTAGE		BKRS
		PRIMARY	SECONDARY	
INV	15KW	120/208V., 3PH., 4W.	120/208V., 3PH., 4W.	(12) 20A/1P (1)20/2 (1)30/2

* INVERTER SIZE SHALL BE CALCULATED USING THE FOLLOWING INFORMATION.
LIGHTS: 4.0 WATTS
FAN: (1)1-1/4HP, (1)1/2HP., (2) 245WATT FANS, (1) 80 WATT FAN

SYSTEM IS DESIGNED AROUND CONTROLLED POWER. EQUAL MANUFACTURERS MUST MEET PHYSICAL EQUIPMENT SIZE AS SHOWN ON DRAWINGS.

FANS SHALL BE PROGRAMMED TO HAVE 5 SECOND DELAY BETWEEN EACH MOTOR COMING ONLINE

SHEET NOTES:


- TRANSFORMER PROVIDE BY UTILITY COMPANY. ELECTRICAL CONTRACTOR TO PROVIDE TRANSFORMER PAD PER UTILITY COMPANY SPECIFICATIONS.
- INSTALL UNDERGROUND PRIMARY CONDUITS AS INDICATED ON THE SITE ELECTRICAL PLAN. COORDINATE WITH UTILITY COMPANY AND ADJUST THE NUMBER AND QUANTITY OF CONDUITS REQUIRED BY THE LOCAL UTILITY COMPANY.
- METER PROVIDE BY UTILITY COMPANY. ELECTRICAL CONTRACTOR TO PROVIDE METER CONDUIT PER UTILITY COMPANY SPECIFICATIONS.
- SEE PANELBOARD SCHEDULE FOR CIRCUIT BREAKER PROVISIONS.
- SEE SHEET E7.2 FOR GROUNDING DETAILS.
- FEEDER CIRCUIT SHALL BE INSTALLED UNDERGROUND BELOW SLAB.
- FEEDERS FOR PANELBOARDS IN STORM SHELTER SHALL BE FED FROM BELOW. NO FEEDER CONDUITS SHALL PENETRATE SHELTER WALLS.
- LIGHTING IN STORM SHELTER SHALL BE CONNECTED TO INVERTER. SEE SHEET E2 SERIES FOR ADDITIONAL INFORMATION.
- VENTILATION FAN SAF-1, SAF-2, EF-C1, EF-C2, EF-E2 SHALL BE CONNECTED TO THE INVERTER. SEE EQUIPMENT SCHEDULE E3.9 FOR ADDITIONAL INFORMATION AND REQUIREMENTS.
- SEE SERVICE ENTRANCE NAMEPLATE DETAIL THIS SHEET.
- STORM SHELTER PLUMBING SHUTOFF VALVE. SEE PLUMBING FOR LOCATION.
- RELAY CONTACT FOR SAF-1, SAF-1, EF-C1 AND EF-C2.
- SHUNT TRIP BUTTON IS MOMENTARY CONTACT MUSHROOM TYPE WITH 2 INCH DIAMETER BUTTON AND SHALL BE WEATHERPROOF AND LOCKABLE ENCLOSURE TO PREVENT ACCIDENTAL ACTIVATION. LOCATE WHERE SHOWN ON PLANS (SEE SHEET E3.1). PROVIDE MELAMINE ENGRAVED SIGNAGE (WHITE BACKGROUND/RED LETTERING) ABOVE BUTTON WITH 3/4" LETTERING THAT READS "SHUNT TRIP POWER SHUTOFF FOR BUILDING. DEPRESSING THIS BUTTON WILL DISCONNECT UTILITY POWER FROM BUILDING."
- GENERATOR IS FOR FULL BUILDING STANDBY POWER AND MAY NOT BE USED FOR EGRESS LIGHTING. ALL EMERGENCY LIGHTING SHALL BE PROVIDED WITH INTERNAL EMERGENCY 90 MINUTE BATTERY.

POWER RISER DIAGRAM NOTES:

- INSTALLATION AND CONNECTION OF ALL DEVICES SHALL BE IN ACCORDANCE WITH NEC, MANUFACTURER'S RECOMMENDATIONS, AND STATE AND LOCAL CODES.
- CONTRACTOR IS RESPONSIBLE FOR THE CONNECTING, INSTALLATION, AND MARKING OF ALL POWER FEEDER CONDUCTORS FOR THE PROPER PHASE SEQUENCE AND LOADING . CONTRACTOR SHALL TEST EACH FEEDER AND EQUIPMENT FEEDERS WITH A PHASE METER PRIOR TO CONNECTING LOADS.
- THE CONTRACTOR IS RESPONSIBLE FOR COORDINATING AND VERIFYING WITH ALL DIVISIONS THE ACTUAL NAMEPLATE DATA OF ALL EQUIPMENT AND DEVICES SUPPLIED ON THIS PROJECT PRIOR TO BID. CONTRACTOR SHALL THEN PROVIDE THE PROPERLY SIZED OVERCURRENT DEVICES (CIRCUIT BREAKERS, CONDUCTORS, DISCONNECTS, FUSES, ETC.) TO PROPERLY PROTECT THE EQUIPMENT PER THE NEC. ENGINEER'S DESIGN BASED ON DATA GIVEN TO HIM BY DESIGNERS OF OTHER DIVISIONS, ACTUAL NAMEPLATE DATA COULD DIFFER.
- SEAL ALL CONDUITS FROM THE EXTERIOR WITH A SEALING COMPOUND, ONCE ALL CABLING HAS BEEN INSTALLED.
- PROVIDE 4" CONCRETE HOUSEKEEPING PAD WITH 1" CHAMFER FOR ALL FLOOR MOUNTED TRANSFORMERS AND SWITCHBOARDS.
- COORDINATE WITH GROUNDING DETAILS ON SHEET E7.2 FOR ALL THE DIFFERENT TYPE GROUNDING REQUIREMENTS.
- ALL UNDERGROUND SECONDARY FEEDERS SHALL BE A MINIMUM OF 36" BELOW GRADE TO THE TOP OF THE DUCT BANK.
- ALL UNDERGROUND PRIMARY FEEDERS SHALL BE A MINIMUM OF 48" BELOW GRADE TO THE TOP OF THE CONDUIT.
- CONTRACTOR SHALL PROVIDE A FULL SIZE COPY OF THE AS-BUILT POWER RISER DIAGRAM FRAMED BEHIND PLEXIGLASS SCREWED TO THE WALL NEAR MAIN SERVICE PANEL.


NOTES:

- CONTRACTOR SHALL CALCULATE AND PROVIDE NAMEPLATE ON THE SERVICE ENTRANCE EQUIPMENT THAT INDICATES THE MAXIMUM AVAILABLE FAULT CURRENT AND THE DATE THE CALCULATION WAS PERFORMED. SEE NAMEPLATE REQUIREMENTS BELOW.

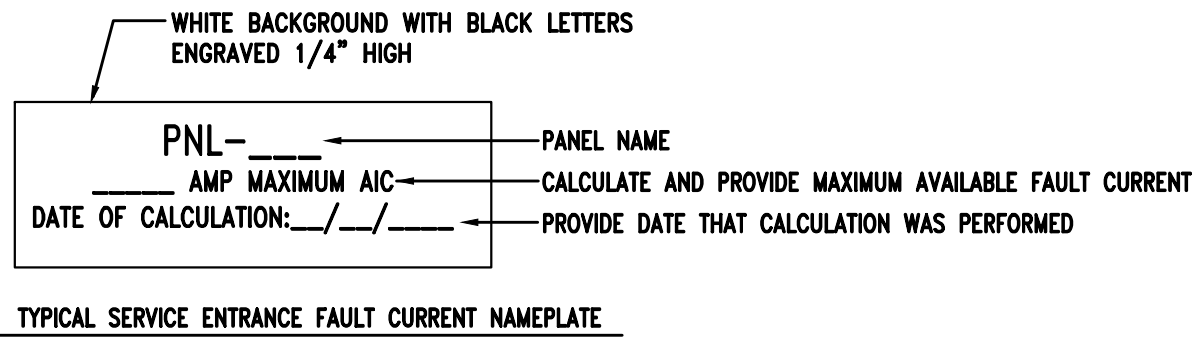

2
E7.1
NO SCALE


DETAIL - SERVICE ENTRANCE FAULT CURRENT NAMEPLATE

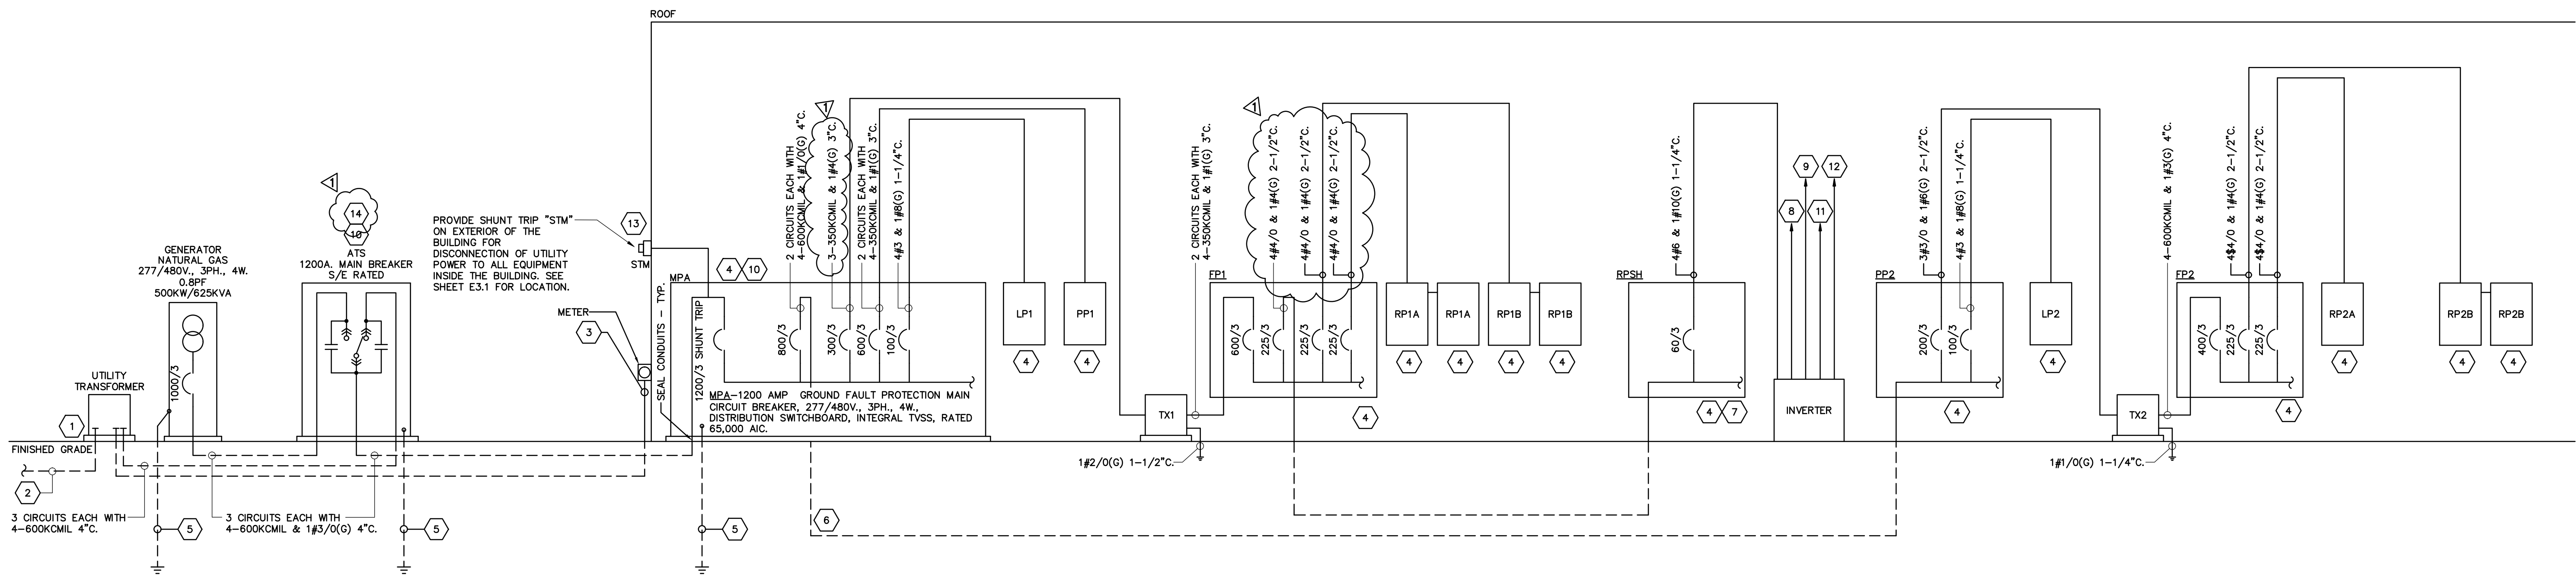

1
E7.1
NO SCALE

RISER DIAGRAM POWER DISTRIBUTION

HUXFORD ELEMENTARY SCHOOL
GYMNASIUM AND CLASSROOM ADDITION
FOR
ESCAMBIA COUNTY BOARD OF EDUCATION
BREWTON, ALABAMA

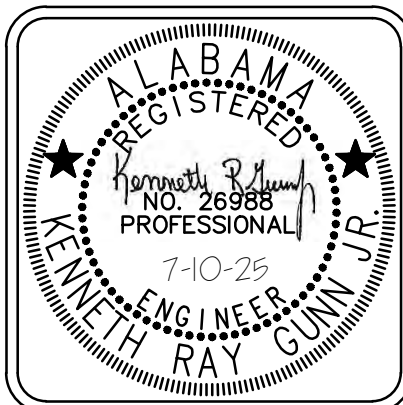

DRAWN: FIP CHECK: KRG
DATE 05-16-2025
REVISED 7/10/25 ADDENDUM 1
REVISED

SHEET TITLE
RISER DIAGRAM -
POWER DISTRIBUTION

JOB NO.
2312SC

SEQUENCE
NO. 120 OF 124

E7.1

Gunn & Associates, P.C.
Consulting Engineers
3102 Highway 14
Millbrook, AL 36054
Tel: 334.285.1273
1200 Providence Park, Suite 200
Birmingham, AL 35242
GA/E23-190

© PH&J ARCHITECTS, INC.
ALL RIGHTS RESERVED.