


GRADING PLAN

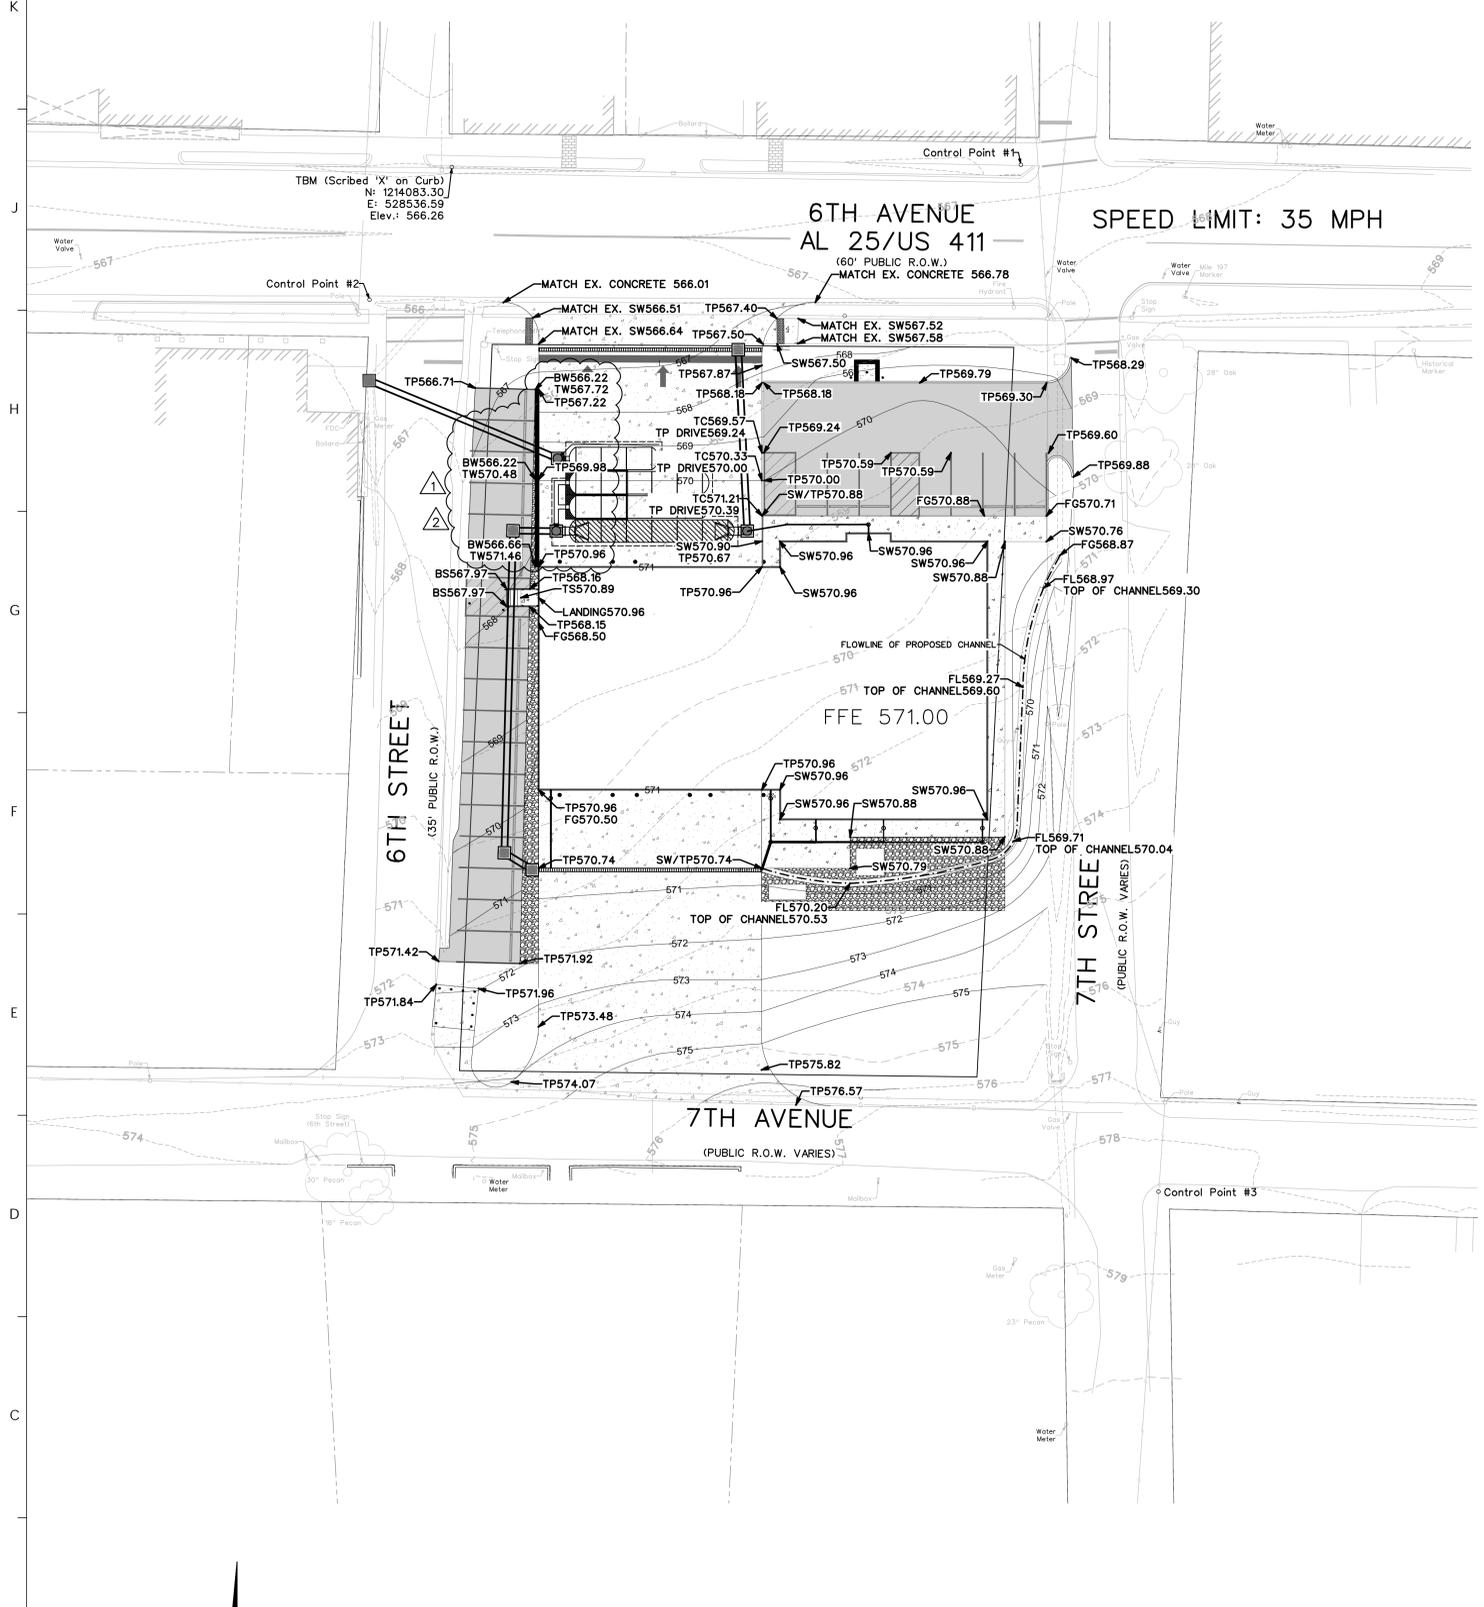

SPOT ELEVATION LEGEND

- TP - TOP OF PAVEMENT
- TC - TOP OF CURB
- SW - SIDEWALK
- FG - FINISHED GRADE
- BS - BOTTOM OF STAIRS
- TS - TOP OF STAIRS
- TW - TOP OF RETAINING WALL
- BW - BOTTOM OF RETAINING WALL (AT TOP OF FOOTING)
- LP - LOW POINT
- HP - HIGH POINT

SCALE: 1" = 20'
GRAPHIC SCALE




UNDERGROUND UTILITIES SHOWN ON THIS MAP ARE FROM LOCAL UTILITY COMPANY RECORDS AND SHOULD BE FIELD VERIFIED IN THE FIELD PRIOR TO CONSTRUCTION.

JOB SAFETY IS NOT THE RESPONSIBILITY OF THE ENGINEER. THE CONTRACTOR IS RESPONSIBLE FOR CONSTRUCTION SITE SAFETY.

WALL PLAN & PROFILE


SCHOEEL
BIRMINGHAM | HUNTSVILLE | TUSCALOOSA
1001 25th Street, Suite 300 Birmingham, Alabama 35205 205.325.6100
101 Washington Street SE Huntsville, Alabama 35801 256.439.7025
3600 Montclair Road, Suite 300 Northport, Alabama 35473 205.323.6100
SCHOEEL.COM

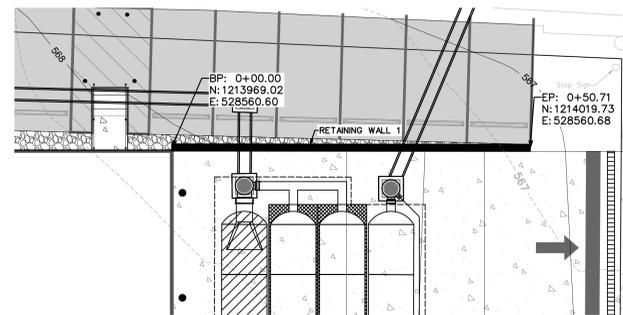

SCALE: 1" = 10'
GRAPHIC SCALE



NOTE: SEE SITE RETAINING WALL SECTION AND SITE WALL EXPANSION JOINT DETAIL ON STRUCTURAL SHEET S1.03

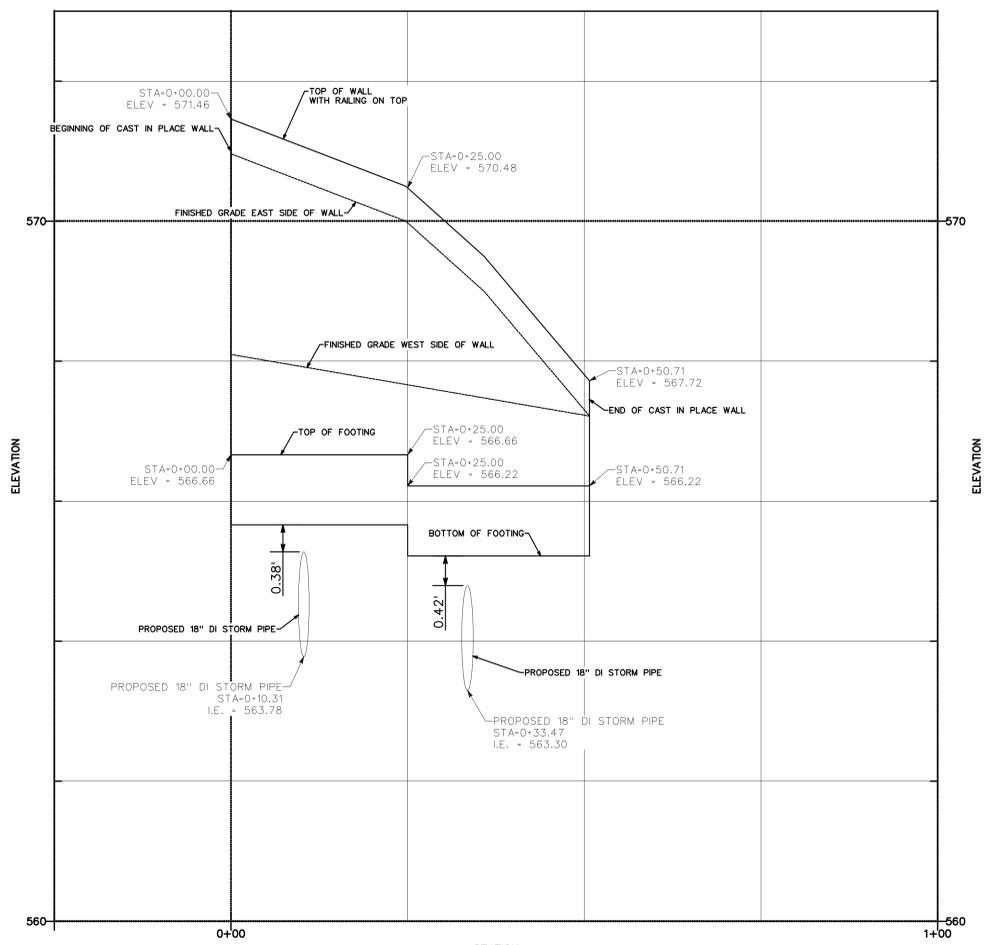

STATION WALL 1 PROFILE
SCALE: 1"=10' HORIZONTAL
SCALE: 1"=1' VERTICAL

Goodwyn Mills Cawood, LLC
117 Jefferson Street North
Huntsville, AL 35801
T 256.539.3431
GMCNETWORK.COM

ISSUE	DATE
100% CONSTRUCTION DOCUMENTS	1/9/2026
ADDENDUM 3	1/23/2026
ADDENDUM 4	2/6/2026

ASHVILLE FIRE STATION #2
222 7TH Avenue North
Ashville, AL 35953




GRADING PLAN

C4


GMC # AHUN250003

DRAWN BY: J. GARNER
CHECKED BY: B. WISEMAN

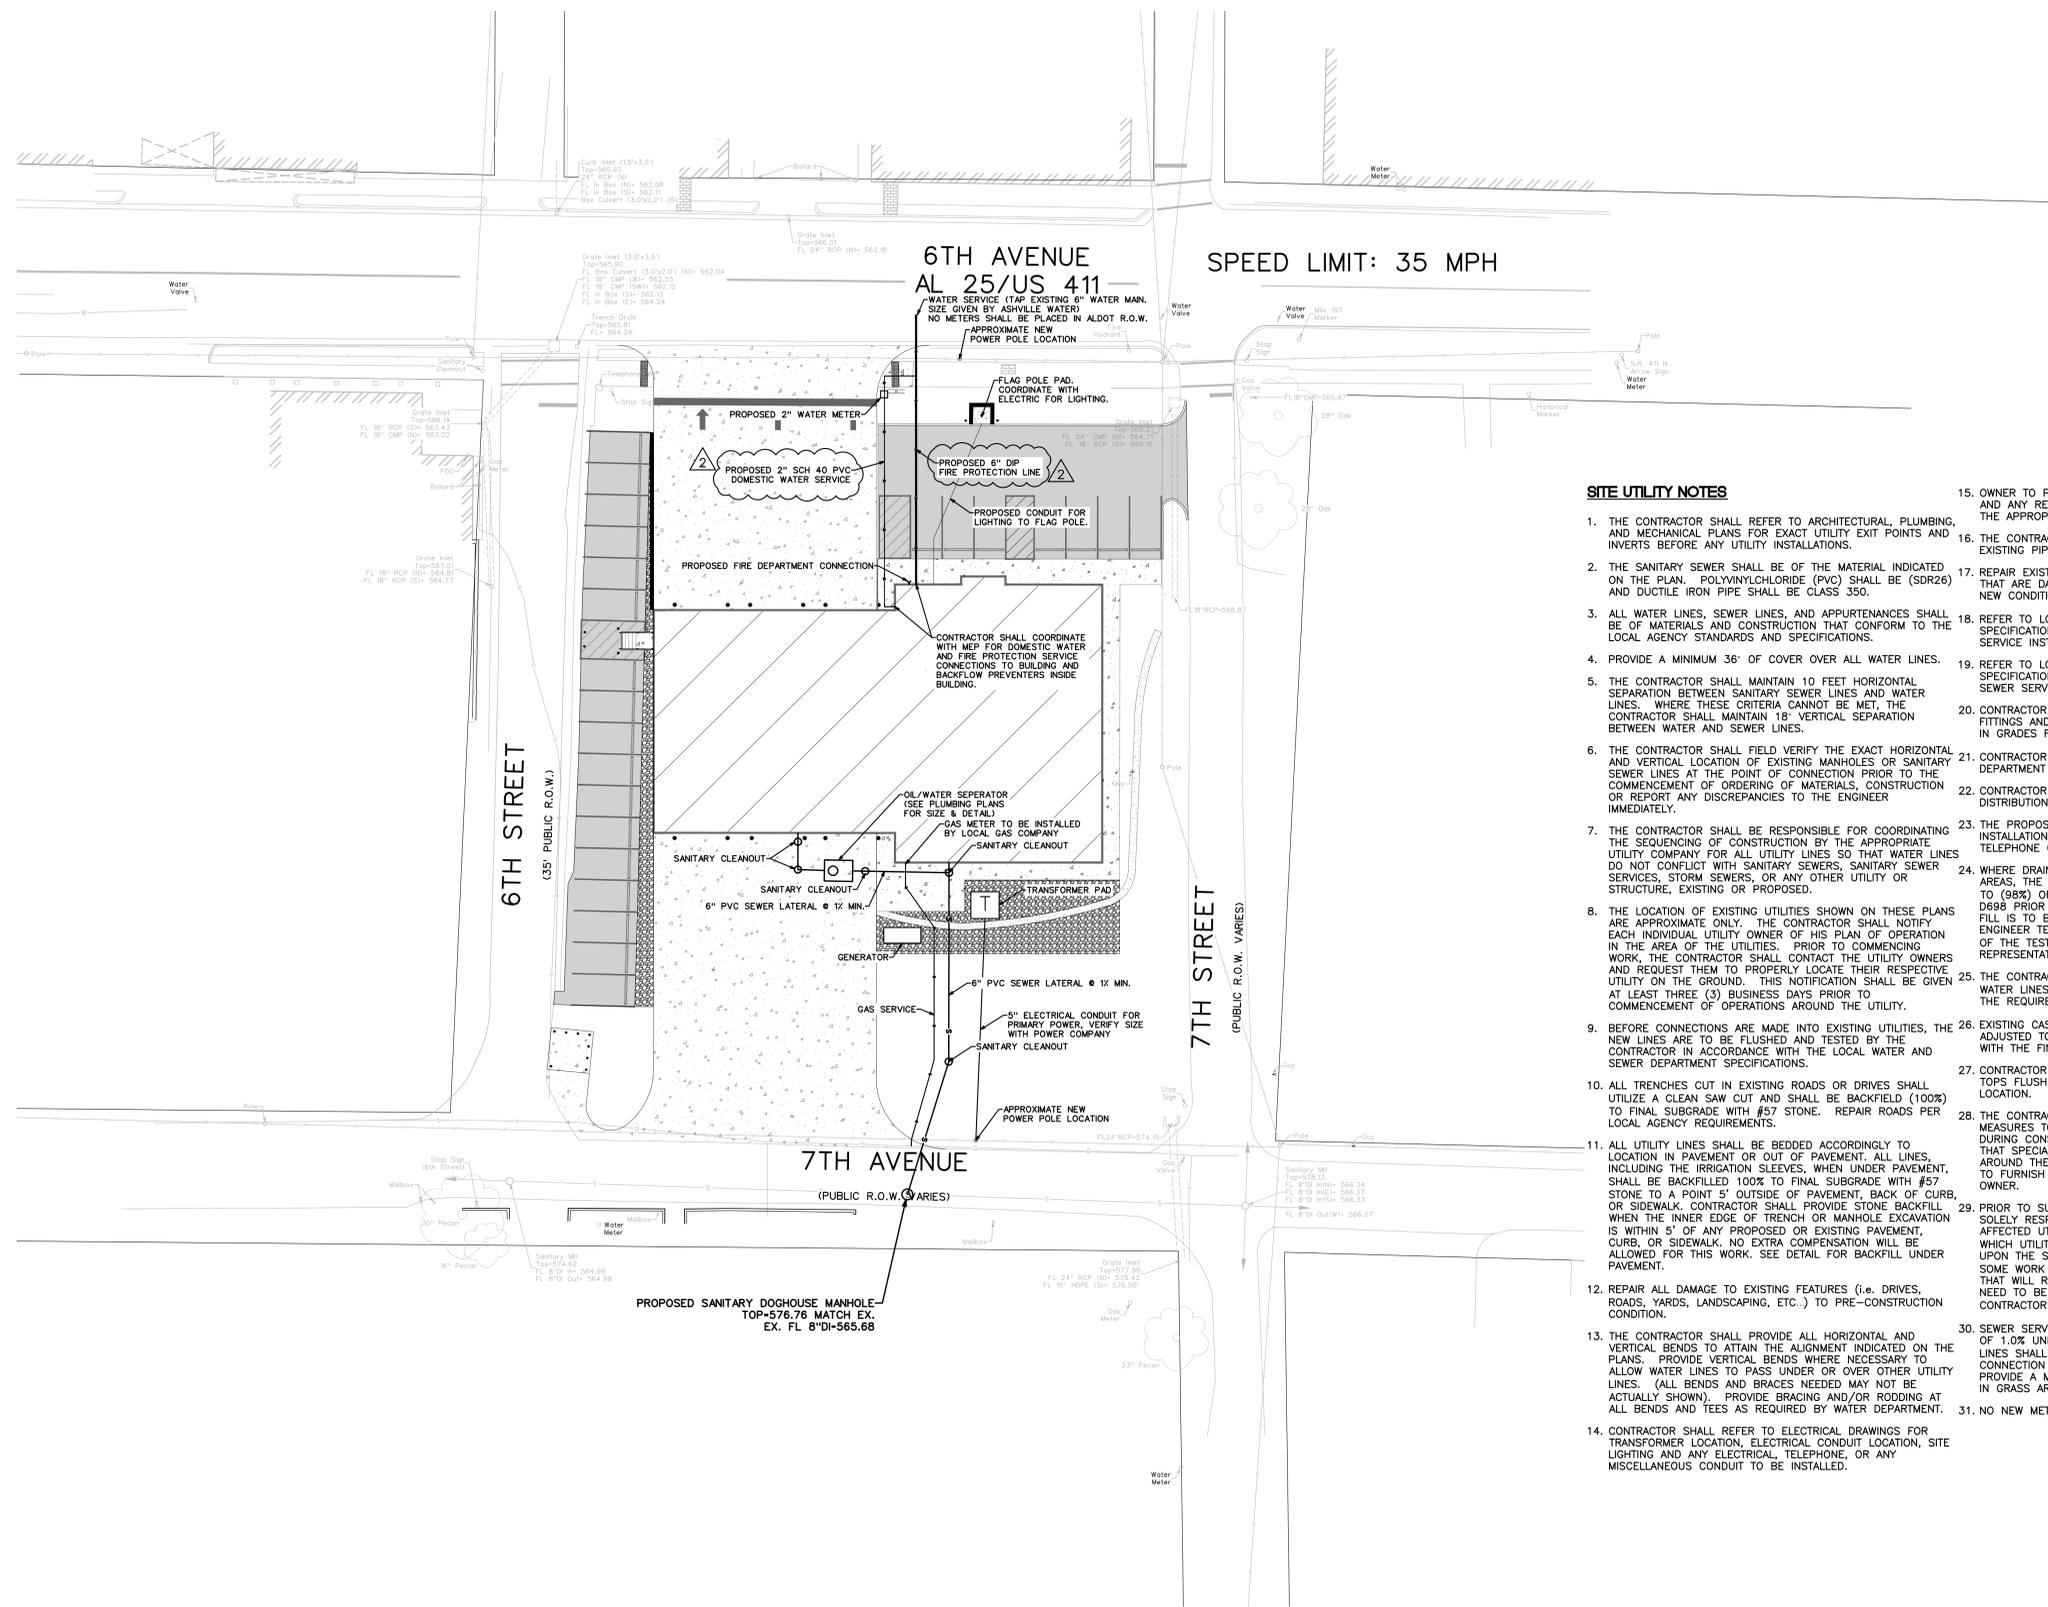

SITE UTILITY NOTES

1. THE CONTRACTOR SHALL REFER TO ARCHITECTURAL, PLUMBING, AND MECHANICAL PLANS FOR EXACT UTILITY EXIT POINTS AND INVERTS BEFORE ANY UTILITY INSTALLATIONS.
2. THE SANITARY SEWER SHALL BE OF THE MATERIAL INDICATED ON THE PLAN. POLYVINYLCHLORIDE (PVC) SHALL BE (SDR26) AND DUCTILE IRON PIPE SHALL BE CLASS 350.
3. ALL WATER LINES, SEWER LINES, AND APPURTENANCES SHALL BE OF MATERIALS AND CONSTRUCTION THAT CONFORM TO THE LOCAL AGENCY STANDARDS AND SPECIFICATIONS.
4. PROVIDE A MINIMUM 36" OF COVER OVER ALL WATER LINES.
5. THE CONTRACTOR SHALL MAINTAIN 10 FEET HORIZONTAL SEPARATION BETWEEN SANITARY SEWER LINES AND WATER LINES. WHERE THESE CRITERIA CANNOT BE MET, THE CONTRACTOR SHALL MAINTAIN 18" VERTICAL SEPARATION BETWEEN WATER AND SEWER LINES.
6. THE CONTRACTOR SHALL FIELD VERIFY THE EXACT HORIZONTAL AND VERTICAL LOCATION OF EXISTING MANHOLES OR SANITARY SEWER LINES AT THE POINT OF CONNECTION PRIOR TO THE COMMENCEMENT OF ORDERING OF MATERIALS, CONSTRUCTION OR REPORT ANY DISCREPANCIES TO THE ENGINEER IMMEDIATELY.
7. THE CONTRACTOR SHALL BE RESPONSIBLE FOR COORDINATING THE SEQUENCING OF CONSTRUCTION BY THE APPROPRIATE UTILITY COMPANY FOR ALL UTILITY LINES SO THAT WATER LINES DO NOT CONFLICT WITH SANITARY SEWERS, SANITARY SEWER SERVICES, STORM SEWERS, OR ANY OTHER UTILITY OR STRUCTURE, EXISTING OR PROPOSED.
8. THE LOCATION OF EXISTING UTILITIES SHOWN ON THESE PLANS ARE APPROXIMATE ONLY. THE CONTRACTOR SHALL NOTIFY EACH INDIVIDUAL UTILITY OWNER OF HIS PLAN OF OPERATION IN THE AREA OF THE UTILITIES. PRIOR TO COMMENCING WORK, THE CONTRACTOR SHALL CONTACT THE UTILITY OWNERS AND REQUEST THEM TO PROPERLY LOCATE THEIR RESPECTIVE UTILITY ON THE GROUND. THIS NOTIFICATION SHALL BE GIVEN AT LEAST THREE (3) BUSINESS DAYS PRIOR TO COMMENCEMENT OF OPERATIONS AROUND THE UTILITY.
9. BEFORE CONNECTIONS ARE MADE INTO EXISTING UTILITIES, THE NEW LINES ARE TO BE FLUSHED AND TESTED BY THE CONTRACTOR IN ACCORDANCE WITH THE LOCAL WATER AND SEWER DEPARTMENT SPECIFICATIONS.
10. ALL TRENCHES CUT IN EXISTING ROADS OR DRIVES SHALL UTILIZE A CLEAN SAW CUT AND SHALL BE BACKFILLED (100%) TO FINAL SUBGRADE WITH #57 STONE. REPAIR ROADS PER LOCAL AGENCY REQUIREMENTS.
11. ALL UTILITY LINES SHALL BE BEDDED ACCORDINGLY TO LOCATION IN PAVEMENT OR OUT OF PAVEMENT. ALL LINES, INCLUDING THE IRRIGATION SLEEVES, WHEN UNDER PAVEMENT, SHALL BE BACKFILLED 100% TO FINAL SUBGRADE WITH #57 STONE TO A POINT 5' OUTSIDE OF PAVEMENT, BACK OF CURB, OR SIDEWALK. CONTRACTOR SHALL PROVIDE STONE BACKFILL WHEN THE INNER EDGE OF TRENCH OR MANHOLE EXCAVATION IS WITHIN 5' OF ANY PROPOSED OR EXISTING PAVEMENT, CURB, OR SIDEWALK. NO EXTRA COMPENSATION WILL BE ALLOWED FOR THIS WORK. SEE DETAIL FOR BACKFILL UNDER PAVEMENT.
12. REPAIR ALL DAMAGE TO EXISTING FEATURES (I.E. DRIVES, ROADS, YARDS, LANDSCAPING, ETC.) TO PRE-CONSTRUCTION CONDITION.
13. THE CONTRACTOR SHALL PROVIDE ALL HORIZONTAL AND VERTICAL BENDS TO ATTAIN THE ALIGNMENT INDICATED ON THE PLANS. PROVIDE VERTICAL BENDS WHERE NECESSARY TO ALLOW WATER LINES TO PASS UNDER OR OVER OTHER UTILITY LINES. (ALL BENDS AND BRACES NEEDED MAY NOT BE ACTUALLY SHOWN). PROVIDE BRACING AND/OR RODDING AT ALL BENDS AND TEES AS REQUIRED BY WATER DEPARTMENT.
14. CONTRACTOR SHALL REFER TO ELECTRICAL DRAWINGS FOR TRANSFORMER LOCATION, ELECTRICAL CONDUIT LOCATION, SITE LIGHTING AND ANY ELECTRICAL, TELEPHONE, OR ANY MISCELLANEOUS CONDUIT TO BE INSTALLED.
15. OWNER TO PAY FOR ANY AID-TO-CONSTRUCTION FOR UTILITIES AND ANY RELATED INSPECTION FEES FOR THESE SERVICES TO THE APPROPRIATE UTILITY AUTHORITY.
16. THE CONTRACTOR SHALL VERIFY REQUIRED PIPE LENGTHS, EXISTING PIPE MATERIAL AND SIZES AS SHOWN ON PLANS.
17. REPAIR EXISTING PAVEMENT, CURBS, WALKS, LANDSCAPING, ETC. THAT ARE DAMAGED BY CONSTRUCTION ACTIVITIES TO A LIKE NEW CONDITION AT NO ADDITIONAL COST TO THE OWNER.
18. REFER TO LOCAL AGENCY'S WATER DEPARTMENT FOR SPECIFICATION AND ILLUSTRATIONS OF TYPICAL DOMESTIC WATER SERVICE INSTALLATION.
19. REFER TO LOCAL AGENCY SANITARY SEWER DEPARTMENT FOR SPECIFICATIONS AND ILLUSTRATIONS OF TYPICAL SANITARY SEWER SERVICE INSTALLATION.
20. CONTRACTOR SHALL PROVIDE AND INSTALL ALL NECESSARY FITTINGS AND CLEANOUTS AT BENDS, JUNCTIONS, AND CHANGE IN GRADES FOR THE SANITARY SEWER SERVICE LINES.
21. CONTRACTOR SHALL COORDINATE LOCAL AGENCY'S GAS DEPARTMENT FOR GAS SERVICE LINE INSTALLATION.
22. CONTRACTOR SHALL COORDINATE ALL SITE PRIMARY POWER DISTRIBUTION WITH ALABAMA POWER PRIOR TO INSTALLATION.
23. THE PROPOSED TELEPHONE LINE CONSTRUCTION AND INSTALLATION SHALL BE COORDINATED WITH THE LOCAL TELEPHONE COMPANY BY THE CONTRACTOR.
24. WHERE DRAINAGE OR UTILITY LINES OCCUR IN PROPOSED FILL AREAS, THE FILL MATERIAL IS TO BE PLACED AND COMPACTED TO (98%) OF MAXIMUM DRY DENSITY ACCORDING TO ASTM D698 PRIOR TO INSTALLATION OF DRAINAGE OR UTILITY LINES. FILL IS TO BE INSPECTED BY A PROFESSIONAL GEOTECHNICAL ENGINEER TESTING FIRM EMPLOYED BY THE OWNER. RESULTS OF THE TEST SHALL BE FURNISHED TO THE OWNER'S REPRESENTATIVE. CONTRACTOR TO PAY FOR ANY RETESTING.
25. THE CONTRACTOR SHALL ADJUST THE ALIGNMENT OF THE WATER LINES (HORIZONTALLY AND/OR VERTICALLY) TO ALLOW THE REQUIRED BRACING AT BENDS AND TEES.
26. EXISTING CASTINGS LOCATED IN FILL/CUT AREAS SHALL BE ADJUSTED TO ENSURE THAT THE TOP OF CASTING IS FLUSH WITH THE FINISHED GRADE.
27. CONTRACTOR SHALL INSTALL ALL SANITARY SEWER CLEANOUT TOPS FLUSH WITH FINISHED GRADE AT THE CLEANOUT LOCATION.
28. THE CONTRACTOR WILL PROVIDE ALL NECESSARY PROTECTIVE MEASURES TO SAFEGUARD EXISTING UTILITIES FROM DAMAGE DURING CONSTRUCTION OF THIS PROJECT. IN THE EVENT THAT SPECIAL EQUIPMENT IS REQUIRED TO WORK OVER AND AROUND THE UTILITIES, THE CONTRACTOR WILL BE REQUIRED TO FURNISH SUCH EQUIPMENT AT NO ADDITIONAL COST TO THE OWNER.
29. PRIOR TO SUBMITTING HIS BID, THE CONTRACTOR WILL BE SOLELY RESPONSIBLE FOR CONTACTING OWNERS OF ALL AFFECTED UTILITIES IN ORDER TO DETERMINE THE EXTENT TO WHICH UTILITY RELOCATIONS AND/OR ADJUSTMENTS WILL HAVE UPON THE SCHEDULE OF WORK FOR THE PROJECT. WHILE SOME WORK MAY BE REQUIRED 'AROUND' UTILITY FACILITIES THAT WILL REMAIN IN PLACE, OTHER UTILITY FACILITIES MAY NEED TO BE ADJUSTED CONCURRENTLY WITH THE CONTRACTOR'S OPERATIONS.
30. SEWER SERVICE TO BE 6" DIAMETER PVC AT A MINIMUM SLOPE OF 1.0% UNLESS SHOWN OTHERWISE ON THE DRAWINGS. LINES SHALL START 5' BEYOND THE BUILDINGS. COORDINATE CONNECTION POINTS WITH THE BUILDING PLUMBING DRAWINGS. PROVIDE A MINIMUM 30" OF COVER OVER ALL SEWER SERVICES IN GRASS AREAS AND 36" OF COVER IN PAVED AREAS.
31. NO NEW METERS SHALL BE PLACED IN ALDOT R.O.W.

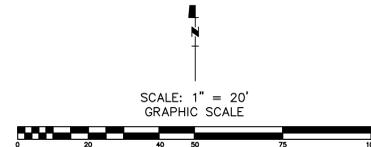

UNDERGROUND UTILITIES SHOWN ON THIS MAP ARE FROM LOCAL UTILITY COMPANY RECORDS AND SHOULD BE FIELD VERIFIED IN THE FIELD PRIOR TO CONSTRUCTION.
 JOB SAFETY IS NOT THE RESPONSIBILITY OF THE ENGINEER. THE CONTRACTOR IS RESPONSIBLE FOR CONSTRUCTION SITE SAFETY.







ISSUE	DATE
100% CONSTRUCTION DOCUMENTS	1/9/2026
ADDENDUM 3	1/23/2026
ADDENDUM 4	2/6/2026

ASHVILLE FIRE STATION #2
 222 7TH Avenue North
 Ashville, AL 35953








UTILITY PLAN

C7

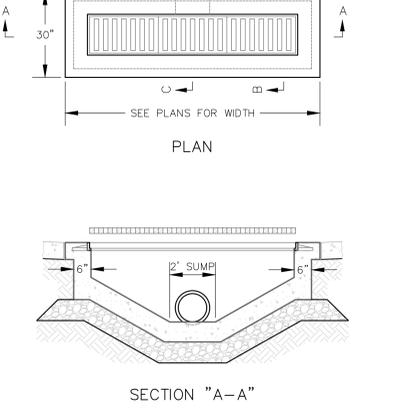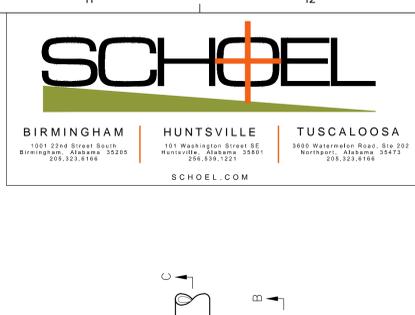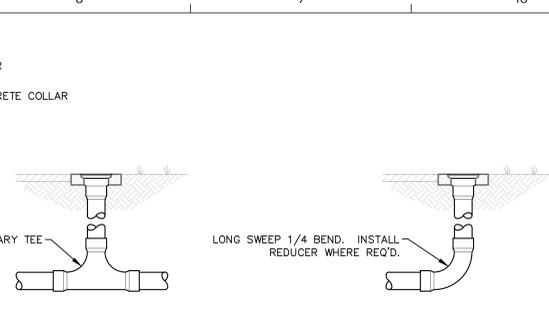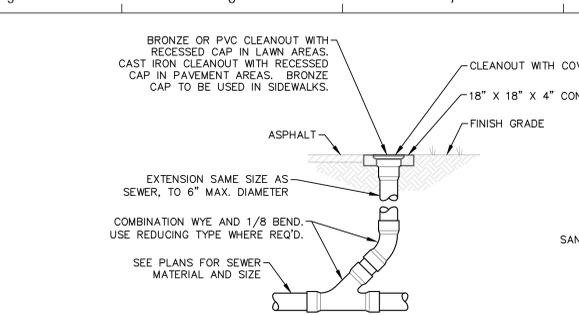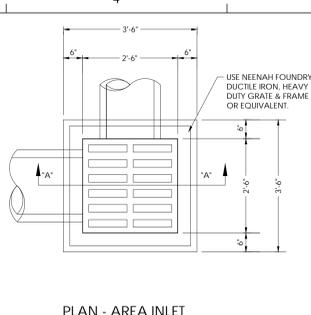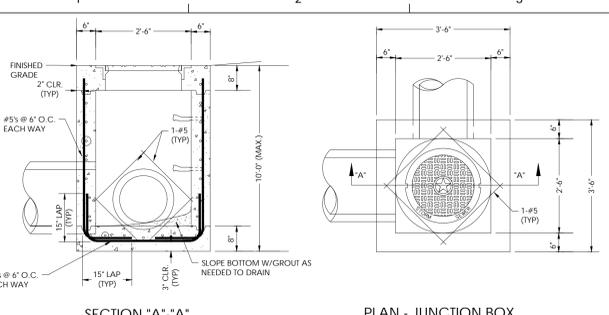





JUNCTION BOX / AREA INLET (15"-24" PIPES)
 NOT TO SCALE

- NOTES:
 1. ALL CONCRETE SHALL DEVELOP A MINIMUM COMPRESSIVE STRENGTH OF 3000 PSI AT 28 DAYS (CLASS '3').
 2. ALL REINFORCING SHALL BE GRADE 60 DEFORMED BARS, AND SHALL CONFORM TO THE RECS OF THE STANDARD SPECIFICATIONS FOR BILLET STEEL (ASTM A-305), WITH DEFORMATIONS CONFORMING TO ASTM A-305.

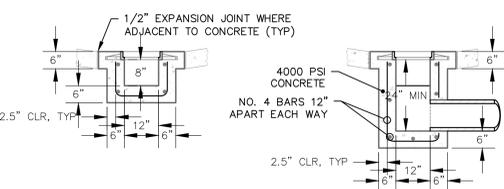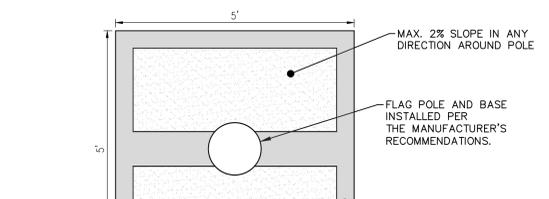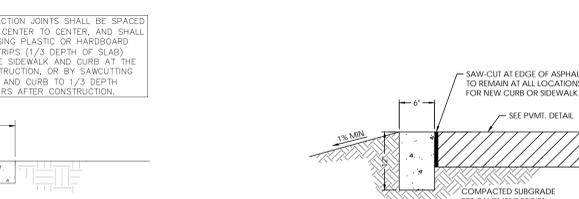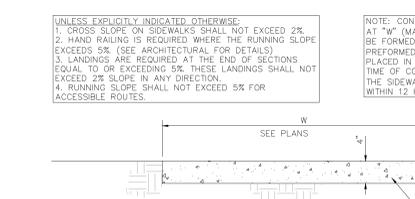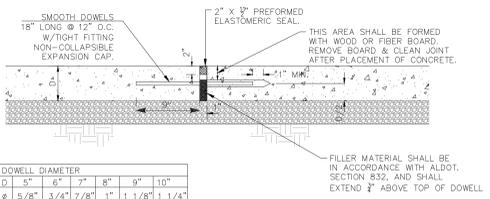





TRENCH DRAIN
 NO SCALE

- NOTES:
 1. SEE PLANS FOR CASTING AND INVERT ELEVATIONS.
 2. COVER AND RAILS SHALL BE JOHN BOUCHARD NO. 5849, TYPE 'A' WITH NO. 2 RAILS, OR APPROVED EQUAL.

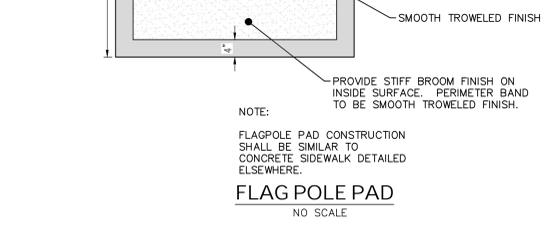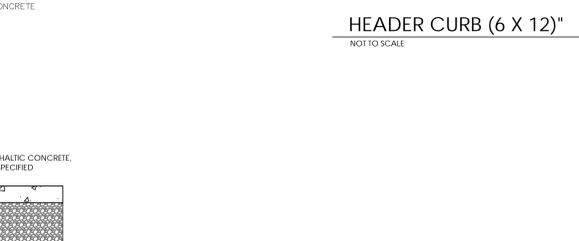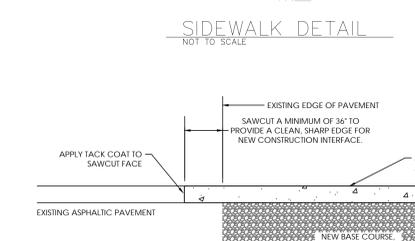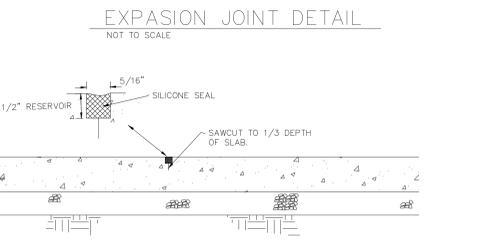

FLAG POLE PAD
 NO SCALE



- NOTE:
 FLAGPOLE PAD CONSTRUCTION SHALL BE SIMILAR TO CONCRETE SIDEWALK DETAILED ELSEWHERE.

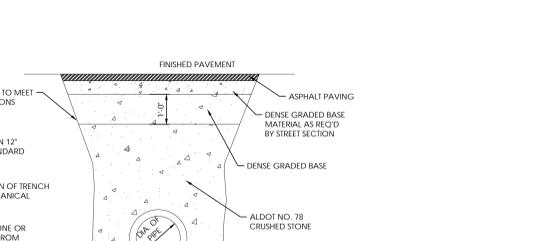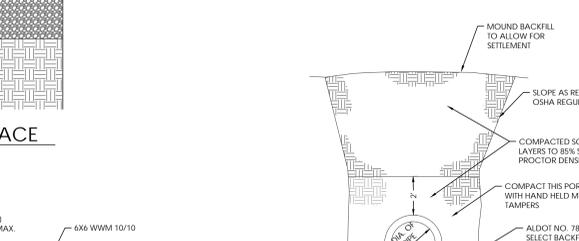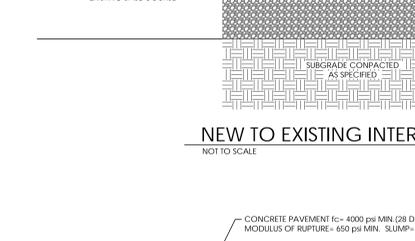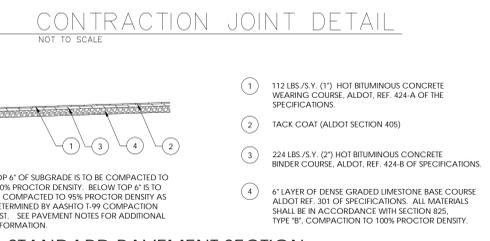



STORM SEWER PIPE BEDDING
 NOT TO SCALE

STORM SEWER PIPE BEDDING
 NOT TO SCALE

HEAVY-DUTY CONCRETE PAVEMENT DETAIL
 NOT TO SCALE

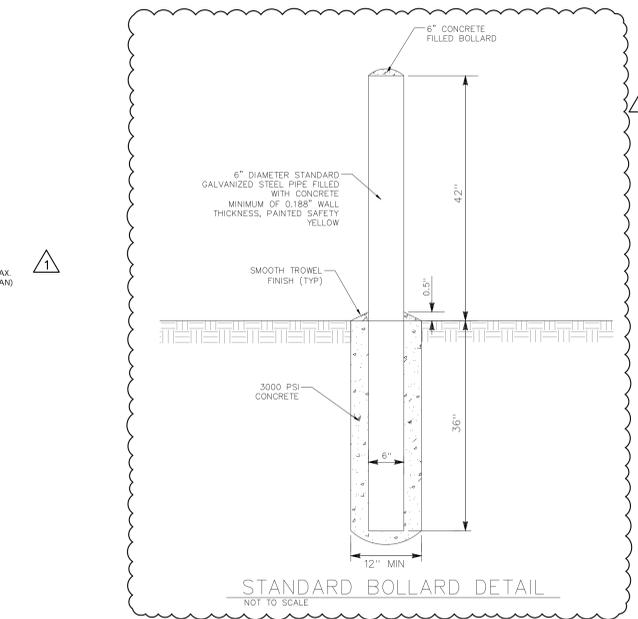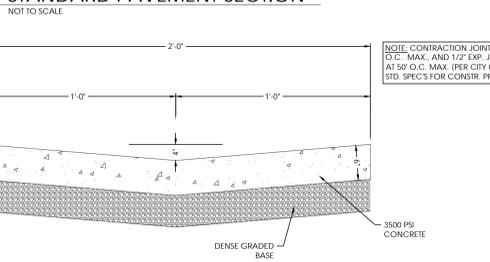

TEMPORARY CONSTRUCTION ENTRANCE
 NO SCALE

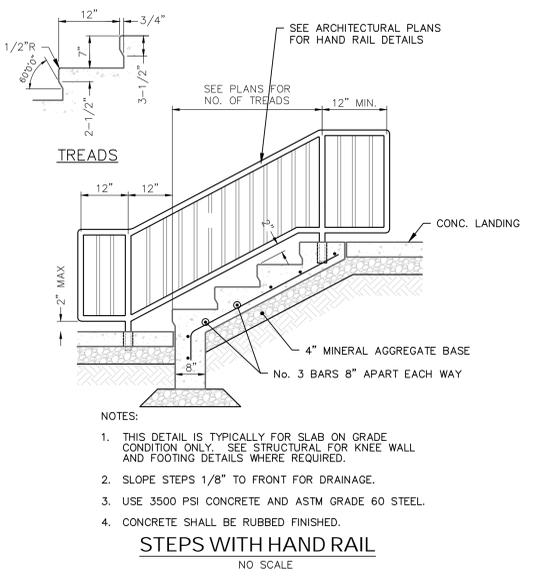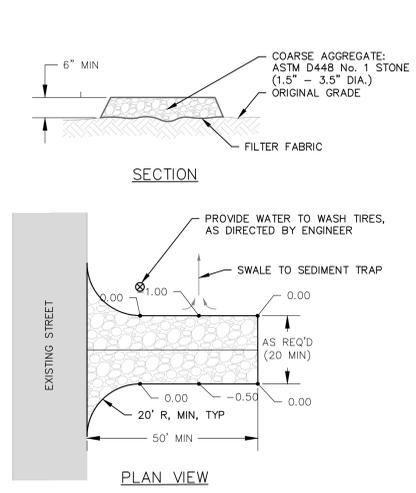

- NOTES:
 1. THIS DETAIL IS TYPICALLY FOR SLAB ON GRADE CONDITION ONLY. SEE STRUCTURAL FOR KNEE WALL AND FOOTING DETAILS WHERE REQUIRED.
 2. SLOPE STEPS 1/8" TO FRONT FOR DRAINAGE.
 3. USE 3500 PSI CONCRETE AND ASTM GRADE 60 STEEL.
 4. CONCRETE SHALL BE RUBBED FINISHED.


ISSUE	DATE
100% CONSTRUCTION DOCUMENTS	1/9/2026
ADDENDUM 3	1/23/2026
ADDENDUM 4	2/6/2026

DRAWN BY: J. GARNER
 CHECKED BY: B. WISEMAN

ASHVILLE FIRE STATION #2
 222 7TH Avenue North
 Ashville, AL 35953



CONSTRUCTION DETAILS
C9.0

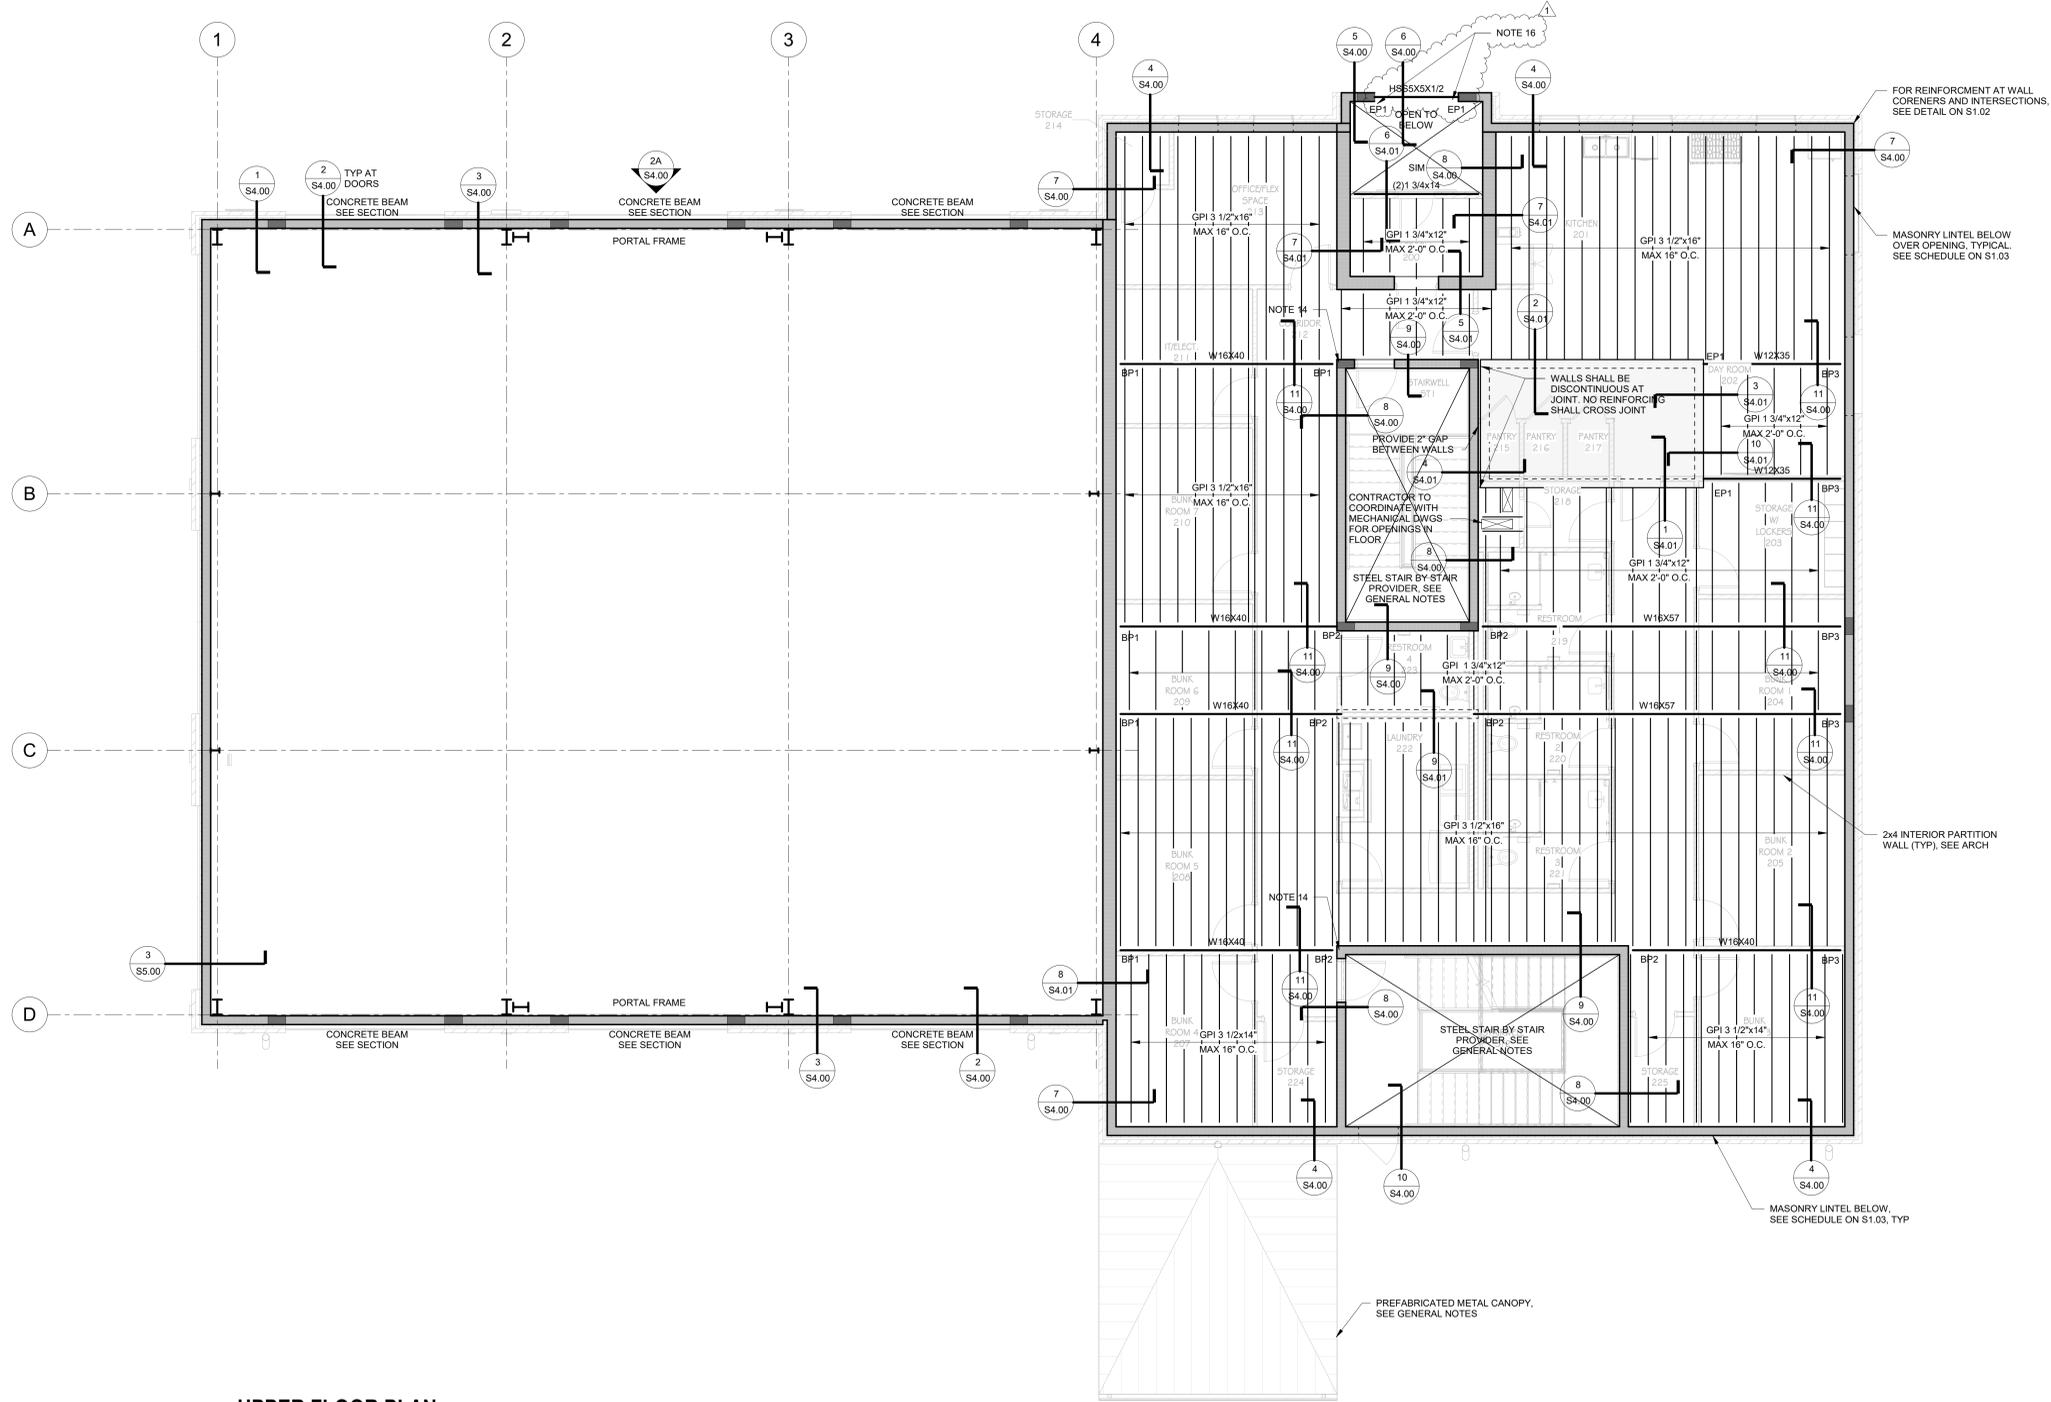

UPPER FLOOR PLAN

- 3/16" = 1'-0"
1. FINISH FLOOR (TOP OF SLAB) ELEVATION 13'-4", UNLESS NOTED.
 2. TOP OF STEEL ELEVATION 3 1/4" BFF, UNLESS NOTED.
 3. FLOOR SYSTEM:
 WOOD FLOORING: 3/4" PLYWOOD SHEATHING WITH 1" GYPCRETE TOPPING ON WOOD I-JOISTS. GLUE FLOOR TO JOISTS AND ANCHOR WITH 16d NAILS AT 6" AT ALL FOUR PANEL EDGES AND 12" AT INTERMEDIATE SUPPORTS. SEE GENERAL NOTES.
 SAFE ROOM ROOF: 12" THICK FORMED CAST-IN PLACE CONCRETE. REINFORCE WITH #5 AT 8" TOP AND BOTTOM, EACH WAY ON CENTER.
 4. SPACE WOOD I-JOISTS EQUALLY BETWEEN FACE OF WALLS OR STEEL, UNLESS NOTED.
 5. "BP" INDICATES BEARING PLATE. REFER TO TYPICAL DETAIL ON S1.03 FOR ADDITIONAL INFORMATION. OFFSET BEARING PLATE AS REQUIRED.
 6. "EP" INDICATES EMBED PLATE WITH HEADED ANCHOR RODS. PROVIDE FULL DEPTH CLIP ANGLE TO EMBED WITH MAXIMUM (2) 3/4" BOLTS. SEE DETAIL FOR ADDITIONAL INFORMATION.
 7. PROVIDE 8" BOND BEAM @48" O.C. FOR FULL HEIGHT OF WALL. REINFORCE W/ 2#4 CONT. UNLESS NOTED.
 8. HANGER LOCATION FOR PIPING LARGER THAN 3 INCHES IN DIAMETER MUST BE COORDINATED BY GENERAL CONTRACTOR WITH WOOD I-JOIST PROVIDER.
 9. METAL BUILDING MANUFACTURER TO USE FRAME LINES AS INDICATED. WHERE THIS IS NOT FEASIBLE, THE METAL BUILDING SHOP DRAWINGS SHOULD CLEARLY DESIGNATE ANY DEVIATIONS. ARCHITECT MUST APPROVE ANY CHANGES MADE TO THE FRAME LAYOUTS PRIOR TO FABRICATION.
 10. LOCATIONS OF THE PORTAL FRAMES AND BRACED FRAMES FOR LATERAL STABILITY OF THE STRUCTURE TO BE AS DIRECTED BY THE METAL BUILDING MANUFACTURER. EVERY EFFORT SHOULD BE MADE TO COORDINATE FRAMES WITH ARCHITECTURAL CONTRACT DOCUMENTS. LOCATIONS AND SIZE OF FRAME ELEMENTS SHOULD BE CLEARLY DEFINED ON SHOP DRAWINGS SUBMITTED FOR APPROVAL.
 11. METAL BUILDING PROVIDER TO LIMIT THE DEPTH OF PORTAL FRAME MEMBERS AS TO AVOID OPENINGS. SEE ARCH DRAWINGS FOR ADDITIONAL INFORMATION.
 12. SHADED REGION INDICATES CONCRETE ROOF/FLOOR SYSTEM. SEE PLAN, SECTIONS, AND GENERAL NOTES.
 13. WHERE MASONRY COLUMNS ARE SHOWN ON PLAN, REINFORCING TO CONTINUE TO ROOF LEVEL. IF MASONRY COLUMNS ARE NOT SHOWN, TERMINATE MASONRY COLUMN AT TOP OF MASONRY LINTEL.
 14. PROVIDE HOOK IN MASONRY LINTEL BELOW AT MASONRY COLUMN. FOR ADDITIONAL INFORMATION, SEE SCHEDULE ON S1.02.
 15. PROVIDE BLOCKING BETWEEN EACH WOOD I-JOIST AT BEARING. SEE SECTIONS FOR ADDITIONAL INFORMATION.
 16. PROVIDE 7 1/2" x 12 1/2" PLATE WITH (2) 3/4" ANCHOR AT EACH END OF BEAMS. INSTALL PLATE FLUSH TO FACE OF MASONRY COLUMNS. CHIP MASONRY AS NECESSARY. WELD HSS BEAMS TO EMBEDS WITH 3/16" WELD ALL AROUND.

GMC

Goodwyn Mills Cawood, LLC
 117 Jefferson Street North
 Huntsville, AL 35801
 T 256.539.3431
 GMCNETWORK.COM

ISSUE	DATE
CONSTRUCTION DOCUMENTS	01/09/26
ADDENDUM 4	02/06/26

DRAWN BY: TRM
 CHECKED BY: HCW


ASHVILLE FIRE STATION #2
 222 7TH Avenue North
 Ashville, AL 35953

GMC # AHUN250003

01/09/2026

UPPER FLOOR PLAN

S2.01

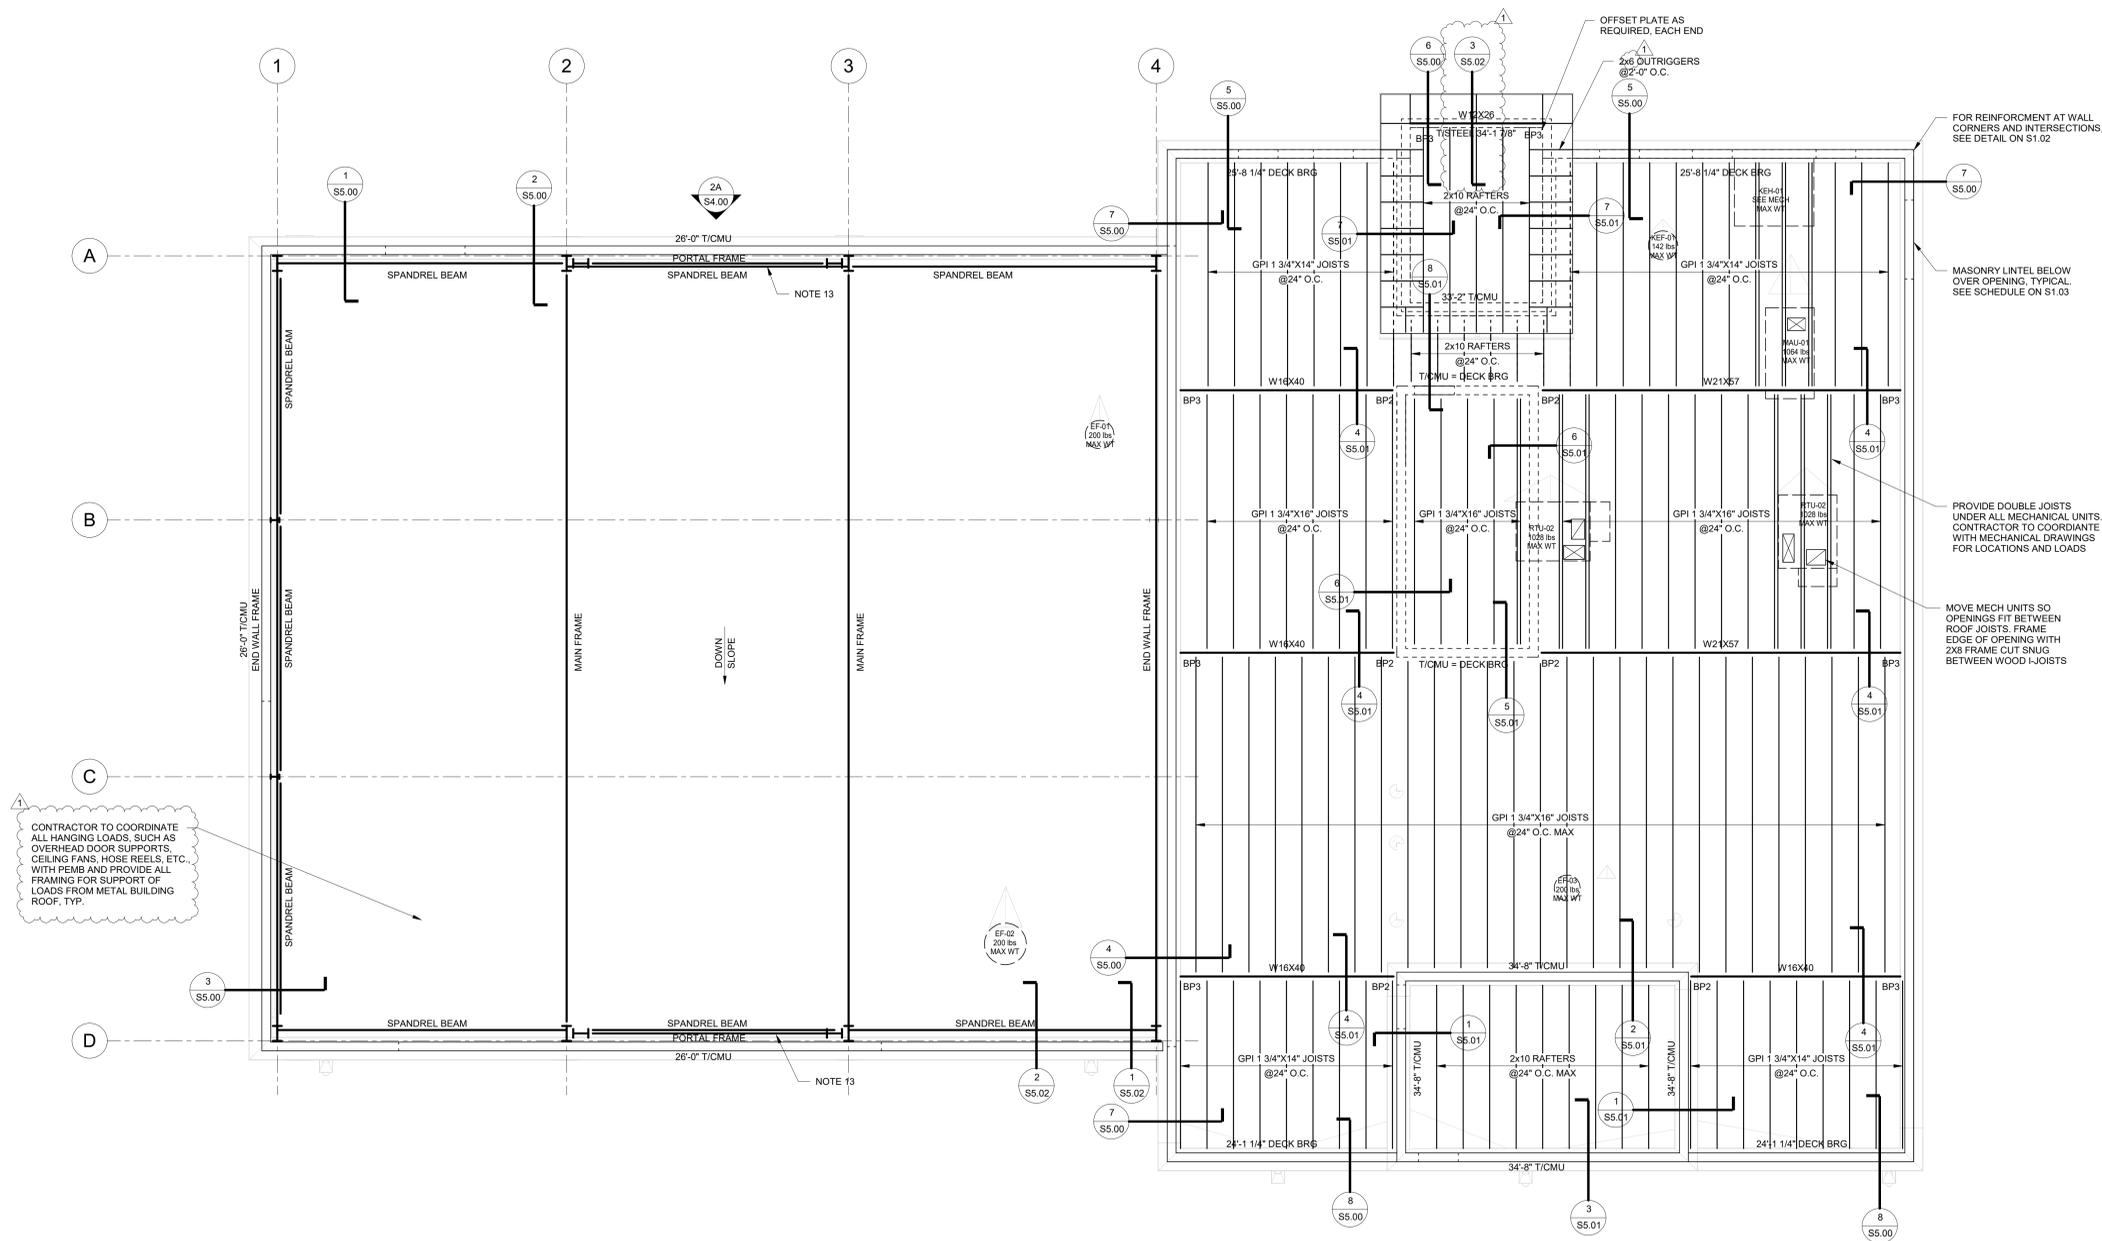

ROOF PLAN

3/16" = 1'-0"

1. TOP OF CMU ELEVATION 25'-4" UNLESS NOTED.
2. TOP OF WOOD I-JOISTS VARIES. SEE PLAN.
3. DECK BEARING VARIES AND SLOPES. SEE PLAN.
4. ROOF SYSTEM:
 PREFABRICATED METAL BUILDING. PREFABRICATED METAL BUILDING FRAMES WITH PURLINS SUPPORTING STANDING SEAM METAL ROOFING.
 WOOD ROOF: 3/4" PLYWOOD SHEATHING ON WOOD I-JOISTS. GLUE ROOF TO JOISTS AND ANCHOR WITH 16d NAILS AT 6" AT ALL FOUR PANEL EDGES AND 12" AT INTERMEDIATE SUPPORTS. SEE GENERAL NOTES.
5. TOP OF STEEL VARIES. STEEL IS LOCATED 9" BELOW T/DECK. SEE SECTIONS FOR ADDITIONAL INFORMATION.
6. SPACE WOOD I-JOISTS BETWEEN FACE OF WALLS AS INDICATED ON PLAN.
7. HANGER LOCATION FOR PIPING LARGER THAN 3 INCHES IN DIAMETER MUST BE COORDINATED BY GENERAL CONTRACTOR WITH THE WOOD I-JOIST PROVIDER AND METAL BUILDING MANUFACTURER. FOR PIPING WEIGHTS, SEE TYPICAL DETAIL ON S1.03.
8. PROVIDE SLOPED HANGERS AT ALL WOOD I-JOISTS CONNECTIONS TO BEAMS.
9. PROVIDE 6" BOND BEAM @48" O.C FOR FULL HEIGHT OF WALL. REINFORCE W/ #44 CONT. UNLESS NOTED.
10. AT SPANDREL BEAMS. SEE PLAN. METAL BUILDING PROVIDER TO PROVIDE FRAMING FOR THE CONNECTION OF THE SPANDREL BEAMS TO THE METAL BUILDING COLUMNS. METAL BUILDING PROVIDER TO DESIGN SPANDREL BEAM FOR 600 PLF (SERVICE WIND LOAD) AND LIMIT DEFLECTION THE LESSER OF L/600, H/600, OR 0.3 INCHES.
11. EQUIPMENT LOCATIONS AND WEIGHTS SHOWN ARE APPROXIMATE. THE GENERAL CONTRACTOR SHALL COORDINATE AND VERIFY THE SIZE, WEIGHT, AND LOCATION OF ALL MECHANICAL UNITS WITH THE I-JOIST PROVIDER. CONTRACTOR TO PROVIDE ROOF EQUIPMENT FRAMING AT ALL MECHANICAL UNITS.
12. METAL BUILDING MANUFACTURER TO USE FRAME LINES AS INDICATED. WHERE THIS IS NOT FEASIBLE, THE METAL BUILDING SHOP DRAWINGS SHOULD CLEARLY DESIGNATE ANY DEVIATIONS. ARCHITECT MUST APPROVE ANY CHANGES MADE TO THE FRAME LAYOUTS PRIOR TO FABRICATION.
13. LOCATIONS OF THE PORTAL FRAMES AND BRACED FRAMES FOR LATERAL STABILITY OF THE STRUCTURE TO BE AS DIRECTED BY THE METAL BUILDING MANUFACTURER. EVERY EFFORT SHOULD BE MADE TO COORDINATE FRAMES WITH ARCHITECTURAL CONTRACT DOCUMENTS. LOCATIONS AND SIZE OF FRAME ELEMENTS SHOULD BE CLEARLY DEFINED ON SHOP DRAWINGS SUBMITTED FOR APPROVAL.
14. METAL BUILDING PROVIDER TO LIMIT THE DEPTH OF PORTAL FRAME MEMBERS AS TO AVOID OPENINGS. SEE ARCH DRAWINGS FOR ADDITIONAL INFORMATION.
15. WHERE ROOF SUPPORTED/SUSPENDED MECHANICAL UNITS ARE LOCATED, THE CONTRACTOR SHALL COORDINATE ALL LOADING, CURB SUPPORTS, OPENING FRAMING, AND ANY ADDITIONAL SUPPORT REQUIREMENTS WITH THE METAL BUILDING PROVIDER. THE METAL BUILDING PROVIDER SHALL PROVIDE ALL FRAMING AS REQUIRED TO SUPPORT THE MECHANICAL UNITS, CURBS, AND ADDITIONAL MECHANICAL LOADS.



Goodwyn Mills Cawood, LLC
117 Jefferson Street North
Huntsville, AL 35801
T 256.539.3431
GMCNETWORK.COM

ISSUE DATE	CONSTRUCTION DOCUMENTS
01/09/26	CONSTRUCTION DOCUMENTS
02/06/26	ADDENDUM 4

DRAWN BY: TRM
CHECKED BY: HCW

ASHVILLE FIRE STATION #2

222 7TH Avenue North
Ashville, AL 35953




GMC # AHUN250003

ROOF FRAMING PLAN



01/09/2026

S2.02

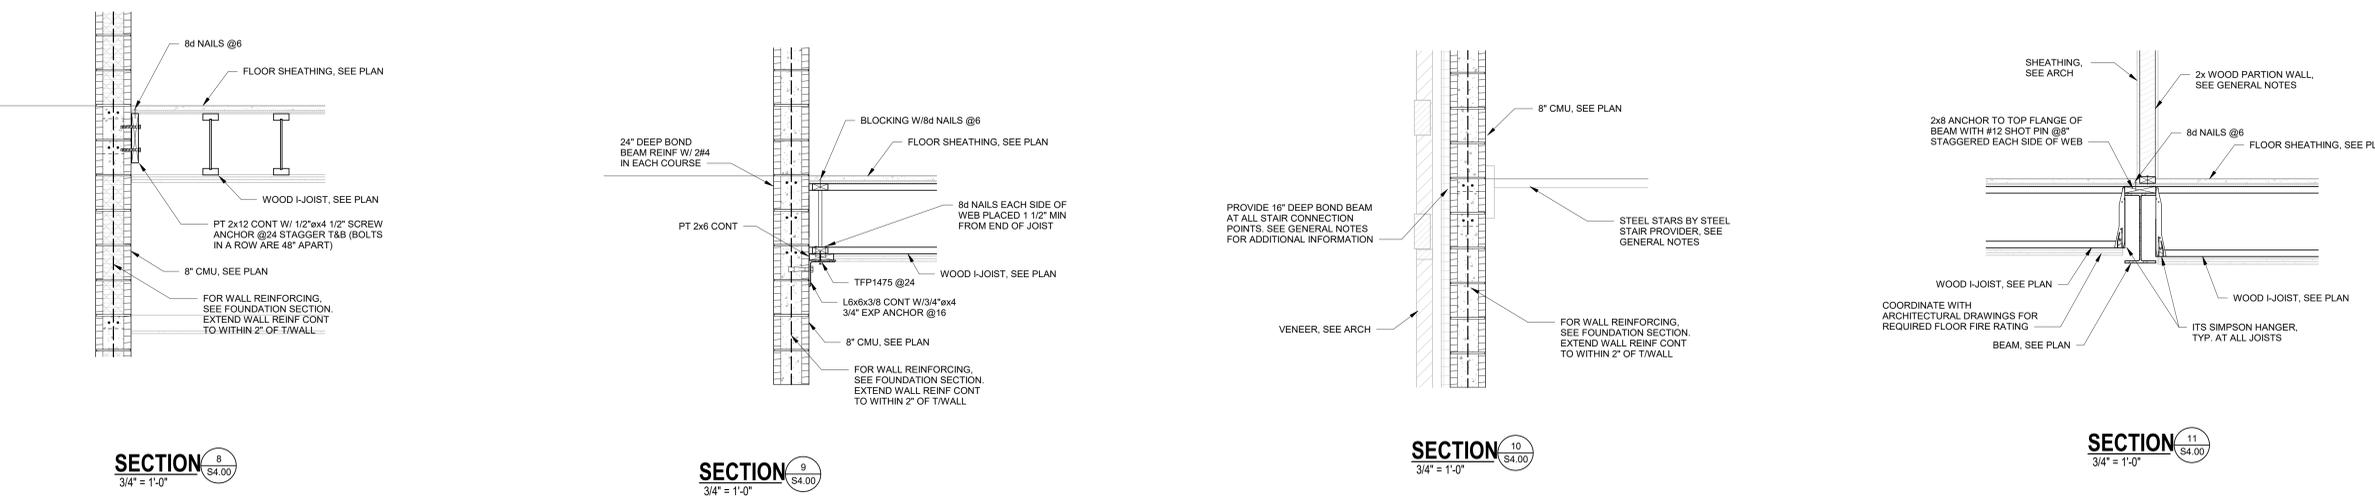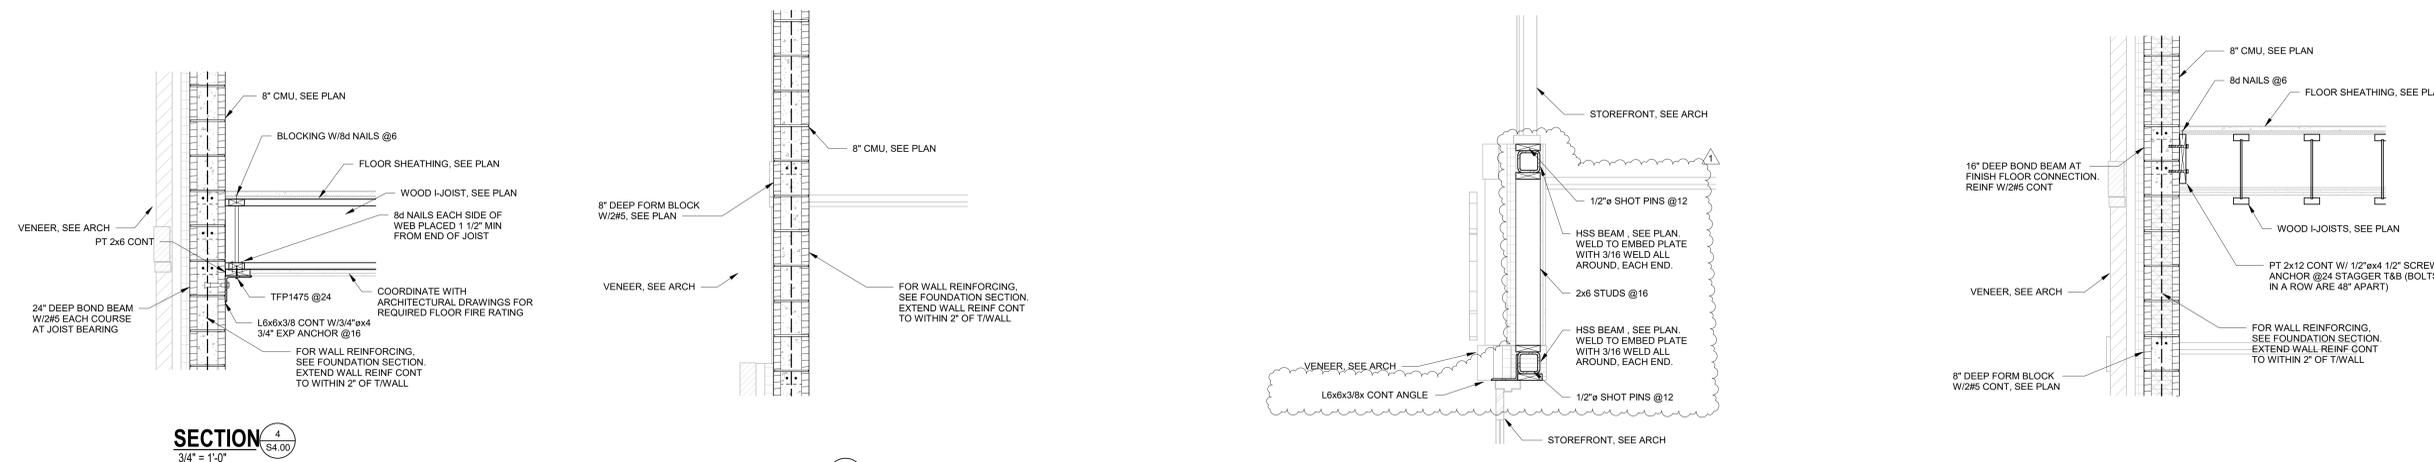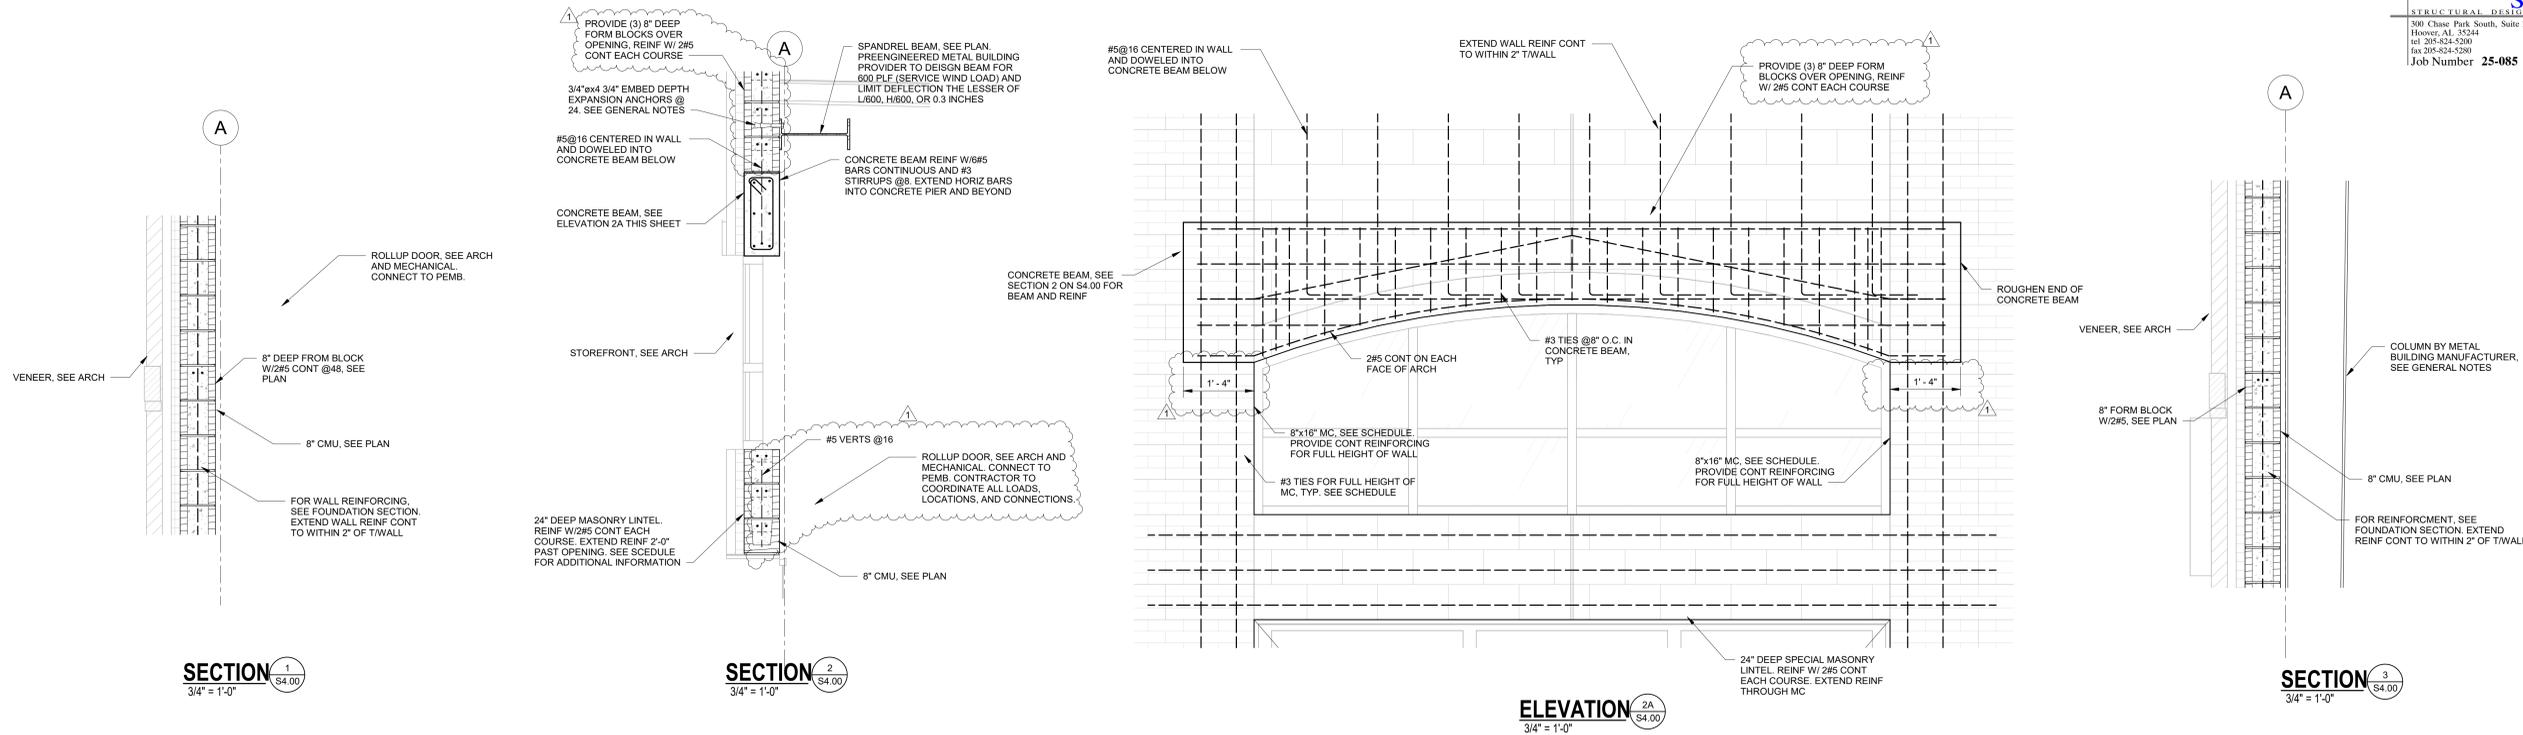

ISSUE	DATE
CONSTRUCTION DOCUMENTS	01/09/26
ADDENDUM 4	02/06/26

ASHVILLE FIRE STATION #2
222 7TH Avenue North
Ashville, AL 35953

Professional Engineer Seal
No. 2259
Professional Engineer
Craig Wilkerson
01/09/2026

SECTIONS AND DETAILS


ASHVILLE FIRE STATION #2
222 7TH Avenue North
Ashville, AL 35953

01/09/2026


S4.00

GMC # AHUN250003


DRAWN BY: TRM
CHECKED BY: HCW

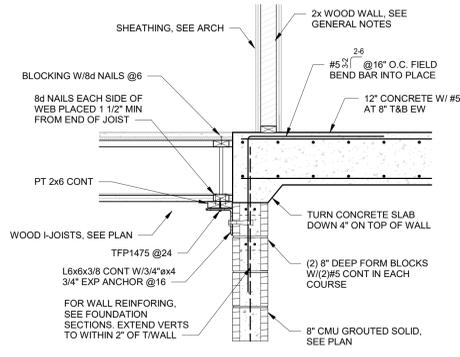


SECTION 1
 3/4" = 1'-0"

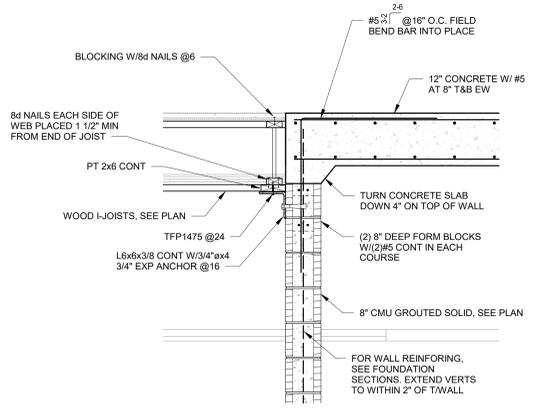


SECTION 2
 3/4" = 1'-0"

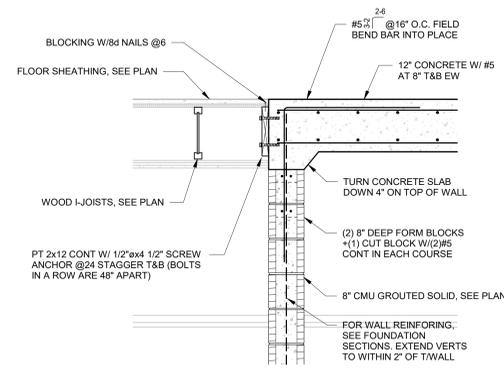


SECTION 3
 3/4" = 1'-0"

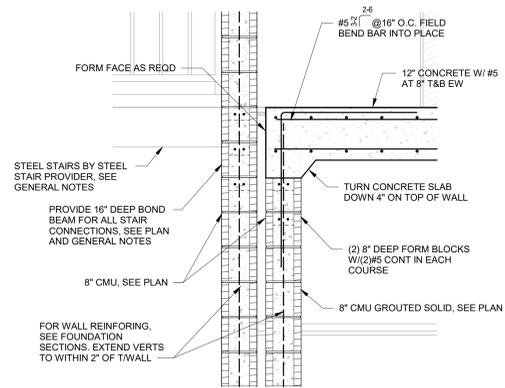


SECTION 4
 3/4" = 1'-0"

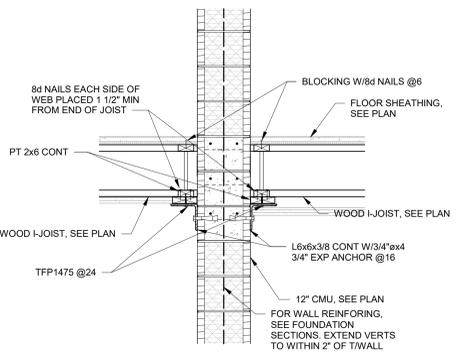


SECTION 5
 3/4" = 1'-0"

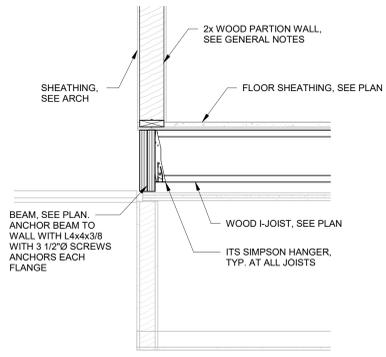


SECTION 6
 3/4" = 1'-0"

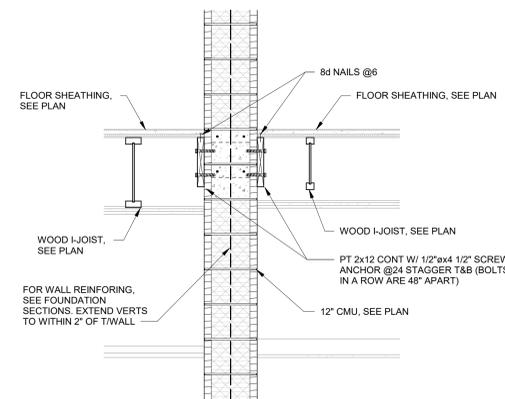


SECTION 7
 3/4" = 1'-0"

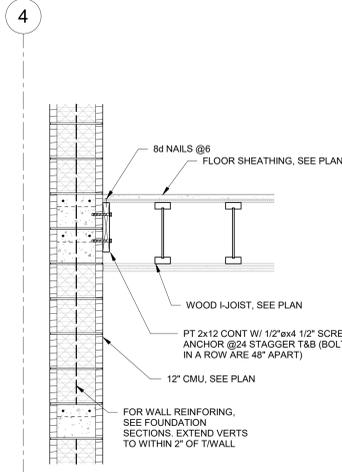

SECTION 8
 3/4" = 1'-0"

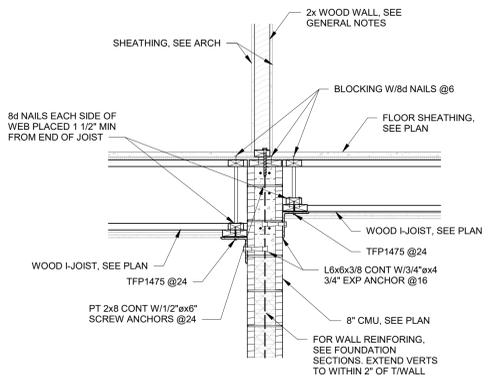

SECTION 9
 3/4" = 1'-0"

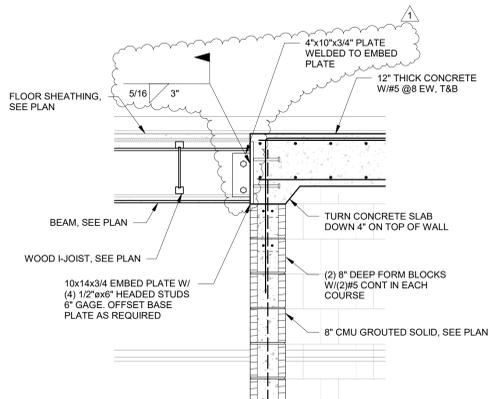

SECTION 10
 3/4" = 1'-0"

ISSUE	DATE
CONSTRUCTION DOCUMENTS	01/09/26
ADDENDUM 4	02/06/26

DRAWN BY: TRM
 CHECKED BY: HCW

ASHVILLE FIRE STATION #2

222 7TH Avenue North
 Ashville, AL 35953




01/09/2026


SECTIONS AND DETAILS

S4.01


GMC # AHUN250003

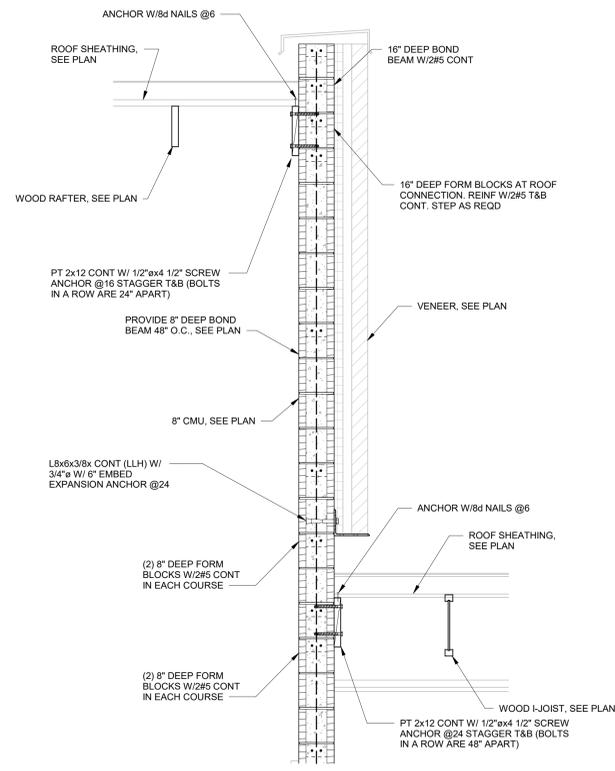


SECTION 1
 3/4" = 1'-0"
 SS.01

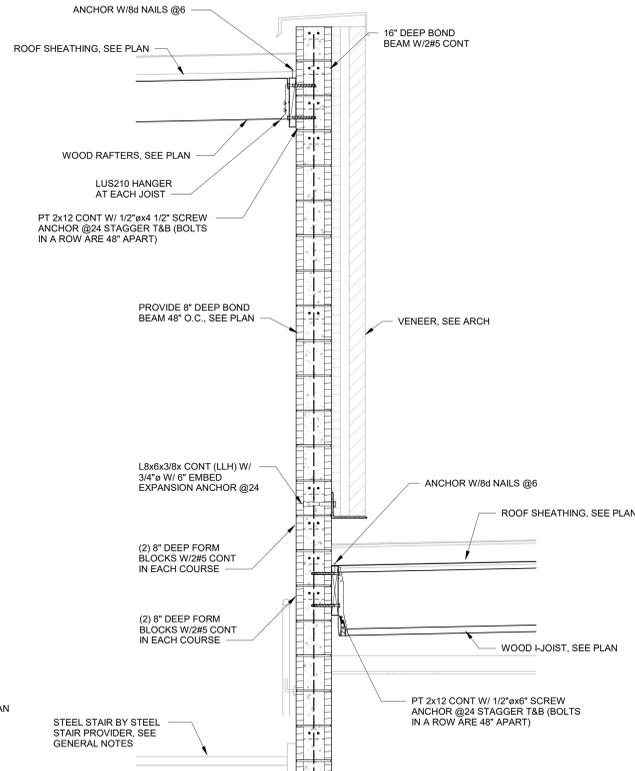


SECTION 2
 3/4" = 1'-0"
 SS.01

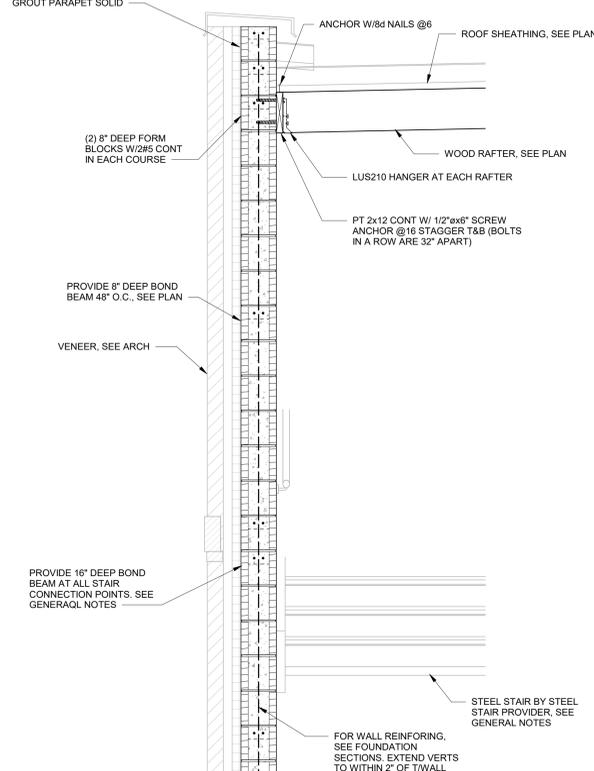


SECTION 3
 3/4" = 1'-0"
 SS.01

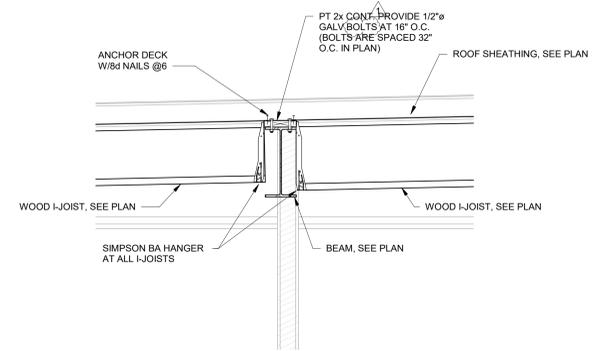


SECTION 4
 3/4" = 1'-0"
 SS.01

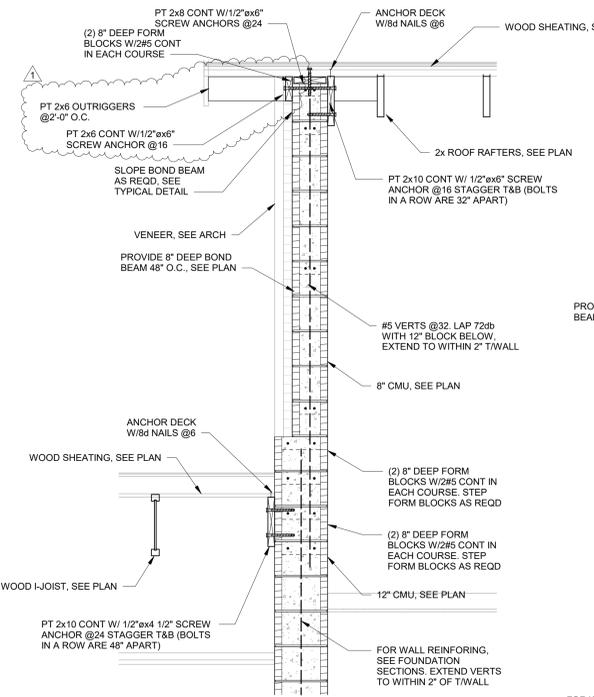


SECTION 5
 3/4" = 1'-0"
 SS.01

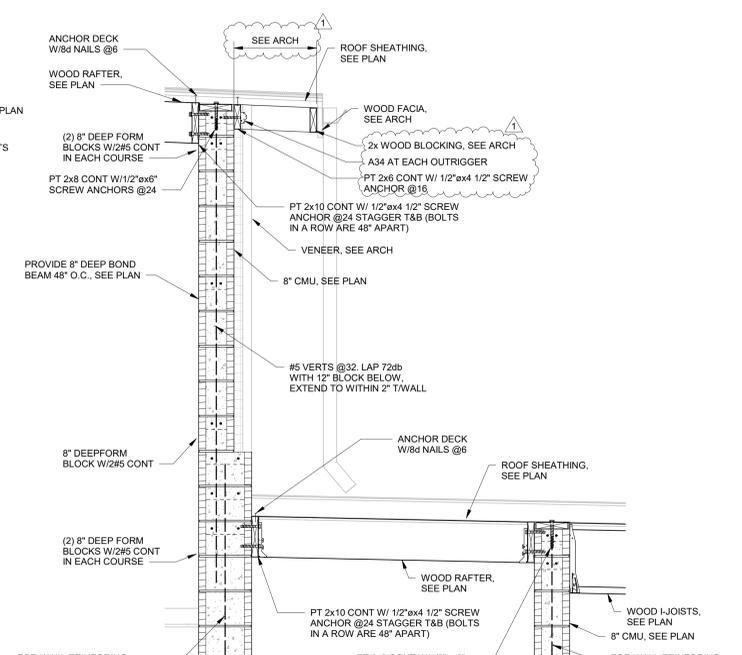


SECTION 6
 3/4" = 1'-0"
 SS.01

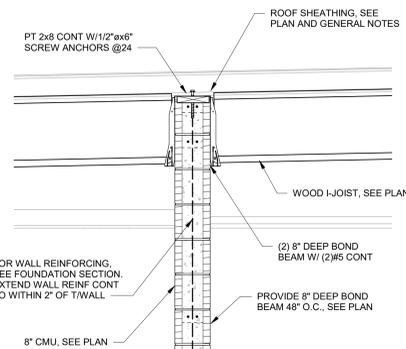


SECTION 7
 3/4" = 1'-0"
 SS.01

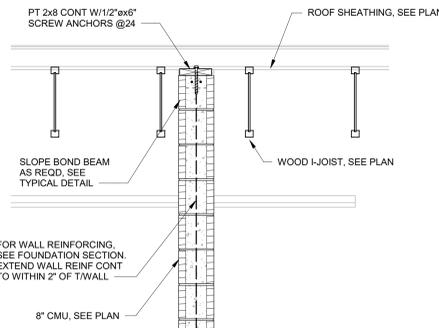

SECTION 8
 3/4" = 1'-0"
 SS.01

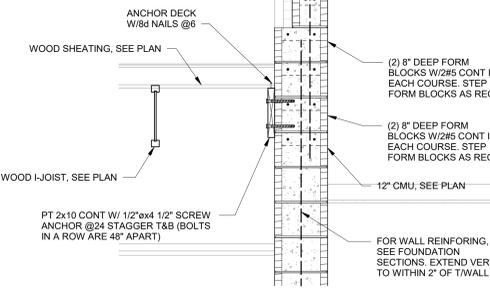

SECTION 9
 3/4" = 1'-0"
 SS.01

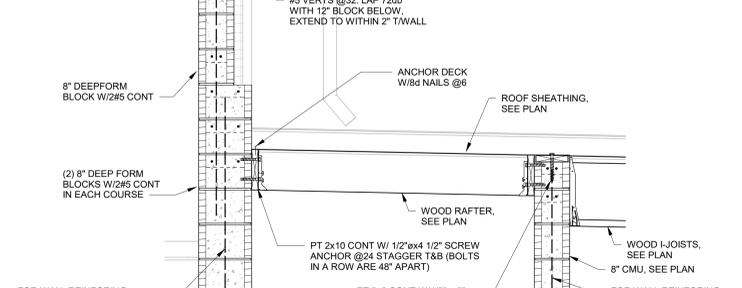

SECTION 10
 3/4" = 1'-0"
 SS.01

ISSUE	DATE
CONSTRUCTION DOCUMENTS	01/09/26
ADDENDUM 4	02/06/26

ASHVILLE FIRE STATION #2
 222 7TH Avenue North
 Ashville, AL 35953



01/09/2026


SECTIONS AND DETAILS

S5.01

GMC # AHUN250003

DRAWN BY: TRM
 CHECKED BY: HCW

H1 GYP TO ACT SOFFIT
SCALE: 1 1/2" = 1'-0"

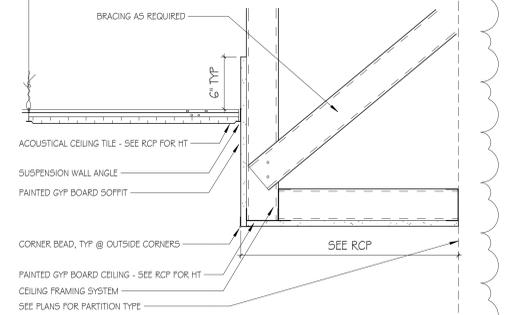

REFLECTED CEILING PLAN LEGEND

CEILING FINISHES:	LIGHTING:
LAY-IN ACOUSTICAL CEILING SYSTEM - 2X2'	2X2 LAY-IN FIXTURE
LAY-IN ACOUSTICAL CEILING SYSTEM - 2X4'	2X4 LAY-IN FIXTURE
GYP BOARD - INTERIOR EIFS SOFFIT - EXTERIOR	LINEAR SUSPENDED FIXTURE
EXPOSED STRUCTURE	LINEAR RECESSED FIXTURE
2X2 LAY-IN METAL CEILING SYSTEM	CIRCULAR SURF. MT. FIXTURE
2X2 LAY-IN WOOD CEILING SYSTEM	CIRCULAR PENDANT FIXTURE
RECESSED LIGHT POCKET	CIRCULAR RECESSED FIXTURE
	LINEAR WALL MT. FIXTURE
	CIRCULAR SURF. MT. FIXTURE
	CIRCULAR PENDANT FIXTURE
	CIRCULAR RECESSED FIXTURE
	CIRCULAR RECESSED FIXTURE
	CIRCULAR RECESSED FIXTURE
	EXIT LIGHT
MECHANICAL:	
SUPPLY DIFFUSER	
RETURN AIR GRILLE	
EXHAUST FAN	

CEILING FINISH LEGEND


NUMBER	TYPE	DETAIL DESCRIPTION
ACT-1	ACOUSTICAL CEILING TILE SYSTEM	MANUFACTURER: ARMSTRONG CEILINGS STYLE: ULTIMA HIGH NRC - SQUARE LAY-IN 15/16" 1'940 COLOR: WHITE SIZE: 24" X 24" X 7/8" SUSPENSION SYSTEM: 15/16" PRELUDE - WHITE
GYP-1	GYP BOARD CEILING	PAINTED GYP BOARD CEILING COLOR: PNT-3 (U.N.O. ON RCP)
GYP-2	GYP BOARD CEILING	TYPE X GYP BOARD CEILING - 1 HOUR FIRE RATED COLOR: PNT-3 (U.N.O. ON RCP)
MGB-1	MOISTURE RESISTANT GYP BOARD CEILING	PAINTED GYP BOARD CEILING - MOISTURE RESISTANT COLOR: PNT-3 (U.N.O. ON RCP)
EXP-1	EXPOSED TO STRUCTURE	EXPOSED TO STRUCTURE - WITH NO FINISH

KEY NOTES - REFLECTED CEILING PLAN

KEY	KEYNOTE
RC1	SEE ELECTRICAL AND SPEC. FOR FAN
RC2	EXHAUST FAN SEE MECH.
RC3	GAS FIRED HEATER, SEE MECHANICAL AND ELECTRICAL
RC4	SEE ELECTRICAL FOR LIGHTING IN STAIRWELL
RC5	EXTERIOR WALL SCONCE, TYP. SEE ELECTRICAL
RC6	PREFINISHED SCUPPER BOX 4 DOWN SPOUT.
RC7	LOCATION OF ACCESS PANEL TO BE COORDINATED IN FIELD.

GENERAL NOTES - REFLECTED CEILING PLAN

1. CEILING HEIGHTS SHALL BE AS NOTED ON REFLECTED CEILING PLANS.
2. WHEREVER POSSIBLE NO CEILING TILE SHOULD BE LESS THAN 6" IN ANY DIRECTION.
3. SEE ELECTRICAL FOR ALL LIGHT FIXTURE TYPES AND SIZES.
4. SEE MECHANICAL FOR ALL DIFFUSER TYPES AND SIZES.
5. SEE INTERIOR ELEVATIONS FOR WALL MOUNTED LIGHT FIXTURE HEIGHT AND LOCATIONS.
6. COORDINATE LOCATIONS OF ALL LIGHTS, DIFFUSERS, AND DEVICES BETWEEN THIS RCP AND MECHANICAL, FIRE PROTECTION, AND ELECTRICAL. NOTIFY ARCHITECT OF ANY DISCREPANCIES FOUND BEFORE PROCEEDING.
7. WHERE EXIT SIGNS ARE LOCATED ABOVE DOORWAYS, CENTER FIXTURE OVER DOOR BUT MAINTAIN MINIMUM OVERHEAD CLEARANCE.
8. ALL SPRINKLER HEADS IN ACOUSTIC CEILINGS SHALL BE CENTERED IN CEILING TILE.
9. ALL BULKHEADS TO BE 4" BELOW ADJACENT ACT CEILING UNLESS NOTED OTHERWISE.
10. SEE ELECTRICAL FOR EMERGENCY LIGHTS.
11. PROVIDE CEILING ACCESS PANEL IN ALL RESTROOMS. COORDINATE LOCATION IN FIELD TO BEST ACCESS ABOVE CEILING MECHANICAL EQUIPMENT.

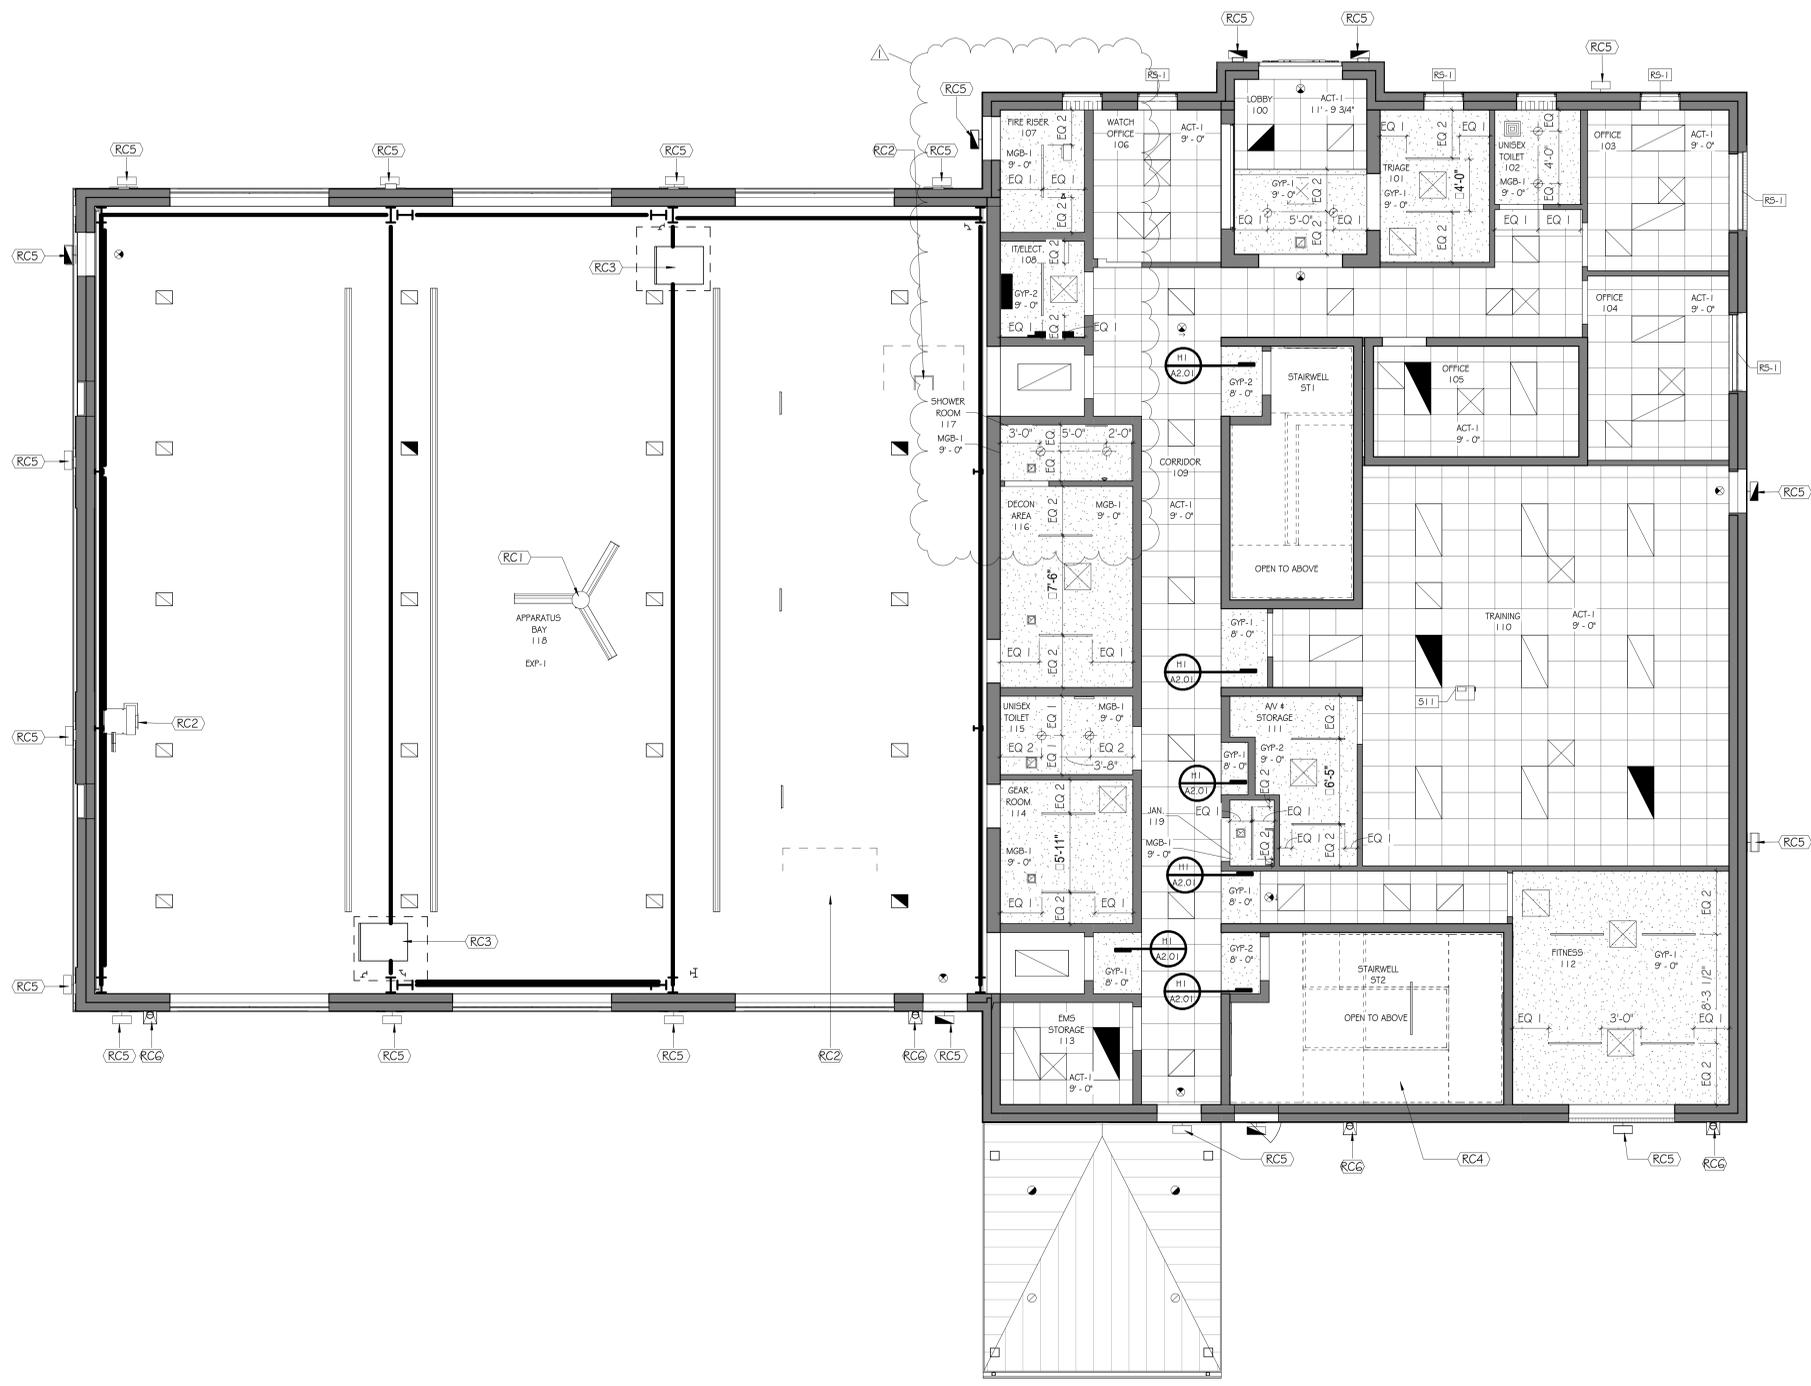

A2 REFLECTED CEILING PLAN - LEVEL 1
SCALE: 3/16" = 1'-0"



Goodwyn Mills Cawood, LLC
117 Jefferson Street North
Huntsville, AL 35801
T 256.539.3431
GMCNETWORK.COM

ISSUE	DATE
100% CONSTRUCTION DOCUMENTS	1/9/2026
ADDENDUM 4	2/6/2026

ASHVILLE FIRE STATION #2
222 7TH Avenue North
Ashville, AL 35953




01/09/2026
REFLECTED CEILING PLAN - LEVEL 1
A2.01

GMC # A-HUN250003

2/6/2026 4:35:27 PM TEMPLATE VERSION: 2025.1

A1 REFLECTED CEILING PLAN - LEVEL 2

SCALE: 3/16" = 1'-0"

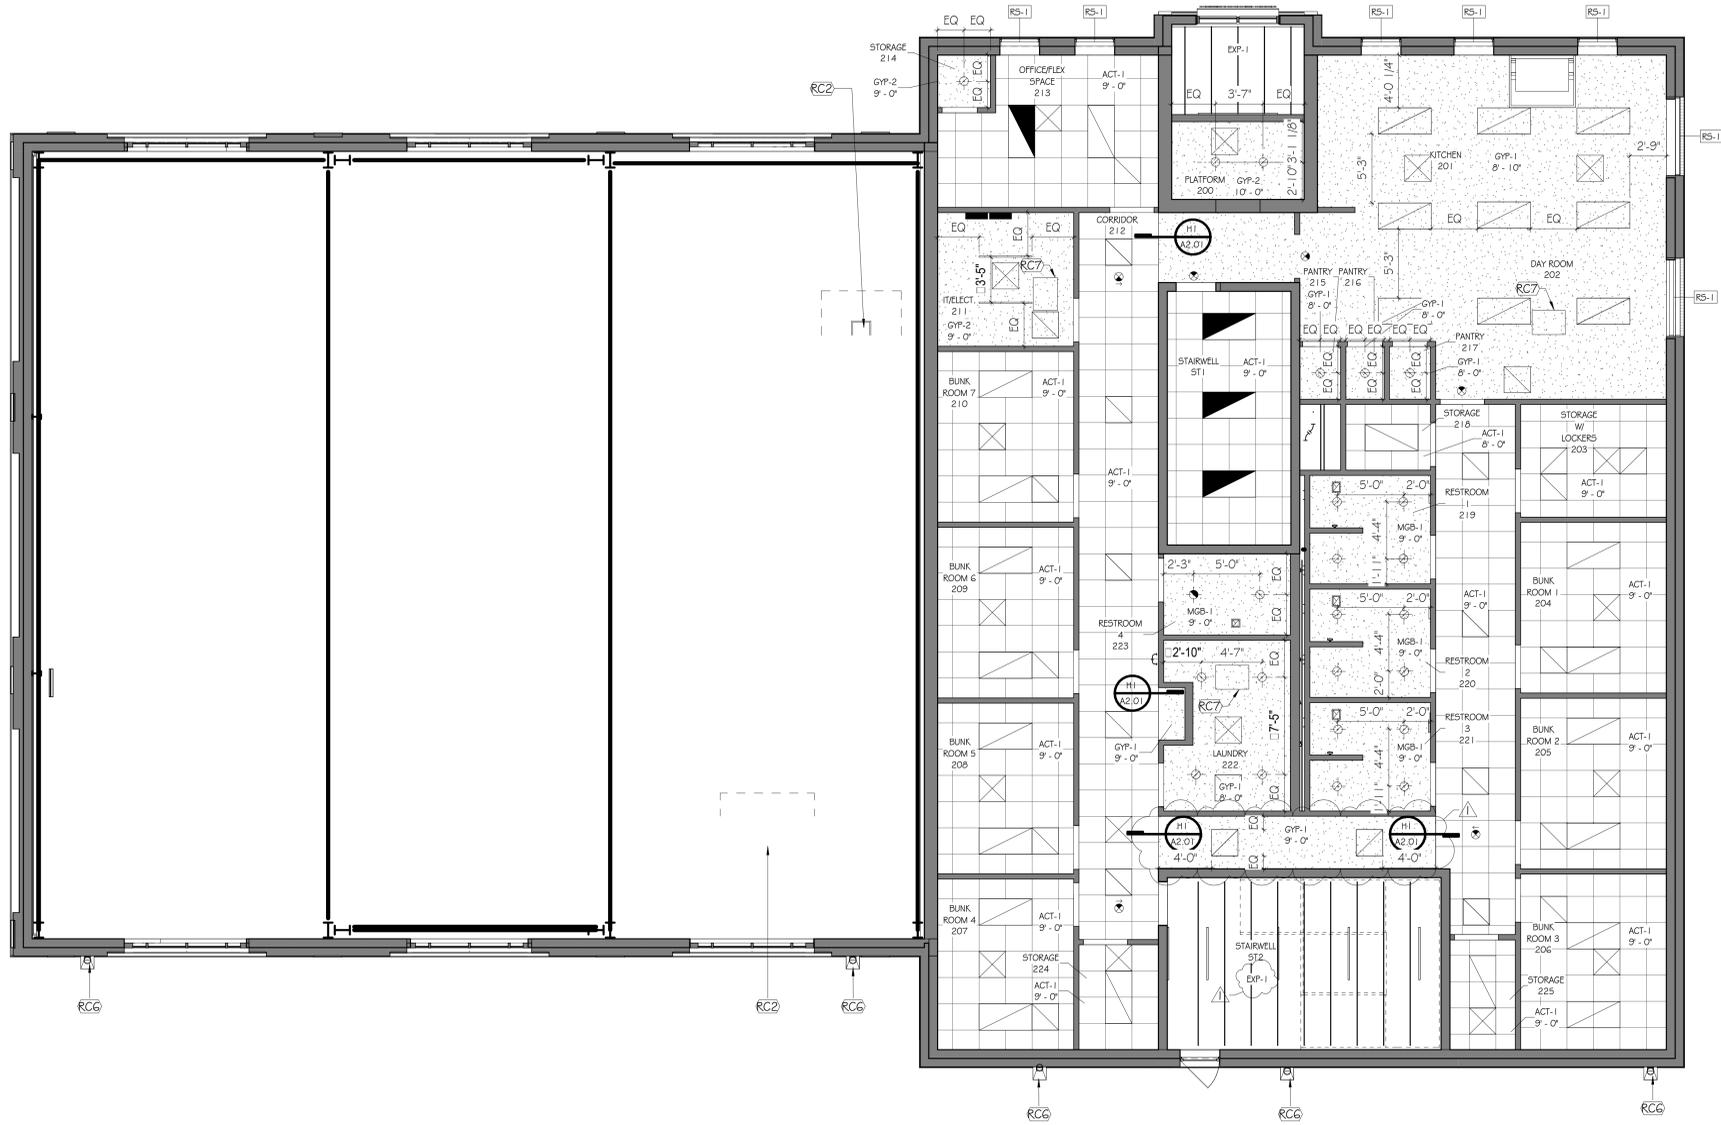

REFLECTED CEILING PLAN LEGEND

CEILING FINISHES:	LIGHTING:
LAY-IN ACOUSTICAL CEILING SYSTEM - 2X2'	2X2 LAY-IN FIXTURE
LAY-IN ACOUSTICAL CEILING SYSTEM - 2X4'	2X4 LAY-IN FIXTURE
GYP BOARD - INTERIOR EIFS SOFFIT - EXTERIOR	LINEAR SUSPENDED FIXTURE
EXPOSED STRUCTURE	LINEAR RECESSED FIXTURE
2X2 LAY-IN METAL CEILING SYSTEM	LINEAR WALL MT. FIXTURE
2X2 LAY-IN WOOD CEILING SYSTEM	CIRCULAR SURF. MT. FIXTURE
RECESSED LIGHT POCKET	CIRCULAR PENDANT FIXTURE
	CIRCULAR RECESSED FIXTURE
	CIRCULAR WALL MT. FIXTURE
	EXIT LIGHT
MECHANICAL:	
SUPPLY DIFFUSER	
RETURN AIR GRILLE	
EXHAUST FAN	

CEILING FINISH LEGEND

NUMBER	TYPE	DETAIL DESCRIPTION
ACT-1	ACOUSTICAL CEILING TILE SYSTEM	MANUFACTURER: ARMSTRONG CEILINGS STYLE: ULTIMA HIGH NRC - SQUARE LAY-IN 15/16" 1940 COLOR: WHITE SIZE: 24" X 24" X 7/8" SUSPENSION SYSTEM: 15/16" PRELUDE - WHITE
GYP-1	GYP BOARD CEILING	PAINTED GYP BOARD CEILING COLOR: PNT-3 (U.N.O. ON RCP)
GYP-2	GYP BOARD CEILING	TYPE X GYP BOARD CEILING - 1 HOUR FIRE RATED COLOR: PNT-3 (U.N.O. ON RCP)
MGB-1	MOISTURE RESISTANT GYP BOARD CEILING	PAINTED GYP BOARD CEILING - MOISTURE RESISTANT COLOR: PNT-3 (U.N.O. ON RCP)
EXP-1	EXPOSED TO STRUCTURE	EXPOSED TO STRUCTURE - WITH NO FINISH

KEY NOTES - REFLECTED CEILING PLAN

KEY	KEYNOTE
RC1	SEE ELECTRICAL AND SPEC. FOR FAN
RC2	EXHAUST FAN SEE MECH.
RC3	GAS FIRED HEATER, SEE MECHANICAL AND ELECTRICAL
RC4	SEE ELECTRICAL FOR LIGHTING IN STAIRWELL
RC5	EXTERIOR WALL SCONCE, TYP. SEE ELECTRICAL
RC6	PREFINISHED SCUPPER BOX 4 DOWN SPOUT.
RC7	LOCATION OF ACCESS PANEL TO BE COORDINATED IN FIELD.


GENERAL NOTES - REFLECTED CEILING PLAN

- CEILING HEIGHTS SHALL BE AS NOTED ON REFLECTED CEILING PLANS.
- WHEREVER POSSIBLE NO CEILING TILE SHOULD BE LESS THAN 6" IN ANY DIRECTION.
- SEE ELECTRICAL FOR ALL LIGHT FIXTURE TYPES AND SIZES.
- SEE MECHANICAL FOR ALL DIFFUSER TYPES AND SIZES.
- SEE INTERIOR ELEVATIONS FOR WALL MOUNTED LIGHT FIXTURE HEIGHT AND LOCATIONS.
- COORDINATE LOCATIONS OF ALL LIGHTS, DIFFUSERS, AND DEVICES BETWEEN THIS RCP AND MECHANICAL, FIRE PROTECTION, AND ELECTRICAL. NOTIFY ARCHITECT OF ANY DISCREPANCIES FOUND BEFORE PROCEEDING.
- WHERE EXIT SIGNS ARE LOCATED ABOVE DOORWAYS, CENTER FIXTURE OVER DOOR BUT MAINTAIN MINIMUM OVERHEAD CLEARANCE.
- ALL SPRINKLER HEADS IN ACOUSTIC CEILINGS SHALL BE CENTERED IN CEILING TILE.
- ALL BULKHEADS TO BE 4" BELOW ADJACENT ACT CEILING UNLESS NOTED OTHERWISE.
- SEE ELECTRICAL FOR EMERGENCY LIGHTS.
- PROVIDE CEILING ACCESS PANEL IN ALL RESTROOMS. COORDINATE LOCATION IN FIELD TO BEST ACCESS ABOVE CEILING MECHANICAL EQUIPMENT.

ASHVILLE FIRE STATION #2
222 7TH Avenue North
Ashville, AL 35953

Goodwyn Mills Cawood, LLC
117 Jefferson Street North
Huntsville, AL 35801
T 256.539.3431
GMCNETWORK.COM

REFLECTED CEILING
PLAN - LEVEL 2

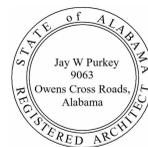

01/09/2026

A2.02

GMC # AHUN250003

ISSUE DATE
100% CONSTRUCTION DOCUMENTS 1/9/2026
ADDENDUM 4/2/6/2026

DRAWN BY: Author
CHECKED BY: Checker



FLOORS:	WALLS:	MISC:	RCF NOTES:
- REFER TO FLOOR FINISH PLANS FOR FLOOR PATTERN. CONTRACTOR MUST NOTIFY INTERIOR DESIGNER BEFORE INSTALLATION OF FLOORING TO REVIEW DESIGN INTENT OF FLOOR PATTERN PLAN - ALL FLOORING TRANSITIONS INCLUDING TRANSITIONS TO SIMILAR MATERIAL OR REDUCER STRIPS AND OTHER THRESHOLDS TO DISSIMILAR MATERIAL SHALL BE LOCATED AT THE CENTERLINE OF DOOR WHEN IN CLOSED POSITION. COLORS SHALL BE SELECTED DURING SUBMITTAL REVIEW. REFER TO DETAILS FOR TRANSITIONS BETWEEN FLOORING MATERIALS. CONTRACTOR TO PROVIDE TRANSITION SIZES APPROPRIATE FOR THICKNESS - AVOID ALL FLOORING MATERIAL SLIVER CUTS LESS THAN 4" WIDE @ WALL PERIMETERS & MATERIAL TRANSITIONS. CONTACT DESIGNER IF JOBSITE CONDITIONS DIFFER. - INSTALL FLOORING CONTINUOUS UNDER ALL CASEWORK, MILLWORK, EQUIPMENT, & FURNITURE - ALIGN VERTICAL GROUT JOINTS IN TILE BASE WITH THOSE IN THE FLOOR TILE UNLESS NOTED OTHERWISE	- REFER TO FINISH PLANS & ELEVATIONS FOR LOCATION OF ACCENT PAINT COLORS - ALL HOLLOW METAL DOOR & WINDOW FRAMES TO BE PAINTED (PNT-2) UNLESS OTHERWISE NOTED - ALL ACCESS PANELS AND MISCELLANEOUS METAL (RETURN AND AIR SUPPLY GRILLES, EXPANSION JOINTS, ETC.) LOCATED ON WALL SURFACES OR CEILING SURFACES TO BE PAINTED WALL OR CEILING COLOR U.N.O. - WALL BASE TO BE INSTALLED ON ALL WALLS, MILLWORK, AND CASEWORK U.N.O. - INSTALL FINISH STRIP EQUAL TO SCHLUTER "JOLLY" AT ALL EXPOSED TILE EDGES & CORNERS MILLWORK / CASEWORK: - INSTALL 3MM EDGE BAND ON ALL PLASTIC LAMINATE COUNTERTOPS AND CABINETS. - ALL WINDOWS TO HAVE SOLID SURFACE (SS-2) SILL U.N.O. - GROMMET LOCATIONS TO BE COORDINATED WITH OWNER - FIELD VERIFY ALL DIMENSIONS FOR CASEWORK & MILLWORK PRIOR TO FABRICATION & INSTALLATION - ALL EXPOSED ENDS AND EXPOSED INTERIORS OF CASEWORK/MILLWORK TO RECEIVE MATCHING LAMINATES - ALL FILE DRAWERS TO BE LOCKABLE.	- DO NOT PAINT DOOR LABELS AT RATED DOORS OR FRAMES. - PROVIDE BLOCKING AS REQUIRED AT ALL TELEVISION LOCATIONS - COORDINATE WITH OWNER'S EQUIPMENT - PROVIDE BLOCKING FOR ALL GRAB BARS AND TOILET ACCESSORIES - REFER TO RCF FOR ACCENT PAINT COLOR LOCATIONS IN CEILING - WHERE CEILINGS ARE CALLED OUT TO BE PAINTED, BOTH CEILING AND SOFFIT/BULKHEAD WALLS ARE TO BE PAINTED ACCENT COLOR - ROLLER SHADES AND BLINDS ARE TAGGED ON THE RCF - NON ADA TOILET FIXTURES SHALL BE CENTERED IN STALL - WALL TILE TO BE INSTALLED TO CEILING ON ALL WET WALLS (REVISE THIS NOTE ACCORDINGLY) - CAULK ALL DOOR FRAMES, MILLWORK, AND VIEW WINDOW FRAMES AFTER WALLCOVERING INSTALLATION IS COMPLETE. COLOR OF CAULK TO MATCH ADJACENT FINISH. - GC TO PROVIDE SPECIFIED EXPANSION JOINT COVER AT ALL EXPOSED FINISH FLOOR, CEILING, AND WALL LOCATIONS - MARKER BOARDS HEIGHTS TO BE (3'-0" A.F.F.) TO THE BOTTOM OF WRITING SURFACE. GC TO COORDINATE WALL BLOCKING AS REQ'D. - ALL PARTIES RESPONSIBLE FOR DELIVERING FINISHES TO THE SITE SHALL CHECK AVAILABILITY OF QUANTITIES AND DELIVERY DATES UPON NOTICE TO PROCEED. NO CONSIDERATION WILL BE GIVEN FOR FAILURE TO COMPLY WITH THIS REQUIREMENT.	- ALL SPRINKLER HEADS IN FINISHED CEILINGS ALL SHALL BE CENTERED IN CEILING TILE. SPRINKLER HEADS SHALL NOT BE PAINTED. - INTERIOR CEILING HEIGHTS SHALL BE AS INDICATED ON THE REFLECTED CEILING PLANS. - ALL BULKHEADS TO BE 4" BELOW ADJACENT ACT CEILING UNLESS NOTED OTHERWISE - WHERE EXIT SIGNS ARE LOCATED ABOVE DOORWAYS, CENTER ABOUT DOOR, BUT MAINTAIN MINIMUM OVERHEAD CLEARANCE. - IN EXPOSED CEILINGS (EXP-2) ALL EXPOSED ELEMENTS NOT LIMITED TO TRUSS SYSTEM, ACOUSTICAL DECK, DUCTWORK, CONDUIT, AND PIPING TO BE PAINTED - ALL GYP CEILINGS TO BE PAINTED (PNT-3) UNLESS OTHERWISE NOTED IN RCF. BOTH CEILING AND SOFFIT /BULKHEAD SURFACES ARE TO BE PAINTED THE SAME COLOR. - DO NOT INSTALL CEILING TILE LESS THAN 6" IN ANY DIRECTION - WHEN POSSIBLE CENTER TILE IN ROOM. - COORDINATE WITH OWNER'S AV CONSULTANT FOR PROJECTION SCREEN AND PROJECTOR LOCATIONS

ROOM FINISH SCHEDULE

ROOM #	ROOM NAME	FLOOR	BASE	WALL	MILLWORK/CASEWORK		COMMENTS
					CABINET	COUNTERTOP	
100	LOBBY	WOC-1, LVT-1	RB-1	PNT-1, WP-1			
101	TRIAGE	LVT-1	RB-1	PNT-1, WP-1	PL-2	SS-1	EPOXY PAINT
102	UNISEX TOILET	EF-1	EB-1	PNT-1, HTW-1			EPOXY PAINT
103	OFFICE	LVT-1	RB-1	PNT-1			
104	OFFICE	LVT-1	RB-1	PNT-1			
105	OFFICE	SC-1	RB-1	PNT-1			
106	WATCH OFFICE	SC-1	RB-1	PNT-1			
107	FIRE RISER	SC-1	RB-1	PNT-1			
108	IT/ELECT.	SC-1	RB-1	PNT-1			
109	CORRIDOR	SC-1	RB-1	PNT-1, PNT-4, HTW-1			
110	TRAINING	SC-1	RB-1	PNT-1, PNT-4, PNT-6			
111	AV & STORAGE	SC-1	RB-1	PNT-1			
112	FITNESS	SC-1	RB-1	PNT-4, PNT-5, PNT-6			
113	EMS STORAGE	SC-1	RB-1	PNT-1			
114	GEAR ROOM	SC-1	RB-1	PNT-1			
115	UNISEX TOILET	EF-1	EB-1	PNT-1, HTW-1			EPOXY PAINT
116	DECON AREA	EF-1	EB-1	PNT-1	PL-2	SS-1	EPOXY PAINT
117	SHOWER ROOM	EF-1	EB-1	PNT-1, HTW-1			EPOXY PAINT
118	APPARATUS BAY	SC-1	RB-1	PNT-1, PNT-4			
119	JAN.	SC-1	RB-1	PNT-1, WP-1			EPOXY PAINT
200	PLATFORM	LVT-1	RB-1	PNT-1			
201	KITCHEN	LVT-1	RB-1	PNT-1, PNT-4	MILLWORK	STAINLESS STEEL	
202	DAY ROOM	LVT-1	RB-1	PNT-1, PNT-4, PNT-6			
203	STORAGE W/ LOCKERS	LVT-1	RB-1	PNT-1			
204	BUNK ROOM 1	LVT-1	RB-1	PNT-5			
205	BUNK ROOM 2	LVT-1	RB-1	PNT-5			
206	BUNK ROOM 3	LVT-1	RB-1	PNT-5			
207	BUNK ROOM 4	LVT-1	RB-1	PNT-5			
208	BUNK ROOM 5	LVT-1	RB-1	PNT-5			
209	BUNK ROOM 6	LVT-1	RB-1	PNT-5			
210	BUNK ROOM 7	LVT-1	RB-1	PNT-5			
211	IT/ELECT.	LVT-1	RB-1	PNT-1			
212	CORRIDOR	LVT-1	RB-1	PNT-1, HTW-1			
213	OFFICE/FLEX SPACE	LVT-1	RB-1	PNT-1			
214	STORAGE	LVT-1	RB-1	PNT-1			
215	PANTRY	LVT-1	RB-1	PNT-1			
216	PANTRY	LVT-1	RB-1	PNT-1			
217	PANTRY	LVT-1	RB-1	PNT-1			
218	STORAGE	LVT-1	RB-1	PNT-1			
219	RESTROOM 1	HTF-1	HTB-1	PNT-1, HTW-1	PL-1	SS-1	EPOXY PAINT
220	RESTROOM 2	HTF-1	HTB-1	PNT-1, HTW-1	PL-1	SS-1	EPOXY PAINT
221	RESTROOM 3	HTF-1	HTB-1	PNT-1, HTW-1	PL-1	SS-1	EPOXY PAINT
222	LAUNDRY	SF-1	RB-1	PNT-1	PL-2		EPOXY PAINT
223	RESTROOM 4	HTF-1	HTB-1	PNT-1, HTW-1	PL-1	SS-1	EPOXY PAINT
224	STORAGE	LVT-1	RB-1	PNT-1			
225	STORAGE	LVT-1	RB-1	PNT-1			
ST1	STAIRWELL	RF-1, RST-1	RB-1	PNT-1, PNT-4			
ST1	STAIRWELL	RF-1, RST-1	RB-1	PNT-1, PNT-4			
ST2	STAIRWELL	RF-1, RST-1	RB-1	PNT-1, PNT-4			
ST2	STAIRWELL	RF-1, RST-1	RB-1	PNT-1, PNT-4			

FLOOR			BASE			MISC		
NUMBER	TYPE	DETAIL DESCRIPTION	NUMBER	TYPE	DETAIL DESCRIPTION	NUMBER	TYPE	DETAIL DESCRIPTION
HTF-1	HARD FLOOR TILE	MANUFACTURER: DAL TILE STYLE NAME: KEYSTONES IN ORGANIC HEXAGON COLOR: CASTLEROCK GROUT: TBD LOCATION: WHERE NOTED	RB-1	RUBBER BASE	MANUFACTURER: ROPPE STYLE NAME: PINNACLE RUBBER BASE -TYPE-TS-1/8" COLOR: 178 PEWTER SIZE: 4" INSTALLATION: CONTINUOUS LOCATION: WHERE NOTED	PL-1	PLASTIC LAMINATE	MANUFACTURER: WILSONART COLOR: LANDMARK WOOD LOCATION: WHERE NOTED
LVT-1	LUXURY VINYL TILE	MANUFACTURER: MOHAWK GROUP STYLE NAME: SECOYA 5.0 C2104 COLOR: 828 HONEY MAPLE SIZE: 9.48" X 59.06" THICKNESS: 5MM INSTALLATION: ASHLAR LOCATION: WHERE NOTED	HTB-1	HARD TILE BASE	MANUFACTURER: DAL TILE STYLE: MATCH HTW-1 COLOR: 828 HONEY MAPLE SIZE: 6" X 24" LOCATION: WHERE NOTED PROVIDE SCHLUTER DILEX-AHK AT FLOOR TILE TO WALL TILE TRANSITION - TYPICAL. INSTALL CUT SIDE DOWN WITH TRIM PIECE.	PL-2	PLASTIC LAMINATE	MANUFACTURER: WILSONART COLOR: PEPPERDUST LOCATION: WHERE NOTED
SC-1	SEALED CONCRETE	MANUFACTURER: EUCLID CHEMICAL STYLE NAME: 2 COATS: EUCCO DIAMOND HARD W/ EUCCO GRIP ANTI-SLIP ADDITIVE COLOR: CLEAR LOCATION: WHERE NOTED	EB-1	EPOXY BASE	MANUFACTURER: MATCH EF-1 STYLE NAME: MATCH EF-1 COLOR: MATCH EF-1 SIZE: 4" LOCATION: WHERE NOTED	SS-1	SOLID SURFACE	MANUFACTURER: WILSONART COLOR: ANGEL FALLS THICKNESS: 1/2" LOCATION: WHERE NOTED
EF-1	EPOXY FLOORING	MANUFACTURER: STONHARD STYLE NAME: STONTEC EPF COLOR: TORIGNAL FLAKE: POLAR (B-330) SIZE: 1/8" FLAKE LOCATION: WHERE NOTED	WALL			SS-2	SOLID SURFACE	MANUFACTURER: WILSONART COLOR: DESIGNER WHITE THICKNESS: 1/2" LOCATION: WINDOW SILLS
RST-1	RUBBER STAIR TREAD & RISERS	MANUFACTURER: NORA STYLE NAME: NORAMENT ARGO TREAD 5172 COLOR: STAMINA LOCATION: STAIRWELLS	PNT-1	[GENERAL/MAIN PAINT]	MANUFACTURER: SHERWIN WILLIAMS COLOR: SW 7672 KNITTING NEEDLES LOCATION: WHERE NOTED	CG-1	CORNER GUARDS	MANUFACTURER: INPRO CORP STYLE NAME: 150BN BLUNOSE HIGH IMPACT CORNER GUARD COLOR: GRAYSTONE 0151 SIZE: 3" WINGS x 8" LOCATION: EXPOSED GYP CORNERS
RF-1	RUBBER FLOORING	MANUFACTURER: NORA STYLE NAME: NORAMENT ARAGO COLOR: STAMINA SIZE: 39.53" X 19.76" THICKNESS: 3.5 MM INSTALLATION: MONOLITHIC LOCATION: WHERE NOTED	PNT-2	[TRIM PAINT]	MANUFACTURER: SHERWIN WILLIAMS COLOR: SW 7018 DOVETAIL LOCATION: WHERE NOTED	WP-1	WALL PROTECTION	MANUFACTURER: INPRO CORP STYLE NAME: PALLADIUM RIGID WALL COLOR: GRAYSTONE 0151 THICKNESS: 0.040" LOCATION: WHERE NOTED NOTE: PROVIDE TOP TRIM CAP & DIVIDER BARS WHERE SEAMS OCCUR. <u>CML WALLS TO HAVE GAPS FILLED IN AND SMOOTHED.</u>
WOM-1	WALK-OFF MAT	MANUFACTURER: MANNINGTON STYLE NAME: FRITON COLOR: STATIC SIZE: 18" X 36" LOCATION: LOBBY	PNT-3	[MAIN CEILING/SOFFIT PAINT]	MANUFACTURER: SHERWIN WILLIAMS COLOR: SW 7005 PURE WHITE LOCATION: WHERE NOTED	RS-1	ROLLER SHADES	MANUFACTURER: DRAPER STYLE: ACCESS FLEX SHADES FABRIC: 3% OPEN LOCATION: RS-1 LOCATIONS AS NOTED ON RCF
SF-1	SHEET FLOORING	MANUFACTURER: MANNINGTON STYLE NAME: TESSELATE COLOR: LAKE SIZE: 12" LOCATION: WHERE NOTED	PNT-4	[ACCENT PAINT]	MANUFACTURER: SHERWIN WILLIAMS COLOR: SW 6869 STOP LOCATION: WHERE NOTED			
			PNT-5	[ACCENT PAINT]	MANUFACTURER: SHERWIN WILLIAMS COLOR: SW G235 FOGGY DAY LOCATION: WHERE NOTED			
			PNT-6	[ACCENT PAINT]	MANUFACTURER: SHERWIN WILLIAMS COLOR: SW 7019 GAUNTLET GRAY LOCATION: WHERE NOTED			
			HTW-1	HARD WALL TILE	MANUFACTURER: DAL TILE STYLE NAME: WANDERWISE COLOR: ROAM SIZE: 12" X 24" INSTALLATION: HORIZONTALLY STACKED GROUT: TBD LOCATION: WHERE NOTED			

CASEWORK SCHEDULE

NOTE: CABINET DESIGN SERIES (CDS) NUMBERS BASED ON AWI STANDARDS EDITION 2

CDS #	CASEWORK TYPE	DESCRIPTION
102	BASE CAB	DBL DOOR
153	BASE CAB	FALSE DRWR / REMOVABLE TOE FOR ADA
211	BASE CAB	SGL DOOR / SGL DRWR
222	BASE CAB	DBL DOORS / DBL DRWRS
230	BASE CAB	3 FILES
301	WALL CAB	SGL DOOR
302	WALL CAB	DBL DOORS
ADA	BASE CAB	ADA SINK
MCWV	TALL STG	MICROWAVE CABINET

TOILET ACCESSORIES SCHEDULE

TAG	DESCRIPTION	COMMENTS
TA01	TOILET TISSUE DISP - DBL STD. ROLL W/SHELF	CFCI
TA02	TOILET TISSUE DISP - SGL JUMBO ROLL	CFCI
TA04	PAPER TOWEL DISPENSER (FOLDED, HIGH-CAPACITY)	OFCI
TA18	STERIS SDS SOAP DISPENSER, SURFACE-MOUNT, MANUAL (LIQUID TYPE)	OFCI
TA23	18" VERTICAL GRAB BAR	CFCI
TA24	36" HORIZONTAL GRAB BAR	CFCI
TA25	42" HORIZONTAL GRAB BAR	CFCI
TA30	MIRROR, CHANNEL FRAMED WITHOUT SHELF (18 x 36 INCHES)	CFCI
TA31	MIRROR, CHANNEL FRAMED WITHOUT SHELF (24 x 36 INCHES)	CFCI
TA32	MIRROR, CHANNEL FRAMED (24 x 60 INCHES)	CFCI
TA33	ROBE HOOK (non-ADA)	CFCI
TA36	SANITARY NAPKIN DISPOSAL - SURF-MT. BOTTOM HINGED	CFCI
TA40	SHOWER ROD	CFCI
TA42	VINYL SHOWER CURTAIN	OFCI
TA85	DIAPER CHANGING STATION, SURFACE-MOUNT	CFCI
TA95	MOP & BROOM HOLDER WITH UTILITY SHELF	CFCI

SPECIALTY EQUIPMENT SCHEDULE

TAG	DESCRIPTION	COMMENTS
S1	4K SMART TV, SEE INTERIOR ELEVATION FOR ELEC. COORDINATION	OFCI
S2	RANGE	OFCI
S3	MICROWAVE	OFCI
S4	REFRIGERATOR	OFCI
S5	DISH WASHER	OFCI
S6	TACK BOARD	CFCI
S7	MARKER BOARD - 10'-0" X 4'-0"	CFCI
S8	CEILING MOUNTED PROJECTION SCREEN - ELECTRIC	CFCI
S10	2 TIER HEAVY DUTY LOCKER	OFCI
S11	PROJECTOR	OFCI
S12	ICE MACHINE	OFCI
S13	COFFEE MAKER	OFCI



Goodwyn Mills Cawood, LLC
117 Jefferson Street North
Huntsville, AL 35801
T 256.539.3431
GMCNETWORK.COM


ISSUE	DATE
100% CONSTRUCTION DOCUMENTS	1/9/2026
ADDENDUM 4	2/6/2026

ASHVILLE FIRE STATION #2
222 7TH Avenue North
Ashville, AL 35953



01/09/2026
A8.01

- MECHANICAL KEYED NOTES**
1. PROVIDE FLUSH WALL CAP WITH BACKDRAFT DAMPER AND INSECT SCREEN. BASIS OF DESIGN SHALL BE BY FAMCO, MODEL: FWVE, OR APPROVED EQUAL.
 2. PROVIDE FIRE DAMPER WITH 1-1/2 HOUR RATING AT DUCT PENETRATION OF FIRE-RESISTANCE-RATED ASSEMBLY. FIRE DAMPER SHALL BE LISTED AND LABELED AS A DYNAMIC, CURTAIN TYPE FIRE DAMPER WITH BLADES OUT OF THE AIRSTREAM IN ACCORDANCE WITH UL 555.
 3. THE APPARATUS BAY SHALL BE PROVIDED WITH A SOURCE CAPTURE SYSTEM THAT CONNECTS DIRECTLY TO MOTOR VEHICLE EXHAUST SYSTEMS. THE SYSTEM SHALL BE ENGINEERED BY A REGISTERED DESIGN PROFESSIONAL OR SHALL BE FACTORY-BUILT EQUIPMENT DESIGNED AND SIZED FOR THE PURPOSE. THE VEHICLE EXHAUST SYSTEM SHOWN IS ILLUSTRATIVE AND PLACED ARBITRARILY FOR GENERAL INFORMATION PURPOSES ONLY—THE ACTUAL SYSTEM COMPONENTS, SIZES, AND LOCATIONS MAY VARY.
 4. PROVIDE DUCT PENETRATIONS OF SAFE ROOM WITH SHROUD. BASIS OF DESIGN SHALL BE ROOF PENETRATION HOUSINGS—MODEL CYCLONE WALL SHROUD, OR APPROVED EQUAL.

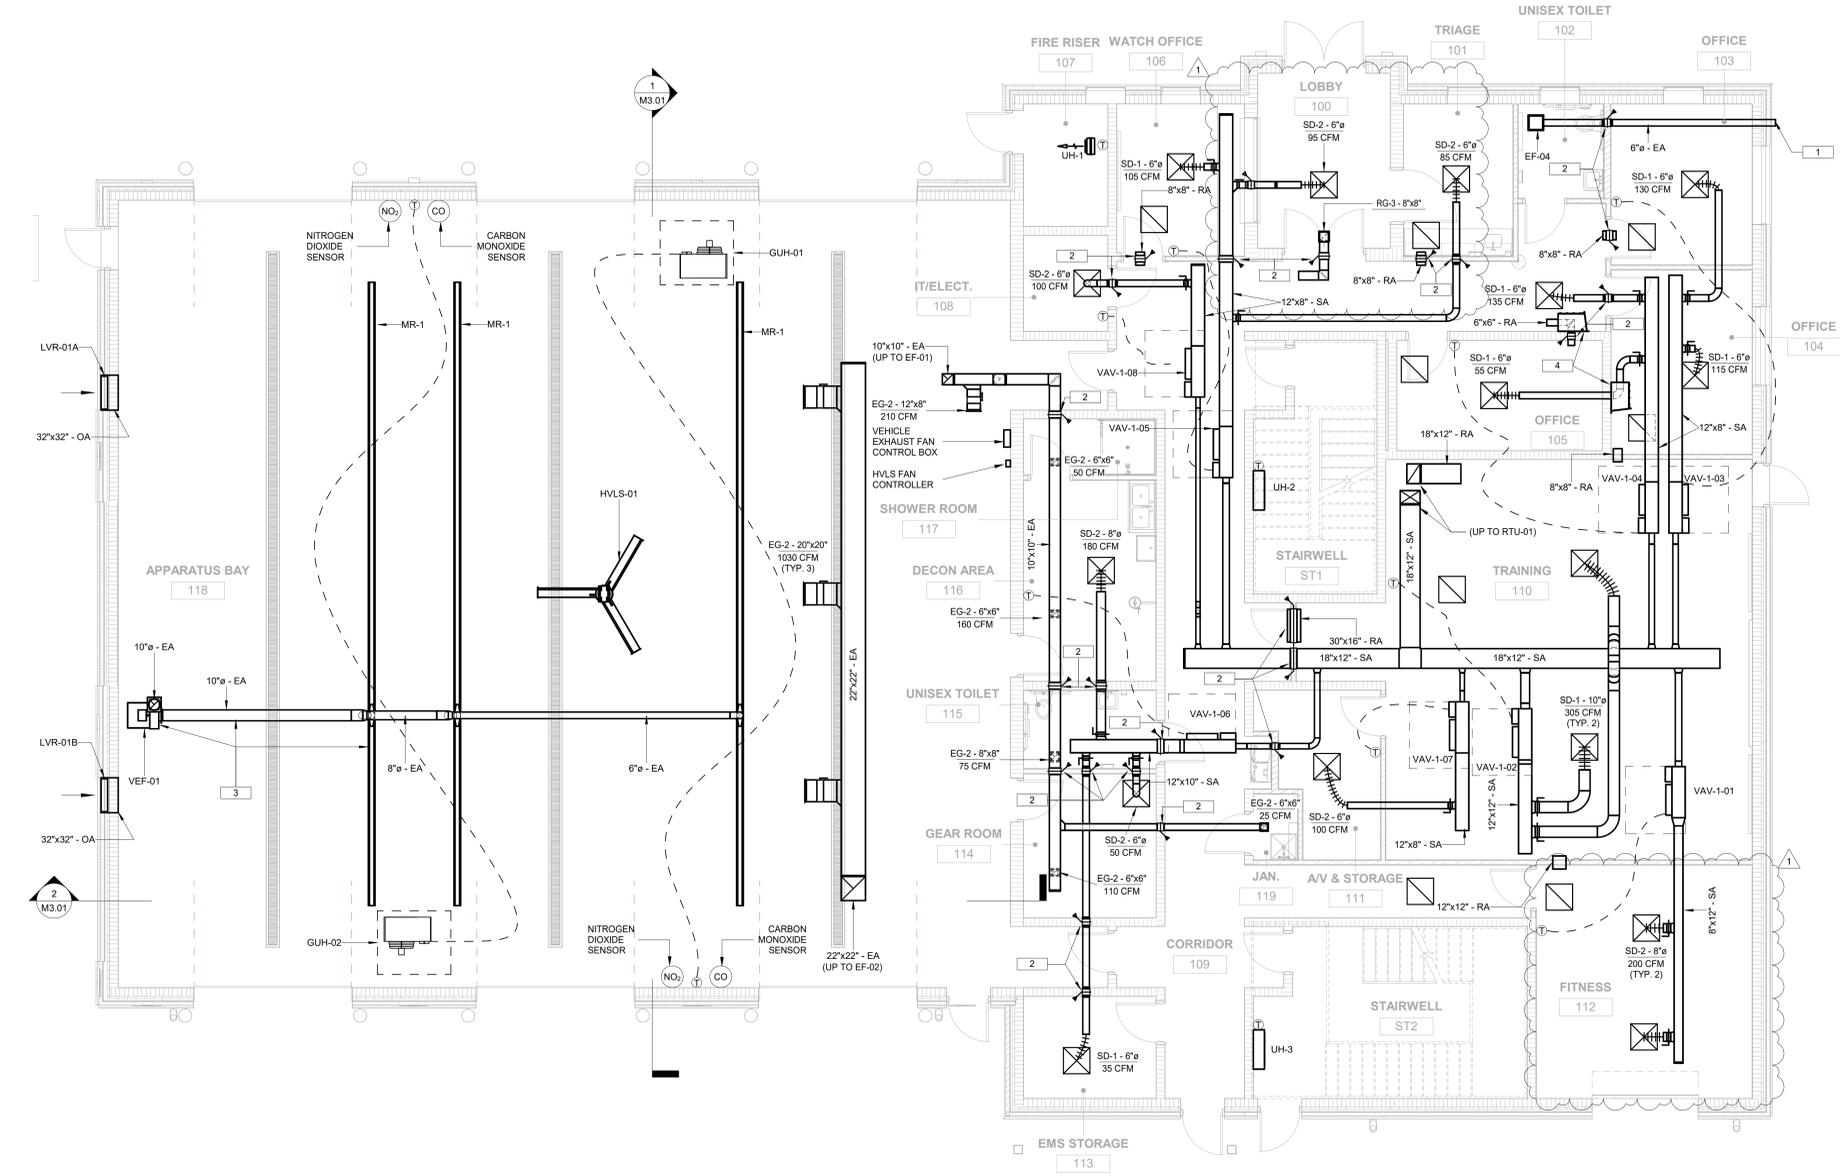


① LEVEL 1 - MECHANICAL PLAN
 3/16" = 1'-0"

ISSUE DATE	CONSTRUCTION DOCUMENTS	ISSUE DATE
	01/09/2026	
	ADDENDUM 4 02/06/2026	

ASHVILLE FIRE STATION #2
 222 7TH Avenue North
 Ashville, AL 35953

GNIC # AHUN250003

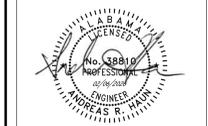


LEVEL 1 MECHANICAL FLOOR PLAN


M1.02



- MECHANICAL KEYED NOTES**
1. PROVIDE MANUAL PUSH-BUTTON ACTUATOR FOR TYPE I HOOD FIRE EXTINGUISHING SYSTEM. PUSH-BUTTON SHALL COME WITH PROTECTIVE GUARD TO PREVENT ACCIDENTAL ACTUATION OF THE TYPE I HOOD FIRE EXTINGUISHING SYSTEM.
 2. PROVIDE DRYERBOX EXHAUST RECEPTACLE. ROUTE DRYER EXHAUST UP AND TERMINATE WITH INSULATED GOOSENECK VENT ABOVE THE ROOF SURFACE.
 3. PROVIDE FIRE DAMPER WITH 1-1/2 HOUR RATING AT DUCT PENETRATION OF FIRE-RESISTANCE-RATED ASSEMBLY. FIRE DAMPER SHALL BE LISTED AND LABELED AS A DYNAMIC, CURTAIN TYPE FIRE DAMPER WITH BLADES OUT OF THE AIRSTREAM IN ACCORDANCE WITH UL 555.
 4. CENTER DIFFUSERS BETWEEN LIGHTING FIXTURES IN KITCHEN. ALIGN EDGE OF DIFFUSER WITH EDGE OF LIGHTING FIXTURE.

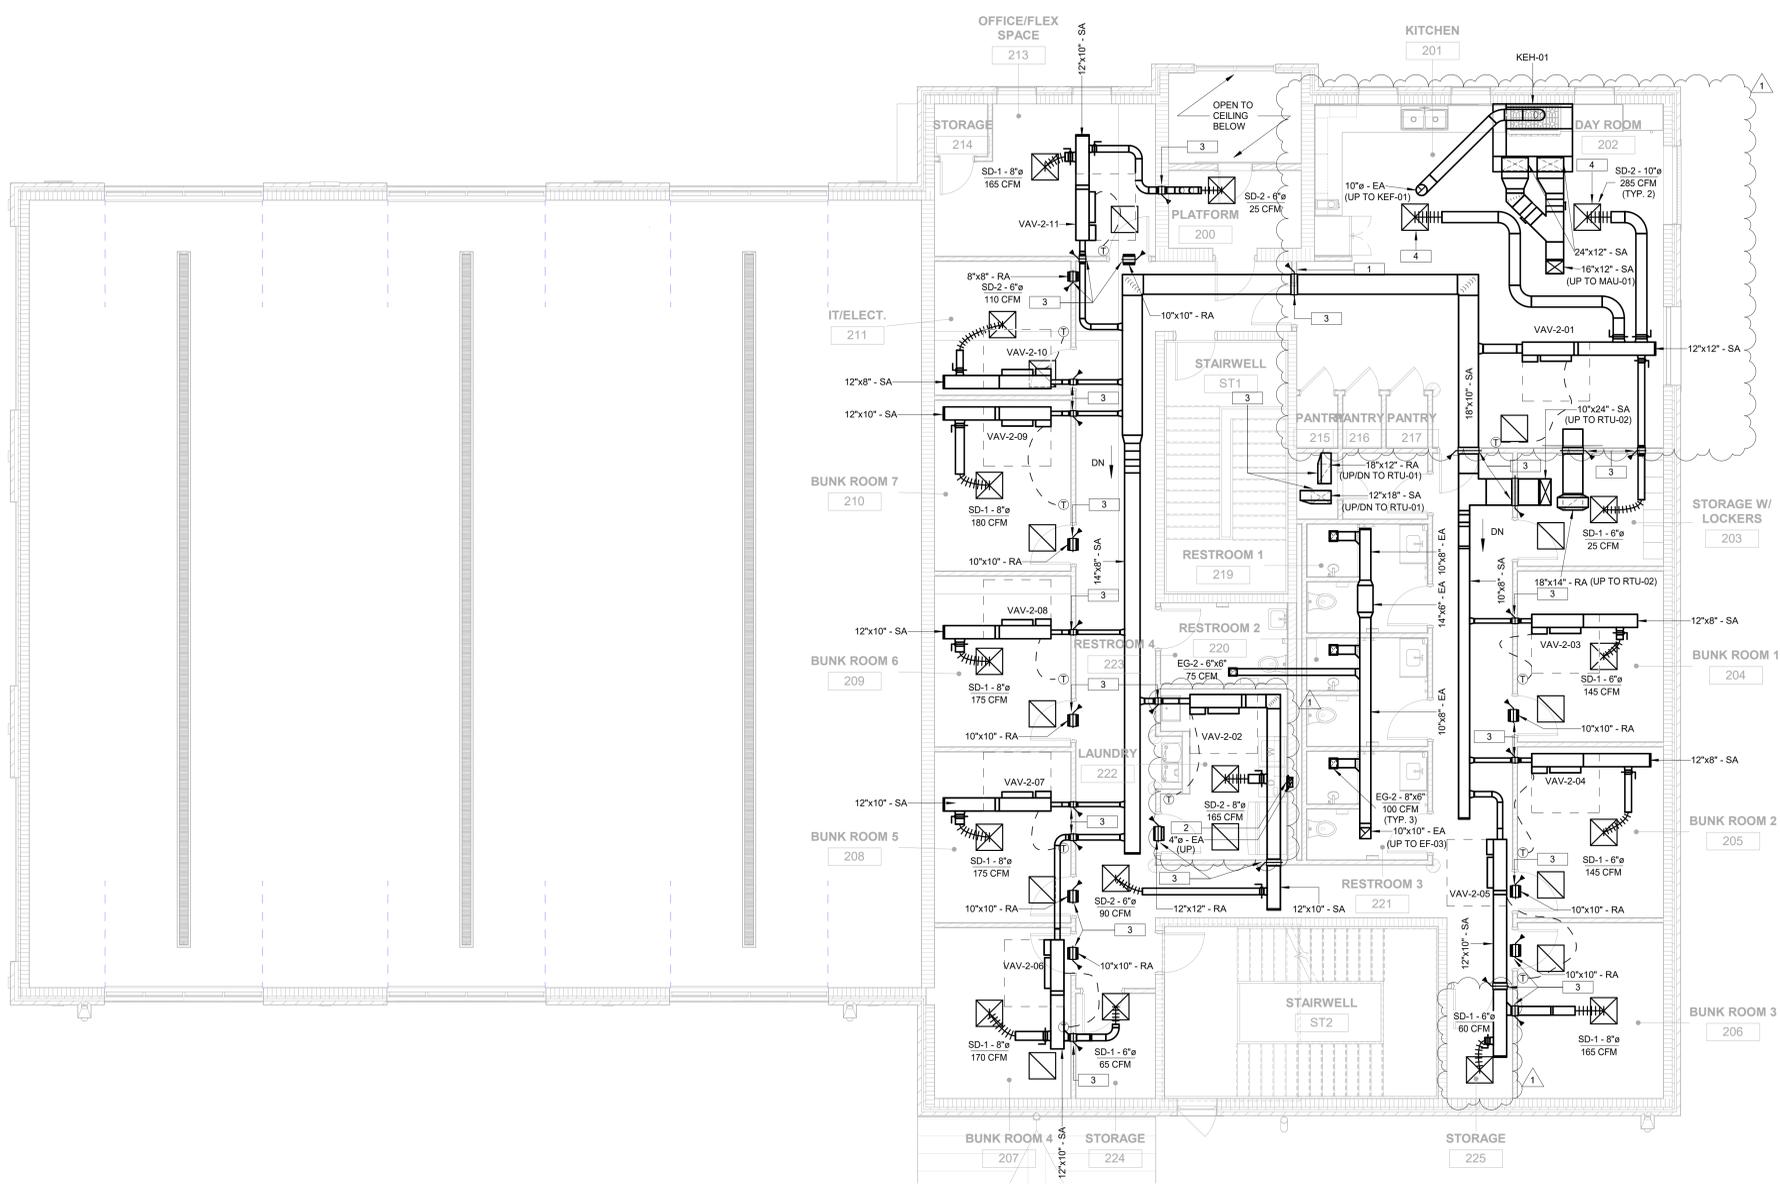

1 LEVEL 2 - MECHANICAL PLAN
 3/16" = 1'-0"

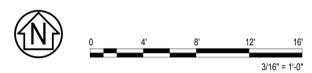

ISSUE DATE	CONSTRUCTION DOCUMENTS
01/09/2026	1
ADDENDUM 4 02/06/2026	

ASHVILLE FIRE STATION #2
 222 7TH Avenue North
 Ashville, AL 35953



LEVEL 2 MECHANICAL FLOOR PLAN

M1.04

Goodwyn Mills Cawood, LLC
 117 Jefferson Street North
 Huntsville, AL 35801
 T 256.539.3431
 GMCNETWORK.COM


DRAWN BY: RU
 CHECKED BY: ARH

GMC # AHUN250003




MECHANICAL KEYED NOTES

1. UNIT HEATER MOUNTING HEIGHT SHALL BE PER THE MANUFACTURER'S INSTALLATION INSTRUCTIONS. UNIT HEATERS IN THE APPARATUS BAY SHALL BE LOCATED BETWEEN THE OVERHEAD DOORS AND SHALL NOT OBSTRUCT APPARATUS OR MOTOR VEHICLE OPERATION.

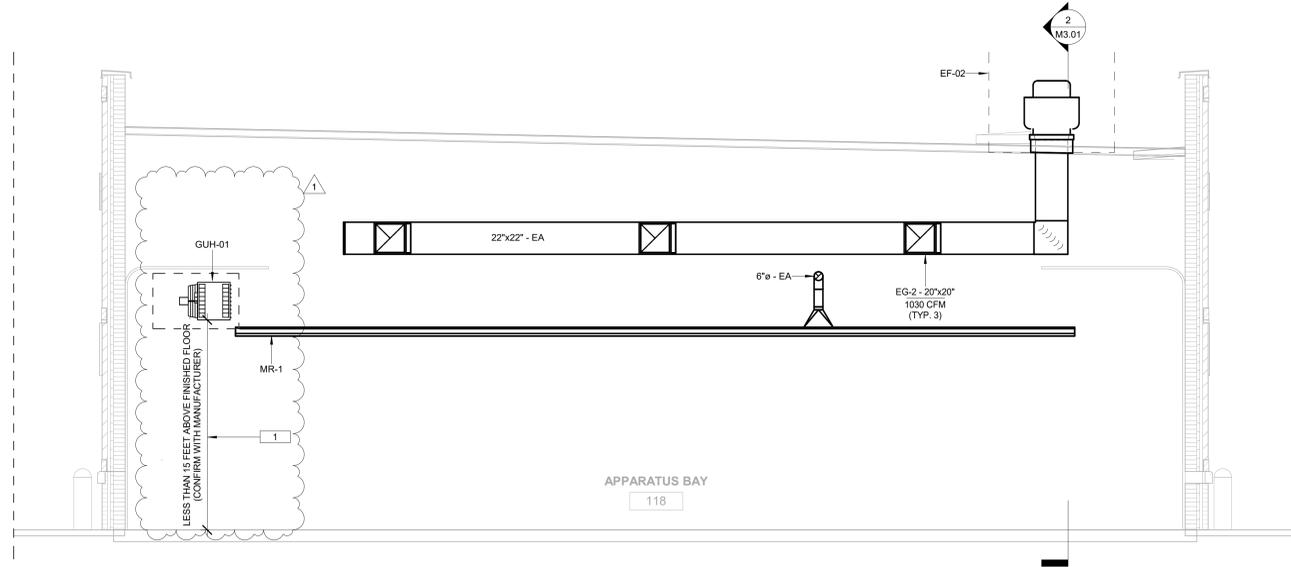

1 APPARATUS BAY SECTION VIEW 1
 1/4" = 1'-0"

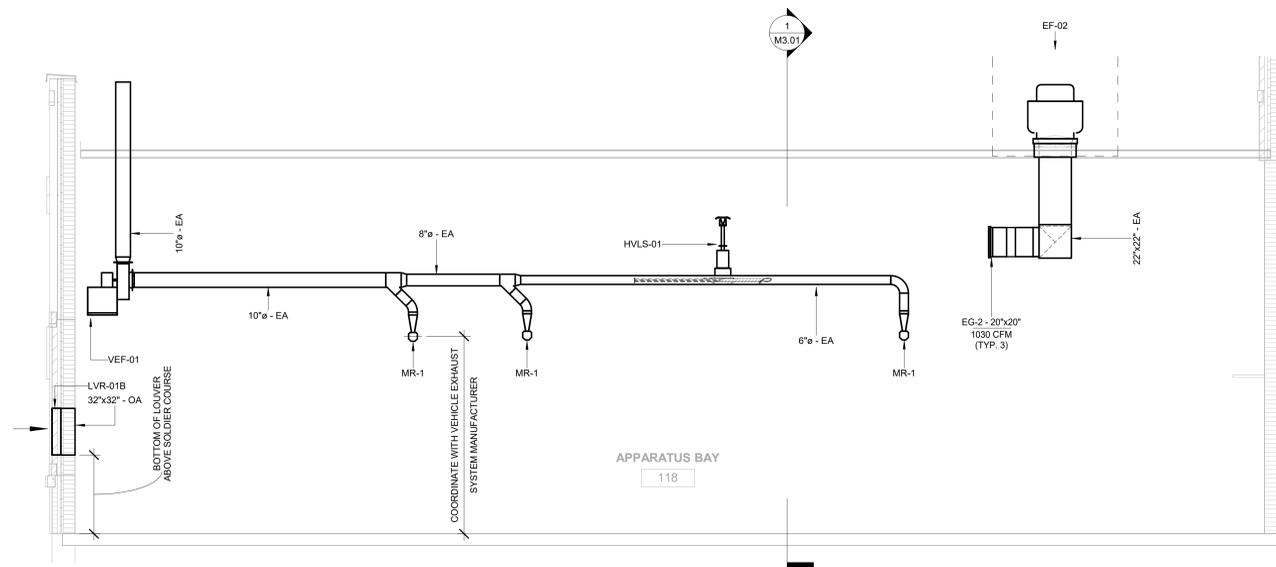

2 APPARATUS BAY SECTION VIEW 2
 1/4" = 1'-0"



ISSUE DATE	CONSTRUCTION DOCUMENTS	ISSUE DATE
	01/09/2026	
	ADDENDUM 4 02/06/2026	
	1	

ASHVILLE FIRE STATION #2
 222 7TH Avenue North
 Ashville, AL 35953



MECHANICAL SECTIONS

M3.01

GMC # AHUN250003

Goodwyn Mills Carwood, LLC
 117 Jefferson Street North
 Huntsville, AL 35801
 T 256.539.3431
 GMCNETWORK.COM



DRAWN BY: Author
 CHECKED BY: Checker

PACKAGED ROOFTOP UNIT (RTU) SCHEDULE

MARK	UNIT NOMINAL SIZE (TONS)	SUPPLY FAN				FAN MOTOR				FILTER MERV	REFRIGERANT TYPE	TOTAL CAPACITY (MBH)	SENSIBLE CAPACITY (MBH)	DX COOLING COIL				NATURAL GAS PREHEAT				ELECTRICAL				BASIS OF DESIGN				NOTES	
		SUPPLY AIR CFM	OUTSIDE AIR CFM	ESP (IN. W.G.)	BHP	DRIVE TYPE	HP	DBT (°F)	WBT (°F)					DBT (°F)	WBT (°F)	EER	IEER	CFM	INPUT (MBH)	OUTPUT (MBH)	GAS PRESSURE (IN. W.C.)	EAT (°F)	LAT (°F)	NO. STAGES	MCA	MOCP	VOLT / PH	L x W x H (IN x IN x IN)	UNIT WEIGHT (LB)		MANUFACTURER
RTU-01	6	1,860	500	2.0	1.49	DIRECT	3.0	8	R-32	69.4	52.9	80.9	66.4	53.5	11.2	21.1	1,200	80	64.8	5-14	46	55	MODULATING	38.8	50	208 / 3	84.5 X 53.3 X 69.5	1,028	DAIKIN APPLIED	DPS06	1 THROUGH 14
RTU-02	6	2,230	450	2.0	1.88	DIRECT	3.0	8	R-32	71.0	59.6	79.0	64.6	53.4	11.2	21.1	1,200	80	64.8	5-14	46	55	MODULATING	38.8	50	208 / 3	84.5 X 53.3 X 69.5	1,028	DAIKIN APPLIED	DPS06	1 THROUGH 14

- NOTES:**
- DIVISION 23 CONTRACTOR SHALL SUPPLY ELECTRICAL DISCONNECTS, PROVIDED BY MANUFACTURER OR OTHERS. DISCONNECTS THAT ARE SHIPPED LOOSE SHALL BE INSTALLED BY DIVISION 26 CONTRACTOR.
 - PROVIDE WITH THROUGH-THE-BASE ELECTRICAL CONNECTIONS.
 - PROVIDE WITH UNIT POWERED 115V GFCI OUTLET.
 - PROVIDE WITH CONFIGURABLE CONTROLS BY THE RTU MANUFACTURER. MULTI-ZONE VARIABLE-AIR-VOLUME (MZVAV) CONTROL ALGORITHMS AND ALL SEQUENCES NECESSARY TO OPERATE THE UNIT BASED ON THE CONTROL DIAGRAMS IN THE CONSTRUCTION DOCUMENTS SHALL BE PROVIDED. CONTROLS SHALL BE CAPABLE OF SUPPORTING DIGITAL COMMUNICATION USING THE BACnet PROTOCOL. CONTROLS SHALL BE INTEGRATED WITH ASSOCIATED VAV BOX CONTROLS.
 - PROVIDE WITH DOUBLE-WALL FOAM INSULATED CABINET OR DOUBLE-WALL FIBERGLASS INSULATED CABINET. CABINET SHALL BE MINIMUM R-7.
 - PROVIDE WITH HINGED ACCESS PANELS.
 - PROVIDE WITH OUTDOOR AIR HOOD.
 - PROVIDE MIXING BOX WITH MODULATING OUTDOOR AIR DAMPER AND MODULATING RETURN AIR DAMPER.
 - PROVIDE WITH VARIABLE SPEED REFRIGERANT COMPRESSOR OR SOME MEANS TO MODULATE CAPACITY ON PART-LOAD DAY.
 - PROVIDE STAINLESS STEEL CONDENSATE DRAIN PAN WITH CONDENSATE OVERFLOW SWITCH.
 - PROVIDE WITH SUPPLY FAN WITH EITHER ELECTRONICALLY COMMUTATED MOTOR OR MOTOR WITH VARIABLE SPEED DRIVE.
 - PROVIDE WITH BOTTOM SUPPLY AND RETURN DUCT CONNECTIONS.
 - PROVIDE DUCT SMOKE DETECTOR IN THE SUPPLY AND RETURN AIR STREAMS.
 - PROVIDE WITH 18" TALL ROOF CURB TO ACCOMMODATE SLOPED ROOF. REFER TO ARCHITECTURE ROOF PLAN FOR ROOF SLOPE. ROOF CURB SHALL COME WITH VIBRATION ISOLATION AND ACOUSTIC REDUCTION PER THE SPECIFICATIONS.

GENERAL EXHAUST FAN (EF) SCHEDULE

MARK	FAN TYPE	EXHAUST FAN				FAN MOTOR				VOLT / PH	UNIT WEIGHT (LB)	BASIS OF DESIGN		NOTES
		AIRFLOW (CFM)	ESP (IN. W.G.)	BHP	DRIVE	HP	DRIVE	HP	MANUFACTURER			MODEL		
EF-01	CENTRIFUGAL DOWNBLAST	630	0.5	0.09	DIRECT	1/4	115 / 1	192	GREENHECK	G-100-VG	1	THROUGH 4		
EF-02	CENTRIFUGAL UPBLAST	3,100	0.7	0.72	DIRECT	2	208 / 3	192	GREENHECK	CUE-180-VG	1	THROUGH 4		
EF-03	CENTRIFUGAL DOWNBLAST	375	0.56	0.07	DIRECT	1/15	115 / 1	192	GREENHECK	G-990-VG	1	THROUGH 4		
EF-04	CENTRIFUGAL CEILING	75	0.25	0.01	DIRECT	1/50	115 / 1	192	GREENHECK	SF-A50	1	THROUGH 4		

- NOTES:**
- DIVISION 23 CONTRACTOR SHALL SUPPLY ELECTRICAL DISCONNECTS, PROVIDED BY MANUFACTURER OR OTHERS. DISCONNECTS THAT ARE SHIPPED LOOSE SHALL BE INSTALLED BY DIVISION 26 CONTRACTOR.
 - PROVIDE WITH HAND / OFF / AUTO (HOA) CONTROLLER.
 - PROVIDE WITH GRAVITY BACKDRAFT DAMPER.
 - PROVIDE WITH 12" TALL ROOF CURB TO ACCOMMODATE SLOPED ROOF. REFER TO ARCHITECTURE ROOF PLAN FOR ROOF SLOPE.

LOUVER (LVR) SCHEDULE

MARK	APPLICATION	CFM	FREE AREA VELOCITY (FPM)	FREE AREA (SQFT)	PRESSURE DROP (IN. W.C.)	VOLT / PH	W X H X D (IN x IN x IN)	UNIT WEIGHT (LB)	MANUFACTURER	MODEL	NOTES
LVR-01A	INTAKE	1,550	510	3.04	0.036	115 / 1	32 X 32 X 6	65	GREENHECK	ECD-801	1 THROUGH 4
LVR-01B	INTAKE	1,550	510	3.04	0.036	115 / 1	32 X 32 X 6	65	GREENHECK	ECD-801	1 THROUGH 4

- NOTES:**
- PROVIDE WITH BIRDSCREEN.
 - PROVIDE WITH FLANGE FRAME.
 - PROVIDE WITH MOUNTING CLIPS.
 - PROVIDE WITH BAKED ENAMEL FINISH AND COLOR APPROVED BY ARCHITECT.

VAV TERMINAL UNIT SCHEDULE

MARK	INLET Ø (IN)	MAX COOLING CFM	MAX HEATING CFM	ELECTRIC HEAT				BASIS OF DESIGN				NOTES
				EAT (°F)	LAT (°F)	KW	NO. STAGES	VOLT / PH	MANUFACTURER	MODEL		
VAV-1-01	6	305	225	50	90	3	MODULATING	208 / 3	DAIKIN APPLIED	MOTH506	1	THROUGH 7
VAV-1-02	8	610	450	50	90	4	MODULATING	208 / 3	DAIKIN APPLIED	MOTH508	1	THROUGH 7
VAV-1-03	5	245	175	50	90	3	MODULATING	208 / 3	DAIKIN APPLIED	MOTH505	1	THROUGH 7
VAV-1-04	5	190	135	50	90	2	MODULATING	208 / 3	DAIKIN APPLIED	MOTH505	1	THROUGH 7
VAV-1-05	6	285	205	50	90	3.5	MODULATING	208 / 3	DAIKIN APPLIED	MOTH506	1	THROUGH 7
VAV-1-06	5	265	190	50	90	2	MODULATING	208 / 3	DAIKIN APPLIED	MOTH505	1	THROUGH 7
VAV-1-07	4	100	75	50	90	1	MODULATING	208 / 3	DAIKIN APPLIED	MOTH504	1	THROUGH 7
VAV-1-08	4	100	75	50	90	1	MODULATING	208 / 3	DAIKIN APPLIED	MOTH504	1	THROUGH 7
VAV-2-01	8	595	435	50	90	5.5	MODULATING	208 / 3	DAIKIN APPLIED	MOTH508	1	THROUGH 7
VAV-2-02	5	265	190	50	90	3.5	MODULATING	208 / 3	DAIKIN APPLIED	MOTH505	1	THROUGH 7
VAV-2-03	4	145	105	50	90	1	MODULATING	208 / 3	DAIKIN APPLIED	MOTH504	1	THROUGH 7
VAV-2-04	4	145	105	50	90	1	MODULATING	208 / 3	DAIKIN APPLIED	MOTH504	1	THROUGH 7
VAV-2-05	5	225	165	50	90	1.5	MODULATING	208 / 3	DAIKIN APPLIED	MOTH505	1	THROUGH 7
VAV-2-06	5	235	175	50	90	1.5	MODULATING	208 / 3	DAIKIN APPLIED	MOTH505	1	THROUGH 7
VAV-2-07	4	175	125	50	90	1.5	MODULATING	208 / 3	DAIKIN APPLIED	MOTH504	1	THROUGH 7
VAV-2-08	4	175	125	50	90	1.5	MODULATING	208 / 3	DAIKIN APPLIED	MOTH504	1	THROUGH 7
VAV-2-09	4	180	135	50	90	1.5	MODULATING	208 / 3	DAIKIN APPLIED	MOTH504	1	THROUGH 7
VAV-2-10	4	110	85	50	90	1	MODULATING	208 / 3	DAIKIN APPLIED	MOTH504	1	THROUGH 7
VAV-2-11	5	190	140	50	90	2.5	MODULATING	208 / 3	DAIKIN APPLIED	MOTH505	1	THROUGH 7

- NOTES:**
- DIVISION 23 CONTRACTOR SHALL SUPPLY ELECTRICAL DISCONNECTS, PROVIDED BY MANUFACTURER OR OTHERS. DISCONNECTS THAT ARE SHIPPED LOOSE SHALL BE INSTALLED BY DIVISION 26 CONTRACTOR. UNIT SHALL HAVE A SINGLE POINT POWER CONNECTION.
 - PROVIDE WITH POWER FUSE.
 - PROVIDE WITH FACTORY MOUNTED DDC CONTROLS AND CONTROLS ENCLOSURE.
 - PROVIDE WITH REMOVABLE AIRFLOW SENSOR.
 - PROVIDE WITH 1" THICK FOIL FACED FIBERGLASS LINER.
 - PROVIDE WITH HANGER BRACKETS.
 - COORDINATE LEFT/RIGHT HAND UNIT SELECTION WITH ACTUAL FIELD INSTALLED LOCATION.

TYPE I KITCHEN EXHAUST HOOD SCHEDULE

MARK	TYPE	EXHAUST HOOD			AIR CURTAIN SUPPLY PLENUM		UTILITY CABINET		WEIGHT (LB)	MANUFACTURER	MODEL	NOTES
		EXHAUST AIR CFM	CFM/FET	ESP (IN. W.G.)	L x W x H (IN x IN x IN)	CFM	ESP (IN. W.G.)	L x W x H (IN x IN x IN)				
KEH-01	WALL CANOPY	985	197	0.58	60 x 48 x 24	790	0.01	72 x 14 x 4	400	GREENHECK	GXEW	1,2

- NOTES:**
- PROVIDE WITH A PRE-ENGINEERED AUTOMATIC WET CHEMICAL FIRE-EXTINGUISHING SYSTEM BY THE KITCHEN EXHAUST EQUIPMENT MANUFACTURER. THE FIRE-EXTINGUISHING SYSTEM SHALL COMPLY WITH NFPA 96 AND UL 300 OR OTHER EQUIVALENT STANDARDS AND SHALL BE INSTALLED IN ACCORDANCE WITH THE REQUIREMENTS OF THE LISTING, THE MANUFACTURER'S INSTRUCTIONS, AND NFPA 17A.
 - PROVIDE WITH FACTORY CONTROLS BY THE KITCHEN EXHAUST EQUIPMENT MANUFACTURER.

MAKEUP AIR UNIT (MAU) SCHEDULE

MARK	CFM	RPM	ESP (IN. W.C.)	BHP	DRIVE	HP	FILTER TYPE	TOTAL CAPACITY (MBH)	SENSIBLE CAPACITY (MBH)	DX COOLING COIL				MODULATING HOT GAS REHEAT				MODULATING NATURAL GAS HEAT				ELECTRICAL				NOTES
										DBT (°F)	WBT (°F)	DBT (°F)	WBT (°F)	EAT (°F)	LAT (°F)	NO. STAGES	MCA	MOCP	VOLT / PH	WEIGHT (LB)	MODEL					
MAU-01	790	1,106	0.50	0.15	DIRECT	1/2	MERV 8	70.5	26.2	83.1	78.2	51.8	51.3	24.2	75	75	60.8	18.8	70	27.9	45	208 / 3	1,364	RV-20-5-J-E2	1 THROUGH 13	

- NOTES:**
- DIVISION 23 CONTRACTOR SHALL SUPPLY ELECTRICAL DISCONNECTS, PROVIDED BY MANUFACTURER OR OTHERS. DISCONNECTS THAT ARE SHIPPED LOOSE SHALL BE INSTALLED BY DIVISION 26 CONTRACTOR.
 - PROVIDE WITH THROUGH-THE-BASE ELECTRICAL CONNECTIONS.
 - PROVIDE WITH UNIT POWERED 115V GFCI OUTLET.
 - PROVIDE WITH CONFIGURABLE CONTROLS BY THE RTU MANUFACTURER. CONTROLS SHALL BE CAPABLE OF SUPPORTING DIGITAL COMMUNICATION USING THE BACnet PROTOCOL.
 - PROVIDE WITH DOUBLE-WALL FOAM INSULATED CABINET OR DOUBLE-WALL FIBERGLASS INSULATED CABINET. CABINET SHALL BE MINIMUM R-7.
 - PROVIDE WITH HINGED ACCESS PANELS.
 - PROVIDE WITH OUTDOOR AIR HOOD.
 - PROVIDE WITH TWO-POSITION OUTDOOR AIR DAMPER.
 - PROVIDE WITH VARIABLE SPEED REFRIGERANT COMPRESSOR OR SOME MEANS TO MODULATE CAPACITY ON PART-LOAD DAY.
 - PROVIDE STAINLESS STEEL CONDENSATE DRAIN PAN WITH CONDENSATE OVERFLOW SWITCH.
 - PROVIDE WITH SUPPLY FAN WITH EITHER ELECTRONICALLY COMMUTATED MOTOR OR MOTOR WITH VARIABLE SPEED DRIVE.
 - PROVIDE WITH BOTTOM SUPPLY DUCT CONNECTION.
 - PROVIDE WITH 18" TALL ROOF CURB TO ACCOMMODATE SLOPED ROOF. REFER TO ARCHITECTURE ROOF PLAN FOR ROOF SLOPE. ROOF CURB SHALL COME WITH VIBRATION ISOLATION AND ACOUSTIC REDUCTION PER THE SPECIFICATIONS.

HIGH VOLUME, LOW SPEED (HVLS) FAN SCHEDULE

MARK	AREA SERVED	AIRFLOW (CFM)	RPM	MAX. RPM	AVG. AIR SPEED (FPM)	OPERATIVE TEMPERATURE (°F)	RELATIVE HUMIDITY (%)	METABOLIC RATE	CLOTHING LEVEL	PERCEIVED COOLING EFFECT (°F)	MOTOR WATTAGE (W)	VOLT / PH	IMPELLER DIAMETER (IN)	UNIT WEIGHT (LB)	BASIS OF DESIGN		NOTES
															MANUFACTURER	MODEL	
HVLS-01	APPARATUS BAY	25,744	88	141	130	77	60	1.7 WALKING	0.57 PANTS, SHORT SLEEVES	7	500	208 / 3	120	135	GREENHECK	DS-3-10-70LV	1 THROUGH 5

- NOTES:**
- DIVISION 23 CONTRACTOR SHALL SUPPLY ELECTRICAL DISCONNECTS, PROVIDED BY MANUFACTURER OR OTHERS. DISCONNECTS THAT ARE SHIPPED LOOSE SHALL BE INSTALLED BY DIVISION 26 CONTRACTOR.
 - PROVIDE FACTORY-MOUNTED WIRED, AND PROGRAMMED VFD. VFD SHALL BE CAPABLE OF OVER-SPEED AND IMPACT DETECTION ALONG WITH TEMPERATURE, VOLTAGE, AND CURRENT MONITORING.
 - PROVIDE WITH DIGITAL KEYPAD CONTROL INTERFACE.
 - PROVIDE WITH MOUNTING KIT APPROPRIATE FOR BUILDING CONSTRUCTION.
 - PROVIDE FINISH AS APPROVED BY ARCHITECT.

GAS UNIT HEATER (GUH) SCHEDULE

MARK	AREA(S) SERVED	TYPE	INPUT (MBH)	OUTPUT (MBH)	FAN HP	AMPS	VOLT / PH	L x W x H (IN x IN x IN)	MANUFACTURER	MODEL	NOTES
GUH-01	APPARATUS BAY	GAS-FIRED PROPELLER	200	164	1/3	7.15	115 / 1	42.5 X 22.1 X 25.8	MODINE	PTX-200	1,2
GUH-02	APPARATUS BAY	GAS-FIRED PROPELLER	200	164	1/3	7.15	115 / 1	42.5 X 22.1 X 25.8	MODINE	PTX-200	1,2

- NOTES:**
- DIVISION 23 CONTRACTOR SHALL SUPPLY ELECTRICAL DISCONNECTS, PROVIDED BY MANUFACTURER OR OTHERS. DISCONNECTS THAT ARE SHIPPED LOOSE SHALL BE INSTALLED BY DIVISION 26 CONTRACTOR.
 - PROVIDE WITH VERTICAL CONCENTRIC VENT KIT.

KITCHEN EXHAUST FAN (KEF) SCHEDULE

MARK	FAN TYPE	EXHAUST FAN				FAN MOTOR				VOLT / PH	UNIT WEIGHT (LB)	BASIS OF DESIGN		NOTES
		AIRFLOW (CFM)	ESP (IN. W.G.)	BHP	DRIVE	HP	DRIVE	HP	MANUFACTURER			MODEL		
KEF-01	CENTRIFUGAL UPBLAST	985	0.832	0.26	DIRECT	1/2	115 / 1	142	GREENHECK	CUE-140-VG	1	THROUGH 5		

- NOTES:**
- DIVISION 23 CONTRACTOR SHALL SUPPLY ELECTRICAL DISCONNECTS, PROVIDED BY MANUFACTURER OR OTHERS. DISCONNECTS THAT ARE SHIPPED LOOSE SHALL BE INSTALLED BY DIVISION 26 CONTRACTOR.
 - PROVIDE WITH ROOF CURB TO ACCOMMODATE SLOPED ROOF. REFER TO ARCHITECTURE ROOF PLAN FOR ROOF SLOPE. ROOF CURB HEIGHT SHALL BE TALL ENOUGH SO EXHAUST DISCHARGE OUTLET IS AT LEAST 40 INCHES ABOVE THE ROOF SURFACE.
 - PROVIDE FAN LISTED AND LABELED IN ACCORDANCE WITH UL 705-SUPPLEMENT SC-RESTAURANT EXHAUST.
 - PROVIDE WITH GREASE CLIP.
 - PROVIDE UPBLAST FAN WHEEL ACCESS PORT.

ELECTRIC UNIT HEATER (UH) SCHEDULE

MARK	AREA(S) SERVED	TYPE	INPUT (KW)	AMPS	VOLT / PH	L x W x H (IN x IN x IN)	MANUFACTURER	MODEL	NOTES
UH-1	FIRE RISER	ELECTRIC	3.3	9.17	208 / 3	14-15/32 X 6-1/2 X 17-3/4	MARKEL	6100 SERIES	1,2,3
UH-2	STAIRWELL 1	ELECTRIC	3.0	9.2	208 / 3	33 X 6-1/2 X 17-3/4	MARKEL	6300 SERIES	1,2
UH-3	STAIRWELL 2	ELECTRIC	3.0	9.2	208 / 3	33 X 6-1/2 X 17-3/4	MARKEL	6300 SERIES	1,2

- NOTES:**
- DIVISION 23 CONTRACTOR SHALL SUPPLY ELECTRICAL DISCONNECTS, PROVIDED BY MANUFACTURER OR OTHERS. DISCONNECTS THAT ARE SHIPPED LOOSE SHALL BE INSTALLED BY DIVISION 26 CONTRACTOR.
 - PROVIDE WITH WIRED THERMOSTAT.
 - PROVIDE WITH WALL/CEILING BRACKET.

GRILLES, REGISTERS & DIFFUSERS SCHEDULE

MARK	TYPE	MOUNTING	MATERIAL	FACE SIZE	BASIS OF DESIGN			NOTES
					MANUFACTURER	MODEL	PRICE	
EG-2	LOUVERED EXHAUST GRILLE	SURFACE	ALUMINUM	PER MFG.	PRICE INDUSTRIES	630	1,2,3	
RG-1	EGGCRATE RETURN GRILLE	LAY-IN	ALUMINUM	24" x 24"	PRICE INDUSTRIES	80	1,2	
RG-2	EGGCRATE RETURN GRILLE	SURFACE	ALUMINUM	PER MFG.	PRICE INDUSTRIES	80	1,2	
RG-3	LOUVERED RETURN GRILLE	SURFACE	ALUMINUM	PER MFG.	PRICE INDUSTRIES	630	1,2	
SD-1	SQUARE PLAQUE DIFFUSER	LAY-IN	ALUMINUM	24" x 24"	PRICE INDUSTRIES	ASPD	1,2,3,4	
SD-2	SQUARE PLAQUE DIFFUSER	SURFACE	ALUMINUM	24" x 24"	PRICE INDUSTRIES	ASPD	1,2,3,4	

- NOTES:**
- PROVIDE WITH POWDER COAT FINISH WITH STANDARD WHITE PAINT.
 - PROVIDE WITH NECK SIZE AS INDICATED ON PLANS. ALL LAY-IN RETURN GRILLES WITHOUT A DUCT CONNECTION SHALL COME WITH A RETURN AIR CANOPY (PRICE, MODEL: RA0) AND SHALL HAVE A NECK SIZE OF 22" X 22" UNLESS NOTED OTHERWISE.
 - PROVIDE WITH MANUAL BALANCING DAMPER. BALANCING DAMPER SHALL BE LOCATED AT BRANCH TAKE OFF. WHERE PROVIDING BALANCING DAMPER AT BRANCH TAKE OFF IS NOT FEASIBLE, BALANCING DAMPER SHALL BE FACTORY INSTALLED AND PROVIDED AT THE AIR TERMINAL.
 - PROVIDE BACK PAN WITH EXTERNAL R-6 INSULATION WITH A MOLDED HEAVY DUTY FOIL/SCHEM VAPOR BARRIER.

VEHICLE EXHAUST RAIL SCHEDULE

MARK	LENGTH (FT)	WEIGHT (LB)	MOUNTING HEIGHT (FT)	RAIL TO VEHICLE DISTANCE (IN)	RAIL TO DOOR DISTANCE (FT)	MANUFACTURER	MODEL
MR-1	47.5	235	10-14	12-24	5.5-8	PLYMOVENT	MRP-50

VEHICLE EXHAUST FAN (VEF) SCHEDULE

MARK	FAN TYPE	EXHAUST FAN				VOLT / PH	UNIT WEIGHT (LB)	BASIS OF DESIGN		NOTES
		AIRFLOW (CFM)	ESP (IN. W.G.)	DRIVE	HP			MANUFACTURER	MODEL	

SINGLE-DUCT VAV TERMINAL UNIT

SYSTEM DESCRIPTION:
THE SINGLE-DUCT VAV TERMINAL UNIT CONSISTS OF AN AIRFLOW SENSOR, MOTORIZED SUPPLY AIRFLOW CONTROL DAMPER, A MODULATING ELECTRIC REHEAT COIL, AND ALL ASSOCIATED APPURTENANCES AND DEVICES DEPICTED ON THE CONTROL SYSTEM DIAGRAM.

UNIT CONTROLLER AND ZONE SENSORS:
CONFIGURABLE UNIT CONTROLLER SHALL BE PROVIDED AND PROGRAMMED FOR EACH TERMINAL UNIT BY THE TERMINAL UNIT MANUFACTURER WITH THE SEQUENCE OF OPERATION AS INDICATED BELOW. THE UNIT CONTROLLER SHALL BE CAPABLE OF SUPPORTING DIGITAL COMMUNICATION USING THE BACNET PROTOCOL. THE HVAC CONTROLS CONTRACTOR SHALL INTEGRATE THE UNIT CONTROLLER WITH THE BUILDING AUTOMATION SYSTEM (BAS) AND SHALL PROVIDE THE NECESSARY CONTROL WIRING AND DEVICES (NETWORK CONTROLLERS, GATEWAYS, ETC.) FOR THE BAS TO MONITOR AND ADJUST SETPOINTS AND GENERATE ALARMS.

EACH VAV TERMINAL UNIT SHALL BE SUPPLIED WITH A WIRED, WALL-MOUNTED ZONE TEMPERATURE AND HUMIDITY SENSOR WITH OVERRIDE BUTTON TO TEMPORARILY OVERRIDE UNOCCUPIED MODE FOR UP TO 2 HOURS.

OCCUPIED MODE:
WHEN THE ASSOCIATED AHU IS PLACED IN OCCUPIED MODE, THE FOLLOWING ACTIONS SHALL OCCUR:

COOLING MODE:
WHEN THE ZONE TEMPERATURE IS ABOVE THE OCCUPIED ZONE DRY BULB TEMPERATURE COOLING SETPOINT OF 75°F (ADJUSTABLE), THE UNIT CONTROLLER SHALL OPEN THE SUPPLY AIRFLOW CONTROL DAMPER TO THE MAXIMUM AIRFLOW POSITION. AS THE ZONE DRY BULB TEMPERATURE FALLS TO THE COOLING SETPOINT, THE UNIT CONTROLLER SHALL MODULATE THE SUPPLY AIRFLOW CONTROL DAMPER BETWEEN MINIMUM AND MAXIMUM AIRFLOW POSITIONS TO MAINTAIN THE ZONE DRY BULB TEMPERATURE SETPOINT. THE UNIT SHALL MAINTAIN THE SUPPLY AIRFLOW CONTROL DAMPER AT THE MINIMUM AIRFLOW POSITION WHEN THE ZONE DRY BULB TEMPERATURE IS BETWEEN THE COOLING AND HEATING SETPOINTS.


DEHUMIDIFICATION MODE:
THE UNIT CONTROLLER SHALL MONITOR THE ZONE RELATIVE HUMIDITY LEVEL. WHEN THE UNIT IS IN COOLING MODE AND THE ZONE RELATIVE HUMIDITY IS 10% ABOVE THE ZONE RELATIVE HUMIDITY SETPOINT OF 50% (ADJUSTABLE), THE UNIT CONTROLLER SHALL ENABLE DEHUMIDIFICATION MODE. IN THIS MODE, THE UNIT SHALL INCREASE THE SUPPLY AIRFLOW INCREMENTALLY UP TO THE MAXIMUM AIRFLOW RATE, AND MODULATE THE REHEAT COIL TO MAINTAIN ZONE TEMPERATURE AT 0.3°F (ADJUSTABLE) BELOW THE OCCUPIED ZONE DRY BULB TEMPERATURE COOLING SETPOINT. WHEN THE ZONE RELATIVE HUMIDITY FALLS TO WITHIN 3% (ADJUSTABLE) OF THE ZONE RELATIVE HUMIDITY SETPOINT, THE UNIT CONTROLLER SHALL DE-ENERGIZE THE REHEAT COIL AND DISABLE DEHUMIDIFICATION MODE.

HEATING MODE:
WHEN THE ZONE TEMPERATURE FALLS BELOW THE OCCUPIED ZONE DRY BULB TEMPERATURE HEATING SETPOINT OF 70°F (ADJUSTABLE), THE UNIT CONTROLLER SHALL ENGAGE HEATING MODE. IN THIS MODE, THE UNIT CONTROLLER SHALL MODULATE THE REHEAT COIL TO MAINTAIN THE OCCUPIED ZONE DRY BULB TEMPERATURE HEATING SETPOINT. IF THE ZONE DRY BULB TEMPERATURE CONTINUES TO FALL, THE UNIT CONTROLLER SHALL MODULATE THE SUPPLY AIRFLOW CONTROL DAMPER OPEN, UP TO THE MAXIMUM HEATING AIRFLOW RATE, IN CONJUNCTION WITH MODULATING THE REHEAT COIL TO MAINTAIN THE OCCUPIED ZONE DRY BULB TEMPERATURE HEATING SETPOINT.

ZONE TEMPERATURE DEADBAND:
THE MINIMUM OCCUPIED ZONE TEMPERATURE DEADBAND SHALL NOT BE ALLOWED TO BE LESS THAN 5°F; IF THE OCCUPIED ZONE HEATING OR COOLING SETPOINT IS ADJUSTED, THE UNIT CONTROLLER SHALL AUTOMATICALLY ADJUST THE CONVERSE SETPOINT TO MAINTAIN A 5°F DEADBAND.

UNOCCUPIED MODE:
WHEN THE ASSOCIATED RTU IS PLACED IN UNOCCUPIED MODE, THE FOLLOWING ACTIONS SHALL OCCUR:

- THE UNIT CONTROLLER SHALL DE-ENERGIZE THE REHEAT COIL AND FULLY OPEN THE SUPPLY AIRFLOW CONTROL DAMPER.
- IF THE ZONE TEMPERATURE RISES ABOVE/DROPS BELOW MORE THAN 3°F THAN THE UNOCCUPIED ZONE DRY BULB TEMPERATURE SETPOINTS OF 85°F (COOLING) AND 55°F (HEATING) (BOTH SETPOINTS ADJUSTABLE), THE BAS SHALL START THE ASSOCIATED RTU AND THE BAS SHALL ENABLE THE COOLING MODE/HEATING MODE SEQUENCES UNTIL THE ZONE DRY BULB TEMPERATURE IS INSIDE THE UNOCCUPIED ZONE TEMPERATURE SETPOINTS BY AT LEAST 3°F.
- IF THE ZONE HUMIDITY LEVEL RISES MORE THAN 15% ABOVE THE ZONE HUMIDITY LEVEL SETPOINT OF 50% (ADJUSTABLE), AND THE ZONE TEMPERATURE IS ABOVE THE OCCUPIED COOLING SETPOINT OF 75°F (ADJUSTABLE), THE BAS SHALL START THE ASSOCIATED RTU AND THE BAS SHALL ENABLE THE COOLING MODE SEQUENCE UNTIL THE ZONE HUMIDITY LEVEL IS NO MORE THAN 10% ABOVE THE ZONE HUMIDITY LEVEL SETPOINT.

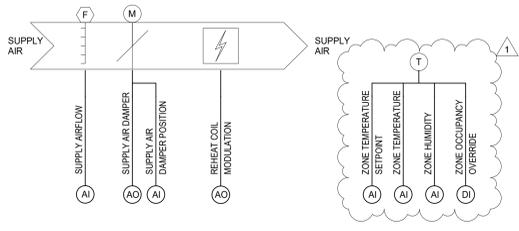

#	DESCRIPTION	INPUT		OUTPUT	
		ANALOG	DIGITAL	ANALOG	DIGITAL
1	SUPPLY AIRFLOW RATE	X			
2	SUPPLY AIR DAMPER CONTROL (0 TO 100%)			X	
3	SUPPLY AIR DAMPER POSITION	X			
4	REHEAT COIL MODULATION			X	
5	ZONE AIR DRY BULB TEMPERATURE	X			
6	ZONE AIR DRY BULB TEMPERATURE SETPOINT	X			
7	ZONE AIR RELATIVE HUMIDITY	X			
8	ZONE OCCUPANCY OVERRIDE		X		




Goodwyn Mills Caswood, LLC
117 Jefferson Street North
Huntsville, AL 35801
T 256.535.3431
GMCNETWORK.COM

EMERGENCY EXHAUST FAN CONTROL

SYSTEM DESCRIPTION:
THE APPARATUS BAY EMERGENCY EXHAUST FAN SYSTEM CONSISTS OF A DIRECT-DRIVE FAN, GRAVITY-OPERATED BACKDRAFT DAMPER, AND ALL ASSOCIATED APPURTENANCES AND DEVICES DEPICTED ON THE CONTROL SYSTEM DIAGRAM. IN ADDITION TO THE EXHAUST FAN, TWO (2) INTAKE COMBINATION LOUVER/DAMPERS SHALL BE INTERLOCKED WITH THE EXHAUST FAN OPERATION.

UNIT CONTROLLER:
THE EXHAUST FAN SHALL BE SUPPLIED WITH A FACTORY-MOUNTED DDC CONTROLLER WITH HAND / OFF / AUTO (HOA) CONTROL.

SYSTEM STARTUP/SHUTDOWN:
THE EXHAUST FAN SHALL BE STARTED/STOPPED BASED ON INPUTS FROM CARBON MONOXIDE AND NITROGEN DIOXIDE SENSORS LOCATED IN THE APPARATUS BAY. IF ANY CARBON MONOXIDE SENSOR DETECTS A CONCENTRATION OF 25 PPM OR GREATER OR IF ANY NITROGEN DIOXIDE SENSOR DETECTS A CONCENTRATION OF 0.5 PPM OR GREATER, LOUVER-01A'S DAMPER AND LOUVER-01B'S DAMPER SHALL OPEN. ONCE BOTH LOUVER DAMPERS ARE CONFIRMED OPEN, THE EXHAUST FAN SHALL BE STARTED AND SHALL RUN CONTINUOUSLY AT A CONSTANT SPEED, SET DURING TEST AND BALANCE. TO EXHAUST THE SCHEDULED AIRFLOW (CFM), THE EXHAUST FAN SHALL BE STOPPED WHEN THE APPARATUS BAY'S CARBON MONOXIDE CONCENTRATION DROPS BELOW 20 PPM AND THE NITROGEN DIOXIDE CONCENTRATION DROPS BELOW 0.4 PPM.

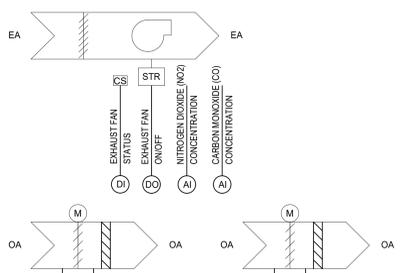

#	DESCRIPTION	INPUT		OUTPUT	
		ANALOG	DIGITAL	ANALOG	DIGITAL
1	EXHAUST FAN ON/OFF				X
2	EXHAUST FAN STATUS		X		
3	LOUVER-01A DAMPER OPEN/CLOSE			X	
4	LOUVER-01A DAMPER POSITION		X		
5	LOUVER-01B DAMPER OPEN/CLOSE			X	
6	LOUVER-01B DAMPER POSITION		X		
7	APPARATUS BAY CO PPM	X			
8	APPARATUS BAY NO ₂ PPM	X			

MULTI-ZONE VAV RTU

SYSTEM DESCRIPTION:
THE MULTI-ZONE ROOFTOP UNIT CONSISTS OF A RETURN AIR PATH WITH RETURN AIR DAMPER, OUTDOOR AIR PATH WITH OUTDOOR AIR DAMPER, PLEATED FILTERS, A DX COOLING COIL, A GAS HEAT EXCHANGER, DIRECT DRIVE SUPPLY AIR FAN(S) WITH VFD, AND ALL ASSOCIATED APPURTENANCES AND DEVICES DEPICTED ON THE CONTROL SYSTEM DIAGRAM.

UNIT CONTROLLER:
CONFIGURABLE UNIT CONTROLLER SHALL BE PROVIDED AND PROGRAMMED FOR EACH RTU BY THE RTU MANUFACTURER WITH THE SEQUENCE OF OPERATION AS INDICATED BELOW. THE UNIT CONTROLLER SHALL BE CAPABLE OF SUPPORTING DIGITAL COMMUNICATION USING THE BACNET PROTOCOL. THE HVAC CONTROLS CONTRACTOR SHALL INTEGRATE THE UNIT CONTROLLER WITH THE BUILDING AUTOMATION SYSTEM (BAS) AND SHALL PROVIDE THE NECESSARY CONTROL WIRING AND DEVICES (NETWORK CONTROLLERS, GATEWAYS, ETC.) FOR THE BAS TO MONITOR AND ADJUST SETPOINTS AND GENERATE ALARMS.

SYSTEM STARTUP/SHUTDOWN:
THE UNIT SHALL BE STARTED/STOPPED THROUGH THE BAS. THE BAS SHALL ALLOW THE OPERATOR TO SET AND ADJUST OCCUPIED/UNOCCUPIED MODES BASED ON A 24-HOUR/7-DAY SCHEDULE.

OCCUPIED MODE:
WHEN THE SYSTEM IS PLACED IN OCCUPIED MODE, THE FOLLOWING STANDARD SEQUENCES SHALL BE ENABLED:

OUTDOOR AIR / RETURN AIR DAMPER CONTROL FOR VENTILATION:
THE OUTDOOR AIR DAMPER AND RETURN AIR DAMPER SHALL MODULATE BASED ON THE SUPPLY AIR FAN SPEED TO MAINTAIN THE OUTDOOR AIRFLOW RATE (CFM) SETPOINT. THE MINIMUM OUTDOOR AIR DAMPER POSITION SHALL BE CONFIGURED DURING TEST AND BALANCE AT THE FOLLOWING SUPPLY AIR FAN SPEEDS: 30%, 50%, 60%, 100%.

SUPPLY AIR FAN CONTROL:
THE SUPPLY AIR FAN(S) SHALL RUN CONTINUOUSLY. THE UNIT SHALL USE ITS INTERNAL CONTROL ALGORITHMS TO VARY THE SPEED OF THE SUPPLY AIR FAN(S) (MULTI-ZONE VARIABLE AIR VOLUME CONTROL) TO MAINTAIN A DUCT STATIC PRESSURE SETPOINT OF 1.0 IN. W.G. (ADJUSTED DURING TEST AND BALANCE). THE DUCT STATIC PRESSURE TRANSMITTER SHALL BE INSTALLED IN THE DOWNSTREAM DUCTWORK, IN A LOCATION APPROXIMATELY 2/3 TO 3/4 TO THE FARTHEST VAV TERMINAL BOX. THE SUPPLY AIR FAN SPEED SHALL NOT BE ALLOWED TO DROP BELOW 90%.

SUPPLY AIR TEMPERATURE CONTROL (COOLING):
WHEN THE SUPPLY AIR TEMPERATURE IS ABOVE THE SUPPLY AIR DRY BULB TEMPERATURE MAXIMUM SETPOINT OF 55°F (ADJUSTABLE), THE UNIT CONTROLLER SHALL ENABLE COOLING MODE. IN THIS MODE, THE UNIT CONTROLLER SHALL MODULATE THE COOLING COIL TO MAINTAIN A MAXIMUM SUPPLY AIR DRY BULB TEMPERATURE OF 55°F (ADJUSTABLE).

SUPPLY AIR TEMPERATURE CONTROL (HEATING):
WHEN THE SUPPLY AIR TEMPERATURE IS BELOW THE SUPPLY AIR DRY BULB TEMPERATURE MINIMUM SETPOINT OF 50°F (ADJUSTABLE), THE UNIT CONTROLLER SHALL ENABLE HEATING MODE. IN THIS MODE, THE UNIT CONTROLLER SHALL MODULATE THE GAS HEAT EXCHANGER TO MAINTAIN THE SUPPLY AIR DRY BULB TEMPERATURE MINIMUM SETPOINT OF 50°F (ADJUSTABLE).

SUPPLY AIR TEMPERATURE DEADBAND:
WHEN THE SUPPLY AIR TEMPERATURE IS BETWEEN THE SUPPLY AIR DRY BULB TEMPERATURE MINIMUM AND MAXIMUM SETPOINTS (50°F - 55°F, ADJUSTABLE), THE UNIT CONTROLLER SHALL CLOSE THE GAS HEAT EXCHANGER VALVE AND DE-ENERGIZE THE COOLING COIL TO PREVENT SIMULTANEOUS HEATING AND COOLING. THE SUPPLY AIR TEMPERATURE DEADBAND SHALL NOT BE ALLOWED TO BE LESS THAN 5°F; IF THE SUPPLY AIR HEATING OR COOLING SETPOINT IS ADJUSTED, THE UNIT CONTROLLER SHALL AUTOMATICALLY ADJUST THE CONVERSE SETPOINT TO MAINTAIN A 5°F DEADBAND.

SUPPLY AIR TEMPERATURE RESET:
WHEN THE OUTDOOR AIR TEMPERATURE FALLS BELOW 70°F (ADJUSTABLE) IN COOLING MODE, THE UNIT CONTROLLER SHALL RESET THE SUPPLY AIR TEMPERATURE SETPOINT UPWARDS LINEARLY AS OUTDOOR AIR TEMPERATURE FALLS BETWEEN 70°F AND 60°F. TO A MAXIMUM SETPOINT OF 60°F (ADJUSTABLE). AS THE OUTDOOR AIR TEMPERATURE RISES ABOVE 70°F, OR IF THE ZONE RELATIVE HUMIDITY IN ANY ASSOCIATED ZONE IS MORE THAN 5% ABOVE THE ZONE RELATIVE HUMIDITY SETPOINT OF 50% (ADJUSTABLE), THE UNIT CONTROLLER SHALL RESET THE SUPPLY AIR TEMPERATURE SETPOINT DOWNWARDS TO THE MINIMUM SETPOINT OF 55°F (ADJUSTABLE).

STATIC PRESSURE RESET:
THE BAS SHALL MONITOR THE DAMPER POSITION OF ALL VAV TERMINAL BOXES ASSOCIATED WITH THE AHU. IF THE DAMPER POSITION OF ALL VAV TERMINAL BOXES IS BELOW 60% (ADJUSTABLE), THE BAS SHALL RESET THE STATIC PRESSURE SETPOINT DOWNWARDS, IN 0.1 IN. W.G. INCREMENTS, UNTIL THE MINIMUM VAV TERMINAL BOX DAMPER POSITION IS ABOVE 60% (ADJUSTABLE). IF THE MAXIMUM VAV TERMINAL BOX DAMPER POSITION RISES ABOVE 90%, THE BAS SHALL RESET THE STATIC PRESSURE UPWARDS SETPOINT UPWARDS, IN 0.2 IN. W.G. INCREMENTS, UNTIL THE MAXIMUM VAV TERMINAL BOX IS BELOW 95%, OR THE STATIC PRESSURE REACHES THE MAXIMUM STATIC PRESSURE SETPOINT OF 1.0 IN. W.G. (ADJUSTABLE).


UNOCCUPIED MODE:
WHEN THE UNIT IS PLACED IN UNOCCUPIED MODE, THE FOLLOWING ACTIONS SHALL OCCUR:

- THE UNIT CONTROLLER SHALL USE ITS INTERNAL SHUTDOWN CONTROL ALGORITHMS TO CLOSE THE GAS HEAT EXCHANGER VALVE, DE-ENERGIZE THE COOLING COIL, DE-ENERGIZE THE SUPPLY AIR FAN(S), CLOSE THE OUTDOOR AIR DAMPER, AND OPEN THE RETURN AIR DAMPER.
- THE ZONE TEMPERATURE IN ANY TWO (2) ASSOCIATED ZONES RISES ABOVE/DROPS BELOW THE UNOCCUPIED ZONE DRY BULB TEMPERATURE SETPOINTS OF 85°F (COOLING) AND 55°F (HEATING) (BOTH SETPOINTS ADJUSTABLE), OR IF THE ZONE TEMPERATURE IN ANY ONE (1) ZONE RISES ABOVE/DROPS BELOW MORE THAN 3°F THAN THE UNOCCUPIED DRY BULB TEMPERATURE SETPOINTS, THE BAS SHALL START THE UNIT AND THE UNIT SHALL ENABLE THE COOLING MODE/HEATING MODE SEQUENCES—WITH THE OUTDOOR AIR DAMPER CLOSED—UNTIL THE ZONE DRY BULB TEMPERATURE IN EACH ZONE IS INSIDE THE UNOCCUPIED ZONE TEMPERATURE SETPOINTS BY AT LEAST 3°F.
- IF THE ZONE HUMIDITY LEVEL IN ANY ONE (1) ASSOCIATED ZONE RISES MORE THAN 15% ABOVE THE ZONE HUMIDITY LEVEL SETPOINT OF 50% (ADJUSTABLE), AND THE ZONE TEMPERATURE IS ABOVE THE OCCUPIED COOLING SETPOINT OF 75°F (ADJUSTABLE), THE BAS SHALL START THE UNIT AND THE UNIT SHALL ENABLE THE COOLING MODE SEQUENCE—WITH THE OUTDOOR AIR DAMPER CLOSED—UNTIL THE ZONE HUMIDITY LEVEL IS NO MORE THAN 10% ABOVE THE ZONE HUMIDITY LEVEL SETPOINT.

SMOKE DETECTION SHUTDOWN:
UPON ACTIVATION OF THE ASSOCIATED, HARD WIRED, INTERLOCKED DUCT SMOKE DETECTORS, THE FIRE ALARM SYSTEM SHALL DE-ENERGIZE THE UNIT (INCLUDING THE SUPPLY FAN(S)). THE UNIT CONTROLLER SHALL THEN SEND AN ALARM TO THE OPERATORS WORKSTATION. THE DUCT SMOKE DETECTORS SHALL BE ABLE TO BE REMOTELY RESET VIA THE FIRE ALARM PANEL, OR REMOTE TEST SWITCH.

DRAIN PAN FLOAT SWITCH SHUTDOWN:
UPON ACTIVATION OF THE DRAIN PAN CONDENSATE FLOAT SWITCH, THE UNIT CONTROLLER SHALL USE ITS INTERNAL SHUTDOWN CONTROL ALGORITHMS TO CLOSE THE GAS HEAT EXCHANGER VALVE, DE-ENERGIZE THE COOLING COIL, DE-ENERGIZE THE SUPPLY AIR FAN(S), CLOSE THE OUTDOOR AIR DAMPER, AND OPEN THE RETURN AIR DAMPER. AN ALARM SHALL BE SENT TO THE OPERATORS WORKSTATION.

HIGH DUCT STATIC PRESSURE LIMIT SWITCH SHUTDOWN:
UPON ACTIVATION OF THE HIGH DUCT STATIC PRESSURE LIMIT SWITCH, THE UNIT CONTROLLER SHALL USE ITS INTERNAL SHUTDOWN CONTROL ALGORITHMS TO CLOSE THE GAS HEAT EXCHANGER VALVE, DE-ENERGIZE THE COOLING COIL, DE-ENERGIZE THE SUPPLY AIR FAN(S), CLOSE THE OUTDOOR AIR DAMPER, AND OPEN THE RETURN AIR DAMPER. AN ALARM SHALL BE SENT TO THE OPERATORS WORKSTATION.

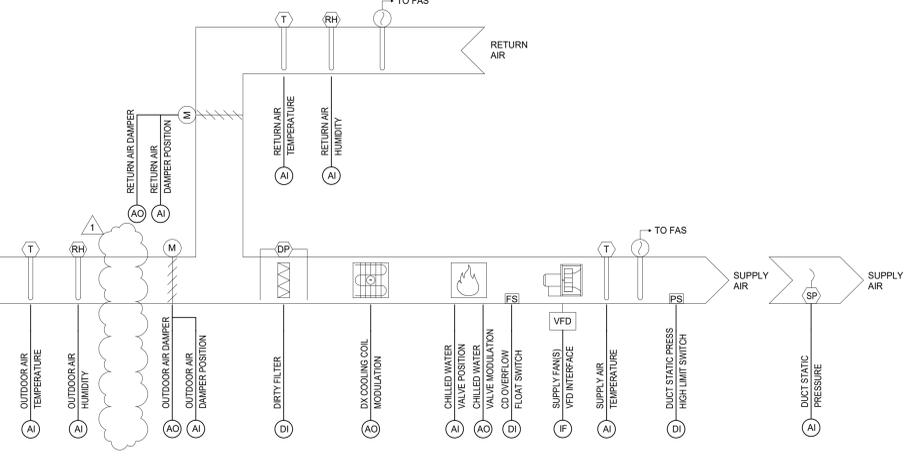

#	DESCRIPTION	INPUT		OUTPUT	
		ANALOG	DIGITAL	ANALOG	DIGITAL
1	RETURN AIR DRY BULB TEMPERATURE	X			
2	RETURN AIR RELATIVE HUMIDITY (OR DEWPOINT)	X			
3	RETURN AIR DAMPER CONTROL (0-100%)			X	
4	RETURN AIR DAMPER POSITION	X			
5	OUTDOOR AIR DRY BULB TEMPERATURE	X			
6	OUTDOOR AIR RELATIVE HUMIDITY (OR DEWPOINT)	X			
7	NOT USED				
8	OUTDOOR AIR DAMPER CONTROL (0 TO 100%)			X	
9	OUTDOOR AIR DAMPER POSITION	X			
10	DIRTY AIR FILTER SWITCH		X		
11	DX COOLING COIL MODULATION			X	
12	GAS HEAT EXCHANGER MODULATION			X	
13	CONDENSATE OVERFLOW SWITCH	X			
14	SUPPLY AIR FAN VFD INTERFACE (ON/OFF, STATUS)	X			X
15	SUPPLY AIR FAN VFD INTERFACE (SPEED CONTROL)			X	
16	LEAVING UNIT SUPPLY AIR DRY BULB TEMPERATURE	X			
17	DUCT STATIC PRESSURE HIGH LIMIT SWITCH		X		
18	DUCT STATIC PRESSURE	X			

NOTES:
A. RETURN AIR DAMPER AND OUTDOOR AIR DAMPER MAY BE INTERLOCKED AND MAY SHARE A COMMON MOTOR ACTUATOR OR EACH MAY HAVE ITS OWN MOTOR ACTUATOR.

GENERAL EXHAUST FAN CONTROL


SYSTEM DESCRIPTION:
THE EXHAUST FAN CONSISTS OF A DIRECT-DRIVE FAN, GRAVITY-OPERATED BACKDRAFT DAMPER, AND ALL ASSOCIATED APPURTENANCES AND DEVICES DEPICTED ON THE CONTROL SYSTEM DIAGRAM.

UNIT CONTROLLER:
THE EXHAUST FAN SHALL BE SUPPLIED WITH A FACTORY-MOUNTED DDC CONTROLLER WITH HAND / OFF / AUTO (HOA) CONTROL.

SYSTEM STARTUP/SHUTDOWN:
THE EXHAUST FAN SHALL BE STARTED/STOPPED BASED ON THE CONFIGURATION OF A 7-DAY DIGITAL TIME CLOCK.

OCCUPIED MODE:
WHEN THE SYSTEM IS PLACED IN OCCUPIED MODE, THE EXHAUST FAN SHALL OPERATE CONTINUOUSLY AT A CONSTANT SPEED. TO BE SET DURING TEST AND BALANCE. TO EXHAUST THE SCHEDULED AIRFLOW (CFM), IF THE FAN FAILS TO START, AS INDICATED BY THE CURRENT SWITCH, AN ALARM SHALL BE GENERATED AT THE OPERATORS WORKSTATION.

UNOCCUPIED MODE:
WHEN THE UNIT IS PLACED IN AN UNOCCUPIED MODE, THE EXHAUST FAN SHALL BE DE-ENERGIZED.

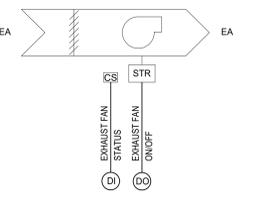

#	DESCRIPTION	INPUT		OUTPUT	
		ANALOG	DIGITAL	ANALOG	DIGITAL
1	EXHAUST FAN ON/OFF				X
2	EXHAUST FAN STATUS		X		

MECHANICAL CONTROL DIAGRAM

ASHVILLE FIRE STATION #2
222 7TH Avenue North
Ashville, AL 35953



M7.01

GMC # AHUN250003

ISSUE DATE


CONSTRUCTION DOCUMENTS 01/09/2026
ADDENDUM 4 02/06/2026

DRAWN BY: Author
CHECKED BY: Checker

FLOOR BOX SCHEDULE				
TAG	DESCRIPTION	BOX MAKE/MODEL BASIS OF DESIGN	COVER PLATE	DEVICES AND CONDUITS
FB1	6-GANG IN CONCRETE FLOOR BOX	LEGRAND RFB46	RECTANGULAR, FLUSH, FINISH TO BE CONFIRMED WITH ARCH	DUPLEX RECEPTACLE; COMMUNICATIONS PLATES AND GANG ADAPTERS AS REQUIRED FOR OWNER PROVIDED DEVICES - COORDINATE REQUIREMENT WITH OWNER. 1" CONDUIT FROM DATA COMPARTMENT; 1-1/4" CONDUIT FROM AV COMPARTMENT; U.O.N.
FB2	4-GANG IN CONCRETE FLOOR BOX	LEGRAND RFB44	RECTANGULAR, FLUSH, FINISH TO BE CONFIRMED WITH ARCH	DUPLEX RECEPTACLE; COMMUNICATIONS PLATES AND GANG ADAPTERS AS REQUIRED FOR OWNER PROVIDED DEVICES - COORDINATE REQUIREMENT WITH OWNER. 1" CONDUIT FROM DATA COMPARTMENT; 1-1/4" CONDUIT FROM AV COMPARTMENT; U.O.N.
FB3	2-GANG IN CONCRETE FLOOR BOX	LEGRAND RFB42	RECTANGULAR, FLUSH, FINISH TO BE CONFIRMED WITH ARCH	DUPLEX RECEPTACLE; SPARE 1" CONDUIT FROM DATA COMPARTMENT, U.O.N.

- POWER GENERAL NOTES:**
- COORDINATE LOCATION AND HEIGHT OF TVS OR DIGITAL DISPLAYS, CLOCKS, POWERED SPEAKERS, AND OTHER WALL-MOUNTED APPURTENANCES WITH OWNER AND ARCHITECT PRIOR TO ROUGH-IN.
 - BRANCH CIRCUITS SHALL HAVE DEDICATED NEUTRAL CONDUCTORS. UP TO THREE BRANCH CIRCUITS RATED NOT MORE THAN 30A, AND OF DIFFERENT PHASES, MAY BE INSTALLED IN A SINGLE CONDUIT, BUT CONDUCTOR AMPACITIES MUST BE DERATED IN ACCORDANCE WITH NEC 315.15 (B) (3).
 - CONTRACTOR SHALL PROVIDE ALL NECESSARY PROVISIONS, SUCH AS CONDUIT AND CONDUCTORS, TO MAKE FINAL CONNECTIONS TO HVAC AND PLUMBING EQUIPMENT FOR ENTIRE PROJECT. COORDINATE ALL STUB-UPS AND PENETRATIONS WITH OTHER TRADES PRIOR TO ROUGH-IN.
 - ENTIRE BRANCH CIRCUIT SHALL UTILIZE SAME CONDUCTOR SIZE AND QUANTITY BETWEEN OUTLETS AS HOMERUN UNLESS OTHERWISE NOTED.
 - INSTALL DISCONNECTS, MOTOR STARTERS, VFD'S, AND SIMILAR EQUIPMENT IN COORDINATION WITH OTHER TRADES TO ENSURE NEC REQUIRED DEDICATED SPACE AND WORKING CLEARANCES ARE MAINTAINED.
 - INSTALL DRY-TYPE TRANSFORMERS WITH ADEQUATE VENTILATION SPACE AT SIDES AND REAR. COMPLY WITH MANUFACTURER'S INSTRUCTIONS.

- POWER KEYED NOTES:**
- RECEPTACLES NEAR BUNKS SHALL BE LOCATED AT 28" AFF TO CENTER OF DEVICE. COORDINATE RECEPTACLE LOCATIONS WITH FURNITURE LAYOUT.
 - PROVIDE PLYWOOD BACKBOARD FOR TELECOM EQUIPMENT. 8'-0" HIGH X 3/4" THICK. MOUNT WITH BOTTOM AT 6" ABOVE FINISHED FLOOR. BACKBOARDS SHALL BE AC GRADE (FACE 'A' SIDE INTO ROOM) FIRE RETARDANT PLYWOOD (HOVER PYRO-GUARD OR APPROVED EQUAL). COUNTERSINK ALL SCREWS, FILL AND SMOOTH ALL SEAMS. COUNTERSINK SCREW HOLES AND VOIDS. PRIME WITH TWO COATS PRIMER, SANDING SMOOTH AFTER EACH COAT. FINISH WITH TWO COATS SEMI-GLOSS ENAMEL PAINT COLOR "GRAY" ON ALL EXPOSED SURFACES. FINAL SURFACES SHALL BE UNIFORMLY SMOOTH AND EVEN. ROUGH ALL ELECTRICAL OUTLETS INTO SPACE BEHIND BACKBOARD FOR FLUSH MOUNT INSTALLATION OF FACEPLATES.
 - STACKED MICROWAVES. COORDINATE MOUNTING HEIGHT WITH ARCHITECT PRIOR TO ROUGH-IN.
 - UNDER CABINET RECEPTACLE FOR GARBAGE DISPOSAL. LOCATE SWITCH FOR GARBAGE DISPOSAL ABOVE COUNTER. COORDINATE EXACT LOCATION WITH ARCHITECT.
 - INSTALL DRYER RECEPTACLE AT 34" AFF. COORDINATE FINAL LOCATIONS AND RECEPTACLE REQUIREMENTS WITH ARCHITECT PRIOR TO ROUGH IN.

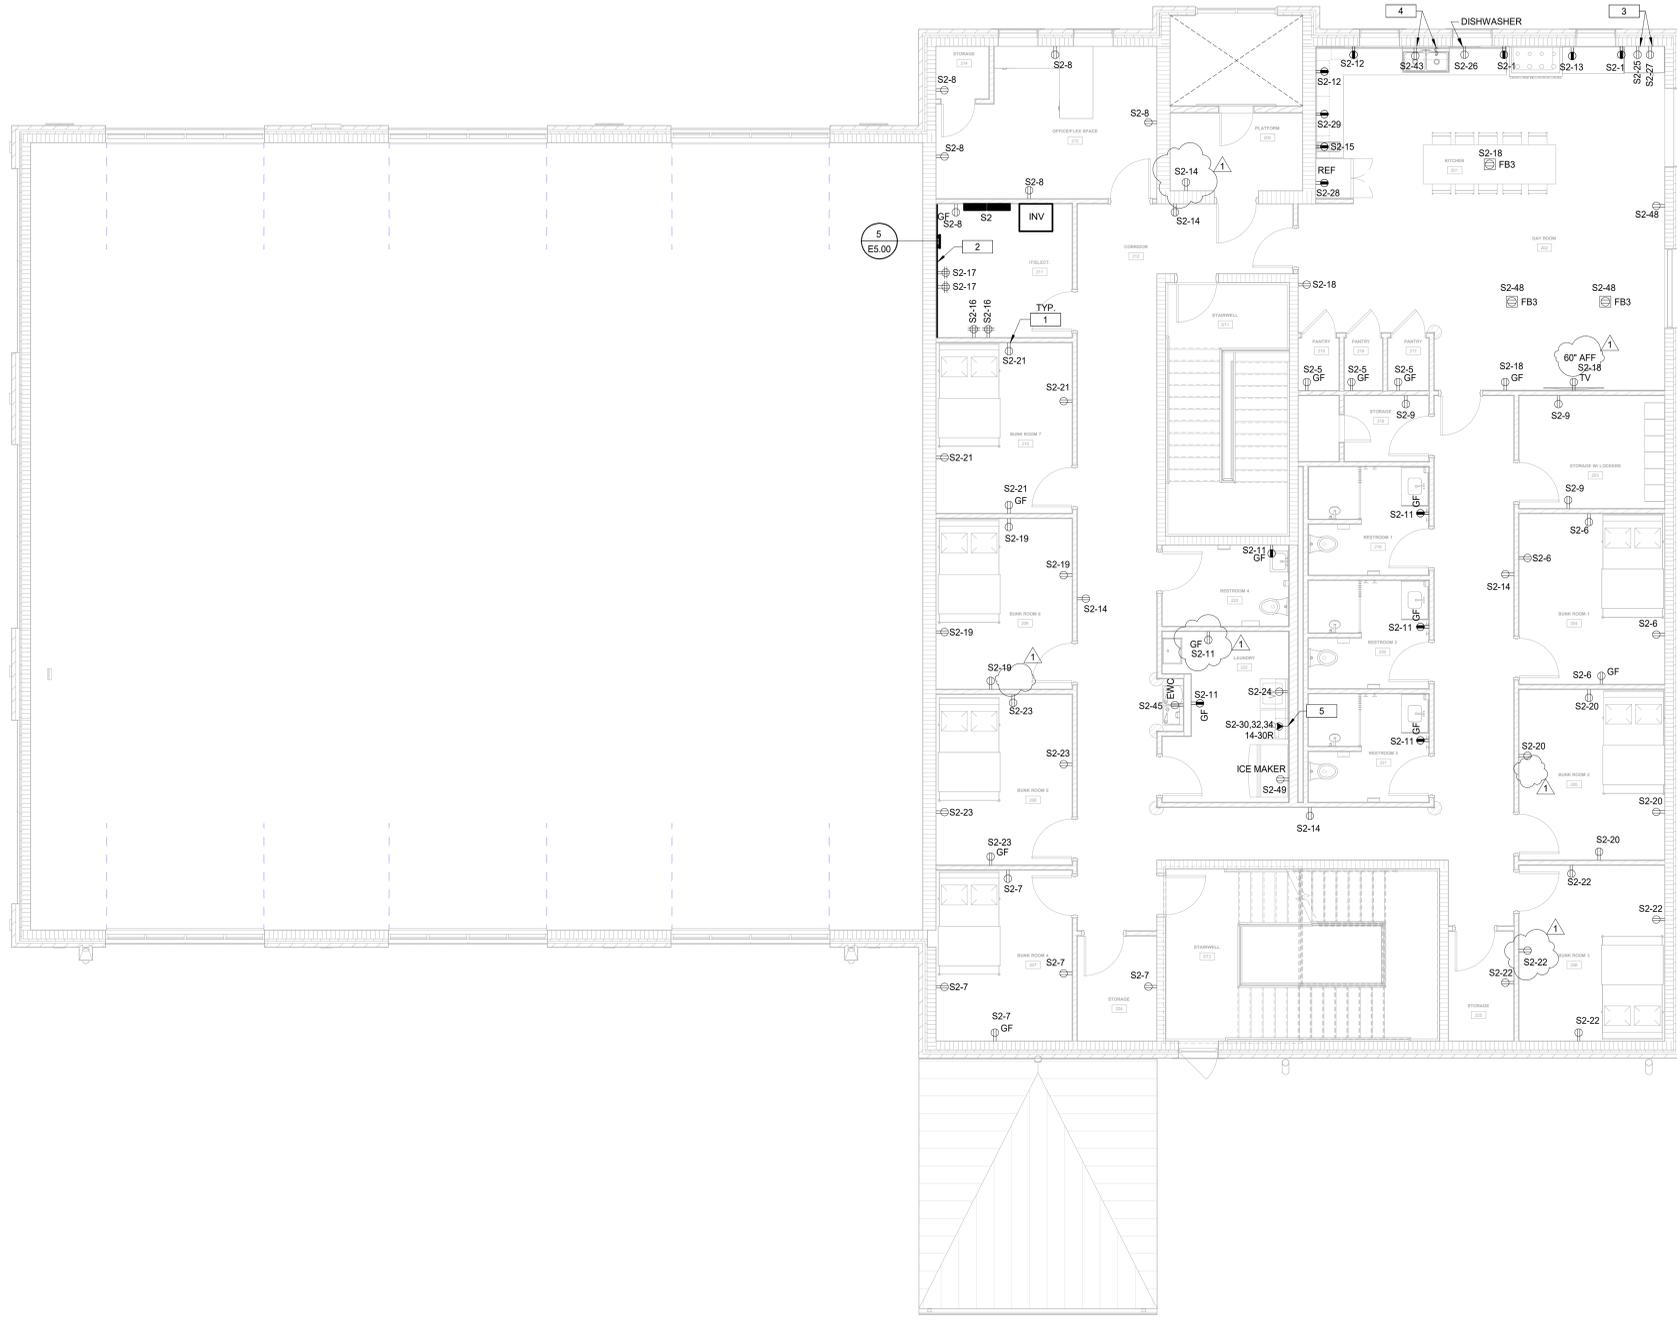

1 SECOND FLOOR POWER PLAN
 3/16" = 1'-0"

ISSUE DATE	ISSUE	DESCRIPTION
01/09/2026	1	CONSTRUCTION DOCUMENTS
12/02/2026		ADDENDUM 4

ASHVILLE FIRE STATION #2
 222 7TH Avenue North
 Ashville, AL 35953



POWER PLAN - SECOND FLOOR

E1.02

GMC # AHUN250003

DRAWN BY: REA
 CHECKED BY: JTD

LIGHTING FIXTURE SCHEDULE





TYPE	DESCRIPTION	MANUFACTURER	MODEL (EQUALS CAN BE SUBMITTED FOR APPROVAL)	WATTAGE	VOLTAGE	Comments
A1	2' X 4' RECESSED CENTER ELEMENT LED, 5000 LUMENS, 80 CRI, 3500K, CURVED OPAL LENS	LITHONIA	STAKS 2X4 5000LM 3500K	40 W	120V	RECESSED, COORDAITE WITH CEILING TYPE
A1E	2' X 4' RECESSED CENTER ELEMENT LED, 5000 LUMENS, 80 CRI, 3500K, CURVED OPAL LENS, CONNECTED TO EMERGENCY POWER	LITHONIA	STAKS 2X4 5000LM 3500K	40 W	120V	RECESSED, COORDAITE WITH CEILING TYPE
AZE	2' X 4' RECESSED CENTER ELEMENT LED, 5000 LUMENS, 80 CRI, 3500K, CURVED OPAL LENS, WITH INTEGRAL OCC SENSORS, CONNECTED TO EMERGENCY POWER	LITHONIA	STAKS 2X4 5000LM 3500K	40 W	120V	RECESSED, COORDAITE WITH CEILING TYPE, INTEGRAL OCC SESOR
A3	2' X 2' RECESSED CENTER ELEMENT LED, 5000 LUMENS, 80 CRI, 3500K, CURVED OPAL LENS	LITHONIA	STAKS 2X2 5000LM 3500K	35 W	120V	RECESSED, COORDAITE WITH CEILING TYPE
A3E	2' X 2' RECESSED CENTER ELEMENT LED, 5000 LUMENS, 80 CRI, 3500K, CURVED OPAL LENS, CONNECTED TO EMERGENCY POWER	LITHONIA	STAKS 2X2 5000LM 3500K	35 W	120V	RECESSED, COORDAITE WITH CEILING TYPE
D4	4" LED RECESSED DOWNLIGHT, 2000 LUMENS, 80 CRI, 3500K, BEVEL TRIM, WIDE BATWING DISTRIBUTION	GOTHAM	IV04D 20LM 35K 80CRI WD BEV ARS	20 W	120V	RECESSED, COORDAITE WITH CEILING TYPE
D4E	4" LED RECESSED DOWNLIGHT, 2000 LUMENS, 80 CRI, 3500K, BEVEL TRIM, WIDE BATWING DISTRIBUTION, CONNECTED TO EMERGENCY POWER	GOTHAM	IV04D 20LM 35K 80CRI WD BEV ARS	20 W	120V	RECESSED, COORDAITE WITH CEILING TYPE
D4W	4" LED RECESSED DOWNLIGHT, 2000 LUMENS, 80 CRI, 3500K, BEVEL TRIM, WIDE BATWING DISTRIBUTION, WET LOCATION LISTED	GOTHAM	IV04D 20LM 35K 80CRI WD BEV ARS	20 W	120V	RECESSED, COORDAITE WITH CEILING TYPE
D4WE	4" LED RECESSED DOWNLIGHT, 2000 LUMENS, 80 CRI, 3500K, BEVEL TRIM, WIDE BATWING DISTRIBUTION, WET LOCATION LISTED, CONNECTED TO EMERGENCY POWER	GOTHAM	IV04D 20LM 35K 80CRI WD BEV ARS	20 W	120V	RECESSED, COORDAITE WITH CEILING TYPE
D4WEXT	4" LED RECESSED DOWNLIGHT, 2000 LUMENS, 80 CRI, 4000K, BEVEL TRIM, WIDE BATWING DISTRIBUTION, WET LOCATION LISTED, CONNECTED TO EMERGENCY POWER	GOTHAM	IV04D 20LM 40K 80CRI WD BEV ARS	20 W	120V	RECESSED, COORDAITE WITH CEILING TYPE
D4WXT	4" LED RECESSED DOWNLIGHT, 2000 LUMENS, 80 CRI, 4000K, BEVEL TRIM, WIDE BATWING DISTRIBUTION, WET LOCATION LISTED	GOTHAM	IV04D 20LM 40K 80CRI WD BEV ARS	20 W	120V	RECESSED, COORDAITE WITH CEILING TYPE
F1	4" LED STRIP, WHITE DIFFUSE LENSE, 4000 LUMENS, 3600K, 80CRI	LITHONIA	CS5 L48 4000LM 35K	40 W	120V	
F1E	4" LED STRIP, WHITE DIFFUSE LENSE, 4000 LUMENS, 3600K, 80CRI, CONNECTED TO EMERGENCY POWER	LITHONIA	CS5 L48 4000LM 35K	40 W	120V	
F2E	4" LED STRIP, WHITE DIFFUSE LENSE, 6000 LUMENS, 3600K, 80CRI, WITH INTEGRAL OCC SENSORS, CONNECTED TO EMERGENCY POWER	LITHONIA	CS5 L48 6000LM 35K	40 W	120V	WITH INTEGRAL OCC SENSOR
FP	IN-GRADE LIGHT, 46W, 4000K, MEDIUM FLOOD, GLARE SHIELD, COORDINATE FINISH WITH ARCHITECT	HYDREL	M710C P3 40K MFL FLCRS GS	46 W	120V	
H2	LED LINEAR HIGH BAY, 18,000 LUMENS, 4000K, 80 CRI, GLARE CONTROL, HIGH EFFICIENCY, WIDE DISTRIBUTION	LITHONIA	CPBH 1800LM HEF GCL WD 40K 80CRI	130 W	120V	MOUNT SO THAT BOTTOM OF FIXTURE IS EVEN WITH BOTTOM OF ROOF JOIST.
H2E	LED LINEAR HIGH BAY, 18,000 LUMENS, 4000K, 80 CRI, GLARE CONTROL, HIGH EFFICIENCY, WIDE DISTRIBUTION, CONNECTED TO EMERGENCY POWER	LITHONIA	CPBH 1800LM HEF GCL WD 40K 80CRI	130 W	120V	MOUNT SO THAT BOTTOM OF FIXTURE IS EVEN WITH BOTTOM OF ROOF JOIST.
PLA	POLE MOUNTED AREA LUMINAIRE, P7 PERFORMANCE PACKAGE, 4000K, 70CRI, TYPE 2 MEDIUM, MOUNTED AT 25'; POLE SHALL BE SQUARED NON-TAPERED STEEL POLE, FINISH BY ARCHITECT.	LITHONIA	DSX0 LED P7 40K 70CRI	170 W	120V	
V1	LED VANITY LIGHT, 18W, SATIN BLACK, 3000K	SONNEMAN	FINO LED BATH BAR	11 W	120V	MOUNTED 7'-0" AFF CENTERED ABOVE SINK
W1	WALL PACK, 3000 LUMENS, 4000K, TYPE 3 MEDIUM, 80 CRI, COORDINATE FINISH WITH ARCHITECT	LITHONIA	WDGE2 P3 40K T3M MVOLT	20 W	120V	REFER TO PLANS FOR MOUNTING HEIGHT
W1E	WALL PACK, 3000 LUMENS, 4000K, TYPE 3 MEDIUM, 80 CRI, COORDINATE FINISH WITH ARCHITECT, CONNECTED TO EMERGENCY POWER	LITHONIA	WDGE2 P3 40K T3M MVOLT	20 W	120V	REFER TO PLANS FOR MOUNTING HEIGHT
W2	36" EXTERIOR SCONCE, 4000K, 3500 LUMENS, COORDINATE FINISH WITH ARCHITECT	SCOTT ARCHITECTURAL LIGHTING	S9272-L48	20 W	120V	REFER TO PLANS FOR MOUNTING HEIGHT
X1	UNIVERSAL MOUNT LED EXIT SIGN, SINGLE-SIDED ILLUMINATED FACE, GREEN, ARROWS AS INDICATED, CONNECTED TO EMERGENCY POWER	LITHONIA	EDG G	5 W	120V	

LIGHTING CONTROL SCHEDULE


LIGHTING CONTROL KEY	SPACE TYPE	WALL SWITCH	SENSOR	DAYLIGHT CTRL.	SCHEDULE	OPERATION
C1	CONFERENCE ROOM	DT1	CEILING	-	-	MANUAL ON; AUTO OFF AFTER 20 MIN VACANCY; SCENE PER TABLE
C1D	CONFERENCE ROOM W/ DAYLIGHTING	DT1	CEILING	YES	-	MANUAL ON; AUTO OFF AFTER 20 MIN VACANCY; SCENE PER TABLE. AUTOMATIC DIM FROM 100% DOWN TO 15% BASED ON MEASURED DAYLIGHT INTENSITY (ADJUSTABLE)
C2	CORRIDOR	D2K	CEILING	-	-	MANUAL ON/OFF (OVERRIDE) PER ZONE; OCCUPANCY ON TO 100%; AUTO DIM TO 50% AFTER 20 MIN VACANCY
C3	CLASSROOM	D4A	CEILING	-	-	MANUAL ON; AUTO ON TO 50%; AUTO OFF AFTER 20 MIN VACANCY; SCENE 1: 40%; SCENE 2: 75%; AUTOMATIC DIM FROM 100% DOWN TO 15% BASED ON MEASURED DAYLIGHT INTENSITY (ADJUSTABLE)
C3D	CLASSROOM W/ DAYLIGHTING	D4A	CEILING	YES	-	MANUAL ON; AUTO ON TO 50%; AUTO OFF AFTER 20 MIN VACANCY; SCENE 1: 40%; SCENE 2: 75%; AUTOMATIC DIM FROM 100% DOWN TO 15% BASED ON MEASURED DAYLIGHT INTENSITY (ADJUSTABLE)
E1	ELECTRICAL/MECHANICAL ROOM	S1	-	-	-	MANUAL ON/OFF
EX1	EXTERIOR BUILDING WALL PACKS	-	PHOTOCELL	-	YES	AUTO ON PHOTOCELL OR SCHEDULE 6:00PM, WHICHEVER IS FIRST; OFF AT 00:00
EX2	EXTERIOR PARKING	-	PHOTOCELL	-	YES	AUTO ON OR SCHEDULE 6:00PM, WHICHEVER IS FIRST; DIM TO 50% AT 00:00
F1	FITNESS/EXERCISE AREA	D4B	-	-	-	MANUAL ON; DIM UP/DN; OCCUPANCY ON TO 50%; AUTO OFF AFTER 20 MIN VACANCY
K1D	KITCHEN/DAYLIGHTING	D4A	CEILING	YES	-	MANUAL ON; OCCUPANCY ON TO 50%; AUTO OFF AFTER 20 MIN VACANCY; SCENE 1: 50%; SCENE 2: 75%; AUTOMATIC DIM FROM 100% DOWN TO 15% BASED ON MEASURED DAYLIGHT INTENSITY (ADJUSTABLE)
L1	LAUNDRY	D4A	CEILING	-	-	MANUAL ON; OCCUPANCY ON TO 50%; AUTO OFF AFTER 20 MIN VACANCY; SCENE 1: 50%; SCENE 2: 75%
L3	LOBBY	D2K	CEILING	-	-	MANUAL ON/AUTO OFF (OVERRIDE) PER ZONE; OCCUPANCY ON TO 100%; AUTO DIM TO 50% AFTER 20 MIN VACANCY
L3D	LOBBY W/ DAYLIGHTING	D2K	CEILING	YES	-	MANUAL ON/OFF (OVERRIDE) PER ZONE; AUTOMATIC DIM FROM 100% DOWN TO 15% BASED ON MEASURED DAYLIGHT INTENSITY (ADJUSTABLE)
L4	LOCKER ROOM	D4B	CEILING	-	-	MANUAL ON, DIM UP/DN; OCCUPANCY ON TO 50%; AUTO OFF AFTER 20 MIN VACANCY
L5	LOUNGE/BREAKROOM	D2	CEILING	-	-	MANUAL ON; OCCUPANCY ON TO 50%; AUTO OFF AFTER 20 MIN VACANCY
O1	OFFICE < 250 SQ FT	OS2	-	-	-	MANUAL ON; OCCUPANCY ON TO 50%; AUTO OFF AFTER 20 MIN VACANCY
O2	OFFICE > 250 SQ FT	D4B	-	-	-	MANUAL ON; OCCUPANCY ON TO 50%; AUTO OFF AFTER 20 MIN VACANCY
R1	RESTROOM - SMALL	OS	CEILING	-	-	MANUAL ON; OCCUPANCY ON; AUTO OFF AFTER 20 MIN VACANCY
R2	RESTROOM - GROUP/LARGE	D2K	CEILING	-	-	MANUAL ON; OCCUPANCY ON; AUTO OFF AFTER 20 MIN VACANCY
S1	STAIRWAY	SK	INTEGRAL	-	-	MANUAL ON; OCCUPANCY ON; DIM TO 50% AUTO AFTER 20 MIN VACANCY; FIXTURES TO HAVE INTEGRAL OCC SENSORS
S2	STORAGE < 50 SQ FT	OS	-	-	-	MANUAL ON; OCCUPANCY ON; AUTO OFF AFTER 20 MIN VACANCY
S3	STORAGE > 100 SQ FT	D2	CEILING	-	-	MANUAL ON; OCCUPANCY ON; AUTO OFF AFTER 20 MIN VACANCY
S4	SLEEPING QUARTERS	D6	-	-	-	PROGRAMMED SCENE DIMMING TO 30% (ADJUSTABLE) WITH TIME DELAY TO 50% OVER 2 MIN (ADJUSTABLE) UPON DISPATCH CALL (CONTACT CLOSURE INPUT). COORDINATE EXACT TIME DELAY WITH OWNER
W2	APPARTUS BAY	D4B	-	-	YES	SCHEDULE ON/OFF; PROVIDE MANUAL ON/OFF OVERRIDE; IF OWNER DESIRED, PROVIDE CONNECTION BETWEEN EMERGENCY DISPATCH CALL SYSTEM AND LIGHTING CONTROL PANEL TO ACTIVATE LIGHTS UPON EMERGENCY CALL.

LIGHTING SWITCH SCHEDULE



SWITCH	DESCRIPTION
D2	DIGITAL 2 BUTTON SWITCH: ON, OFF
D2K	KEYED DIGITAL 2 BUTTON SWITCH: ON, OFF
D4A	DIGITAL 4 BUTTON SWITCH: ON, OFF, SCENE 1, SCENE 2
D4B	DIGITAL 4 BUTTON SWITCH: ON, OFF, UP, DOWN
DAK	KEYED DIGITAL 4 BUTTON SWITCH: ON, OFF, UP, DOWN
D6	DIGITAL 6 BUTTON SWITCH: ON, OFF, UP, DN, SCENE 1, SCENE 2
DT1	DIGITAL TOUCH SCREEN CONTROLLER
OS	WALL-MOUNTED LOW VOLTAGE SWITCH WITH INTEGRAL OCCUPANCY SENSOR
OS2	WALL-MOUNTED LOW VOLTAGE SWITCH WITH INTEGRAL OCCUPANCY SENSOR AND DIMMING
S1	LINE VOLTAGE SWITCH
SK	LINE VOLTAGE KEYSWITCH
T1	TIMER SWITCH

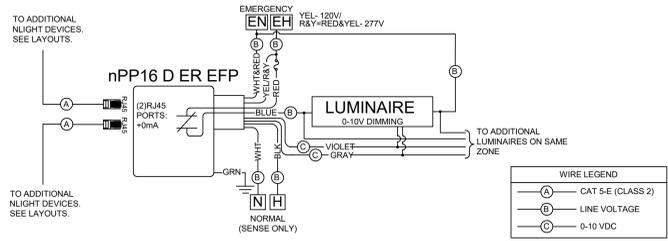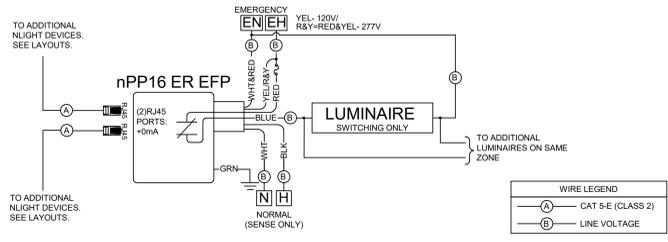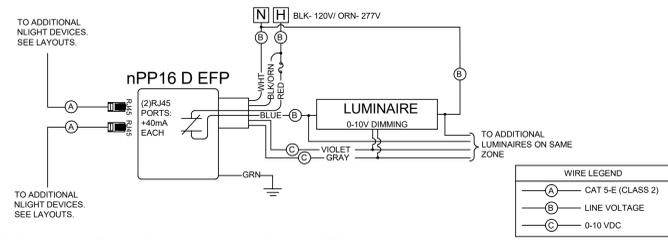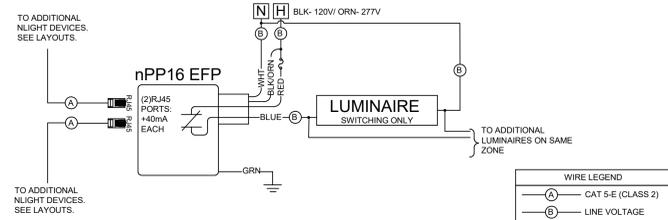

LIGHTING CONTROL PANEL 'LCP'

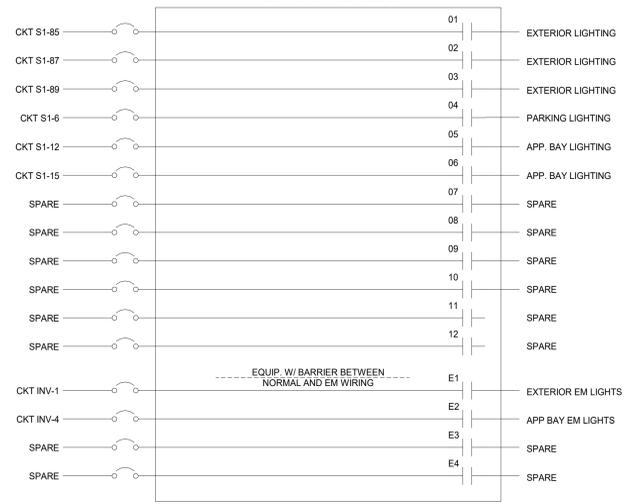

3 LIGHTING CONTROL PANEL
N.T.S.

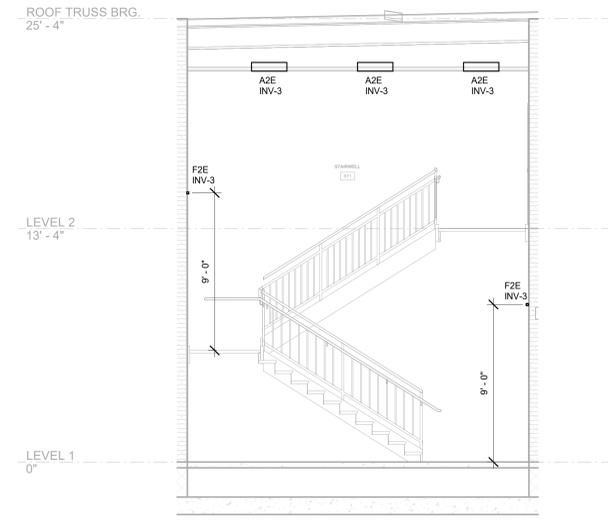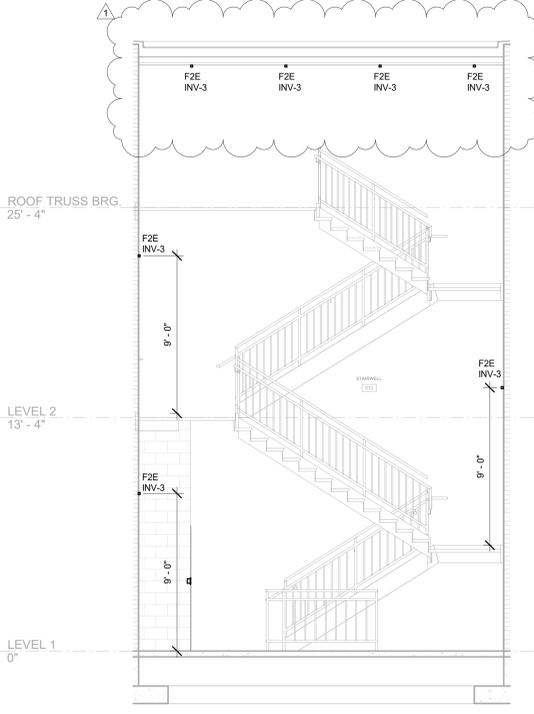


4 LIGHTING CONTROL DETAILS
N.T.S.

- LIGHTING GENERAL NOTES:**
- BRANCH CIRCUITS SHALL HAVE DEDICATED NEUTRAL CONDUCTORS. UP TO THREE BRANCH CIRCUITS RATED NOT MORE THAN 30A, AND OF DIFFERENT PHASES, MAY BE INSTALLED IN A SINGLE CONDUIT, BUT CONDUCTOR AMPACITIES MUST BE DERATED IN ACCORDANCE WITH NEC 315.15 (B) (3).
 - CONNECT ALL EXIT SIGNS AHEAD OF ALL SWITCHING IN SPACES SERVED.
 - ALL EXTERIOR LIGHTING SHALL HAVE THE SAME COLOR TEMPERATURE.
 - OCCUPANCY SENSORS SHALL BE DUAL TECHNOLOGY AND BE COMPATIBLE WITH ROOM LOW-VOLTAGE DIMMING OR ON/OFF SWITCHING AS INDICATED.
 - PROVIDE POWER PACKS AND ADDITIONAL COMPONENTS AS NEEDED, WHETHER OR NOT SHOWN ON PLANS, TO PROVIDE A FULLY FUNCTIONING CONTROL SYSTEM COMPLIANT WITH INTERNATIONAL ENERGY CONSERVATION CODE (IECC). COORDINATE ABOVE CEILING ACCESS TO INSTALLED COMPONENTS WITH ARCHITECT PRIOR TO ROUGH-IN. IF FIXTURES ARE INSTALLED IN HARD CEILINGS, LOCATE DEVICES, E.G. POWER PACKS, ETC., ABOVE ADJACENT SPACES WITH CEILING GRID OR OPEN TO STRUCTURE EQUIPMENT SPACES FOR ACCESS.
 - FINISH COLORS OF LIGHTING FIXTURES SHALL BE CONFIRMED WITH OWNER AND ARCHITECT PRIOR TO SUBMITTAL OF PRODUCT DATA FOR REVIEW BY ENGINEER.
 - OCCUPANCY AND DAYLIGHT SENSOR LAYOUT SHOWN IS APPROXIMATE. ADJUST LOCATIONS AND QUANTITIES IN FIELD AS NECESSARY TO PROVIDE FULL ROOM COVERAGE IN ACCORDANCE WITH MANUFACTURER'S DOCUMENTATION.
 - PROVIDE LOW-VOLTAGE SWITCHES CAPABLE OF MULTI-UNIT COMMUNICATION WITH POWER PACKS. OCCUPANCY SENSORS AND/OR LIGHT FIXTURES AS REQUIRED IN SPACES THAT REQUIRE MULTIPLE SWITCH LOCATIONS (SUCH AS 3-WAY AND 4-WAY APPLICATIONS).
 - CONTRACTOR SHALL CLOSELY COORDINATE ARCHITECTURAL REFLECTED CEILING PLANS AND CEILING TYPE SPECIFICATIONS WITH RESPECTIVE LIGHTING FIXTURE FOR EACH ROOM PRIOR TO ORDERING TO ASSURE PROPER INSTALLATION. CONFLICTS PERTAINING TO THE INSTALLATION REQUIREMENTS SHALL BE BROUGHT TO THE ATTENTION OF THE ARCHITECT/ENGINEER OF RECORD.
 - FOR ANY LIGHTING FIXTURE THAT REQUIRES REMOTE POWER SUPPLIES AND/OR CONTROLLERS, COORDINATE LOCATION OF THOSE SO THEY ARE NOT VISIBLE IN FINISHED SPACES.
 - UNLESS OTHERWISE NOTED, LIGHT FIXTURES DESIGNATED AS EMERGENCY THAT DO NOT CONTAIN INTEGRAL EMERGENCY BATTERIES SHALL BE CONTROLLED TO OPERATE (ON, OFF, DIM) WITH OTHER FIXTURES IN THE SAME GROUP, ROOM, OR AREA. SUCH FIXTURES SHALL EMPLOY AN EMERGENCY POWER PACK OR EMERGENCY SHUNT DEVICE WHICH CONNECTS THE FIXTURE TO ITS ALTERNATE POWER SUPPLY IN THE EVENT OF UTILITY POWER LOSS. EXTEND UNSWITCHED "NORMAL" UTILITY CIRCUIT TO THE POWER PACK OR SHUNT DEVICE FOR DETECTION OF UTILITY POWER LOSS.

- LIGHTING KEYED NOTES:**
- LIGHTING CONTROL PANEL SHALL BE EQUIPPED WITH 24 RELAYS. RELAYS SHALL BE 120V RATED 20A. CONTROL PANEL SHALL BE EQUIPPED WITH ASTRONOMICAL TIME CLOCK, PHOTOCELL, 7 DAY HOLIDAY SCHEDULING, 0-10V DIMMING AND SHALL BE EQUIPPED WITH NETWORK PORT AND INPUT FOR FIRE ALARM OVERRIDE.
 - FIXTURES INDICATED AS NIGHTLIGHTS SHALL BE CONTROLLED ALONG WITH OTHER FIXTURES IN THEIR GROUP DURING NORMAL BUSINESS HOURS. AFTER HOURS, FIXTURES DESIGNATED AS NIGHTLIGHTS SHALL ILLUMINATE TO 50%.



1 FIRST FLOOR LIGHTING PLAN
 3/16" = 1'-0"

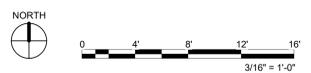

ISSUE DATE

CONSTRUCTION DOCUMENTS	01/09/2026
ADDENDUM 1	02/06/2026
ADDENDUM 2	
ADDENDUM 3	
ADDENDUM 4	
ADDENDUM 5	
ADDENDUM 6	
ADDENDUM 7	
ADDENDUM 8	
ADDENDUM 9	
ADDENDUM 10	
ADDENDUM 11	
ADDENDUM 12	
ADDENDUM 13	
ADDENDUM 14	
ADDENDUM 15	
ADDENDUM 16	
ADDENDUM 17	
ADDENDUM 18	
ADDENDUM 19	
ADDENDUM 20	

ASHVILLE FIRE STATION #2
 222 7TH Avenue North
 Ashville, AL 35953

GMC # AHUN250003




LIGHTING PLAN - FIRST FLOOR

E2.01

DRAWN BY: REA
 CHECKED BY: JTD

- LIGHTING GENERAL NOTES:**
- BRANCH CIRCUITS SHALL HAVE DEDICATED NEUTRAL CONDUCTORS. UP TO THREE BRANCH CIRCUITS RATED NOT MORE THAN 30A, AND OF DIFFERENT PHASES, MAY BE INSTALLED IN A SINGLE CONDUIT, BUT CONDUCTOR AMPACITIES MUST BE DERATED IN ACCORDANCE WITH NEC 315.15 (B) (3).
 - CONNECT ALL EXIT SIGNS AHEAD OF ALL SWITCHING IN SPACES SERVED.
 - ALL EXTERIOR LIGHTING SHALL HAVE THE SAME COLOR TEMPERATURE.
 - OCCUPANCY SENSORS SHALL BE DUAL TECHNOLOGY AND BE COMPATIBLE WITH ROOM LOW-VOLTAGE DIMMING OR ON/OFF SWITCHING AS INDICATED.
 - PROVIDE POWER PACKS AND ADDITIONAL COMPONENTS AS NEEDED, WHETHER OR NOT SHOWN ON PLANS, TO PROVIDE A FULLY FUNCTIONING CONTROL SYSTEM COMPLIANT WITH INTERNATIONAL ENERGY CONSERVATION CODE (IECC). COORDINATE ABOVE CEILING ACCESS TO INSTALLED COMPONENTS WITH ARCHITECT PRIOR TO ROUGH-IN. IF FIXTURES ARE INSTALLED IN HARD CEILINGS, LOCATE DEVICES, E.G. POWER PACKS, ETC., ABOVE ADJACENT SPACES WITH CEILING GRID OR OPEN TO STRUCTURE EQUIPMENT SPACES FOR ACCESS.
 - FINISH COLORS OF LIGHTING FIXTURES SHALL BE CONFIRMED WITH OWNER AND ARCHITECT PRIOR TO SUBMITTAL OF PRODUCT DATA FOR REVIEW BY ENGINEER.
 - OCCUPANCY AND DAYLIGHT SENSOR LAYOUT SHOWN IS APPROXIMATE. ADJUST LOCATIONS AND QUANTITIES IN FIELD AS NECESSARY TO PROVIDE FULL ROOM COVERAGE IN ACCORDANCE WITH MANUFACTURER'S DOCUMENTATION.
 - PROVIDE LOW-VOLTAGE SWITCHES CAPABLE OF MULTI-UNIT COMMUNICATION WITH POWER PACKS. OCCUPANCY SENSORS AND/OR LIGHT FIXTURES AS REQUIRED IN SPACES THAT REQUIRE MULTIPLE SWITCH LOCATIONS (SUCH AS 3-WAY AND 4-WAY APPLICATIONS).
 - CONTRACTOR SHALL CLOSELY COORDINATE ARCHITECTURAL REFLECTED CEILING PLANS AND CEILING TYPE SPECIFICATIONS WITH RESPECTIVE LIGHTING FIXTURE FOR EACH ROOM PRIOR TO ORDERING TO ASSURE PROPER INSTALLATION. CONFLICTS PERTAINING TO THE INSTALLATION REQUIREMENTS SHALL BE BROUGHT TO THE ATTENTION OF THE ARCHITECT/ENGINEER OF RECORD.
 - FOR ANY LIGHTING FIXTURE THAT REQUIRES REMOTE POWER SUPPLIES AND/OR CONTROLLERS, COORDINATE LOCATION OF THOSE SO THEY ARE NOT VISIBLE IN FINISHED SPACES.
 - UNLESS OTHERWISE NOTED, LIGHT FIXTURES DESIGNATED AS EMERGENCY THAT DO NOT CONTAIN INTEGRAL EMERGENCY BATTERIES SHALL BE CONTROLLED TO OPERATE (ON, OFF, DIM) WITH OTHER FIXTURES IN THE SAME GROUP, ROOM, OR AREA. SUCH FIXTURES SHALL EMPLOY AN EMERGENCY POWER PACK OR EMERGENCY SHUNT DEVICE WHICH CONNECTS THE FIXTURE TO ITS ALTERNATE POWER SUPPLY IN THE EVENT OF UTILITY POWER LOSS. EXTEND UNSWITCHED "NORMAL" UTILITY CIRCUIT TO THE POWER PACK OR SHUNT DEVICE FOR DETECTION OF UTILITY POWER LOSS.
 - UNLESS OTHERWISE NOTED, LIGHT FIXTURES DESIGNATED AS EMERGENCY THAT CONTAIN INTEGRAL EMERGENCY BATTERIES SHALL BE CONTROLLED TO OPERATE (ON, OFF, DIM) WITH OTHER FIXTURES IN THE SAME GROUP, ROOM, OR AREA. SUCH FIXTURES SHALL EMPLOY AN INTEGRAL EMERGENCY BATTERY UNIT AND EMERGENCY SHUNT DEVICE WHICH CONNECTS THE FIXTURE TO ITS ALTERNATE POWER SUPPLY IN THE EVENT OF UTILITY POWER LOSS. EXTEND UNSWITCHED "NORMAL" UTILITY CIRCUIT TO THE FIXTURE FOR DETECTION OF UTILITY POWER LOSS.

- LIGHTING KEYED NOTES:**
- MANUAL DIAL SWITCH FOR SHOWERS, 60 MINUTE TIMER.
 - FIXTURES INDICATED AS NIGHTLIGHTS SHALL BE CONTROLLED ALONG WITH OTHER FIXTURES IN THEIR GROUP DURING NORMAL BUSINESS HOURS. AFTER HOURS, FIXTURES DESIGNATED AS NIGHTLIGHTS SHALL ILLUMINATE TO 50%.

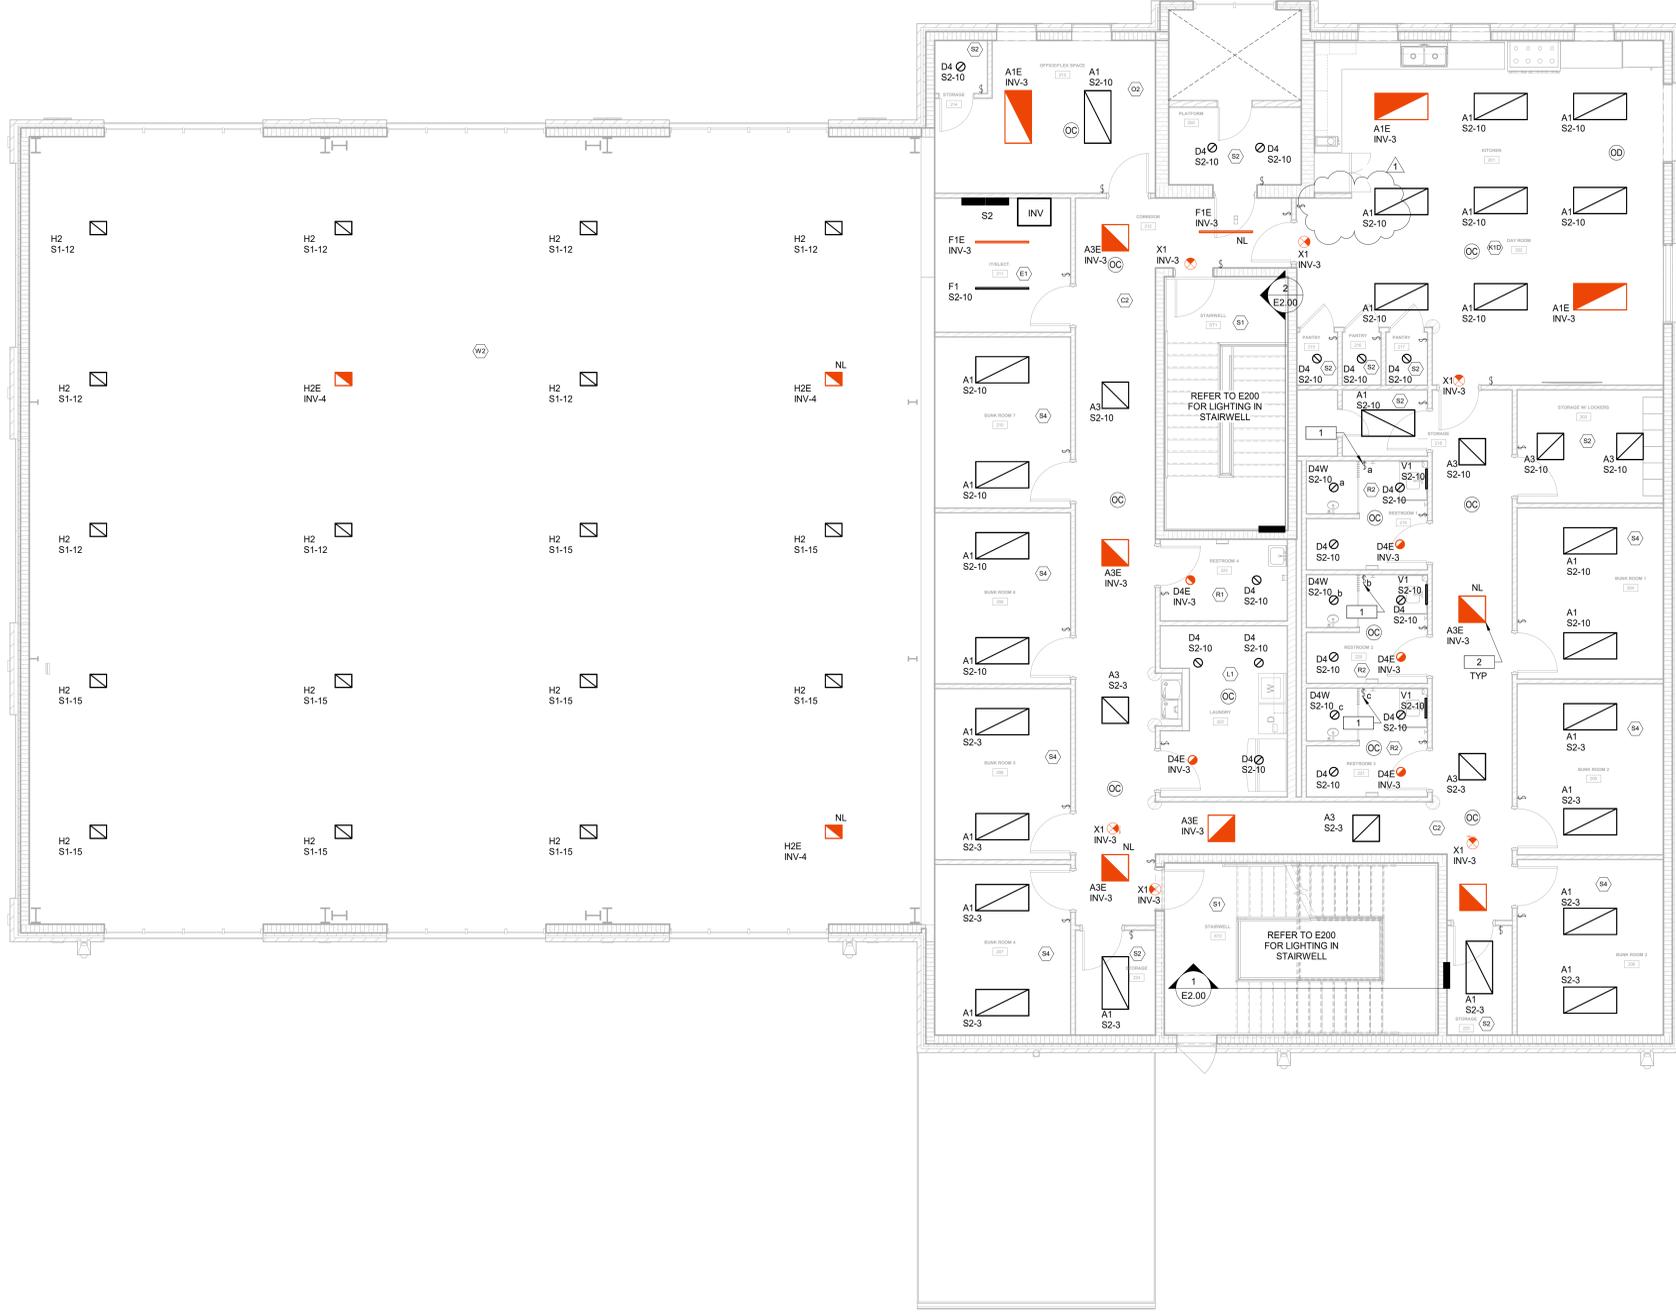

1 SECOND FLOOR LIGHTING PLAN
 3/16" = 1'-0"

ISSUE DATE	ISSUE DESCRIPTION	ISSUE BY	CHECKED BY
01/09/2026	CONSTRUCTION DOCUMENTS		
2/6/2026	ADDENDUM 4		

ASHVILLE FIRE STATION #2
 222 7TH Avenue North
 Ashville, AL 35953



LIGHTING PLAN -
 SECOND FLOOR

E2.02

GMC # AHUN250003

DRAWN BY: REA
 CHECKED BY: JTD

