
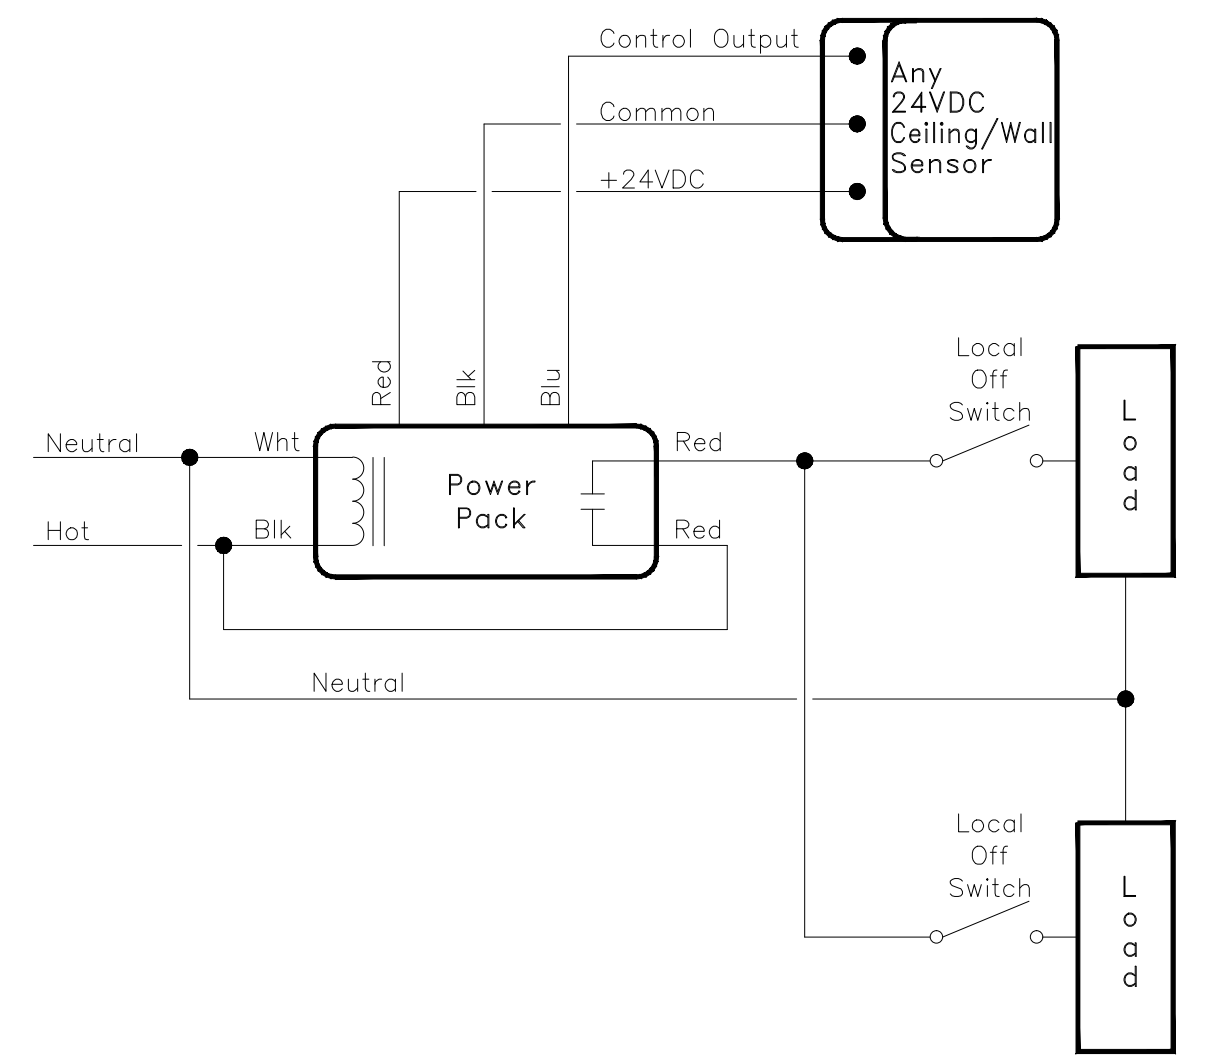


**1 ELECTRICAL LIGHTING PLAN** SCALE: 1/8" = 1'-0"

- SEED PROJECT NOTES:**
- A. REMOVE AND DISCARD LIGHT FIXTURES IN ROOM. ASSOCIATED BRANCH CIRCUITS MUST BE PRESERVED FOR NEW LIGHT FIXTURES.**
  - B. KENNEL AREA: REMOVE LIGHTING FIXTURES, EXIT ILLUMINATED SIGNS, BRANCH CIRCUITS ASSOCIATED TO ELECTRIC CEILING FANS, ELECTRIC POWER EQUIPMENT, AND ASSOCIATED DEVICES. ALL ITEMS REMOVED SHALL BE PROPERLY DISCARDED.**

**SPECIAL ELECTRICAL NOTES**

- ① OUTSIDE WALL FIXTURES TO BE MOUNTED ABOVE DOOR.
- ② CONNECT EMERGENCY LIGHT FIXTURES CIRCUITS IN ACCORDANCE WITH DETAIL **1** ON SHEET E-601.
- ③ CONTRACTOR SHALL COORDINATE THE INSTALLATION OF SURGERY LIGHT FIXTURE ABOVE EXAMINATION TABLE WITH USER (FORT POLK VTF).
- ④ EXTERIOR LIGHTING CONTROL SCHEMATIC AT DETAIL **2** ON SHEET E-601.
- ⑤ PROVIDE CEILING MOUNTED OCCUPANCY SENSOR IN THIS ROOM. REFER TO WIRING DIAGRAM ON SHEET E-102.
- ⑥ PENDANT MOUNT "C1" FIXTURES IN THIS AREA AT 9'-0" AFF. COORDINATE LOCATION WITH MECHANICAL PRIOR TO ROUGH-IN.
- ⑦ PENDANT MOUNT "C1" FIXTURES IN THIS AREA AT 9'-0" AFF. COORDINATE LOCATION WITH OVERHEAD DOOR PRIOR TO ROUGH-IN.

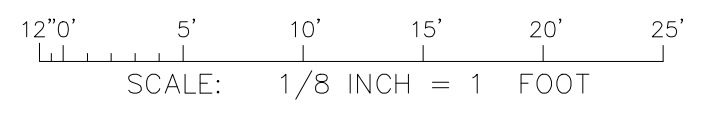

**2 OCCUPANCY WIRING DIAGRAM** SCALE: NO SCALE

Rev.	Date	Description

Designed by B. BLANCHARD	Date FEBRUARY 2012
Dwn by B. BLANCHARD	Sal No. W9126G-10-D-0025
Reviewed by M. SMITH	Contr. No.
Submitted by TROY MARTINSON, PE PROJECT MANAGER	Plot date Plot scale


U.S. ARMY ENGINEER DISTRICT  
CORPS OF ENGINEERS  
FORT WORTH, TEXAS

**MERRICK & COMPANY**

FORT POLK, LOUISIANA  
MILITARY WORKING DOG FACILITY  
PROJECT No.: 062622, P2# 130860

**ELECTRICAL LIGHTING PLAN**

Sheet reference number:  
**E-102**  
Sheet 85 of 96

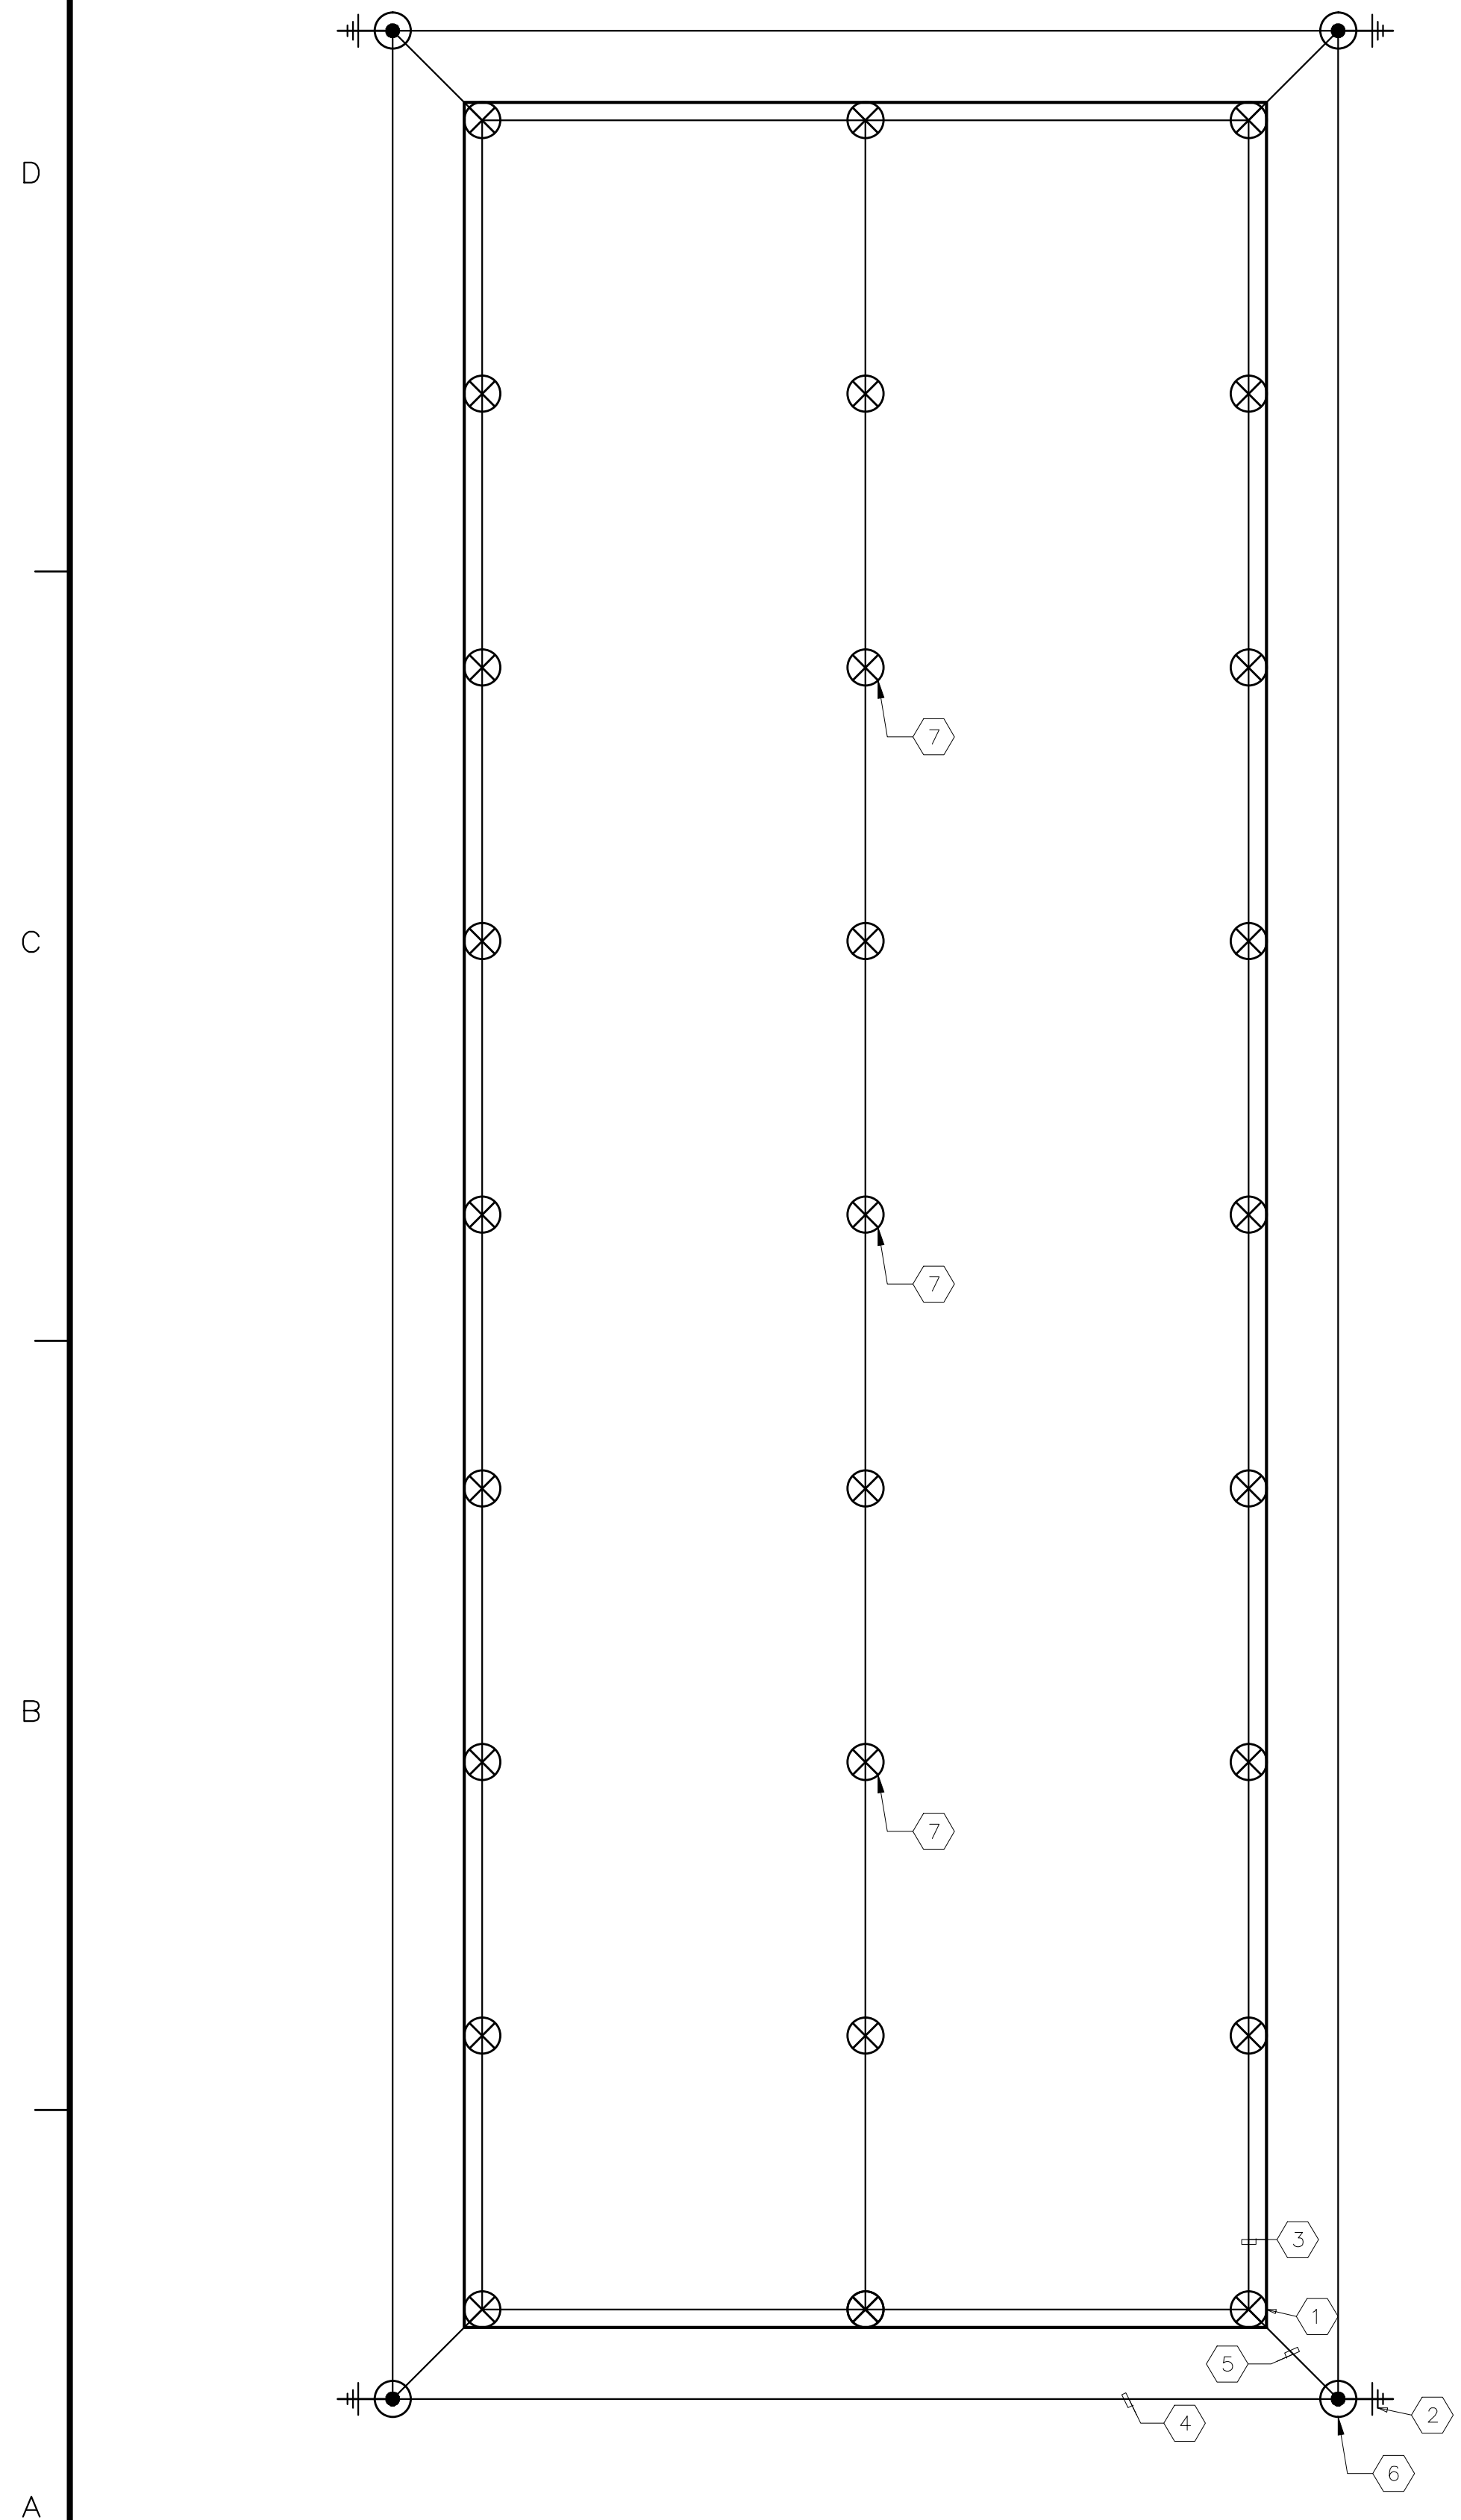

**LEGEND**

- ⊗ 1/2" DIAMETER, 12" AIR TERMINAL
- PRIMARY CONDUCTOR
- SECONDARY CONDUCTOR
- BONDING
- ⊥ GROUND ROD
- ⊙ GROUND ROD TEST WELL

**GENERAL NOTES:**  
(LIGHTNING PROTECTION SYSTEM)


1. STRUCTURAL FRAMEWORK SHALL BE MADE ELECTRICALLY CONTINUOUS BY WELDING.
2. ALL SPLICES BELOW GRADE SHALL BE THE EXOTHERMIC WELD TYPE.
3. CONNECT AIR TERMINAL TO THE STRUCTURAL STEEL FRAMING WITH CONDUCTOR ROUTED THROUGH THE ROOF AND WELD TO HORIZONTAL MEMBER.
4. CONNECT AIR TERMINAL TO TOP OF THE STRUCTURAL STEEL COLUMN WITH CONDUCTOR ROUTED THROUGH THE ROOF.
5. GROUND RODS SHALL BE CONNECTED TO BOTTOM OF THE STRUCTURAL STEEL COLUMN WITH NO. 1/0 AWG BARE COPPER CONDUCTOR.
6. ALL METAL EQUIPMENT ON ROOF SHALL BE BONDED TO THE LIGHTNING PROTECTION SYSTEM.
7. THRU ROOF FLASHING SHALL BE ALUMINUM WITH 8 INCH ROUND BASE AND VERTICAL TUBE WITH NEOPRENE SEAL. FLASHING SHALL BE THE PRODUCT OF THE MANUFACTURER OF THE LIGHTNING PROTECTION SYSTEM. A MEMBRANE FLASHING SHALL BE PROVIDED OVER THE THRU ROOF FLASHING.
8. BOND TO WATER SERVICE PIPES AND OTHER METALLIC PIPING SYSTEMS AS REQUIRED BY NFPA 70 AND 780.
9. INTERCONNECT LIGHTNING PROTECTION GROUNDING SYSTEM TO ELECTRICAL POWER SYSTEM, TELECOMMUNICATIONS, AND BUILDING GROUNDING GRID SYSTEMS AS REQUIRED BY NFPA 70 AND 780.
10. MINIMUM GROUND CABLE LAYOUT AND MINIMUM GROUND ROD LOCATIONS ARE SHOWN. PROVIDE ADDITIONAL GROUND RODS AS NECESSARY TO OBTAIN OVERALL GROUND GRID SYSTEM RESISTANCE OF LESS THAN 10 OHMS.
11. PROVIDE THE LIGHTNING PROTECTION SYSTEM IN ACCORDANCE WITH THE REQUIREMENTS OF THE SPECIFICATIONS AND NFPA 780 AND UL 96A. THE NEW FACILITY SHALL HAVE A UL MASTER LABEL CERTIFICATE.
12. BARE COPPER MATERIALS SHALL NOT COME IN CONTACT WITH ALUMINUM.
13. INSTALLED LIGHTNING PROTECTION SYSTEM SHALL BE FIELD-INSPECTED WITH UL MASTER LABEL FOR LIGHTNING PROTECTION SYSTEM.
14. PROVIDE PVC SLEEVE WHEREVER GROUNDING CONDUCTOR MUST PASS THROUGH CONCRETE PAD, SLAB, OR FOUNDATION GRADE BEAM.
15. GROUND ALL STRUCTURAL METAL OBJECTS SUCH AS HANDRAILS.

**SPECIAL ELECTRICAL NOTES:**  
(SHEET E-105 ONLY)


1. TYPICAL ALUMINUM AIR TERMINAL SHALL BE PLACED AT OR WITHIN 2 FEET OF THE ENDS OF RIDGES OR EDGES AND CORNERS OF ROOFS.
2. TYPICAL 3/4" x 10' COPPERCLAD GROUND ROD, THERMOWELDED TO GROUND LOOP CONDUCTOR.
3. ALUMINUM CONDUCTOR, 14 AWG, 98,600 CIRCULAR MILS, NET WEIGHT 95 LBS. PER 1,000 FEET.
4. GROUND LOOP COPPER CONDUCTOR, 1/0 AWG, 115,000 CIRCULAR MILS, WEIGHT 375 LBS. PER 1,000 FEET. BURIED 3 FEET BELOW GRADE, AND THERMOWELDED TO GROUND RODS.
5. ALUMINUM CONDUCTOR, 14 AWG, 98,600 CIRCULAR MILS, NET WEIGHT 95 LBS. PER 1,000 FEET, BONDED TO STRUCTURAL STEEL FRAMEWORK.
6. TYPICAL TEST WELL FOR COPPER-CLAD STEEL GROUND RODS. BOND ALL GROUND RODS TOGETHER.
7. MOUNT A GROUNDED AIR TERMINAL ON METAL STRUCTURE.

**SEED PROJECT NOTE:**


THIS SHEET IS THE EXISTING LIGHTNING PROTECTION SYSTEM (LPS) AS BUILT. LPS SHALL BE DESIGNED AND CONSTRUCTED PER CODES AND CRITERIA CALLED IN THIS RFP. A UL LIGHTNING PROTECTION INSPECTION MASTER LABEL CERTIFICATE SHALL BE PROVIDED BY A COMMERCIAL THIRD-PARTY INSPECTION ENTITY, AS NOTED IN UFC 3-575-01. THE EXISTING STANDING SEAM METAL ROOF IS TO REMAIN AND BE EXTENDED ON EITHER SIDE OF THE KENNEL AND AT THE OFFICE WITH THE NEW FIRE ROOM. THE EXISTING LPS SHALL BE MODIFIED TO COMPLY WITH ALL REQUIREMENTS. MODIFICATION MAY ENTAIL AN ALL NEW SYSTEM. THE LPS CONTRACTOR SHALL DETERMINE WHAT MAY OR MAY NOT BE REUSED DURING CONSTRUCTION.

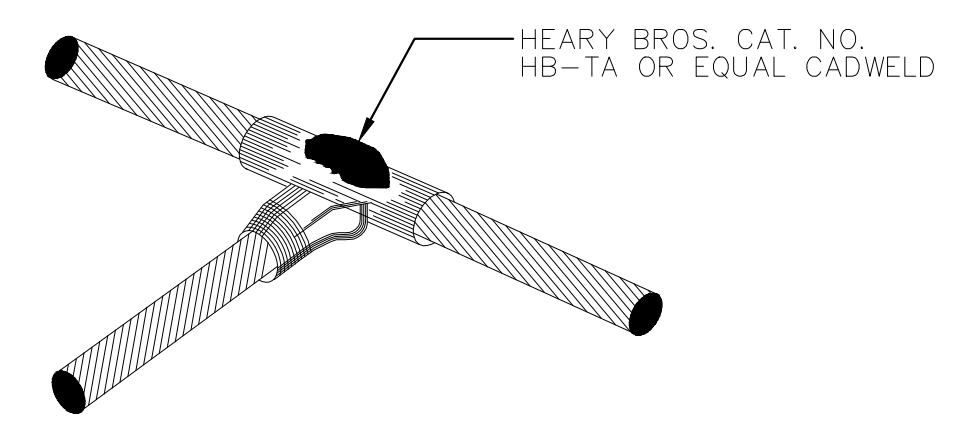


**2 TEE-SPLICER CONNECTOR DETAIL**  
NO SCALE

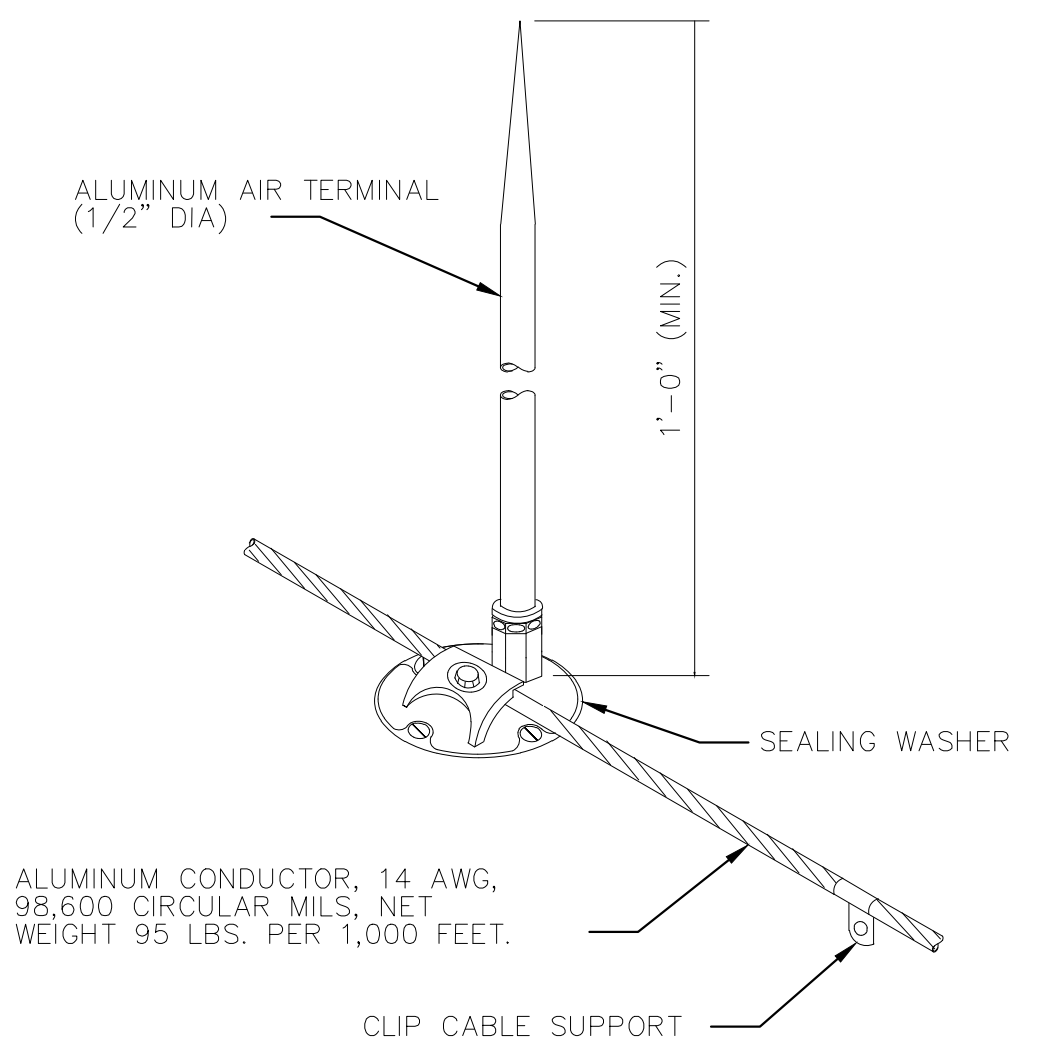


**3 AIR TERMINAL DETAIL**  
NO SCALE

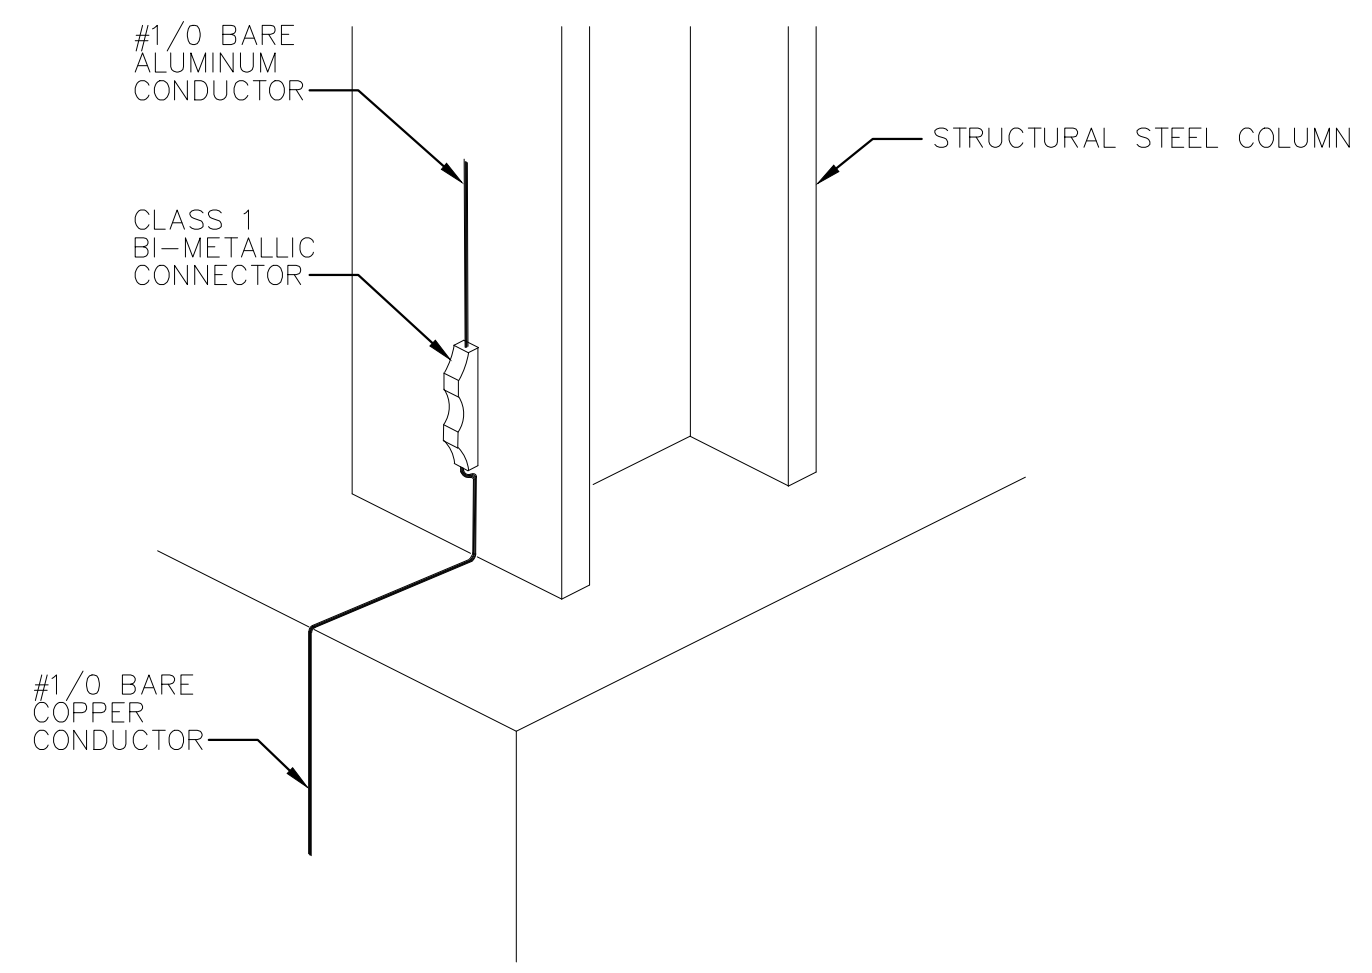

**4 BI-METALLIC CONNECTOR DETAIL**  
NO SCALE

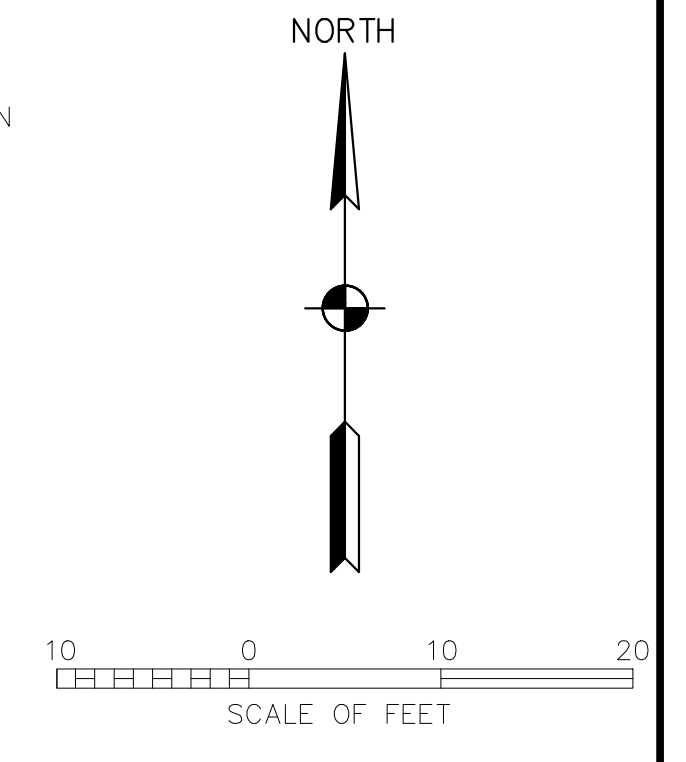

**1 LIGHTNING PROTECTION PLAN**  
SCALE: 1" = 10'

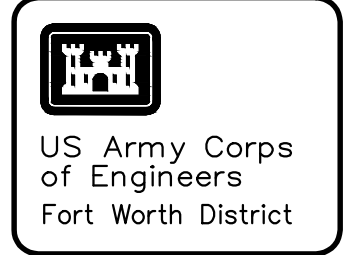

Symbol	Description	Tracking No.	Action	Date

Designed by: M. SMITH	Date: FEBRUARY 2012	Rev.
Dwn by: B. BLANCHARD	Sol No. W9126G-12-R-0056	
Reviewed by: G. VERSTRAETE	Contr. No.	
Submitted by: TROY MARINSON, PE	Project No. FP062622E105	Proj. date: 
PROJECT MANAGER		Proj. scale: 

U.S. ARMY ENGINEER DISTRICT  
CORPS OF ENGINEERS  
FORT WORTH, TEXAS

FORT POLK, LOUISIANA  
MILITARY WORKING DOG FACILITY  
PROJECT No.: 062622, P2# 130860

LIGHTNING  
PROTECTION PLAN

Sheet reference number:  
**E-105**  
Sheet 88 of 96



**LIGHTING:**  
Technology shall be LED. All lamps shall have a Correlated Color Temperature (CCT) not greater than 4100k, a Color Rendering Index of (CRI) not less than 80, minimum efficacy of 100 lumens per watt, a lumen depreciation greater than or equal to L70 at 40,000 hours and five-year unconditional warranty for material.

**Kennel Area:**  
(1) Provide lighting controls as required by UFC 3-530-01.  
(2) Provide full cut-off type, wall-mounted, lighting fixtures around the building perimeter. These fixtures shall be controlled by a lighting contactor with a photocell and timeclock should respond to the architectural character of the facility.  
(3) Provide emergency lighting required by NFPA 101. Incorporate the emergency lighting into normally provided lighting fixtures by utilizing local battery backup.  
(4) Provide LED illuminated exit signs with battery backup in accordance with NFPA 101.

**Office Area:**  
(1) Provide lighting controls as required by UFC 3-530-01. This will include manual controls of each area along with occupancy/vacancy sensors.  
(2) Provide general-purpose lighting in the following rooms: Kennel Master, Entry Vestibule, Handlers/Conf, Dog Food, Trainers, COMM, Changing Room and Exam Groom area (Bid Option).

1. Conform to NFPA 101 regarding penetrations in walls and partitions due to outlet boxes, normal construction ratings or fire ratings. At all penetrations of fire-rated walls or partitions, seal the opening to maintain the fire rating of the wall or partition. Provide F-rating in accordance with ASTM E814 or UL1479 that matches the rating of the wall or partition being penetrated. Provide commercially manufactured products manufactured and tested specifically for condition of application.


2. All building telecommunications cabling systems (BCS) shall conform to TIA 568, TIA 569, TIA 607, UFC 3-580-01. If any conflicts arise between UFC or TIA's, then UFC will take precedence.

REFER TO THE EXISTING AS BUILT LIGHTING PLAN. THE QUANTITY OF NEW FIXTURES SHALL BE SIMILAR IN THE OFFICE AREA. ALL WALKWAYS OF THE KENNEL AREA SHALL HAVE NEW FIXTURES INSTALLED SIMILAR TO THE EXISTING WALKWAYS LAYOUT. FINAL QUANTITIES AND TYPE TO BE DETERMINED DURING DESIGN.

### SHEET NOTES

### FLOOR PLAN

FOR INFORMATION ONLY

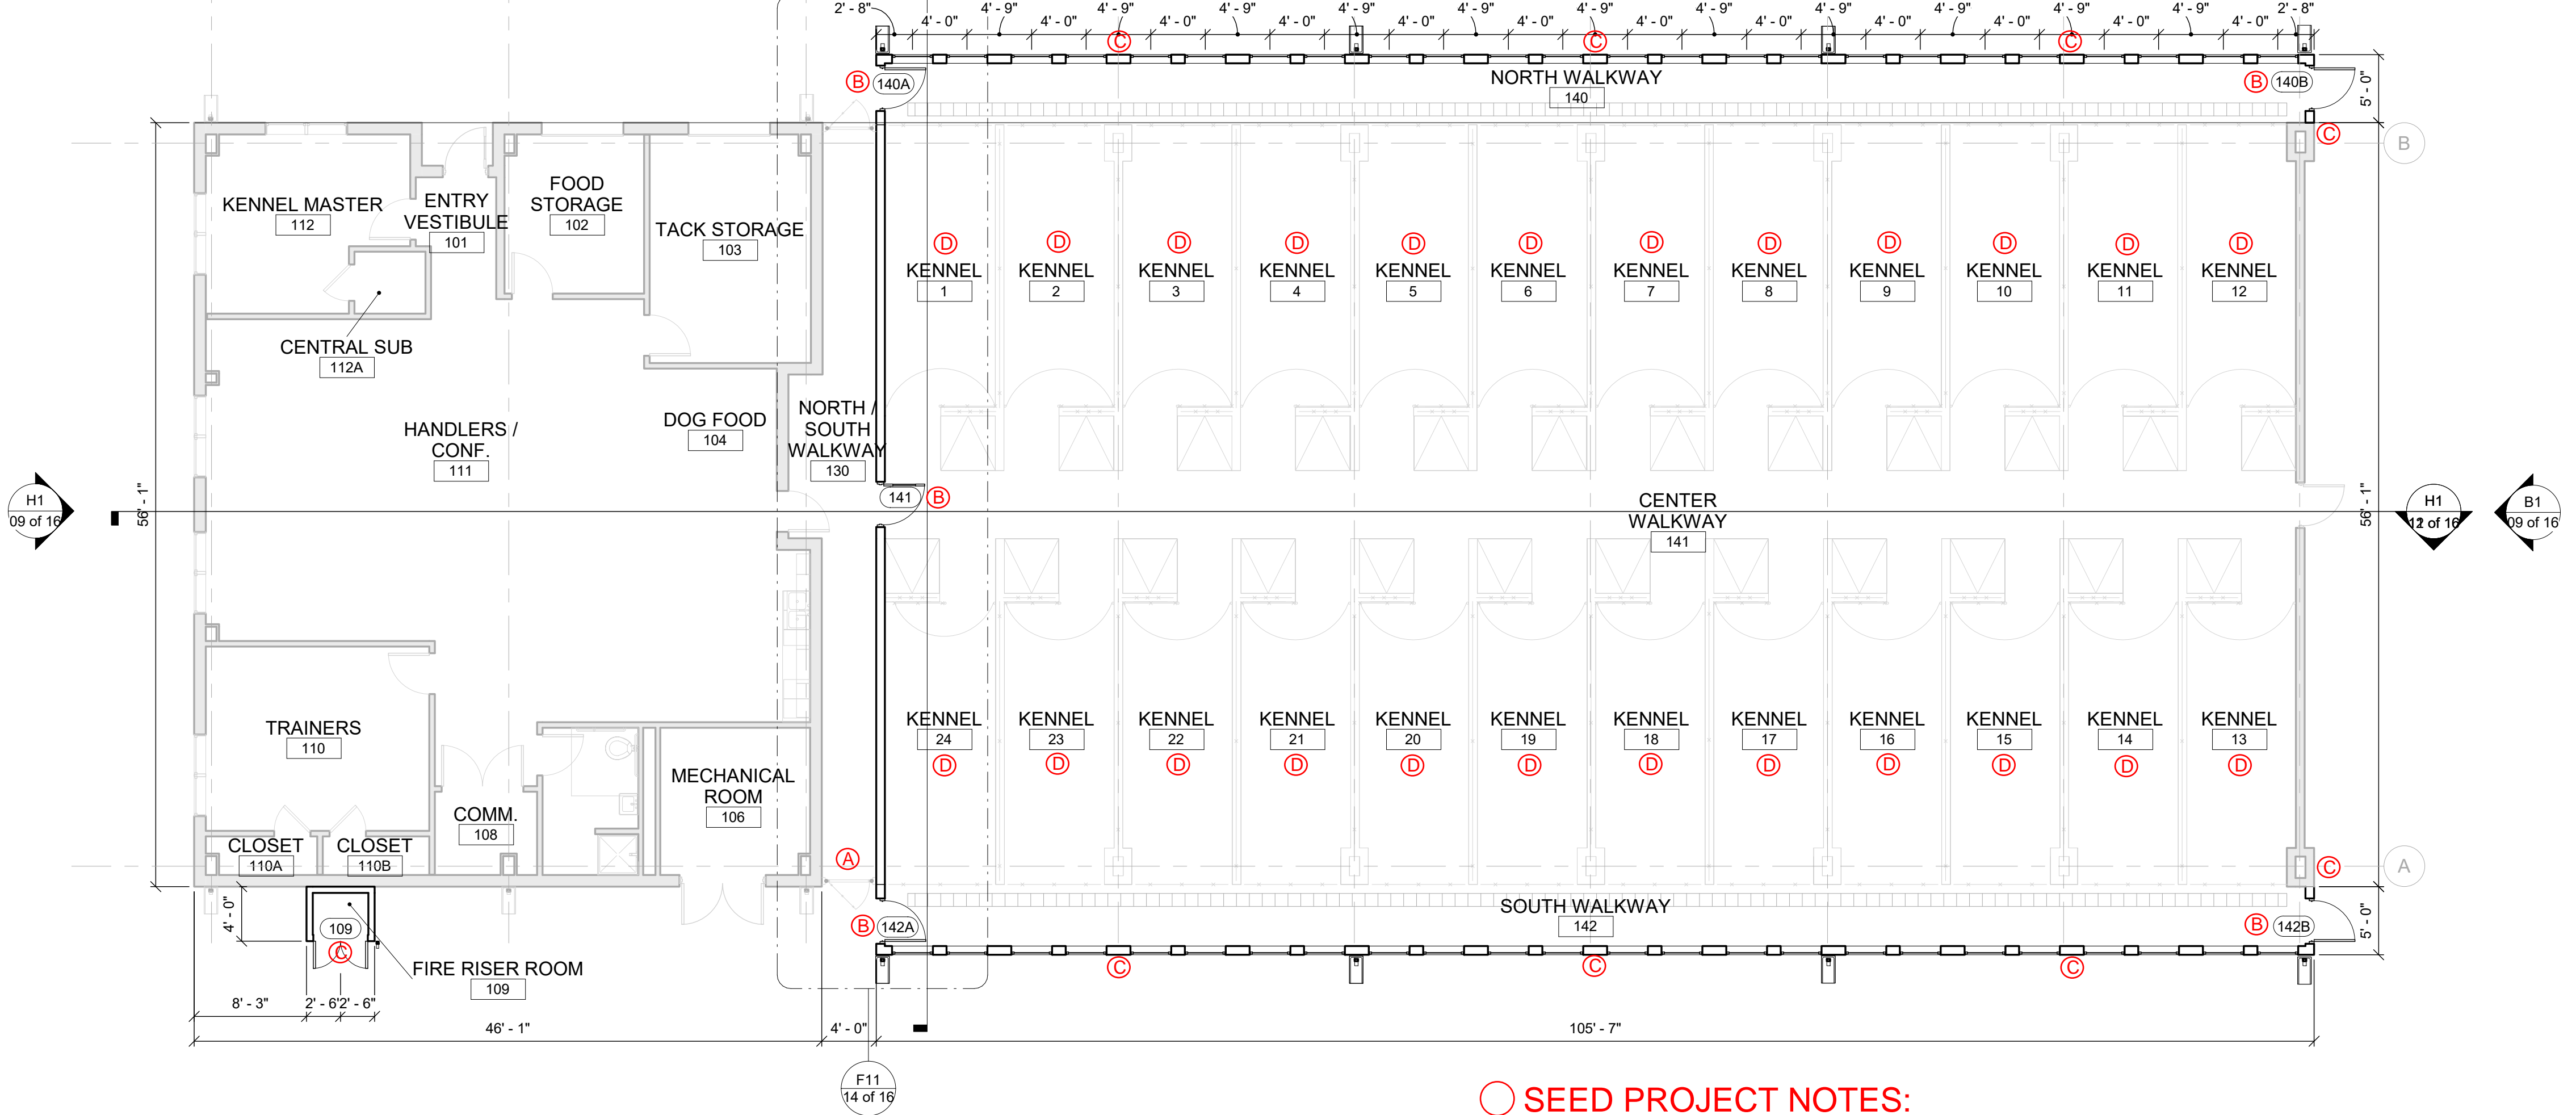

**NOTE THAT THIS FLOOR PLAN DOES NOT SHOW BID OPTIONS 1 & 2**


- BID OPTION 1: Reconfiguration of administrative area to provide exam and isolation areas.
  - BID OPTION 2: ABA restroom upgrades (moving sink and adjacent receptacle)
- Additional electrical work will be needed to support each of these options.

### SEED PROJECT NOTES:

- A. PROVIDE THE BACKBONE FOR A FULLY FUNCTIONAL CLOSED-CIRCUIT TELEVISION SYSTEM INCLUDING CONNECTION POINTS FOR CAMERAS, EQUIPMENT, AND WIRING. THIS INCLUDES CATEGORY 6 CABLE, CONDUIT, JUNCTION BOXES, AND WIRING RACEWAYS. PROVIDE COMMUNICATION HORIZONTAL PATHWAY IN CONDUIT, CATEGORY 6 CABLE, FOR THE NEW CCTV CAMERAS IN THE KENNEL AREA. REFER TO THE EXISTING CCTV LAYOUT ON THE COMMUNICATION PLAN FOR APPROXIMATE LOCATIONS OF NEW CAMERAS. FINAL LOCATIONS SHALL BE DETERMINED DURING THE DESIGN PHASE.
- B. PROVIDE IDS/ACS INFRASTRUCTURE ONLY TO NEW DOORS IN THE KENNEL AREA. INFRASTRUCTURE INCLUDES CONDUITS AND J-BOX.
- C. PROVIDE FULL CUT-OFF TYPE, WALL-MOUNTED, LIGHTING FIXTURES AROUND THE BUILDING PERIMETER. FINAL QUANTITIES TO BE DETERMINED DURING DESIGN.
- D. PROVIDE TWO LIGHT FIXTURES PER KENNEL. EACH KENNEL WILL BE SWITCHED SEPARATELY. FINAL LAYOUT TO BE DETERMINED DURING DESIGN.

## SEED PROJECT NEW WORK FLOOR PLAN

B1 1/8" = 1'-0"

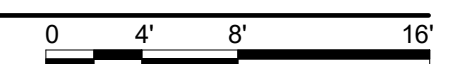

MICHIGAN AVE.

LEGEND


EXISTING	DESCRIPTION	NEW	REMOVE BY OTHER
— AP —	AERIAL PRIMARY	— AP —	APX
— US —	UNDERGROUND SECONDARY	— US —	
○	POWER POLE (SIZED AS SHOWN)	●	○
—>	DOWN GUY	—>	—>
○	POLE-MOUNTED 10 TRANSFORMER	N/A	○
N/A	POLE-MOUNTED 3-10 TRANSFORMER	⊕	
AS	AERIAL SECONDARY SERVICE	ASX	ASX

SPECIAL ELECTRICAL NOTES:

- (THIS SHEET ONLY)
- 1 4#300 KCMIL COPPER IN 3" CONDUIT WITH ONE SPARE 3" CONDUIT ALL ENCASED IN CONCRETE. REFER TO DETAIL 2/ES-504 FOR DUCTBANK CONSTRUCTION REQUIREMENTS.
  - 2 30' CLASS 3 ANODIZED ALUMINUM, DARK BRONZE FINISH. (SEE DETAIL 3, SHEET ES-503)
  - 3 150 W, LUMINAIRE R5 (SEE DETAIL 2, SHEET ES-503)
  - 4 70 W, LUMINAIRE L (SEE DETAIL 1 AND 4, SHEET ES-503)
  - 5 2 #10, COPPER, THHN CONDUCTORS AND 1 #10 COPPER THHN GROUND IN 1/2" RIGID GALVANIZED STEEL CONDUIT
  - 6 2 #8, COPPER, THWN CONDUCTORS AND 1 #8 COPPER THWN GROUND IN 1" RIGID GALVANIZED STEEL ABOVE GRADE AND 1" FVC SCHEDULE 40 BELOW GRADE (SEE DETAILS 1-5, SHEET ES-504 FOR INSTALLATION METHODS.)

GENERAL NOTES:

- 1. UNDERGROUND COMMUNICATION LINES SHOW ON SHEETS CS-101 AND CS-102

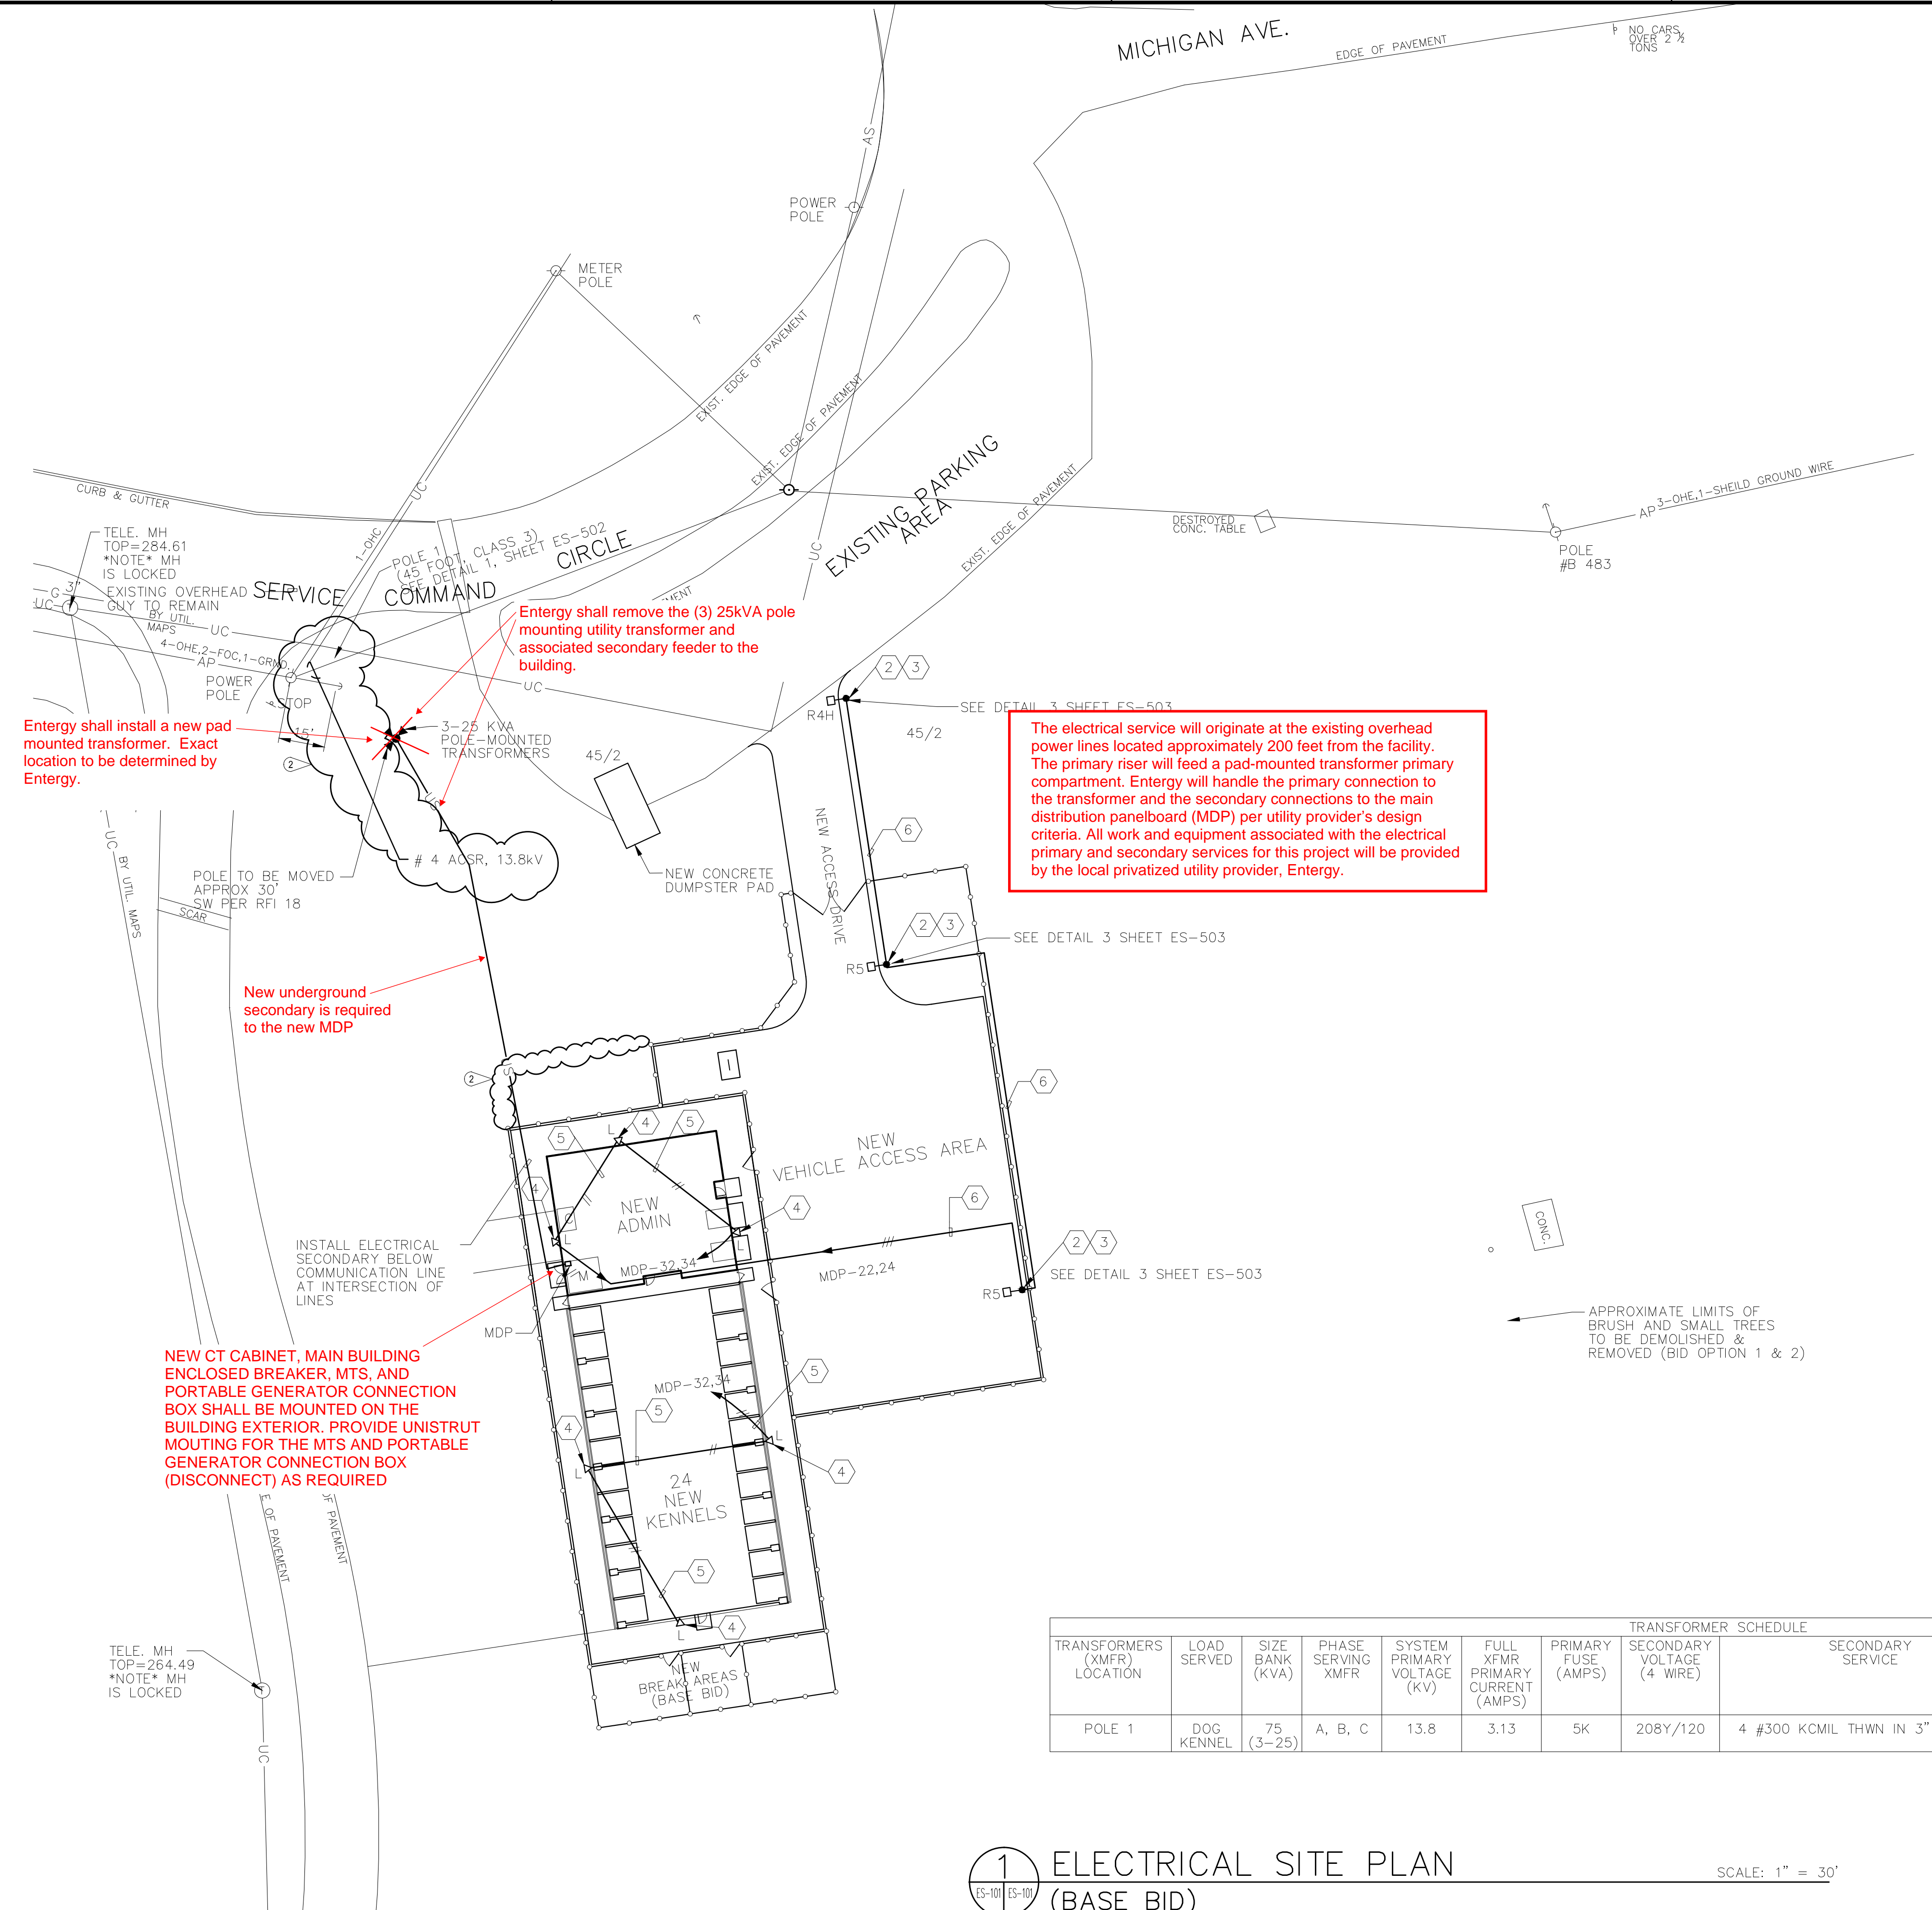

Entergy shall install a new pad mounted transformer. Exact location to be determined by Entergy.

Entergy shall remove the (3) 25kVA pole mounting utility transformer and associated secondary feeder to the building.

The electrical service will originate at the existing overhead power lines located approximately 200 feet from the facility. The primary riser will feed a pad-mounted transformer primary compartment. Entergy will handle the primary connection to the transformer and the secondary connections to the main distribution panelboard (MDP) per utility provider's design criteria. All work and equipment associated with the electrical primary and secondary services for this project will be provided by the local privatized utility provider, Entergy.

New underground secondary is required to the new MDP


NEW CT CABINET, MAIN BUILDING ENCLOSED BREAKER, MTS, AND PORTABLE GENERATOR CONNECTION BOX SHALL BE MOUNTED ON THE BUILDING EXTERIOR. PROVIDE UNISTRUT MOUNTING FOR THE MTS AND PORTABLE GENERATOR CONNECTION BOX (DISCONNECT) AS REQUIRED

TRANSFORMERS (XFMR) LOCATION	LOAD SERVED	SIZE BANK (KVA)	PHASE SERVING XFMR	SYSTEM PRIMARY VOLTAGE (KV)	FULL XFMR PRIMARY CURRENT (AMPS)	PRIMARY FUSE (AMPS)	SECONDARY VOLTAGE (4 WIRE)	SECONDARY SERVICE	SERVING PANEL	MAIN CIRCUIT BREAKER / SWITCH	CONNECTED LOAD (KVA)	CONNECTED SECONDARY LOAD (AMPS)
POLE 1	DOG KENNEL	75 (3-25)	A, B, C	13.8	3.13	5K	208Y/120	4 #300 KCMIL THWN IN 3" PVC/RSC	MDP	250 A, 3P	65.4	180.6

1 ELECTRICAL SITE PLAN (BASE BID)

SCALE: 1" = 30'

RECORD DRAWINGS

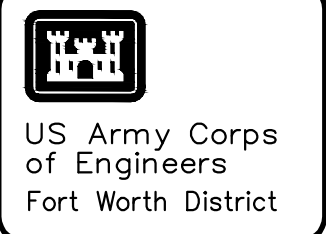

Date	Revision
02/27/12	002712

Designed by:	Rev. Date:	Rev. Date:
Dwn by:	FEBRUARY 2012	FEBRUARY 2012
Reviewed by:	Sat No.:	Sat No.:
Submitted by:	W9126G-10-D-0025	W9126G-10-D-0025
PROJECT MANAGER:	Contr. No.:	Contr. No.:
TROY MARTINSON, PE		
	Plot date:	Plot date:

U.S. ARMY ENGINEER DISTRICT  
CORPS OF ENGINEERS  
FORT WORTH, TEXAS



FORT POLK, LOUISIANA  
MILITARY WORKING DOG FACILITY  
PROJECT No.: 062622, P2# 130860  
ELECTRICAL SITE PLAN  
(BASE BID)



Sheet reference number:  
ES-101  
Sheet 32 of 96



