



ADDENDUM NO. 2:

Date: 09/10/26
 Project: L.E. WILLSON ES WINDOW REPLACEMENT
 WSM #26-026
 DCM# 2026579

 Owner: Sheffield City Schools
 Architect: Ward Scott Morris Architecture, Inc.

 Bid Date: September 17TH, 2026 **PLEASE NOTE REVISED BID DATE**
 Bid Time: 2:00 PM
 Bid Location: Sheffield Board of Education Annex 300 W 6th St, Sheffield, AL 35660

This Addendum forms a part of the Contract Documents and modifies the original Bid Documents as noted below. Acknowledge receipt of this Addendum in the location provided on the Bid Proposal Form. Further instruction, including requested approved equals to follow in subsequent addenda.

1.1 GENERAL

- A. Demo and Reno of the gym locker rooms has been removed from the scope. Please note sheet removal listed below.
- B. On Page A001 there is a note "SPANDREL GLAZING TO COVER SIDE OF WINDOW THAT COVERS INTERIOR MECH ROOMS" does this apply to the classroom windows and classroom closet windows? Please Advise.
 1. Spandrel to be located as indicated on window elevation sheets. The spandrel layout on these sheets should cover all mechanical closets from exterior view. Note adjusted for clarification on attached A001.
- C. Please provide the door hardware schedule.
 1. Please provide hardware allowance of \$1800 per door.
- D. We have noticed that there are three Plan pages listed on the Index that are missing: A094, A104, And A105. In addition, there is one that was included in the documents but is not listed on the Index: A331. Please, advise.
 1. See below for revised sheet list.

GENERAL

G101 COVER SHEET

ARCHITECTURAL

A001 STOREFRONT SCHEDULE
 A091 OVERALL DEMO PLAN - GROUND FLOOR
 A092 OVERALL DEMO PLAN - SECOND FLOOR
 A101 OVERALL NEW CONSTRUCTION PLAN - GROUND FLOOR
 A102 OVERALL NEW CONSTRUCTION PLAN - SECOND FLOOR
 A201 EXTERIOR ELEVATIONS - GYM
 A202 EXTERIOR ELEVATIONS - CLASSROOM BUILDING

A311 WALL SECTIONS

A331 SECTION DETAILS

- E. On the window schedule (A001) there is A LOT of spandrels, which are not typically covered by a window treatment. Please clarify whether we are covering the entire window with manual/motorized shades or only the "blue portion" of the window?
 - 1. Please provide shades at clear glazing locations only. See spec for clarification on motorized and manual locations.
- F. On page A001 there is a note in the top right that says all new mullions at storefront and curtain wall should be 2-1/2" x 6". We want to use Coral that is listed in the spec but their Curtain Wall is 2-1/2" x 7". Please advise if this will be acceptable.
 - 1. Acceptable provided field conditions allow for 7" mullion depth.
- G. On plan page A103 it calls for note 5 to have new floor finish to receive sealed concrete in rooms 1112 and 1122. Are we to install new sealed concrete entirely in both rooms or would it be just at the part in room 1122 that is having the new slab infill.
 - 1. Removed from scope
- H. On page A103 note 4 calls for infill wall to match existing. Please provide details on what is the existing wall type to match for accurate pricing.
 - 1. Removed from scope

1.2 SPECIFICATIONS

- A. N/A

1.3 DRAWINGS

- A. A001 – Replace sheet in its entirety with attached replacement sheet A001
- B. A091 – Replace sheet in its entirety with attached replacement sheet A091
- C. A093 – Remove in its entirety from contract documents
- D. A095 – Remove in its entirety from contract documents
- E. A101 – Replace sheet in its entirety with attached replacement sheet A101
- F. A103 – Remove in its entirety from contract documents

1.4 ATTACHED TO ADDENDUM

- A. Drawing Sheet A001
- B. Drawing Sheet A091
- C. Drawing Sheet A101


END OF ADDENDUM

KEYNOTES - DEMOLITION PLAN:


- 1 REMOVE EXISTING PLUMBING FIXTURES, TOILET PARTITIONS, URINAL SCREENS & TOILET ACCESSORIES.
- 2 REMOVE EXISTING LOCKERS, CONCRETE BASE AND FINISH TILE AT BASE. PATCH AND REPAIR EXISTING CONCRETE SLAB TO PREPARE FOR NEW FINISH FLOOR.
- 3 REMOVE EXISTING SHOWERS (HEADS), HANDLES, BUILT-IN SEATING AND SHOWER PARTITIONS. INFILL DEPRESSED FLOOR/SLAB AREAS AT SHOWERS TO HAVE FLUSHED FINISH WITH EXISTING TOP OF SLAB IN SPACE.
- 4 REMOVE EXISTING FINISH FLOOR, SMOOTH, PATCH AND REPAIR EXISTING SLAB AS NEEDED TO PREPARE FOR NEW FLOOR FINISH.
- 5 EXISTING CURB TO BE REMOVED. SMOOTH, PATCH AND REPAIR EXISTING SLAB AS NEEDED TO PREPARE FOR NEW FLOOR FINISH.
- 6 EXISTING TO REMAIN
- 7 EXISTING TO BE REMOVED
- 8 EXISTING WINDOWS TO BE REMOVED

GENERAL NOTES - DEMOLITION PLAN:

- REMOVE EXISTING EQUIPMENT AND FURNITURE AND TURN OVER TO OWNER (UNLESS NOTED OTHERWISE)
- EXISTING WINDOWS AT CAFETERIA, KITCHEN AND LIBRARY TO REMAIN. NEW WINDOWS PROVIDED SHALL MATCH EXISTING WINDOWS AT CAFETERIA, KITCHEN AND LIBRARY FOR REFERENCE.
- EXISTING EXTERIOR CANOPIES (COVERED WALKWAYS) TO REMAIN.

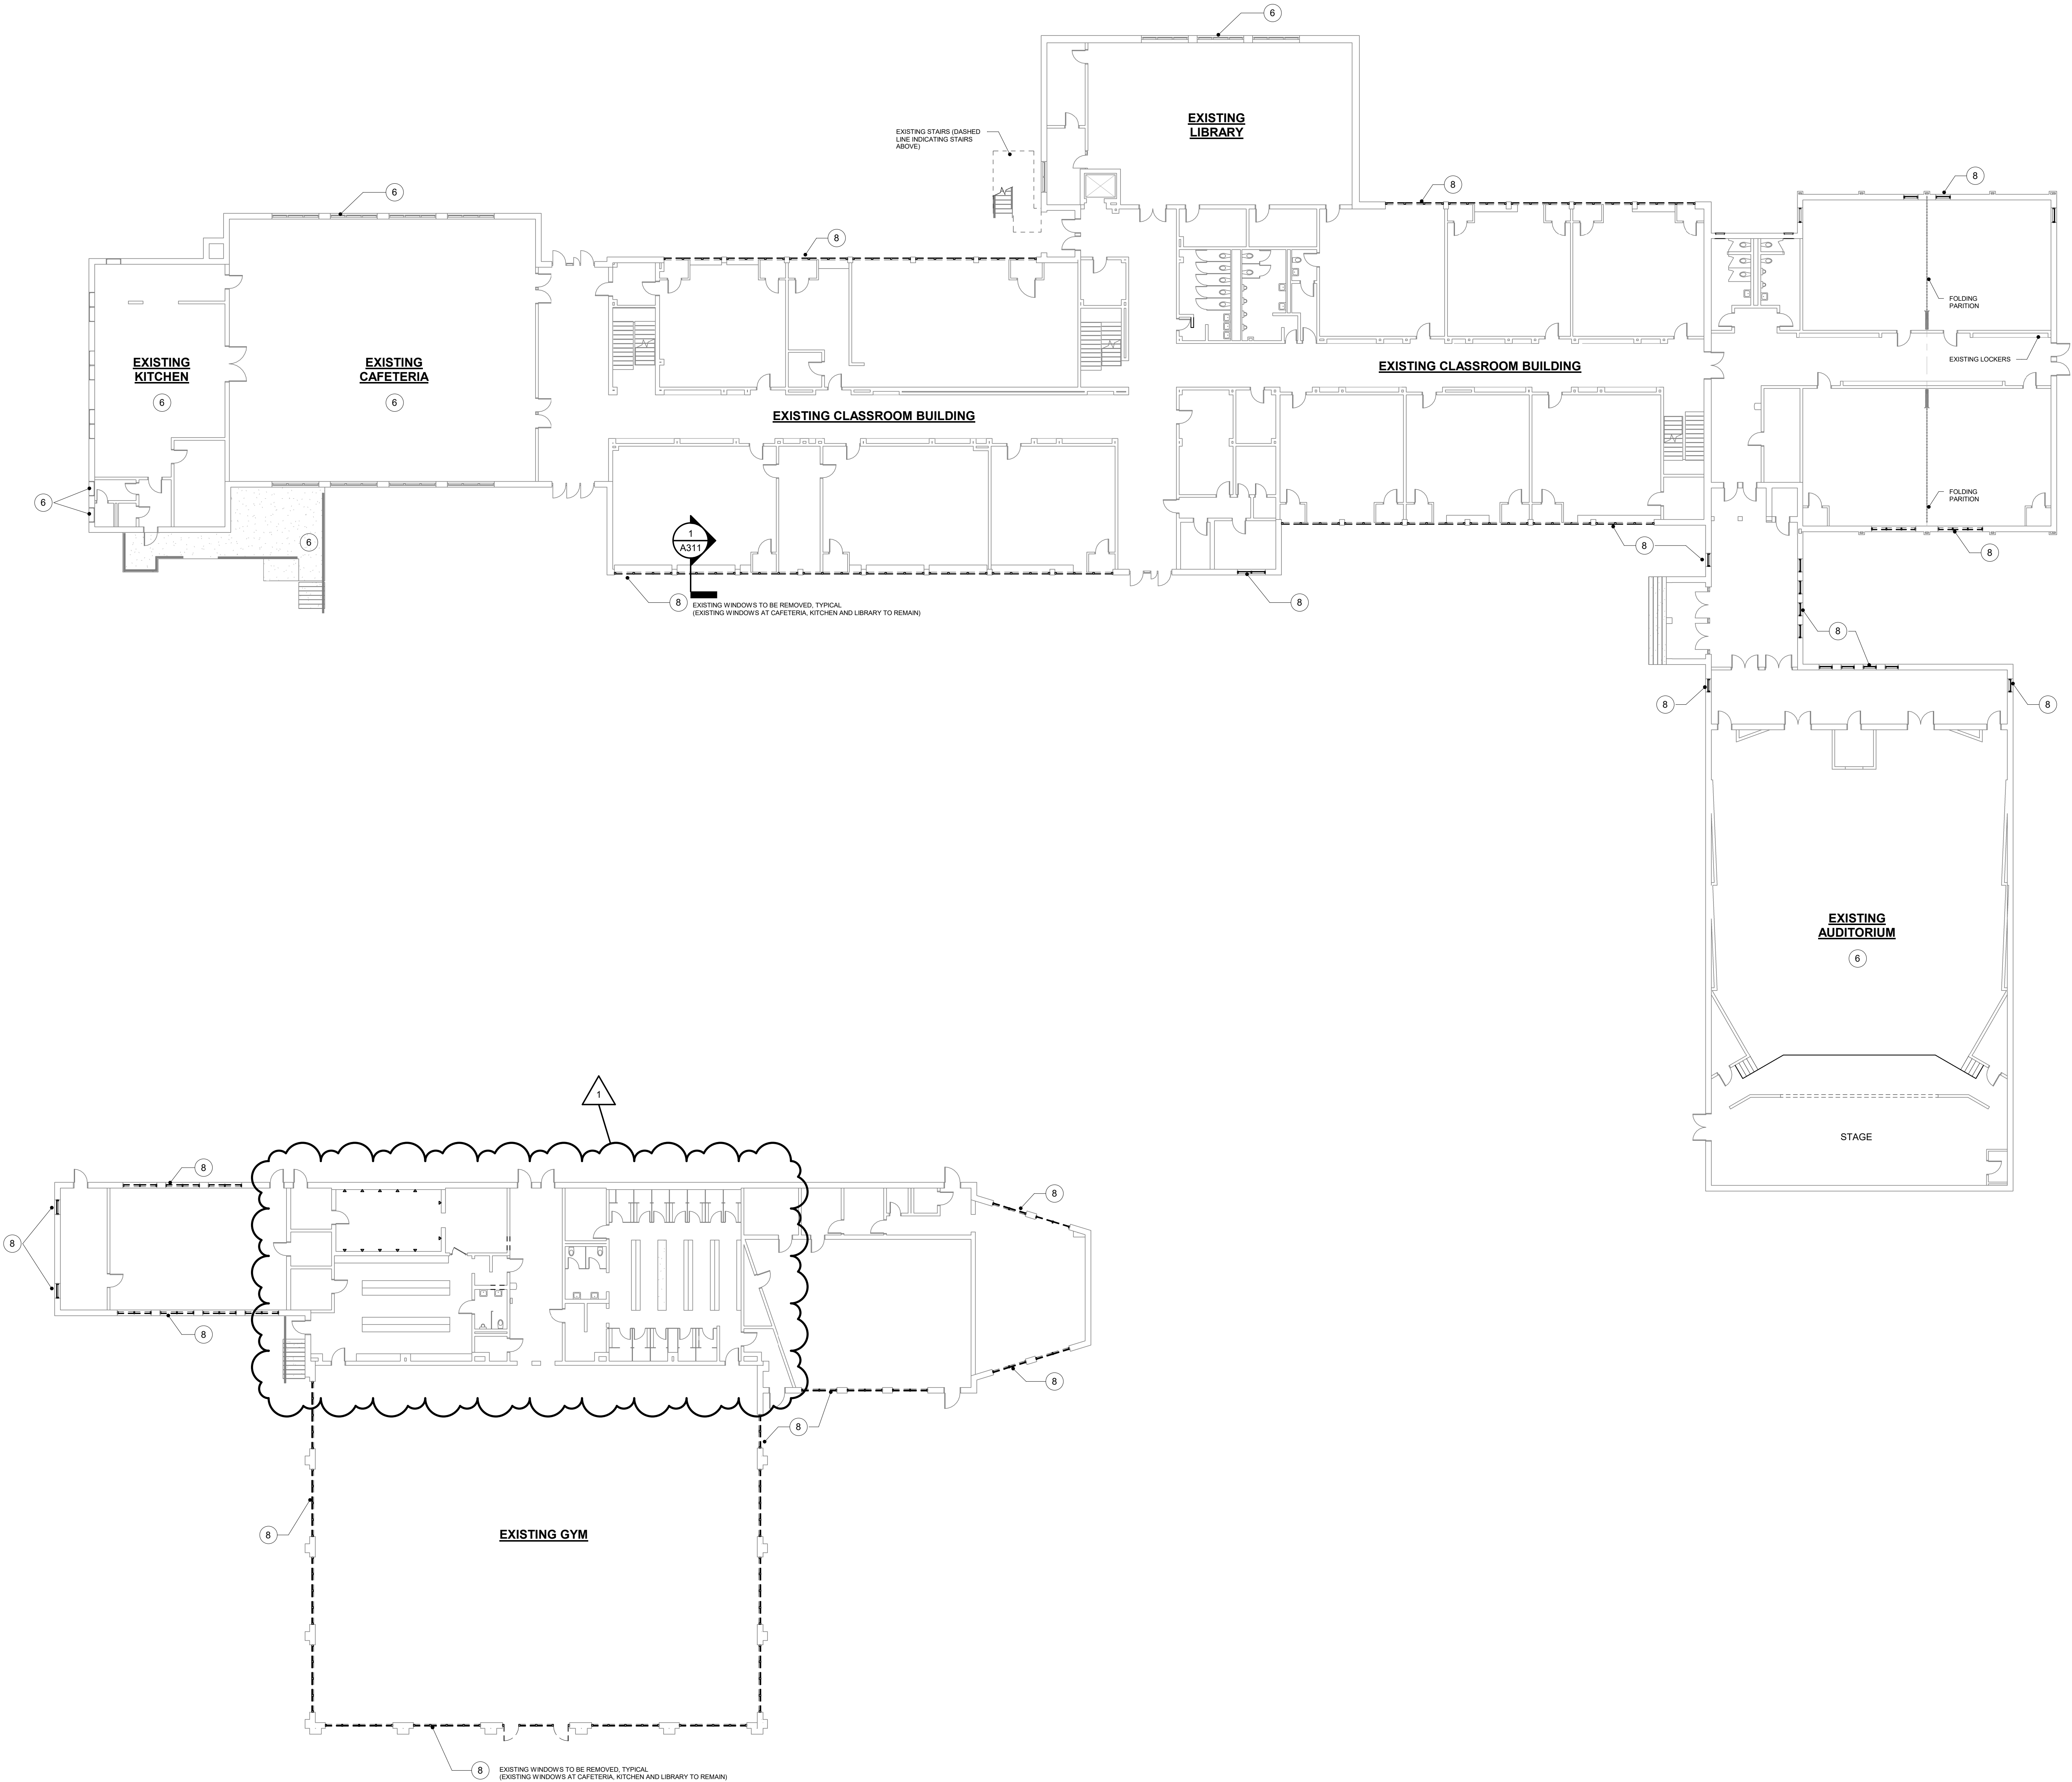


1 GROUND LEVEL - OVERALL EXISTING PLAN
1/16" = 1'-0"

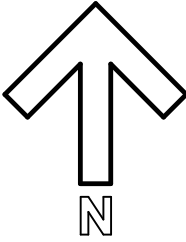


KEYNOTES - NEW CONSTRUCTION:

- 1 EXISTING TO REMAIN (NOT IN CONTRACT - N.I.C)
2 REPLACE ALL GRASS WITH NEW SOD AT AREAS DISTURBED BY DEMOLITION OR NEW CONSTRUCTION

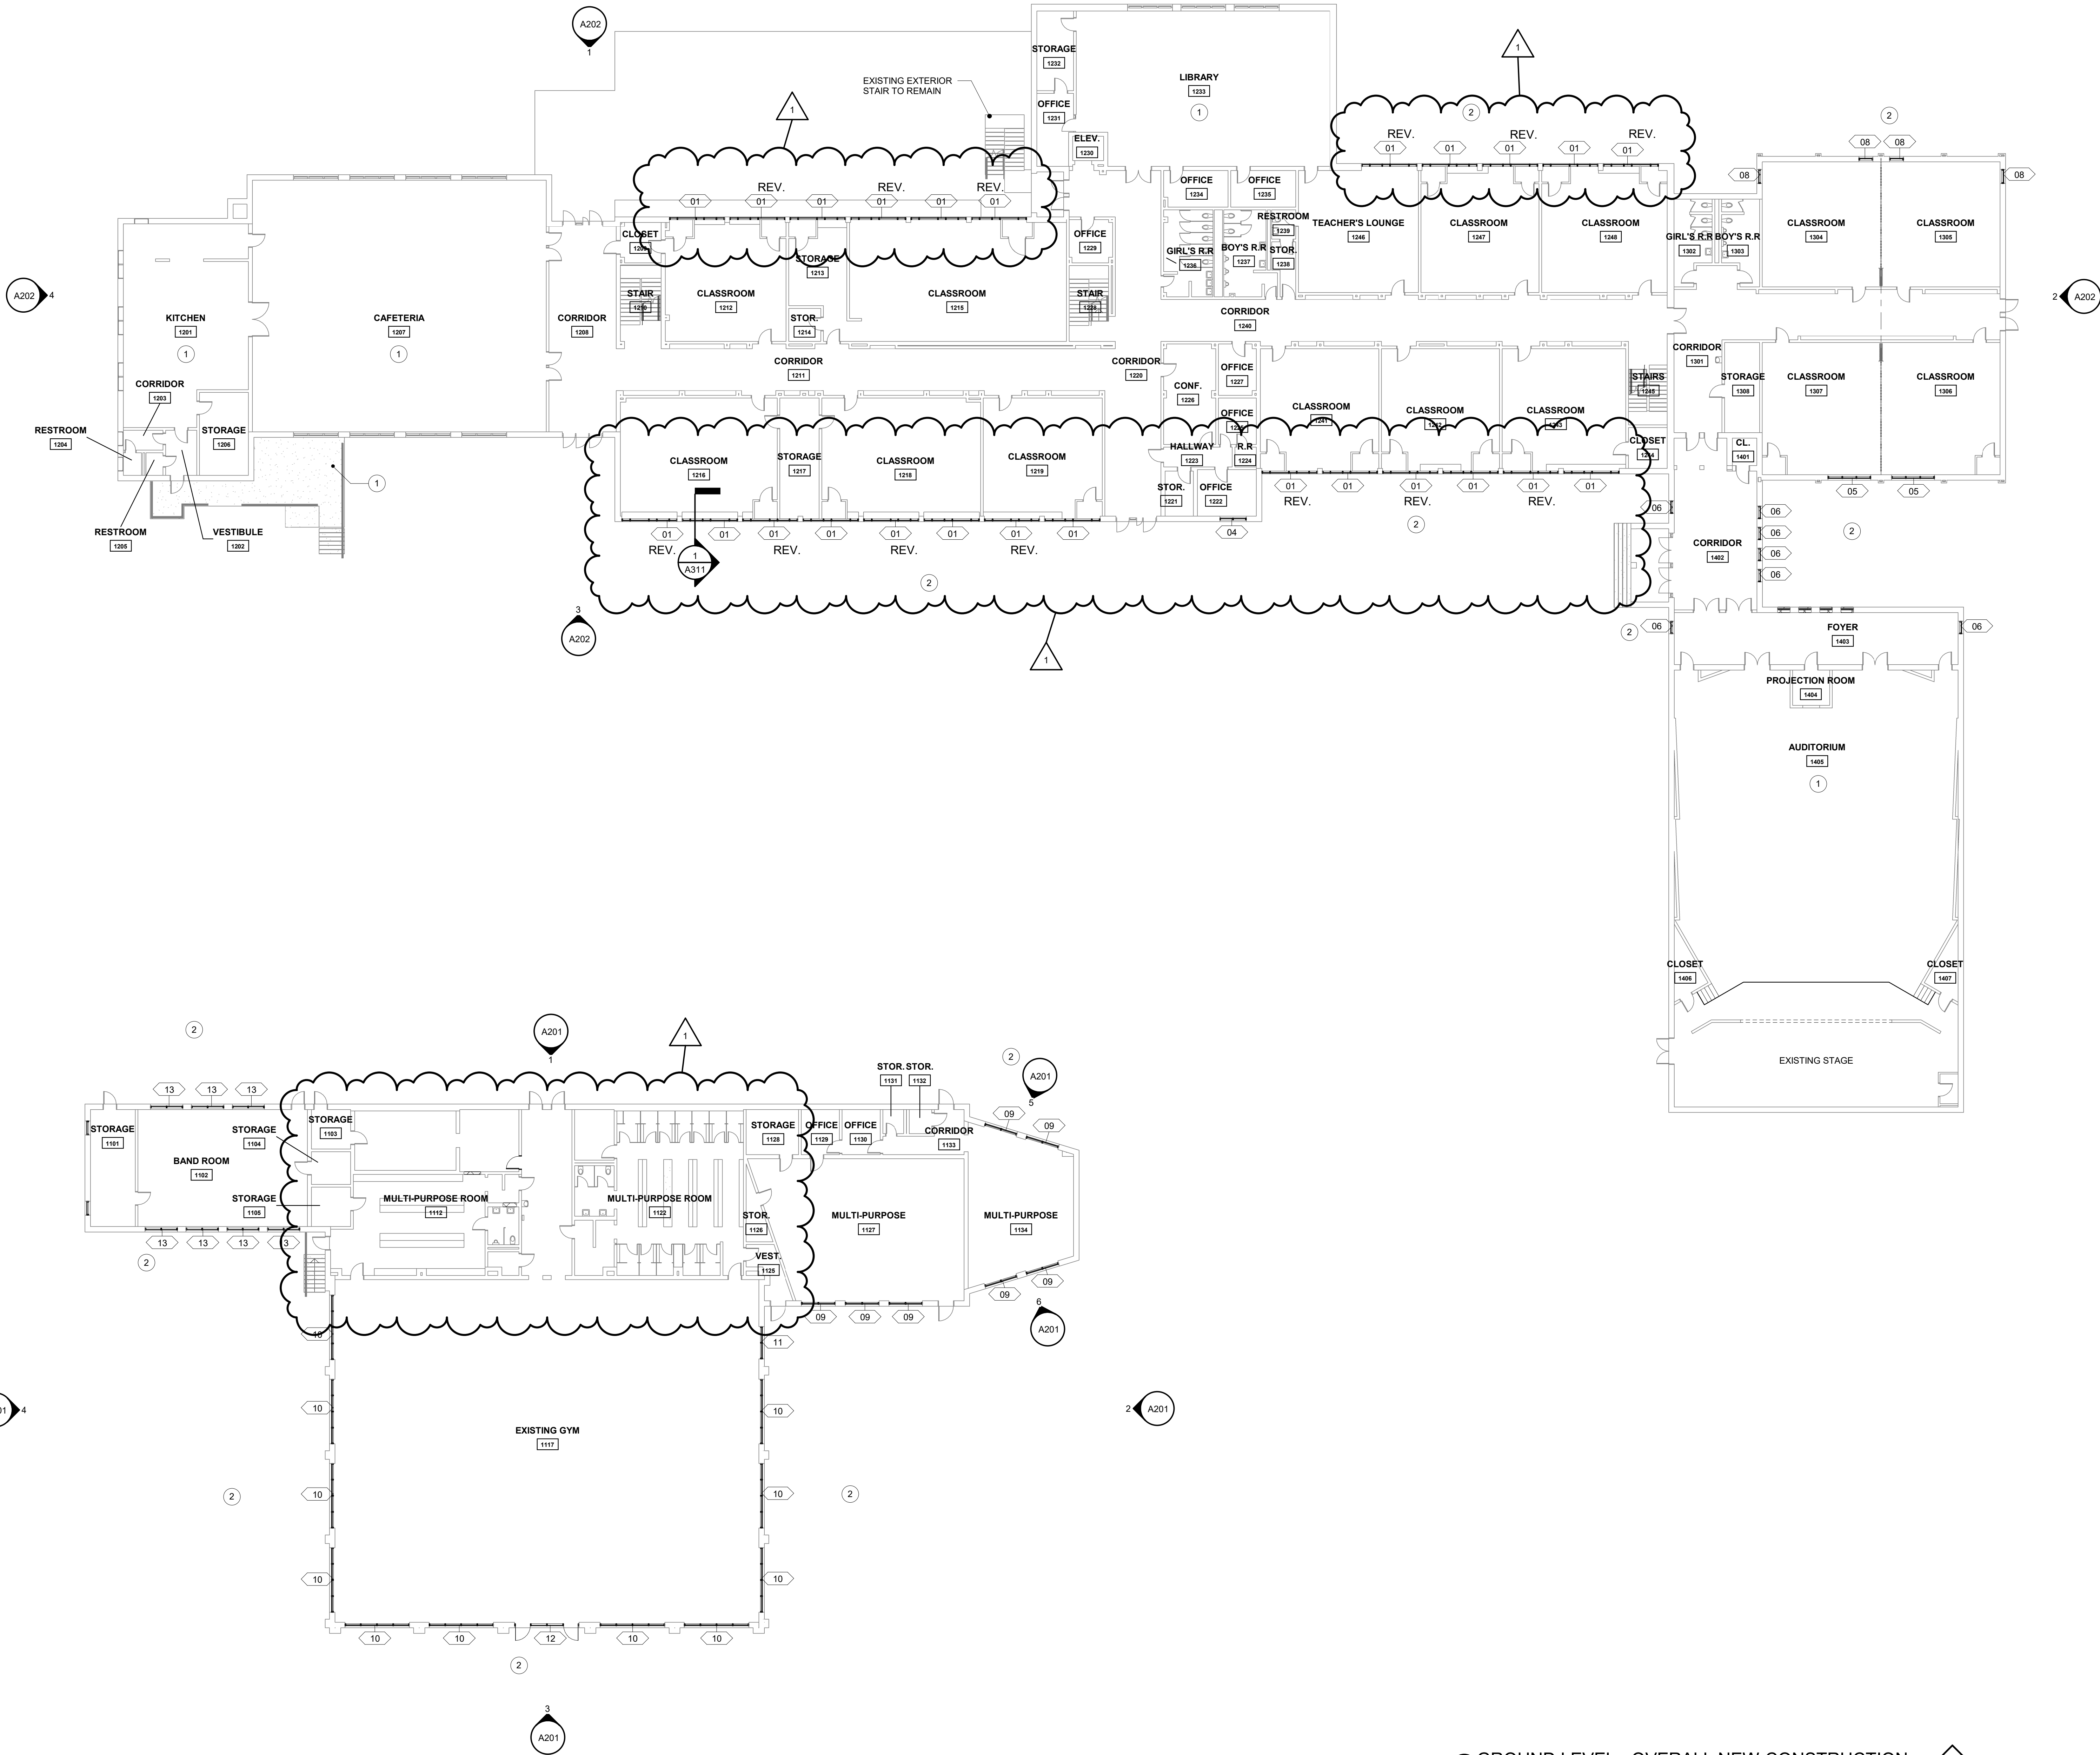

1 GROUND LEVEL - OVERALL NEW CONSTRUCTION
1/16" = 1'-0"

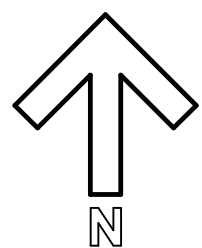

WARD | SCOTT | MORRIS
ARCHITECTURE
TUSCALOOSA | HUNTSVILLE
1606 PAUL W. BRYANT DRIVE, TUSCALOOSA, ALABAMA 35401
www.wardscottmorris.com

L.E. WILLSON ELEMENTARY SCHOOL - RENOVATION
SHEFFIELD CITY SCHOOLS
2200 EAST 31ST STREET, SHEFFIELD, AL 35660



BID DOCUMENTS

DATE: 08/26/26
PROJ NO: 26-026

REVISIONS		
#	DESC	DATE
1	ADD2	9/10/26

OVERALL NEW
CONSTRUCTION
PLAN - GROUND
FLOOR

A101

ADD 2: REMOVED GYM LOCKER DEMO/RENO SCOPE, ADDED MISSING TAGS